
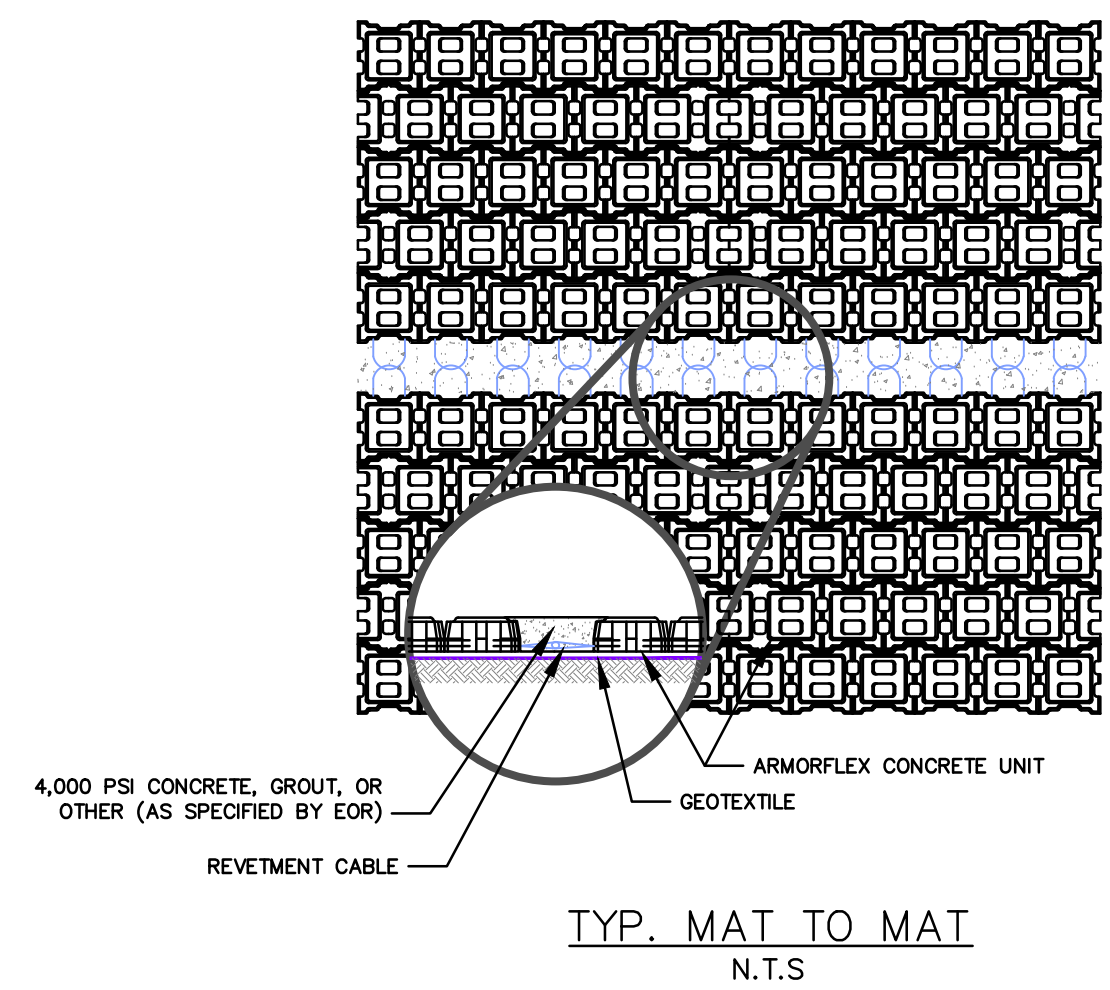
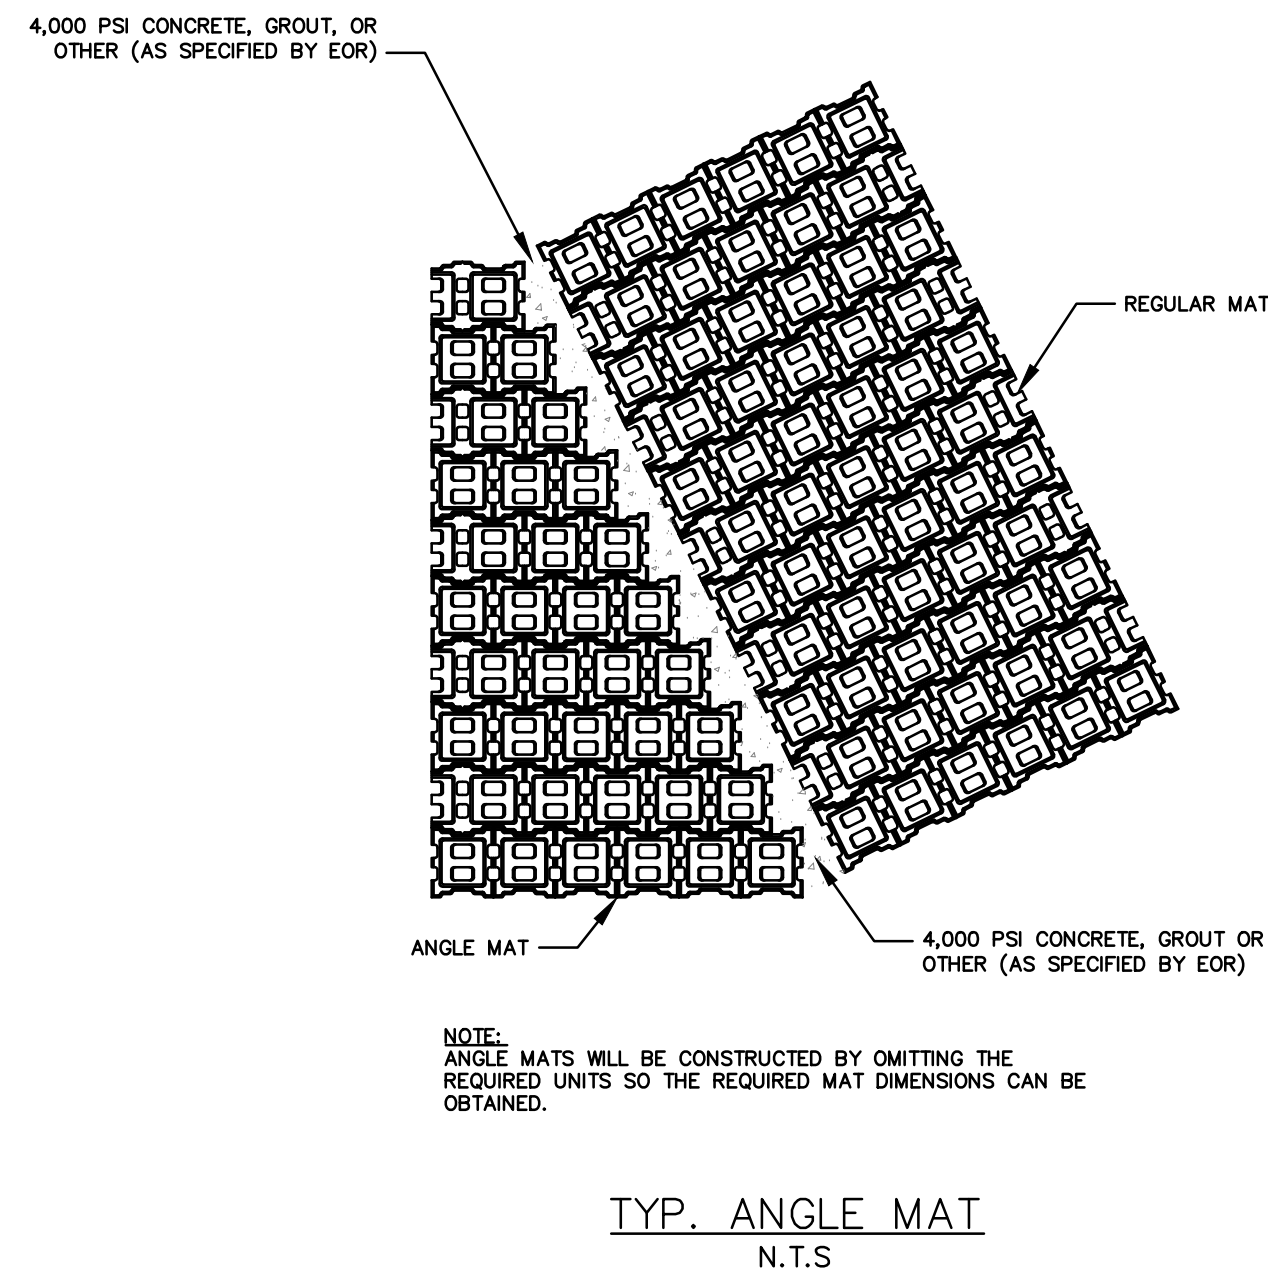
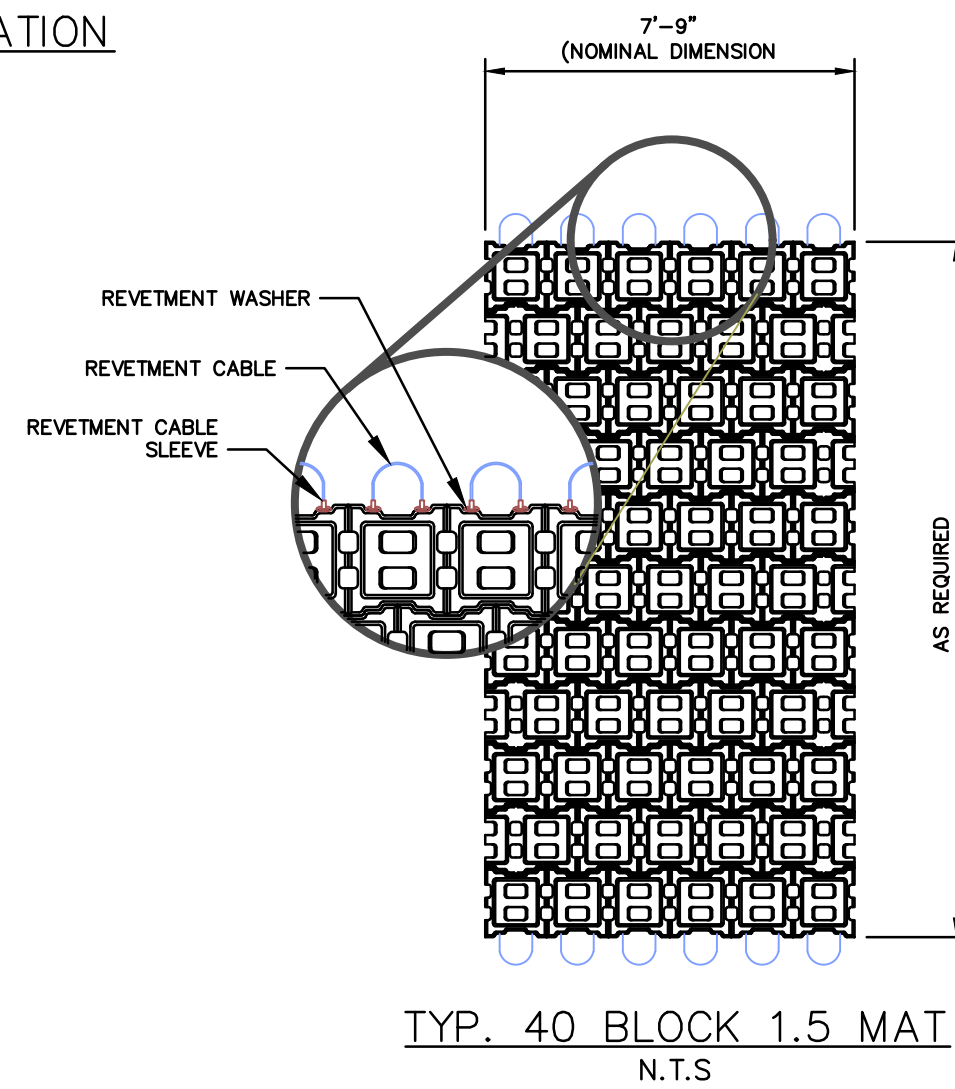
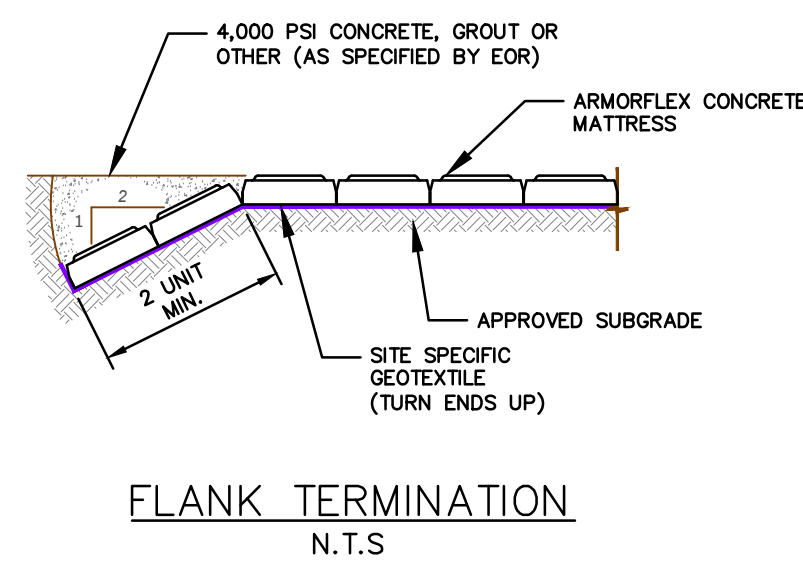
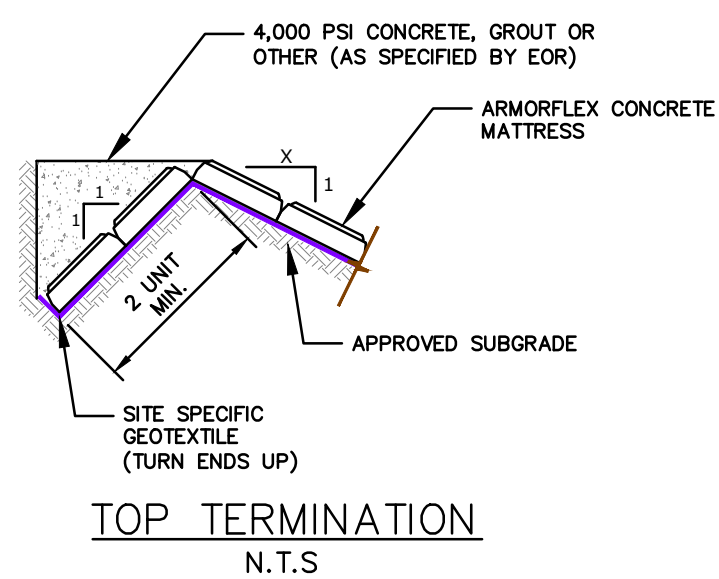
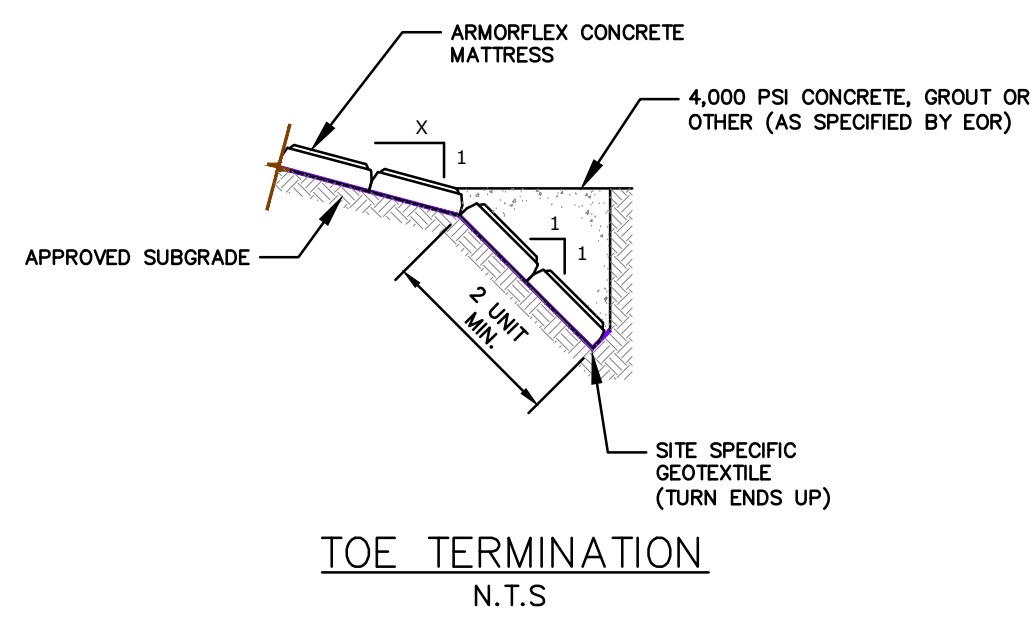


Source: Va. DSWC

Plate 3.18-1

RIPRAP OUTLET PROTECTION DETAIL

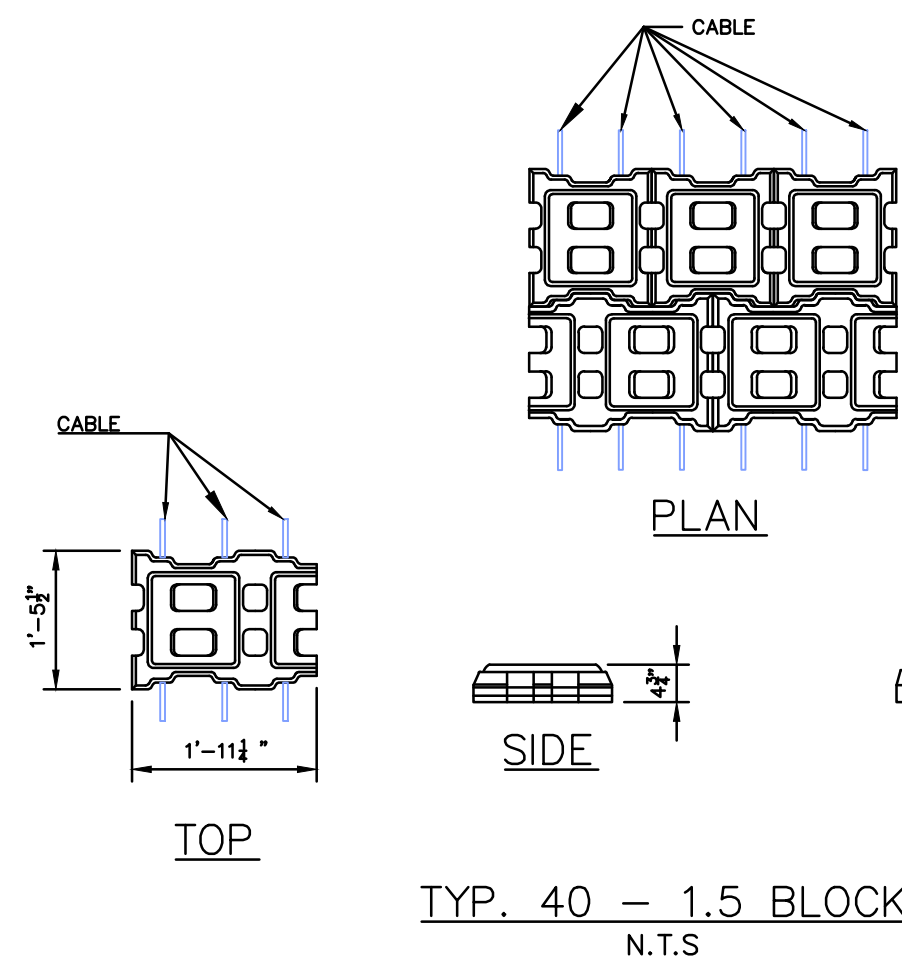

NO.	DATE	CHKD.	APPD.	DESCRIPTION
0	05/05/21	JK	DW	ADDRESS VADEQ COMMENTS PROPOSED FORD AT STREAM S-D14 CROSSING (ACCESS ROAD MFP-FR-292)
1	06/23/21	JUZ	RE	




Mountain Valley Pipeline EROSION AND SEDIMENT CONTROL PLANS MOUNTAIN VALLEY PIPELINE PROJECT - H600 LINE SPREAD 10 - FRANKLIN COUNTY, VIRGINIA	MOUNTAIN VALLEY PIPELINE, LLC 2200 ENERGY DRIVE CANONSBURG, PA 15317
---	--

TETRA TECH complex world CLEAR SOLUTIONS™ 661 ANDERSEN DRIVE FOSTER PLAZA 7 PITTSBURGH, PA 15220
--

EROSION AND SEDIMENT CONTROL PLANS

COMMONWEALTH OF VIRGINIA DAVID J. WALLNER Lic. No. 57593 6/23/2021 PROFESSIONAL ENGINEER
--

DRAWN BY:	JUZ
CHECKED BY:	RE
APPROVED BY:	DW
DATE:	06/23/2021
SCALE:	AS SHOWN
SHT. NO. 14.70AES OF	14.81ES

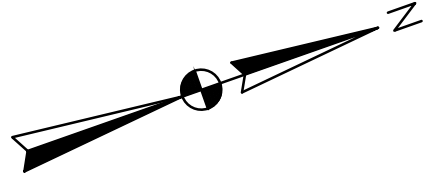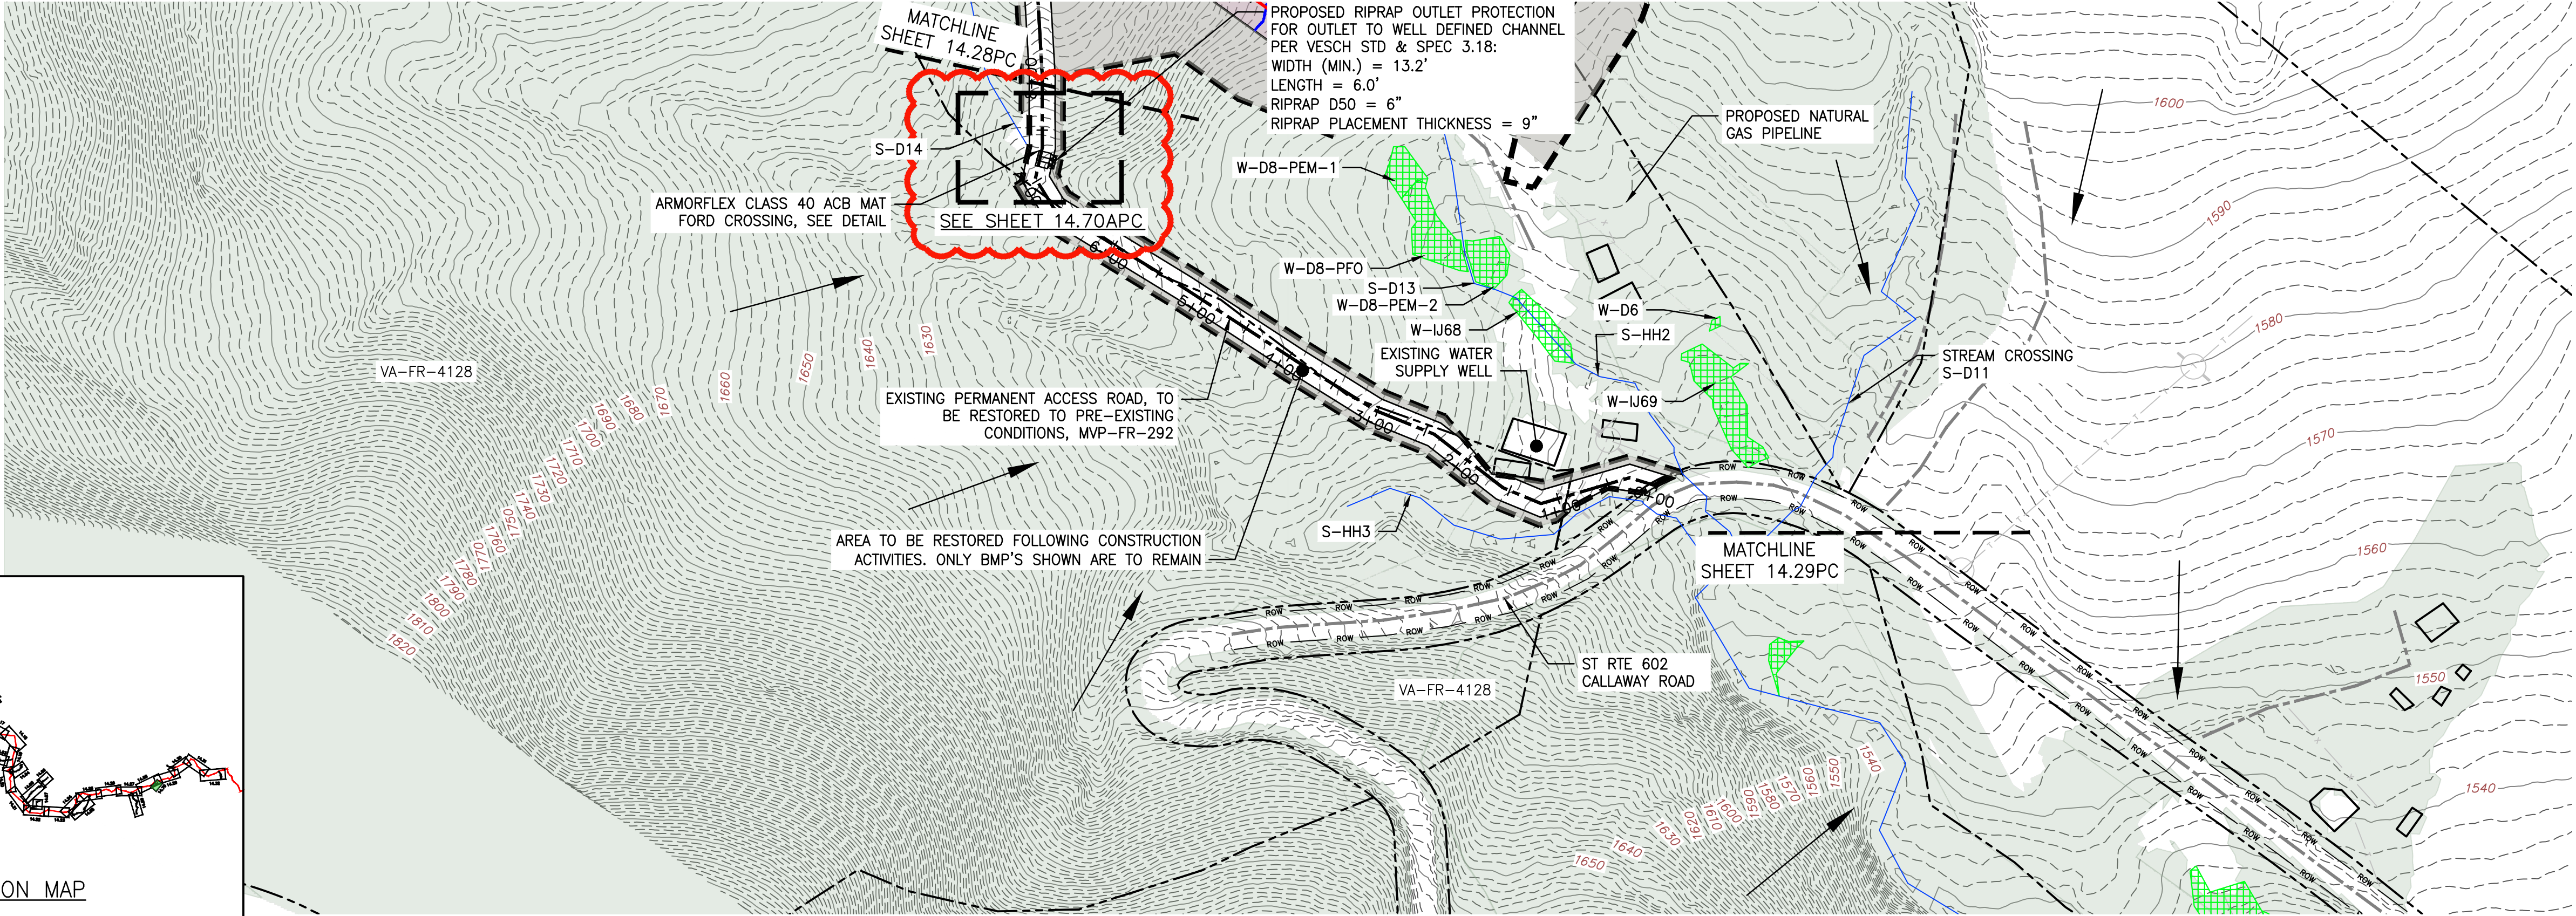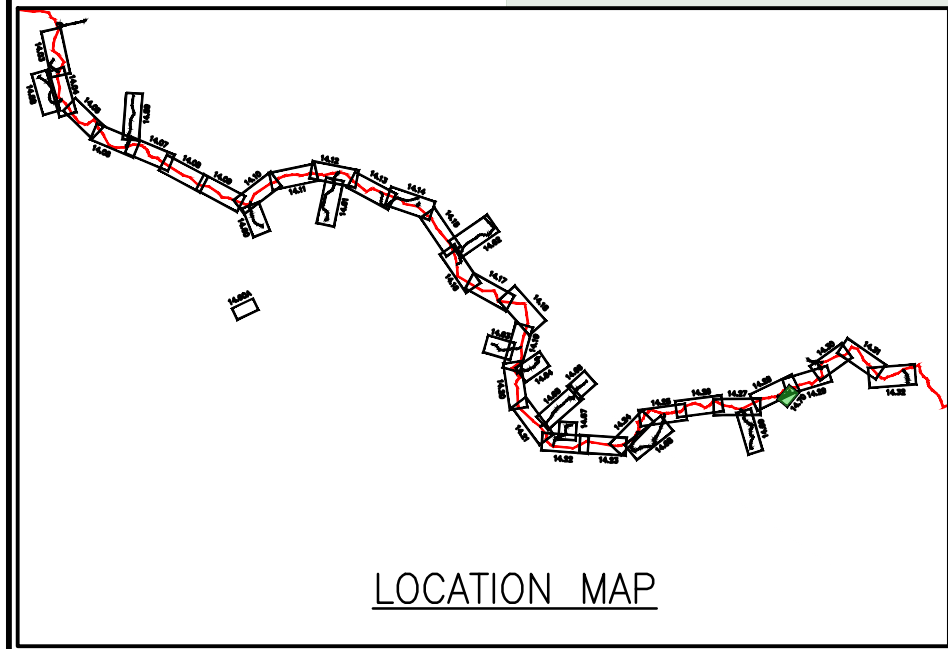

LEGEND

- EXISTING CULVERT
- STREAM
- EXISTING PROPERTY LINE
- EXISTING STATE LINE
- EXISTING COUNTY LINE
- EXISTING ROAD/TRAIL
- USDA FOREST SERVICE (NATIONAL FOREST) LANDS
- APPALACHIAN NATIONAL SCENIC TRAIL
- ACID FORMING MATERIAL
- GRASS-LINED CHANNEL (SEE DETAIL MVP-ES39)
- PROPOSED LIMIT OF DISTURBANCE
- PROPOSED PERMANENT RIGHT OF WAY

- PROPOSED LEVEL SPREADER DIVERSION
- PROPOSED LEVEL SPREADER
- PROPOSED ACCESS ROAD CENTERLINE
- PROPOSED PIPELINE
- SURFACE WATER FLOW DIRECTION
- POND
- WETLAND
- PROPOSED CULVERT WITH OUTLET PROTECTION (SEE DETAILS MVP-ES7, 7.1)
- APPROXIMATE LOCATION OF WATER BAR END TREATMENTS (PENDING FIELD CONDITIONS)

- STREAM FLOW DIRECTION
- FEMA 100 YEAR FLOODPLAIN
- PERMANENT WATER BAR 10' END TREATMENT
- PERMANENT WATER BAR 15' END TREATMENT
- PERMANENT WATER BAR 20' END TREATMENT

- STEEP SLOPE AREA
- EXISTING FOREST
- PERMANENT EASEMENT RESTORED TO MEADOW CONDITION
- TEMPORARY EASEMENT RESTORED TO BRUSH CONDITION

PLAN

SCALE: 1" = 100'



NOTES:

- NOTE THAT ALL WATER BARS REGARDLESS OF SPECIFIED CALCULATION LENGTH ARE TO BE INSTALLED WITH 20-FT END TREATMENT LENGTHS, EXCEPT AS NOTED IN NOTE 2 BELOW.
- IN AREAS OF RIDGETOP AS NOTED IN THE TABLE ON THE KEY PLAN OF THIS PLAN SET, WATER BARS WITH END TREATMENT LENGTHS OF 10-FT WILL BE PLACED ON EITHER END.


NO.	DATE	DWN.	APPD.	DESCRIPTION
1	06/23/21	JUZ	RE	ADDRESS VIDEO COMMENTS
2	05/05/21	JK	RE	PROPOSED 600' X STREAM S-D14 CROSSING (ACCESS ROAD MVP-FR-292)
3	03/21/18	KAL	RE	ADDRESS VIDEO COMMENTS
4	03/16/18	KAL	RE	ADDRESS VIDEO COMMENTS
5	03/04/18	KAL	RE	ADDRESS VIDEO COMMENTS
6	02/22/18	KAL	RE	RESUBMISSION USING APPROVED STORMWATER METHODOLOGY

Mountain Valley Pipeline	
POST CONSTRUCTION (STORMWATER & RESTORATION) PLANS	
MOUNTAIN VALLEY PIPELINE PROJECT - H600 LINE	
SPREAD 10 - FRANKLIN COUNTY, VIRGINIA	
MOUNTAIN VALLEY PIPELINE, LLC	
2200 ENERGY DRIVE	
CANONSBURG, PA 15317	


TETRA TECH
complex world | CLEAR SOLUTIONS™

661 ANDERSEN DRIVE
FOSTER PLAZA 7
PITTSBURGH, PA 15220


POST CONSTRUCTION
(STORMWATER &
RESTORATION) PLANS

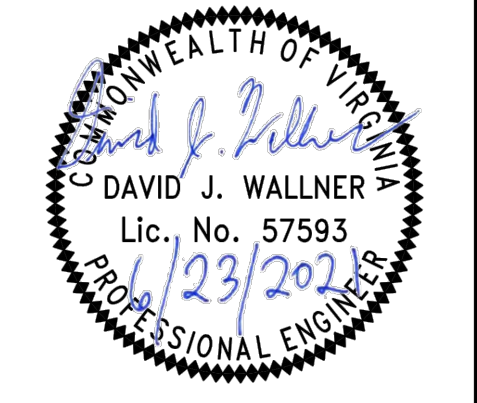


DRAWN BY:	JUZ
CHECKED BY:	RE
APPROVED BY:	DW
DATE:	06/23/2021
SCALE:	AS SHOWN
SHT. NO. 14.70PC	OF 14.77PC

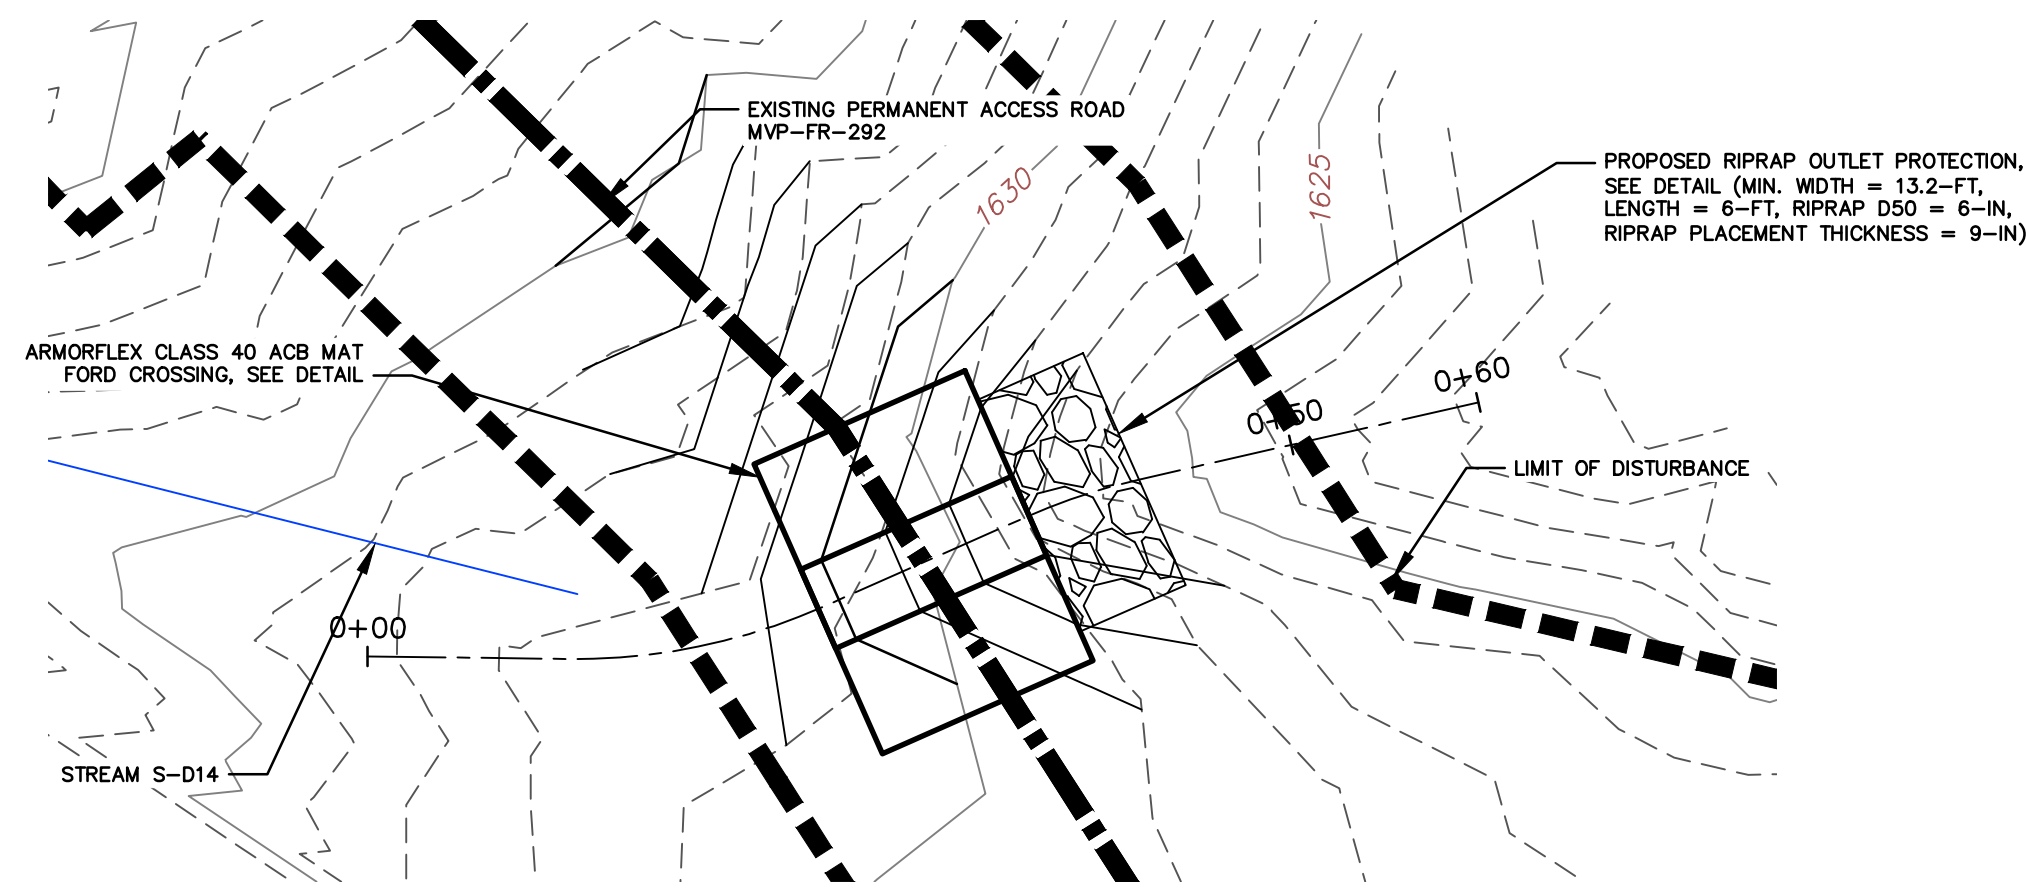


PLAN VIEW
SCALE
0 10 20
SCALE IN FEET

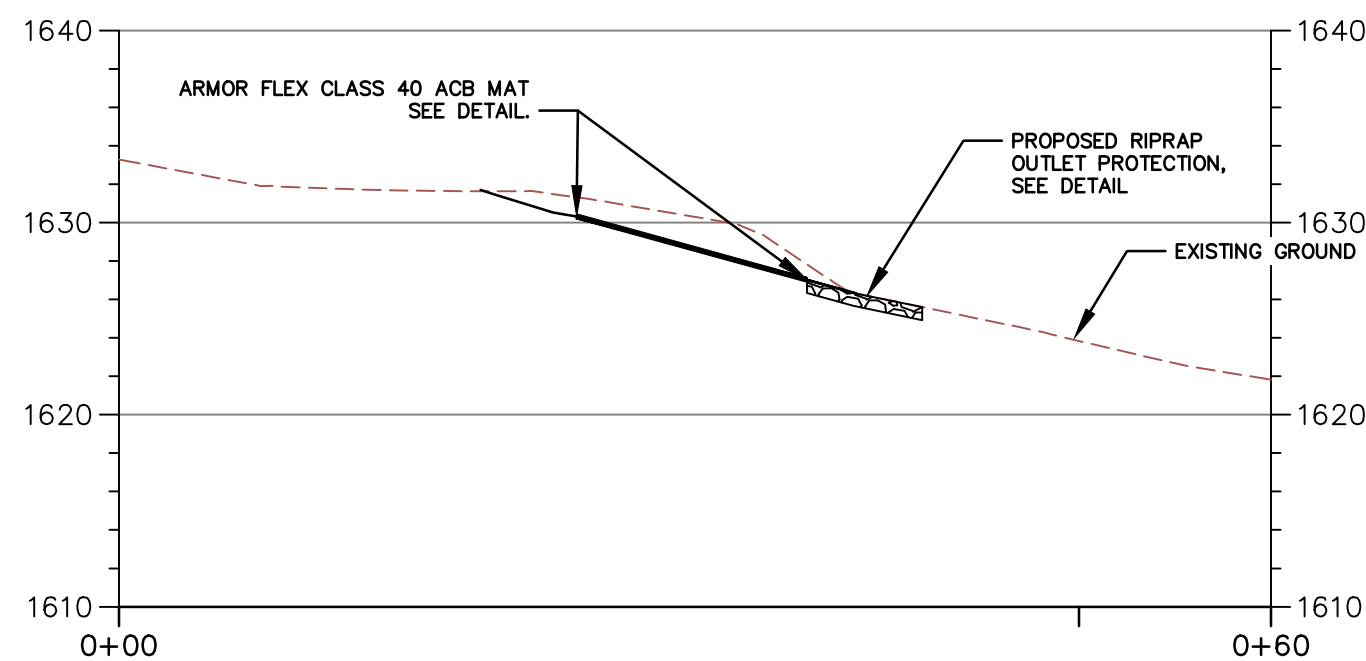


PROFILE VIEW
SCALE
0 10 20
SCALE IN FEET

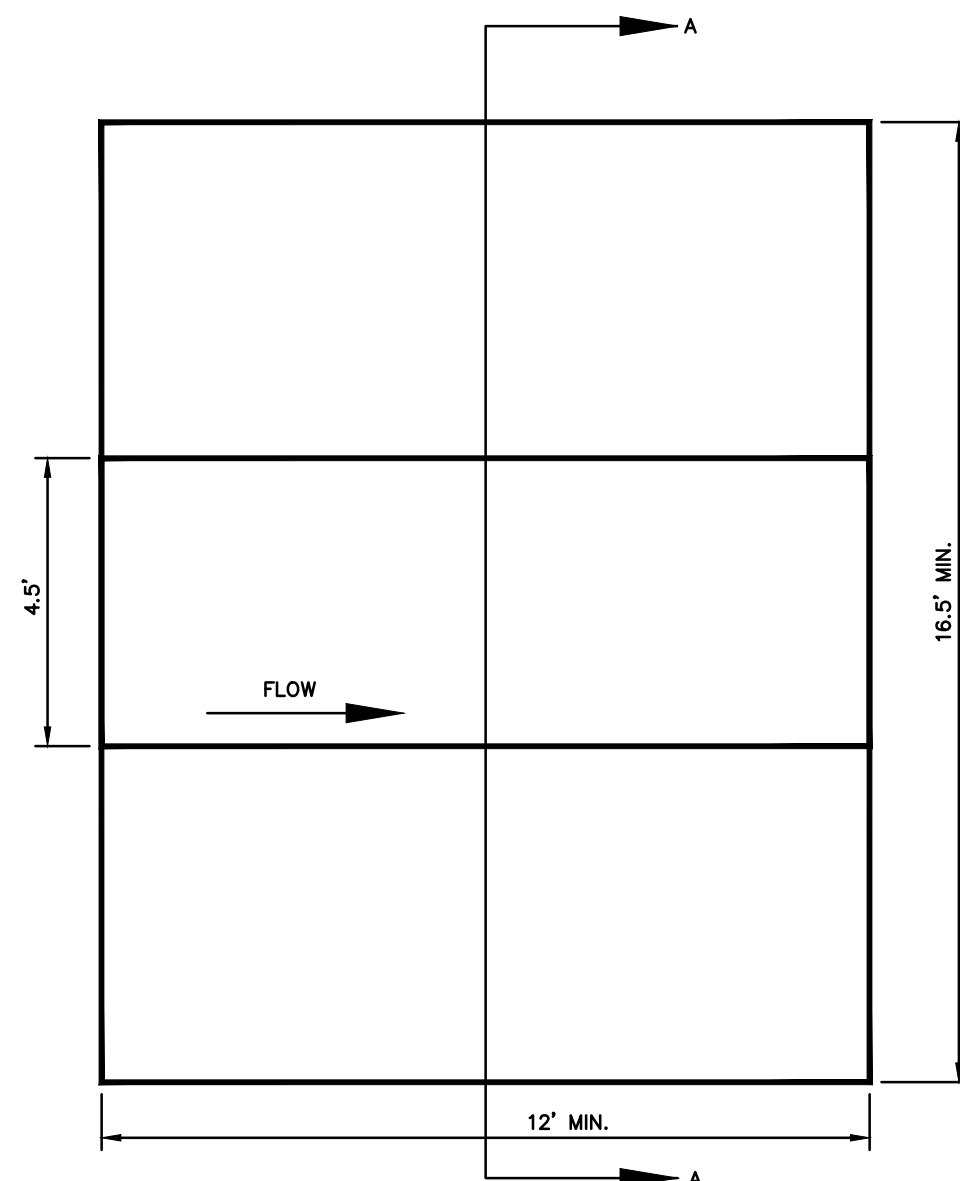

ACB MAT FORD CROSSING PLAN VIEW

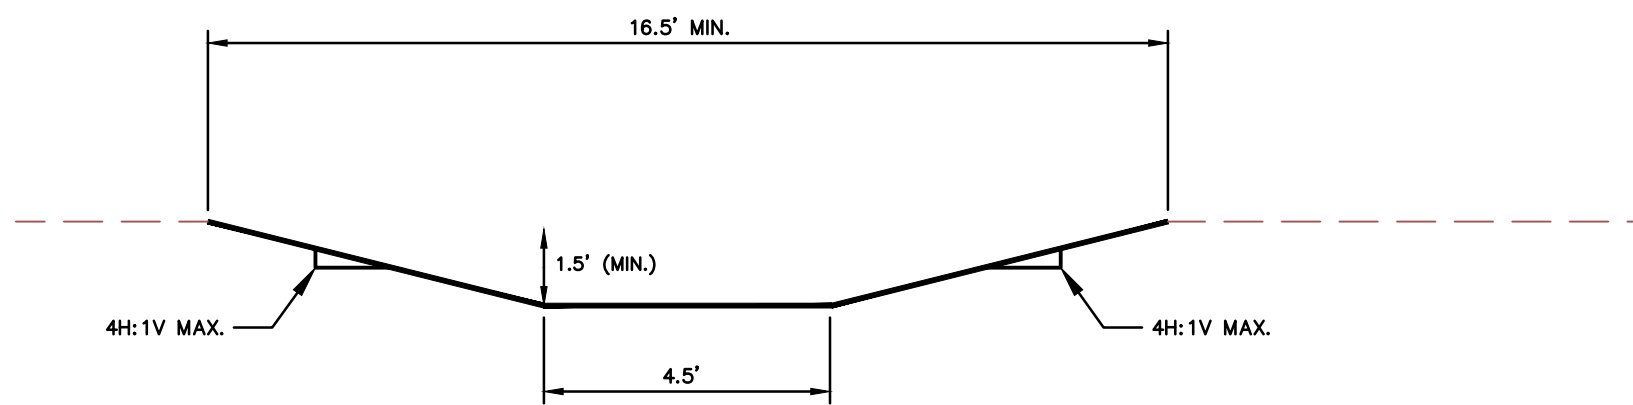


SECTION A-A

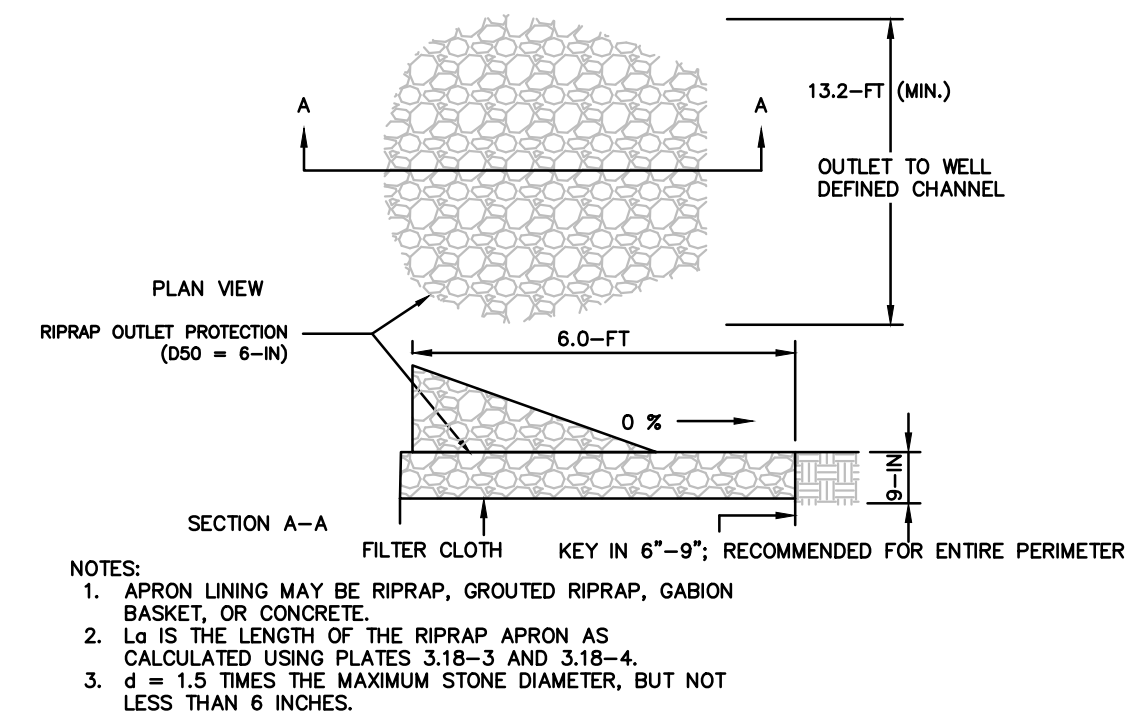


Source: Va. DSWC

Plate 3.18-1


RIPRAP OUTLET PROTECTION DETAIL

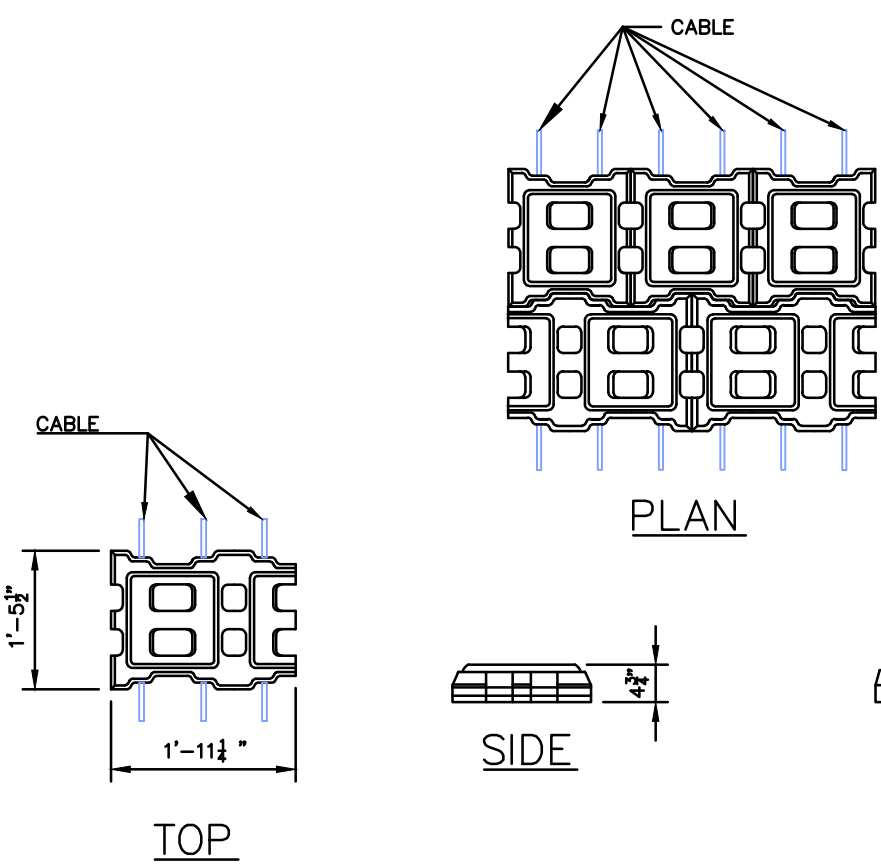


TYP. 40 - 1.5 BLOCK
N.T.S.

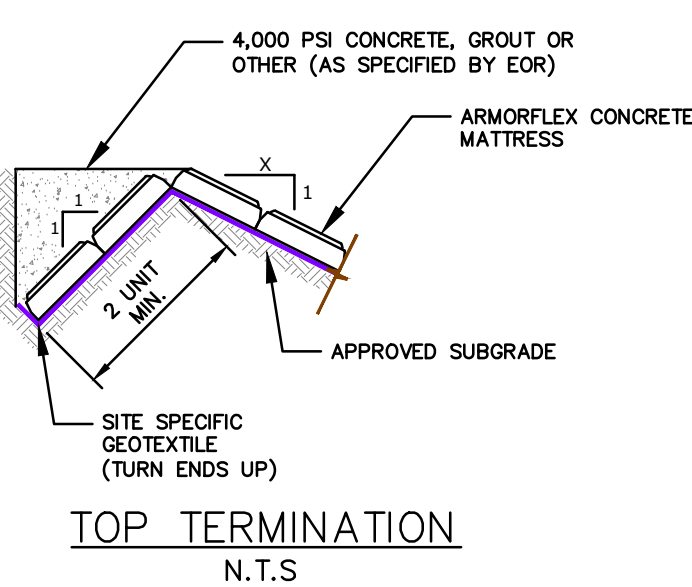


TOP TERMINATION
N.T.S.

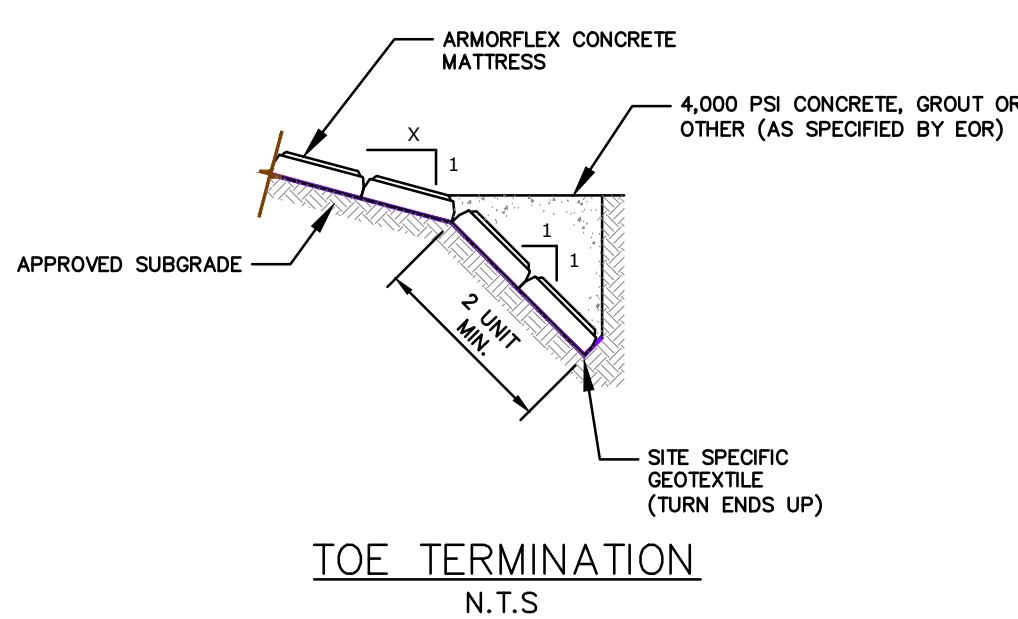


TOE TERMINATION
N.T.S.

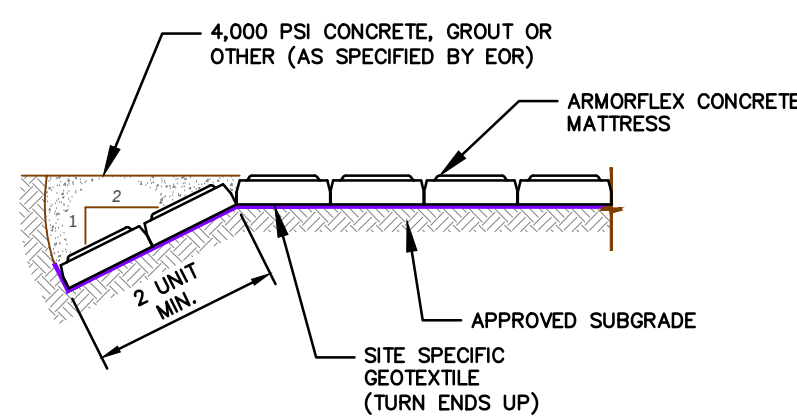


FLANK TERMINATION
N.T.S.

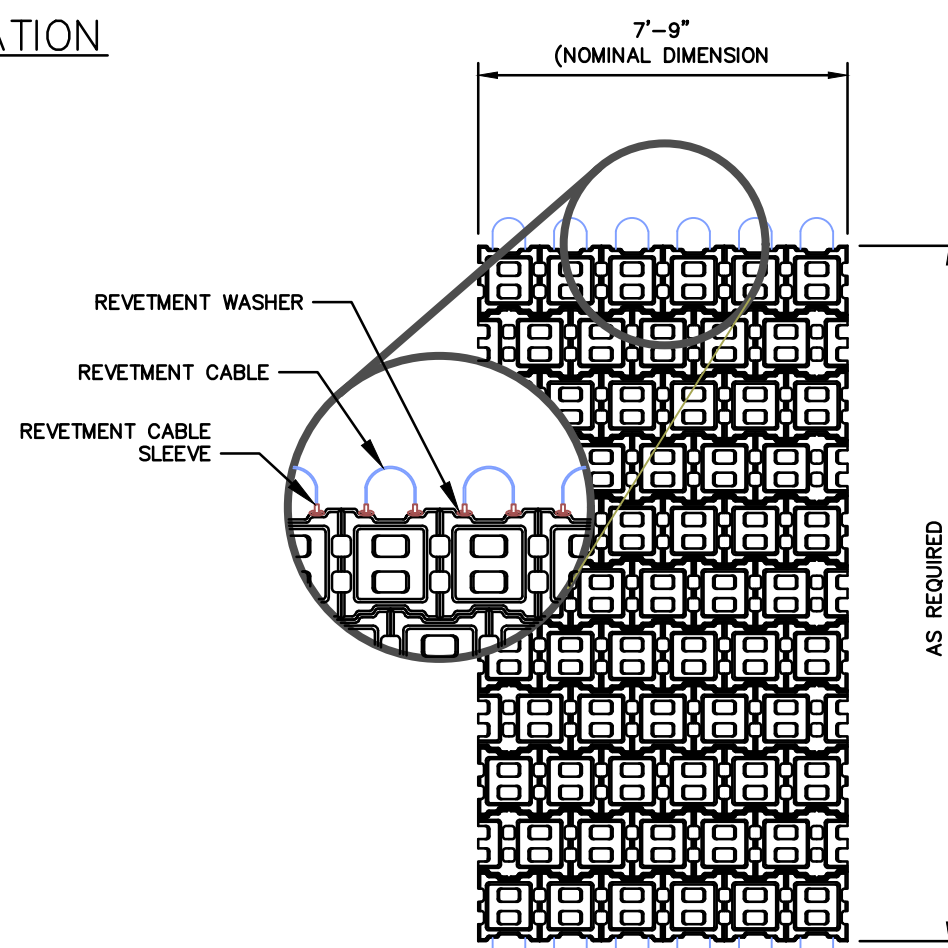

TYP. 40 BLOCK 1.5 MAT
N.T.S.

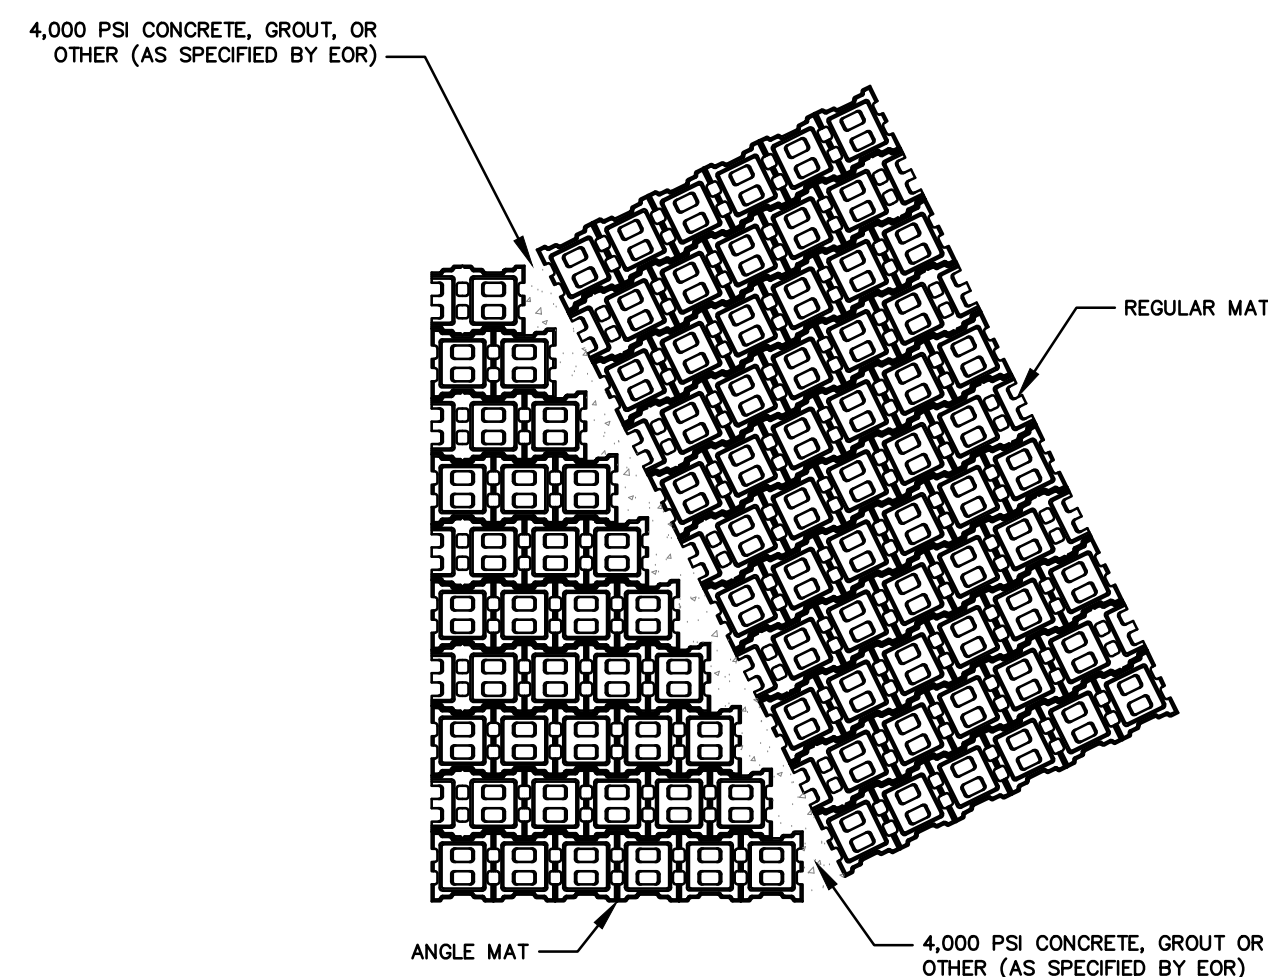

TYP. ANGLE MAT
N.T.S.

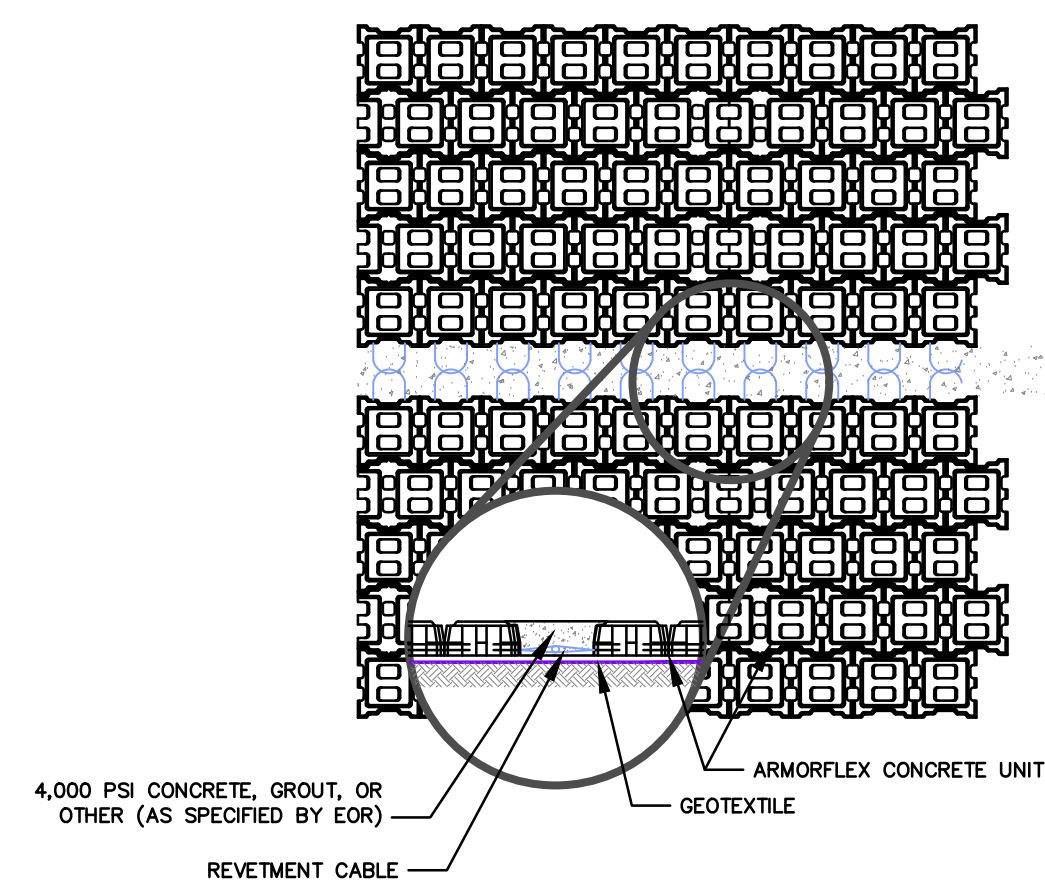

TYP. MAT TO MAT
N.T.S.

--	--	
Date: 06/30/2021

Re: Review of Major Plan Modifications in Virginia

To fulfill the requirement in Mountain Valley Pipeline, LLC's (MVP) Annual Standards & Specifications (AS&S) for the Program Administrator to review and approve major modifications to ESC plans, SWM plans, and SWPPPs, MVP's certified Plan Reviewer has provided me with copies of the major modifications for final review and approval by DEQ. The following revisions have been approved by MVP's certified Plan Reviewer:

Project: Mountain Valley Pipeline Project—H600 Line

Submittal/Modification Name: MVP_FR-292 Ford & S-D14 Mod

Files Included: MVP_FR-292 Ford & S-D14 Mod_14.28 & 14.28A_PC Plans

MVP_FR-292 Ford & S-D14 Mod_14.70 & 14.70A_ESC Plans

MVP_FR-292 Ford & S-D14 Mod_14.70 & 14.70A_PC Plans

MVP_FR-292 Ford & S-D14 Mod_Supporting Calculations

MVP_FR-292 Ford & S-D14 Mod_VA Channel Design Calcs

MVP_FR-292 Ford & S-D14 Mod_Photo Log

MVP_FR-292 Ford & S-D14 Mod_RtC Letter

I have verified that each modification as being consistent with MVP's AS&S. Based on my review of the attached information, I hereby approve the major modifications noted therein.

A handwritten signature in blue ink, appearing to read "Cory Chalmers".

Cory Chalmers
Senior Environmental Coordinator & Lead Program Administrator
Mountain Valley Pipeline

cc: MVP certified Plan Reviewer (email)