
By virtue of this seal and signature, all supporting documents included in this package are accurate and support the design presented herein.

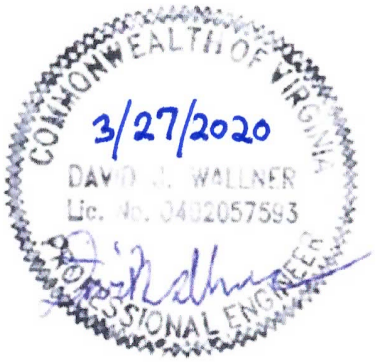

SPREAD H

EXISTING PERMANENT ACCESS ROAD MVP-MN-279.01

EXISTING PERMANENT ACCESS ROAD MVP-MLV-AR-28

EXISTING TEMPORARY ACCESS ROAD MVP-MN-278.01

EXISTING TEMPORARY ACCESS ROAD MVP-RO-281

EXISTING TEMPORARY ACCESS ROAD MVP-RO-282

EXISTING PERMANENT ACCESS ROAD MVP-RO-283

EXISTING TEMPORARY ACCESS ROAD MVP-RO-279.01

EXISTING TEMPORARY ACCESS ROAD MVP-RO-280

EXISTING TEMPORARY ACCESS ROAD MVP-RO-285

EXISTING TEMPORARY ACCESS ROAD MVP-RO-286

PROPOSED TEMPORARY ACCESS ROAD MVP-RO-287

EXISTING PERMANENT ACCESS ROAD MVP-RO-288

EXISTING PERMANENT ACCESS ROAD MVP-FR-290

EXISTING PERMANENT ACCESS ROAD MVP-FR-289

EXISTING PERMANENT ACCESS ROAD MVP-FR-291

EXISTING PERMANENT ACCESS ROAD MVP-FR-292.01

EXISTING PERMANENT ACCESS ROAD MVP-FR-292

EXISTING PERMANENT ACCESS ROAD MVP-FR-293.01

MATCHLINE SHEET 14.02ES

NO.:	DATE:	DWN.:	CHKD.:	APPD.:	DESCRIPTION:
5	03/04/18	KAL	RE	DW	ADDRESS VADEQ COMMENTS
4	02/27/18	KAL	RE	DW	ADDRESS VADEQ COMMENTS
3	02/05/18	KAL	RE	DW	ADDRESS VADEQ COMMENTS
2	11/21/17	KAL	RE	DW	ADDRESS VADEQ COMMENTS
1	09/21/17	KAL	RE	DW	PLAN SUBMISSION

REVISIONS:

Mountain Valley PIPELINE

EROSION AND SEDIMENT CONTROL PLANS

MOUNTAIN VALLEY PIPELINE PROJECT – H600 LINE

SPREAD 10 – MONTGOMERY COUNTY, VIRGINIA

MOUNTAIN VALLEY PIPELINE, LLC
555 SOUTHPOINTE BOULEVARD, SUITE 200
CANONSBURG, PA 15311

TETRA TECH
complex world | CLEAR SOLUTIONS™
661 ANDERSEN DRIVE
FOSTER PLAZA 7
PITTSBURGH, PA 15220

EROSION AND SEDIMENT CONTROL PLANS

COMMONWEALTH OF VIRGINIA
DAVID J. WALLNER
Lic. No. 0402057593
PROFESSIONAL ENGINEER

DRAWN BY:	KAL
CHECKED BY:	RE
APPROVED BY:	DW
DATE:	03/04/2018
SCALE:	AS SHOWN
REVISION	

SHT. NO. 14.01ES OF 14.81ES

TETRA TECH CAD FILE PATH: X:\CADD_Pittsburgh\EOT\7157 – MVP\13 – Montgomery\E&S\E&S Version 5.0.0\7157ES14.01(S10).dwg PLOTTED ON: 3/2/2018 11:09 AM PLOTTED BY: Zeigler, Justin PLOT FILE: ENVIRONMENTAL_COLOR.ctb

SPREAD I

Spread H

Spead I

MATCHLINE SHEET 14.01ES

EXISTING PERMANENT ACCESS ROAD MVP-FR-293.02

EXISTING PERMANENT ACCESS ROAD MVP-MLV-AR-30

EXISTING TEMPORARY ACCESS ROAD MVP-FR-296

EXISTING TEMPORARYACCESS ROAD MVP-FR-302

EXISTING TEMPORARY ACCESS ROAD MVP-FR-295

EXISTING TEMPORARY ACCESS ROAD MVP-FR-294

EXISTING PERMANENT ACCESS ROAD MVP-FR-299

EXISTING PERMANENT ACCESS ROAD MVP-FR-300

EXISTING PERMANENT ACCESS ROAD MVP-FR-303.01

EXISTING TEMPORARY ACCESS ROAD MVP-FR-305

MP 251.5
MP 252.0
MP 252.5
MP 253.0
MP 253.5
MP 254.0
MP 254.5
MP 255.0
MP 255.5
MP 256.0
MP 256.5
MP 257.0
MP 257.5
MP 258.0
MP 258.5
MP 259.0
MP 259.5
MP 260.0
MP 260.5
MP 261.0
MP 261.5
MP 262.0
MP 262.5
MP 263.0
MP 263.5
MP 264.0

14.33 14.34 14.35 14.36 14.37 14.38 14.39 14.40 14.41 14.42 14.43 14.44 14.45 14.46 14.47 14.48 14.49 14.50 14.51 14.52 14.53 14.54 14.55 14.56 14.57 14.71 14.72 14.73 14.74 14.75 14.76 14.77

NO.:	DATE:	DWN.:	CHKD.:	APPD.:	DESCRIPTION:
5	03/04/18	KAL	RE	DW	ADDRESS VADEQ COMMENTS
4	02/27/18	KAL	RE	DW	ADDRESS VADEQ COMMENTS
3	02/05/18	KAL	RE	DW	ADDRESS VADEQ COMMENTS
2	11/21/17	KAL	RE	DW	ADDRESS VADEQ COMMENTS
1	09/21/17	KAL	RE	DW	PLAN SUBMISSION

REVISIONS:

PIPELINE
EROSION AND SEDIMENT CONTROL PLANS
MOUNTAIN VALLEY PIPELINE PROJECT – H600 LINE
SPREAD 10 – MONTGOMERY COUNTY, VIRGINIA

MOUNTAIN VALLEY PIPELINE, LLC
555 SOUTHPOINTE BOULEVARD, SUITE 200
CANONSBURG, PA 15311


TETRA TECH
complex world | CLEAR SOLUTIONS™
661 ANDERSEN DRIVE
FOSTER PLAZA 7
PITTSBURGH, PA 15220

EROSION AND SEDIMENT CONTROL PLANS

COMMONWEALTH OF VIRGINIA
DAVID J. WALLNER
Lic. No. 0402057593
PROFESSIONAL ENGINEER

DRAWN BY:	KAL
CHECKED BY:	RE
APPROVED BY:	DW
DATE:	03/04/2018
SCALE:	AS SHOWN
REVISION	
SHT. NO.	14.02ES OF 14.81ES


TETRA TECH CAD FILE PATH: X:\CADD_Pittsburgh\EOT\7157 – MVP\13 – Montgomery\E&S\E&S Version 5.0.0\7157ES14.02(S10).dwg PLOTTED ON: 3/2/2018 11:10 AM PLOTTED BY: Zeigler, Justin PLOT FILE: ENVIRONMENTAL_COLOR.ctb

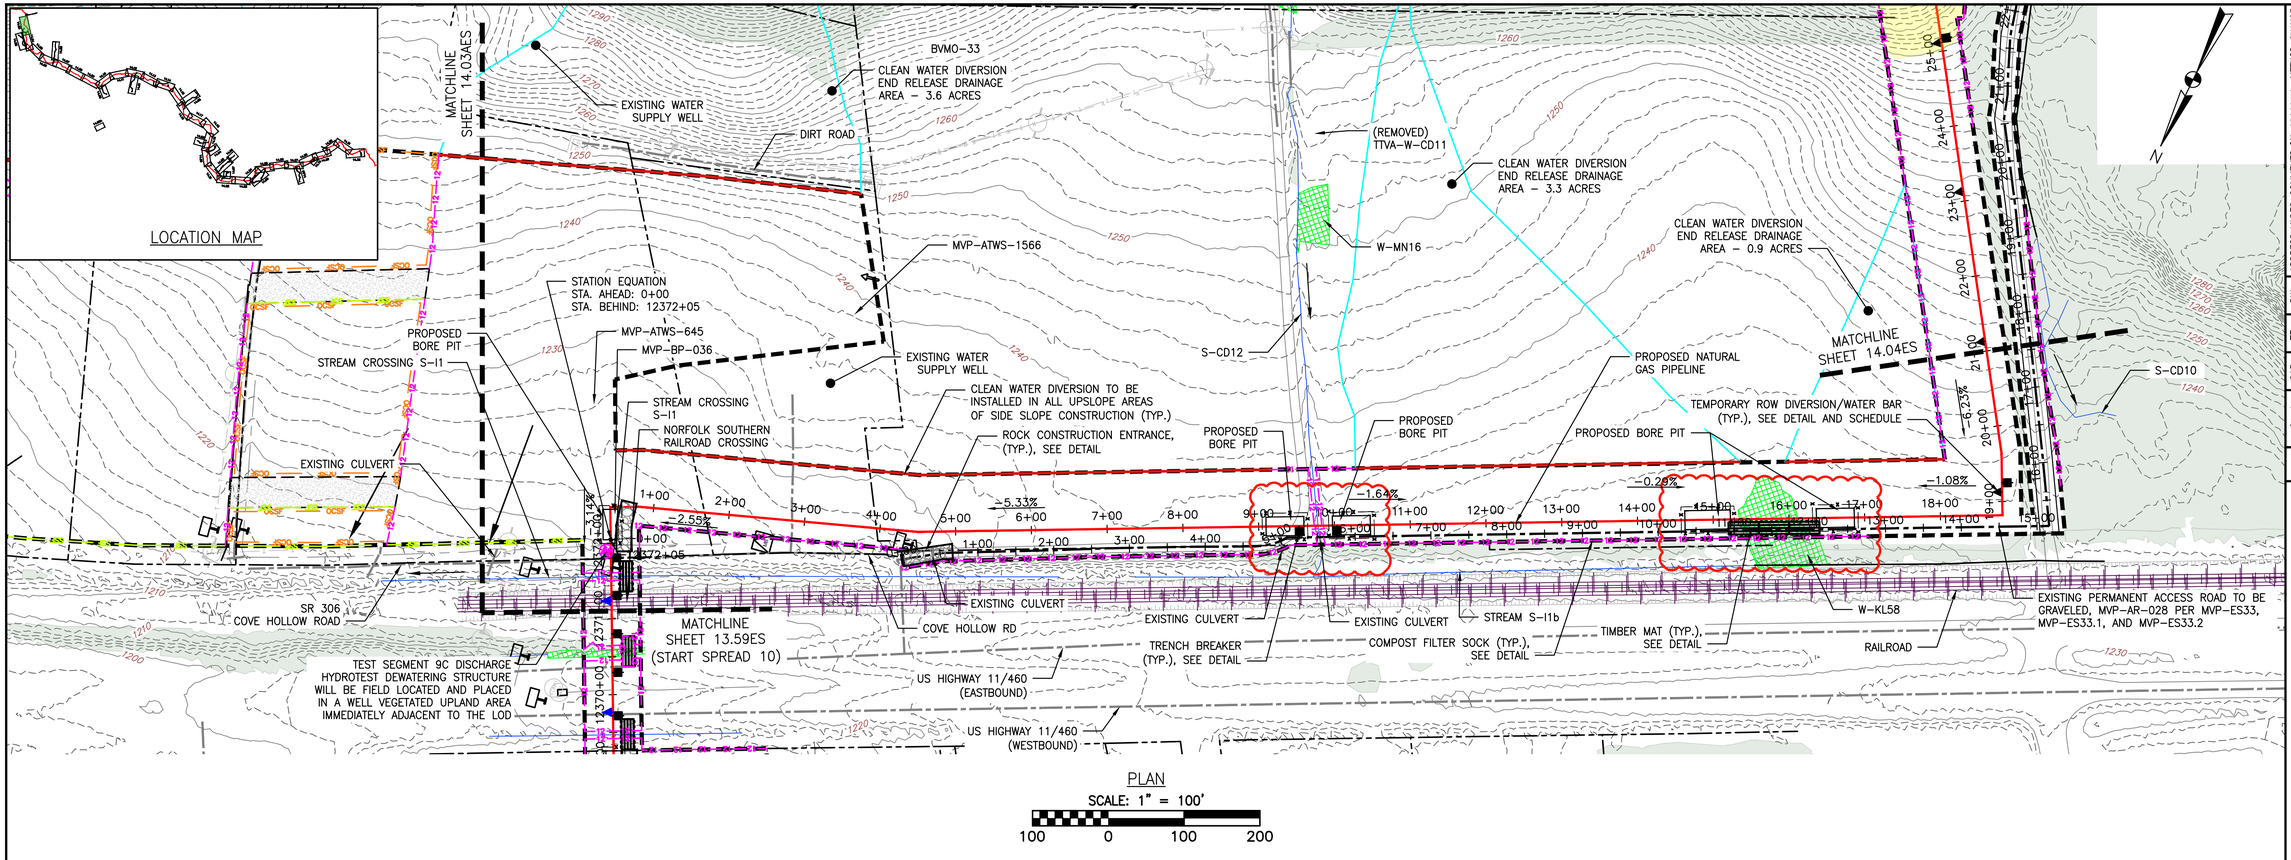

PLAN

SCALE: 1" = 100'

100 0 100 200

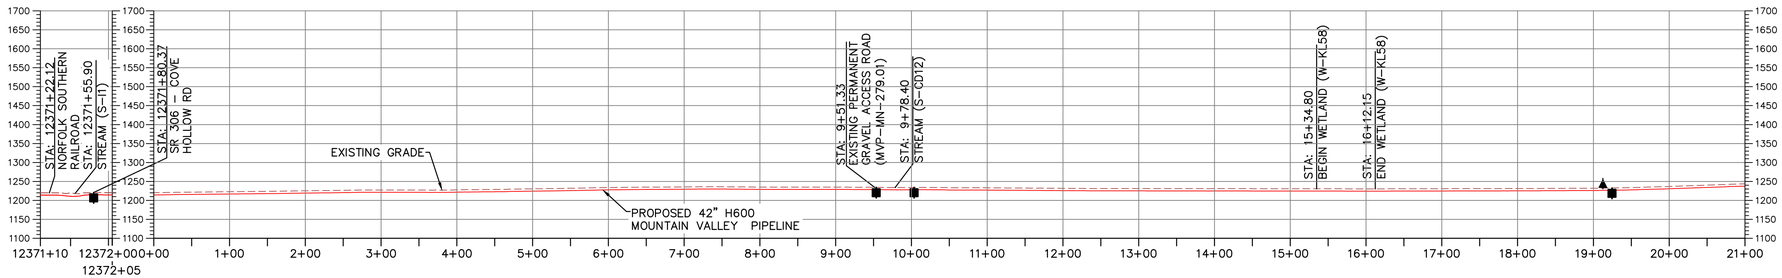

PROFILE

HORIZONTAL SCALE: SCALE: 1" = 100'

100 0 100 200

VERTICAL SCALE: SCALE: 1" = 200'

200 0 200 400

LEGEND

- PROPOSED LIMIT OF DISTURBANCE
- STREAM
- USDA FOREST SERVICE (NATIONAL FOREST) LANDS
- APPALACHIAN NATIONAL SCENIC TRAIL
- EXISTING ROAD/TRAIL
- EXISTING PROPERTY LINE
- EXISTING STATE LINE
- EXISTING COUNTY LINE
- POND
- WETLAND
- ACID FORMING MATERIAL
- EXISTING FOREST
- PROPOSED ACCESS ROAD CENTERLINE
- PROPOSED PIPELINE
- PROPOSED SILT FENCE (SEE NOTE 5)
- PROPOSED SUPER SILT FENCE (SEE DETAIL MVP-ES9.2)
- PROPOSED REINFORCED FILTRATION DEVICE (SEE DETAILS MVP-ES9, 9.1, 9.2, 9.3)
- ORANGE CONSTRUCTION SAFETY FENCE
- PROPOSED COMPOST FILTER SOCK (SEE DETAILS MVP-ES3, 3.1, 3.2)
- PROPOSED COMPOST FILTER SOCK (SEE DETAILS MVP-ES3, 3.1, 3.2)
- PROPOSED COMPOST FILTER SOCK (SEE DETAILS MVP-ES3, 3.1, 3.2)
- GRASS-LINED CHANNEL (SEE DETAIL MVP-ES39)
- CLEAN WATER DIVERSION PIPE
- CLEAN WATER DIVERSION DIKE (SEE DETAIL MVP-ES50 AND MVP-ES51)
- STREAM FLOW DIRECTION
- FEMA 100 YEAR FLOODPLAIN
- DRAINAGE AREA BOUNDARY
- TIMBER MAT (SEE DETAIL MVP-ES37)
- STEEP SLOPE EROSION CONTROL (SEE NOTE 2)
- STEEP SLOPE AREAS (SEE NOTE 4)
- PROPOSED ROCK CONSTRUCTION ENTRANCE
- PROPOSED TRENCH BREAKER (SEE DETAIL MVP-20)
- TEMPORARY ROW DIVERSION/WATER BAR (VADEQ STD & SPEC 3.11)
- PERMANENT SLOPE BREAKER/ROW DIVERSION/WATER BAR (SEE DETAILS MVP-17, ES38, AND SCHEDULE)

COMMONWEALTH OF VIRGINIA
DANIEL C. WITT
Lic. No. 65093
2/1/2023
PROFESSIONAL ENGINEER

THIS SEAL APPLIES ONLY TO REVISIONS DATED 02-01-23

NOTES:

1. TOPSOIL SEGREGATION WILL BE PERFORMED IN ALL IMMEDIATE CONSTRUCTION AREAS OF THE PROJECT IN ACCORDANCE WITH DETAILS MVP-ES46.1 THROUGH MVP-ES46.3.
2. FLEXTERRA, EARTHGUARD OR EQUIVALENT MAY BE USED AS A SUBSTITUTE TO EROSION CONTROL BLANKET AS DIRECTED BY MVP.
3. CONTRACTOR IS RESPONSIBLE TO IDENTIFY ALL UTILITIES. THE UTILITY LINES SHOWN ON THE PLAN ARE FOR INFORMATIONAL PURPOSES ONLY AND DO NOT REPRESENT SURVEYED LINE INFORMATION.
4. SLOPES OF 30" OR GREATER EXIST. CONSTRUCTION FOR STEEP SLOPES TO BE PERFORMED USING STEEP SLOPE TECHNIQUES IDENTIFIED IN THE DETAIL SHEETS. ALSO REFER TO THE SITE-SPECIFIC DESIGN OF STABILIZATION MEASURES IN SELECTED HIGH-HAZARD PORTIONS OF THE ROUTE OF THE PROPOSED MOUNTAIN VALLEY PIPLELINE PROJECT.
5. WHERE CONSTRUCTION CONDITIONS PRECLUDE THE USE OF DIVERSION DITCHES DUE TO SITE CONDITIONS THE CONTRACTOR WILL INSTALL SILT FENCE AT THE DIRECTION OF MVP.
6. IMPROVEMENTS TO PERMANENT AND TEMPORARY ACCESS ROADS WILL BE PERFORMED PER THE SITE SPECIFIC ACCESS ROAD DETAILS.
7. TEMPORARY ACCESS ROAD CROSSING OF STREAMS AND WETLANDS WILL UTILIZE TIMBERMATS. ANY PERMANENT ROAD CROSSINGS WILL BE CONDUCTED VIA CULVERTS.
8. ALL NON VMRC STREAM CROSSINGS WILL BE PERFORMED AS DESCRIBED IN THE STREAM CROSSING TABLE INCLUDED IN THIS PACKAGE.

NO.:	DATE:	DWN.:	CHKD.:	APPD.:	DESCRIPTION:
–	02/01/23	GAR	TD	DW	ADDRESS VADEQ COMMENTS ON CROSSING METHOD CHANGE
–	05/12/21	GAR	RE	DW	CROSSING METHOD CHANGE FROM OPEN CUT TO BORE
7	06/22/18	KAL	RE	DW	FIELD MODIFICATION
6	03/16/18	KAL	RE	DW	ADDRESS VADEQ COMMENTS
5	03/04/18	KAL	RE	DW	ADDRESS VADEQ COMMENTS
4	02/27/18	KAL	RE	DW	ADDRESS VADEQ COMMENTS

REVISIONS:

Mountain Valley PIPELINE

EROSION AND SEDIMENT CONTROL PLANS

MOUNTAIN VALLEY PIPELINE PROJECT – H600 LINE

SPREAD 10 – MONTGOMERY COUNTY, VIRGINIA

MOUNTAIN VALLEY PIPELINE, LLC
2200 ENERGY DRIVE
CANONSBURG, PA 15311

TETRA TECH
complex world | CLEAR SOLUTIONS™
661 ANDERSEN DRIVE
FOSTER PLAZA 7
PITTSBURGH, PA 15220


EROSION AND SEDIMENT CONTROL PLANS

COMMONWEALTH OF VIRGINIA
DAVID J. WALLNER
Lic. No. 57593
5/12/2023
PROFESSIONAL ENGINEER

DRAWN BY:	GAR
CHECKED BY:	RE
APPROVED BY:	DW
DATE:	02/01/2023
SCALE:	AS SHOWN
REVISION	7
SHT. NO.	14.03ES OF 14.81ES

TETRA TECH CAD FILE PATH: X:\CADD_Pittsburgh\EQT\7157 – MVP\13 – Montgomery\E&S\E&S Version 5.0.0\7157ES14.03(S10).dwg PLOTTED ON: 9/15/2022 2:08 PM PLOTTED BY: Zeigler, Justin PLOT FILE: ENVIRONMENTAL_COLOR.ctb

LOCATION MAP

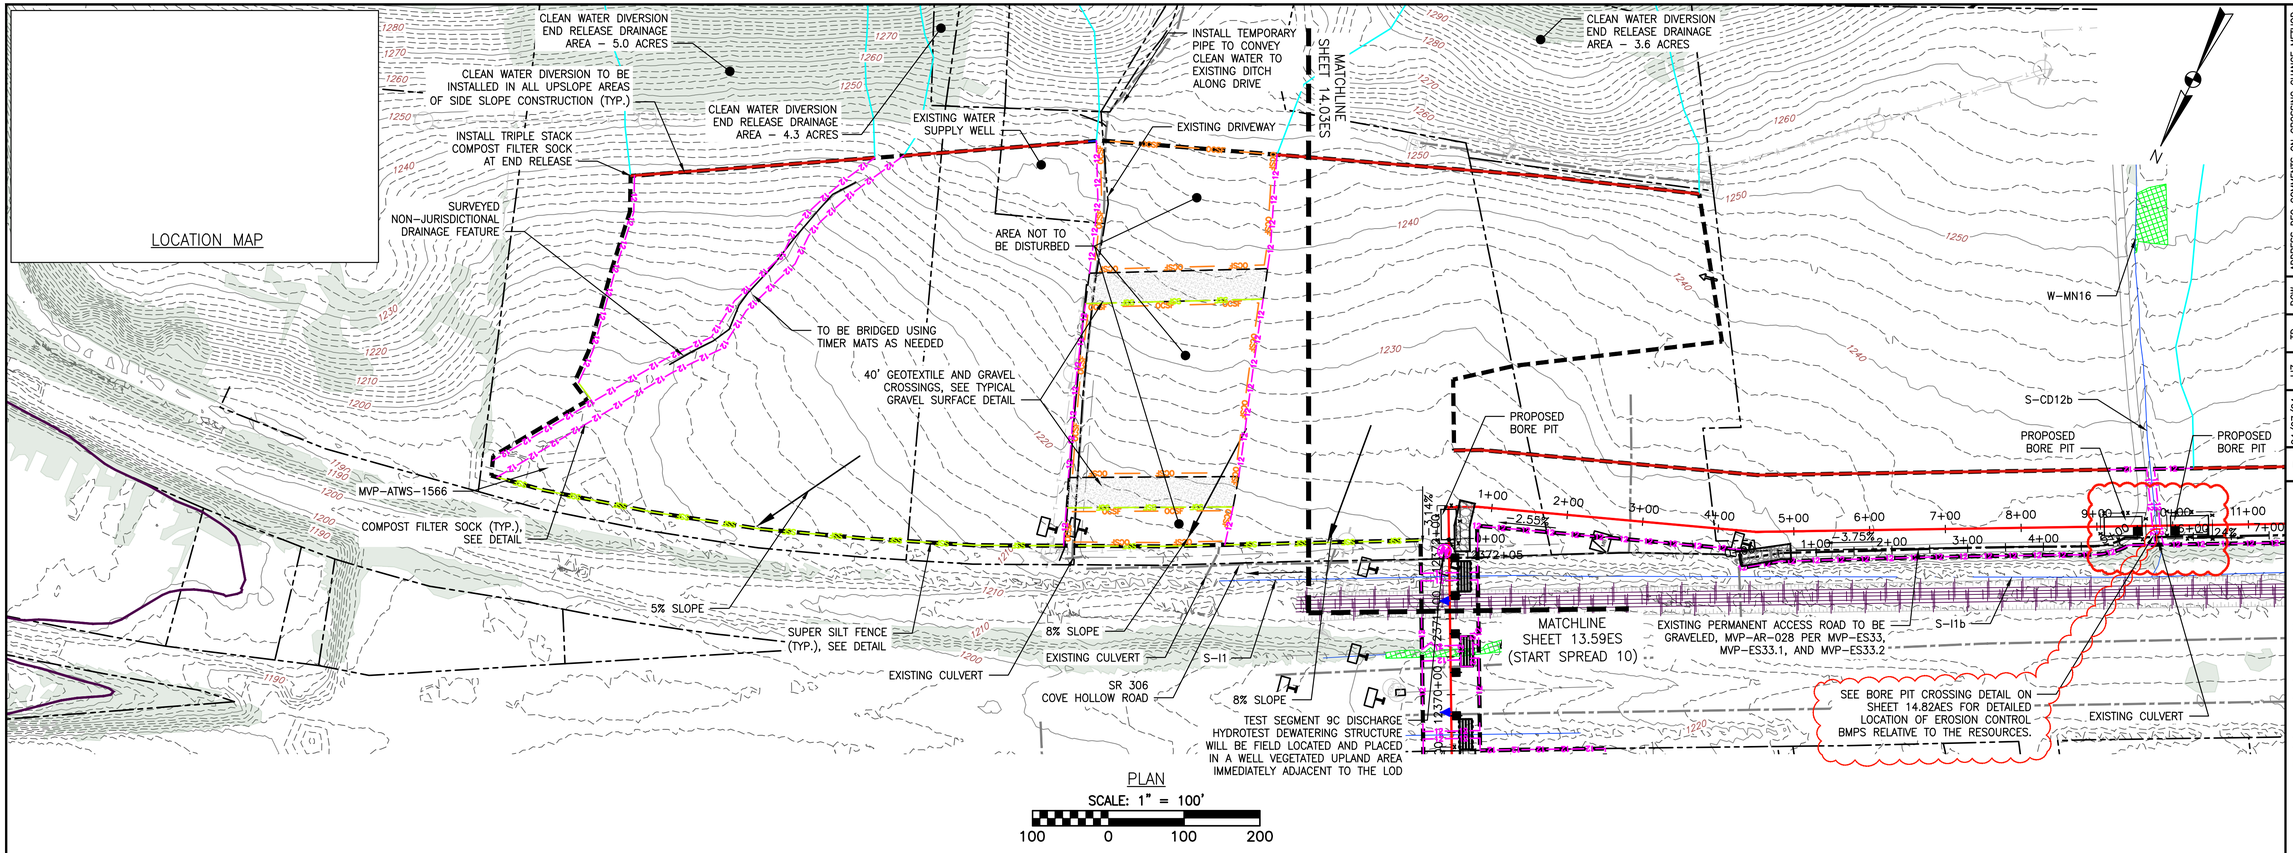

PLAN

SCALE: 1" = 100'

100 0 100 200

LEGEND

- PROPOSED LIMIT OF DISTURBANCE
- STREAM
- USDA FOREST SERVICE (NATIONAL FOREST) LANDS
- APPALACHIAN NATIONAL SCENIC TRAIL
- EXISTING ROAD/TRAIL
- EXISTING PROPERTY LINE
- EXISTING STATE LINE
- EXISTING COUNTY LINE
- POND
- WETLAND
- ACID FORMING MATERIAL
- EXISTING FOREST
- PROPOSED ACCESS ROAD CENTERLINE
- PROPOSED PIPELINE
- PROPOSED SILT FENCE (SEE NOTE 5)
- PROPOSED SUPER SILT FENCE (SEE DETAIL MVP–ES9.2)
- PROPOSED REINFORCED FILTRATION DEVICE (SEE DETAILS MVP–ES9, 9.1, 9.2, 9.3)
- ORANGE CONSTRUCTION SAFETY FENCE
- PROPOSED COMPOST FILTER SOCK (SEE DETAILS MVP–ES3, 3.1, 3.2)
- PROPOSED COMPOST FILTER SOCK (SEE DETAILS MVP–ES3, 3.1, 3.2)
- PROPOSED COMPOST FILTER SOCK (SEE DETAILS MVP–ES3, 3.1, 3.2)
- GRASS–LINED CHANNEL (SEE DETAIL MVP–ES39)
- CLEAN WATER DIVERSION PIPE
- CLEAN WATER DIVERSION DIKE (SEE DETAIL MVP–ES50 AND MVP–ES51)
- STREAM FLOW DIRECTION
- FEMA 100 YEAR FLOODPLAIN
- DRAINAGE AREA BOUNDARY
- TIMBER MAT (SEE DETAIL MVP–ES37)
- STEEP SLOPE EROSION CONTROL (SEE NOTE 2)
- STEEP SLOPE AREAS (SEE NOTE 4)
- PROPOSED ROCK CONSTRUCTION ENTRANCE
- PROPOSED TRENCH BREAKER (SEE DETAIL MVP–20)
- TEMPORARY ROW DIVERSION/WATER BAR (VADEQ STD & SPEC 3.11)
- PERMANENT SLOPE BREAKER/ROW DIVERSION/WATER BAR (SEE DETAILS MVP–17, ES38, AND SCHEDULE)

NOTES:

1. TOPSOIL SEGREGATION WILL BE PERFORMED IN ALL IMMEDIATE CONSTRUCTION AREAS OF THE PROJECT IN ACCORDANCE WITH DETAILS MVP–ES46.1 THROUGH MVP–ES46.3.
2. FLEXTERRA, EARTHGUARD OR EQUIVALENT MAY BE USED AS A SUBSTITUTE TO EROSION CONTROL BLANKET AS DIRECTED BY MVP.
3. CONTRACTOR IS RESPONSIBLE TO IDENTIFY ALL UTILITIES. THE UTILITY LINES SHOWN ON THE PLAN ARE FOR INFORMATIONAL PURPOSES ONLY AND DO NOT REPRESENT SURVEYED LINE INFORMATION.
4. SLOPES OF 30" OR GREATER EXIST. CONSTRUCTION FOR STEEP SLOPES TO BE PERFORMED USING STEEP SLOPE TECHNIQUES IDENTIFIED IN THE DETAIL SHEETS. ALSO REFER TO THE SITE–SPECIFIC DESIGN OF STABILIZATION MEASURES IN SELECTED HIGH–HAZARD PORTIONS OF THE ROUTE OF THE PROPOSED MOUNTAIN VALLEY PIPELINE PROJECT.
5. WHERE CONSTRUCTION CONDITIONS PRECLUDE THE USE OF DIVERSION DITCHES DUE TO SITE CONDITIONS THE CONTRACTOR WILL INSTALL SILT FENCE AT THE DIRECTION OF MVP.
6. IMPROVEMENTS TO PERMANENT AND TEMPORARY ACCESS ROADS WILL BE PERFORMED PER THE SITE SPECIFIC ACCESS ROAD DETAILS.
7. TEMPORARY ACCESS ROAD CROSSING OF STREAMS AND WETLANDS WILL UTILIZE TIMBERMATS. ANY PERMANENT ROAD CROSSINGS WILL BE CONDUCTED VIA CULVERTS.
8. ALL NON VMRC STREAM CROSSINGS WILL BE PERFORMED AS DESCRIBED IN THE STREAM CROSSING TABLE INCLUDED IN THIS PACKAGE.

COMMONWEALTH OF VIRGINIA
4/7/23
DANIEL C. WITT
Lic. No. 65093
PROFESSIONAL ENGINEER

THIS SEAL APPLIES ONLY TO REVISIONS DATED 04–07–2023

NO.:	DATE:	DWN.:	CHKD.:	APPD.:	DESCRIPTION:
–	04/07/24	JJZ	TD	DCW	ADDRESS DEQ COMMENTS ON CROSSING CHANGE METHOD
–	05/12/21	CAR	RE	DW	CROSSING METHOD CHANGE FROM OPEN CUT TO BORE
7	06/22/18	KAL	RE	DW	FIELD MODIFICATION
6	03/16/18	KAL	RE	DW	ADDRESS VADEQ COMMENTS
5	03/04/18	KAL	RE	DW	ADDRESS VADEQ COMMENTS
4	02/27/18	KAL	RE	DW	ADDRESS VADEQ COMMENTS

REVISIONS:

Mountain Valley PIPELINE

EROSION AND SEDIMENT CONTROL PLANS
MOUNTAIN VALLEY PIPELINE PROJECT – H600 LINE
SPREAD 10 – MONTGOMERY COUNTY, VIRGINIA

MOUNTAIN VALLEY PIPELINE, LLC
2200 ENERGY DRIVE
CANONSBURG, PA 15311

TETRA TECH
complex world | CLEAR SOLUTIONS™
661 ANDERSEN DRIVE
FOSTER PLAZA 7
PITTSBURGH, PA 15220

EROSION AND SEDIMENT CONTROL PLANS


COMMONWEALTH OF VIRGINIA
DAVID J. WALLNER
Lic. No. 57593
PROFESSIONAL ENGINEER
5/12/2021

DRAWN BY:	JZ
CHECKED BY:	TD
APPROVED BY:	DCW
DATE:	04/07/2023
SCALE:	AS SHOWN

REVISION

SHT. NO. 14.03AES OF 14.81ES


TETRA TECH CAD FILE PATH: X:\CADD_Pittsburgh\EQT\7157 – MVP\13 – Montgomery\E&S\E&S Version 5.0.0\7157ES14.03A(S10).dwg PLOTTED ON: 3/31/2023 2:20 PM PLOTTED BY: Zeigler, Justin PLOT FILE: ENVIRONMENTAL_COLOR.ctb

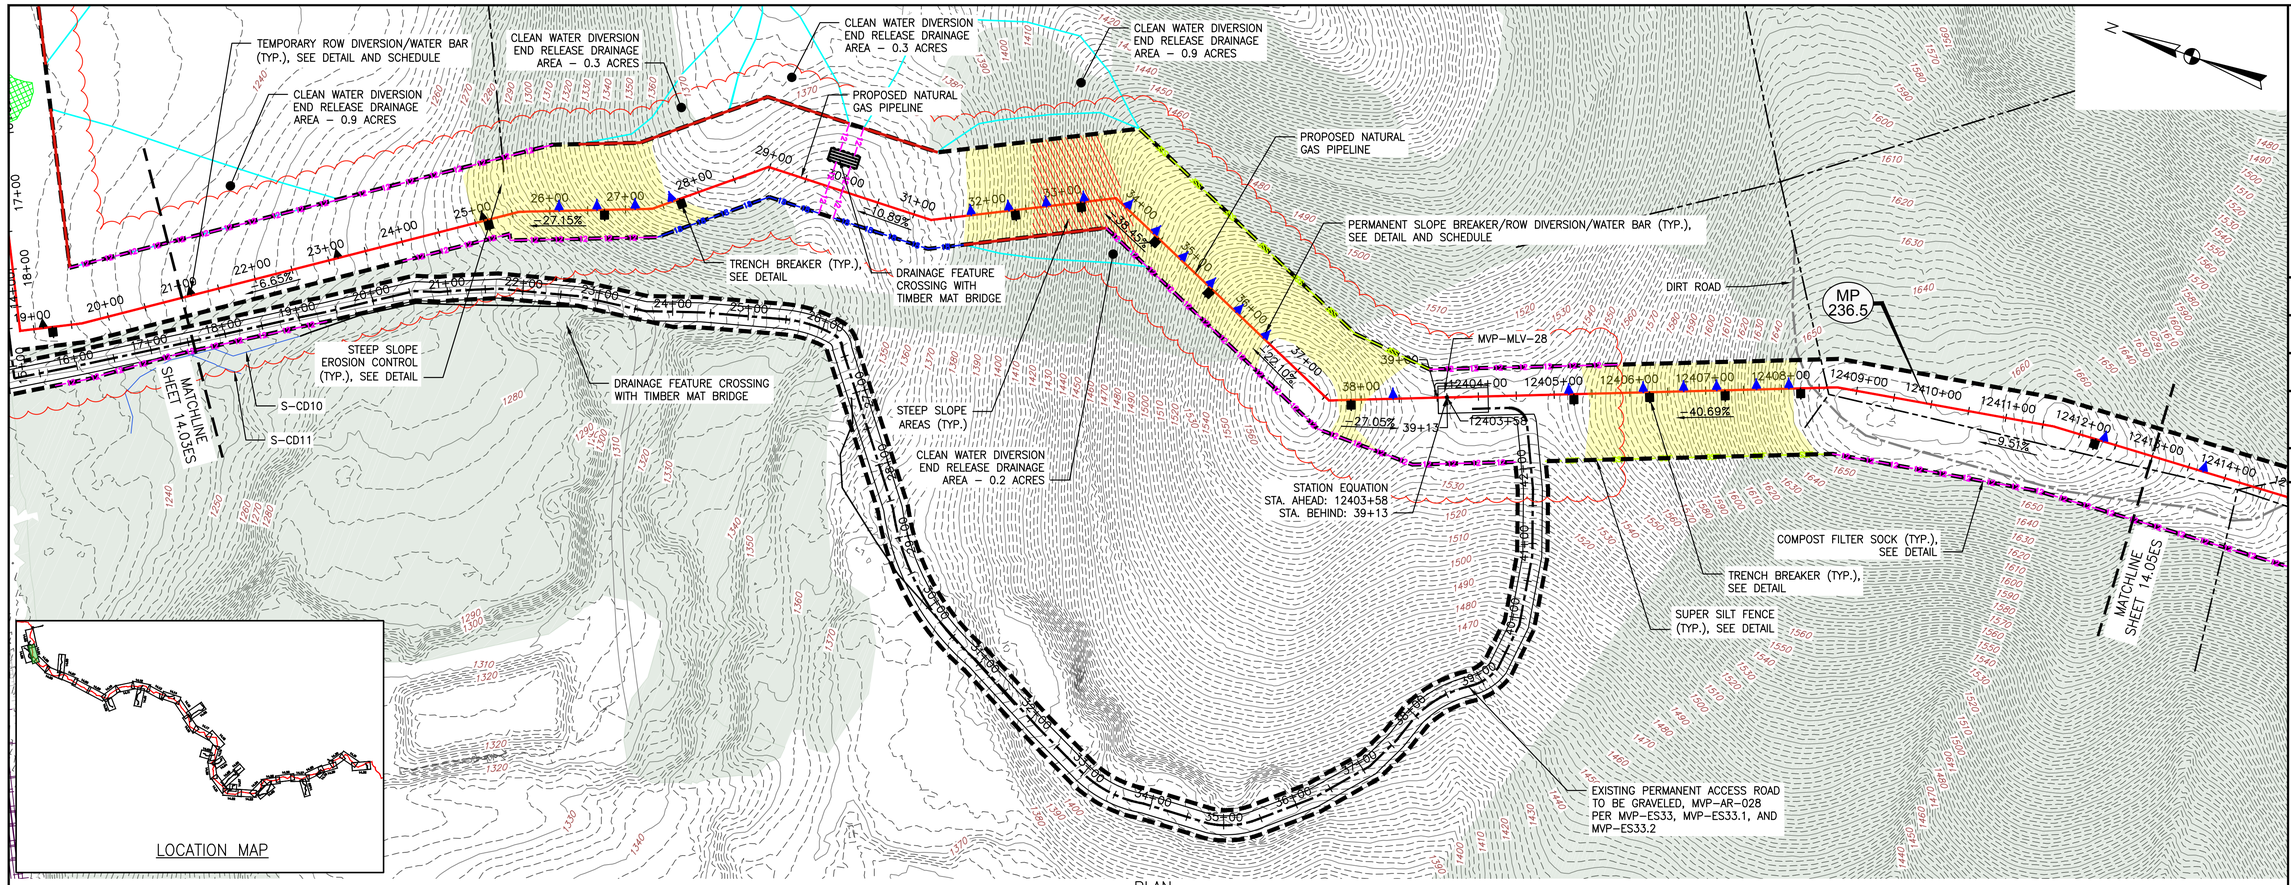

PLAN

SCALE: 1" = 100'

100 0 100 200

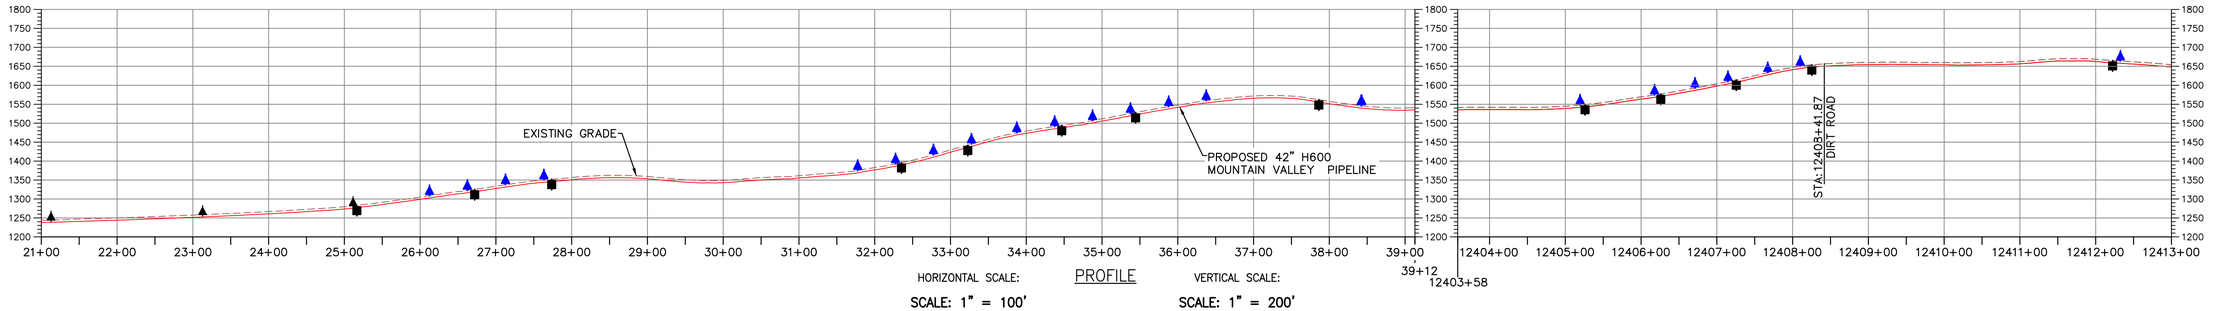

HORIZONTAL SCALE: SCALE: 1" = 100'

100 0 100 200

PROFILE

VERTICAL SCALE: SCALE: 1" = 200'

200 0 200 400

LEGEND

- PROPOSED LIMIT OF DISTURBANCE
- STREAM
- USDA FOREST SERVICE (NATIONAL FOREST) LANDS
- APPALACHIAN NATIONAL SCENIC TRAIL
- EXISTING ROAD/TRAIL
- EXISTING PROPERTY LINE
- EXISTING STATE LINE
- EXISTING COUNTY LINE
- POND
- WETLAND
- ACID FORMING MATERIAL
- EXISTING FOREST
- PROPOSED ACCESS ROAD CENTERLINE
- PROPOSED PIPELINE
- PROPOSED SILT FENCE (SEE NOTE 5)
- PROPOSED SUPER SILT FENCE (SEE DETAIL MVP-ES9.2)
- PROPOSED REINFORCED FILTRATION DEVICE (SEE DETAILS MVP-ES9, 9.1, 9.2, 9.3)
- ORANGE CONSTRUCTION SAFETY FENCE
- PROPOSED COMPOST FILTER SOCK (SEE DETAILS MVP-ES3, 3.1, 3.2)
- PROPOSED COMPOST FILTER SOCK (SEE DETAILS MVP-ES3, 3.1, 3.2)
- PROPOSED COMPOST FILTER SOCK (SEE DETAILS MVP-ES3, 3.1, 3.2)
- GRASS-LINED CHANNEL (SEE DETAIL MVP-ES39)
- CLEAN WATER DIVERSION PIPE
- CLEAN WATER DIVERSION DIKE (SEE DETAIL MVP-ES50 AND MVP-ES51)
- STREAM FLOW DIRECTION
- FEMA 100 YEAR FLOODPLAIN
- DRAINAGE AREA BOUNDARY
- TIMBER MAT (SEE DETAIL MVP-ES37)
- STEEP SLOPE EROSION CONTROL (SEE NOTE 2)
- STEEP SLOPE AREAS (SEE NOTE 4)
- PROPOSED ROCK CONSTRUCTION ENTRANCE
- PROPOSED TRENCH BREAKER (SEE DETAIL MVP-20)
- TEMPORARY ROW DIVERSION/WATER BAR (VADEQ STD & SPEC 3.11)
- PERMANENT SLOPE BREAKER/ROW DIVERSION/WATER BAR (SEE DETAILS MVP-17, ES38, AND SCHEDULE)

NOTES:

1. TOPSOIL SEGREGATION WILL BE PERFORMED IN ALL IMMEDIATE CONSTRUCTION AREAS OF THE PROJECT IN ACCORDANCE WITH DETAILS MVP-ES46.1 THROUGH MVP-ES46.3.
2. FLEXTERRA, EARTHGUARD OR EQUIVALENT MAY BE USED AS A SUBSTITUTE TO EROSION CONTROL BLANKET AS DIRECTED BY MVP.
3. CONTRACTOR IS RESPONSIBLE TO IDENTIFY ALL UTILITIES. THE UTILITY LINES SHOWN ON THE PLAN ARE FOR INFORMATIONAL PURPOSES ONLY AND DO NOT REPRESENT SURVEYED LINE INFORMATION.
4. SLOPES OF 30° OR GREATER EXIST. CONSTRUCTION FOR STEEP SLOPES TO BE PERFORMED USING STEEP SLOPE TECHNIQUES IDENTIFIED IN THE DETAIL SHEETS. ALSO REFER TO THE SITE-SPECIFIC DESIGN OF STABILIZATION MEASURES IN SELECTED HIGH-HAZARD PORTIONS OF THE ROUTE OF THE PROPOSED MOUNTAIN VALLEY PIPELINE PROJECT.
5. WHERE CONSTRUCTION CONDITIONS PRECLUDE THE USE OF DIVERSION DITCHES DUE TO SITE CONDITIONS THE CONTRACTOR WILL INSTALL SILT FENCE AT THE DIRECTION OF MVP.
6. IMPROVEMENTS TO PERMANENT AND TEMPORARY ACCESS ROADS WILL BE PERFORMED PER THE SITE SPECIFIC ACCESS ROAD DETAILS.
7. TEMPORARY ACCESS ROAD CROSSING OF STREAMS AND WETLANDS WILL UTILIZE TIMBERMATS. ANY PERMANENT ROAD CROSSINGS WILL BE CONDUCTED VIA CULVERTS.
8. ALL NON VMRC STREAM CROSSINGS WILL BE PERFORMED AS DESCRIBED IN THE STREAM CROSSING TABLE INCLUDED IN THIS PACKAGE.

TETRA TECH CAD FILE PATH: X:\CADD_Pittsburgh\EQT\7157 – MVP\13 – Montgomery\E&S\E&S Version 5.0.0\7157ES14.04(S10).dwg PLOTTED ON: 7/10/2018 2:52 PM PLOTTED BY: Kusiowski, Jim PLOT FILE: ENVIRONMENTAL_COLOR.ctb

NO.	DATE:	DWN.:	CHKD.:	APPD.:	DESCRIPTION:
7	06/22/18	KAL	RE	DW	ADDRESS VADEQ COMMENTS
6	03/16/18	KAL	RE	DW	ADDRESS VADEQ COMMENTS
5	03/04/18	KAL	RE	DW	ADDRESS VADEQ COMMENTS
4	02/27/18	KAL	RE	DW	ADDRESS VADEQ COMMENTS
3	02/05/18	KAL	RE	DW	ADDRESS VADEQ COMMENTS
2	11/21/17	KAL	RE	DW	FIELD MODIFICATION

REVISIONS:

Mountain Valley PIPELINE

EROSION AND SEDIMENT CONTROL PLANS

MOUNTAIN VALLEY PIPELINE PROJECT – H600 LINE

SPREAD 10 – MONTGOMERY COUNTY, VIRGINIA

MOUNTAIN VALLEY PIPELINE, LLC
555 SOUTHPOINTE BOULEVARD, SUITE 200
CANONSBURG, PA 15311


TETRA TECH
complex world | CLEAR SOLUTIONS™
661 ANDERSEN DRIVE
FOSTER PLAZA 7
PITTSBURGH, PA 15220

EROSION AND SEDIMENT CONTROL PLANS

COMMONWEALTH OF VIRGINIA
DAVID J. WALLNER
Lic. No. 0402057593
PROFESSIONAL ENGINEER

DRAWN BY:	KAL
CHECKED BY:	RE
APPROVED BY:	DW
DATE:	06/22/2018
SCALE:	AS SHOWN
SHT. NO.	14.04ES OF 14.81ES


REVISION

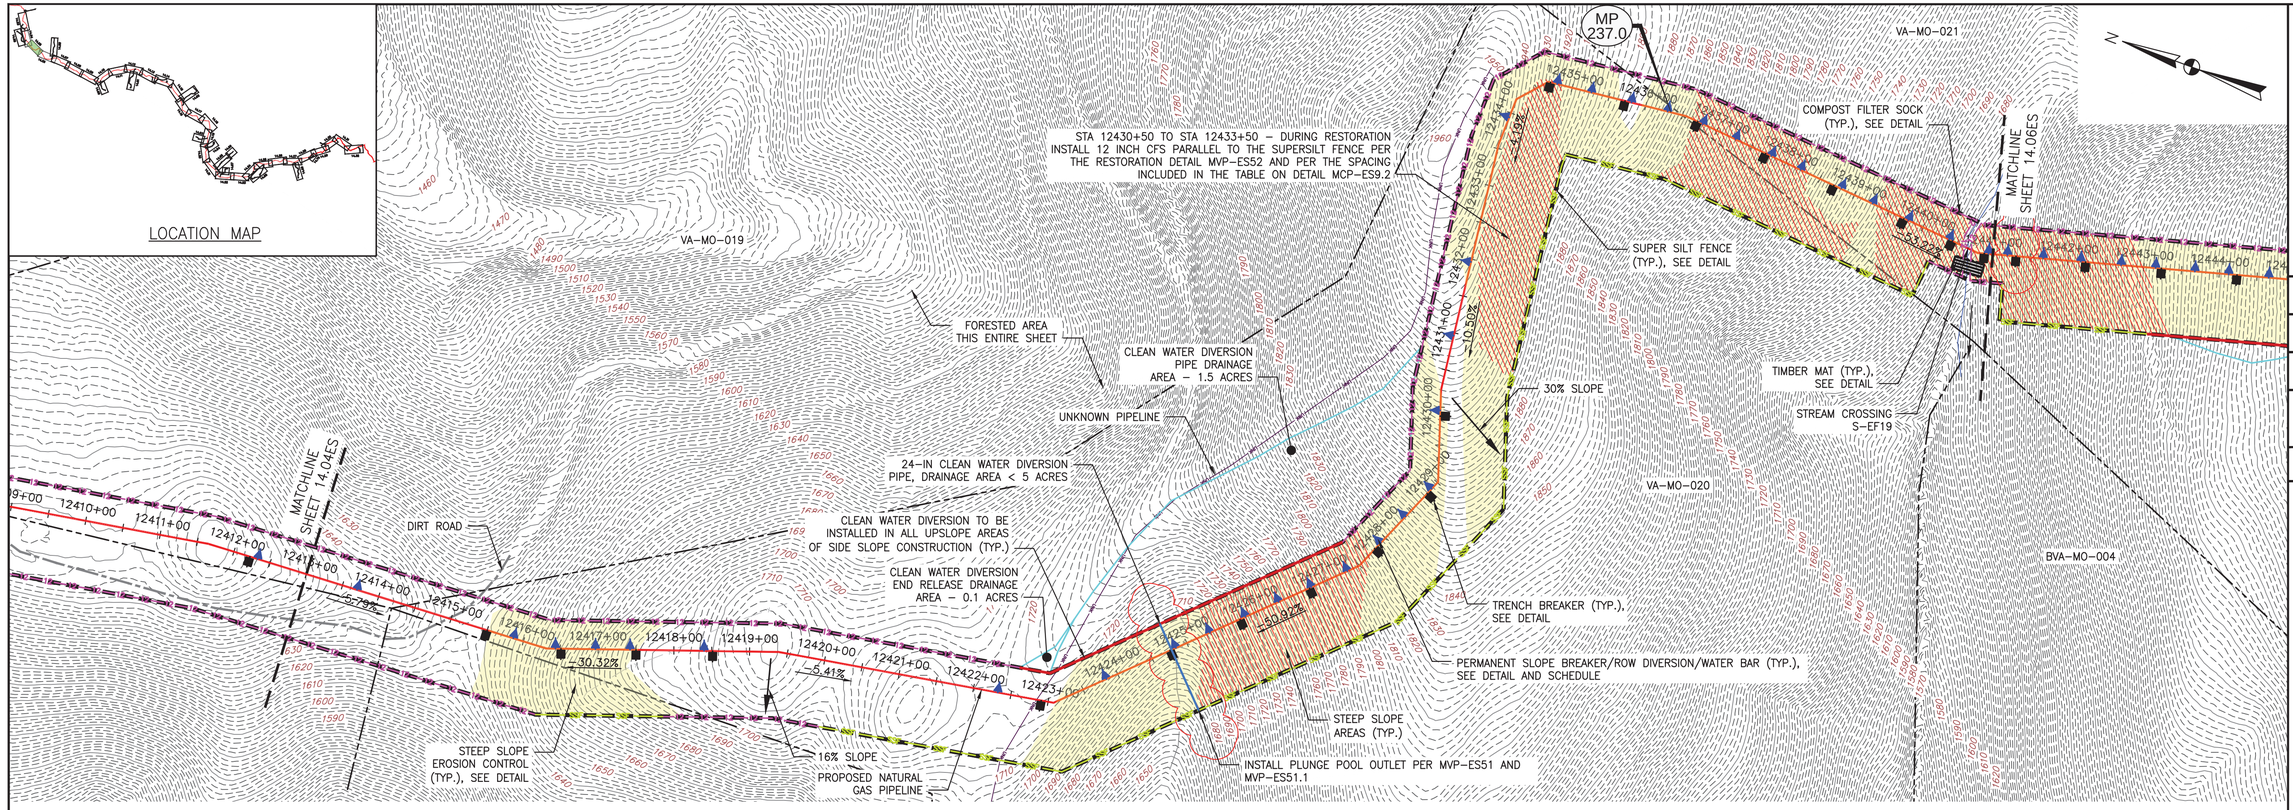

PLAN

SCALE: 1" = 100'

100 0 100 200

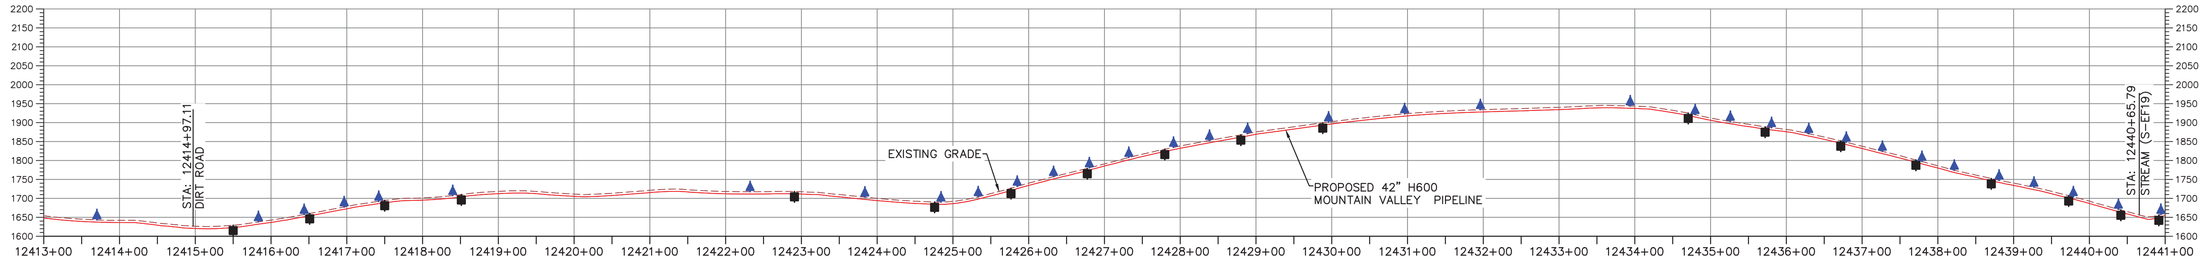

PROFILE

HORIZONTAL SCALE: SCALE: 1" = 100'

100 0 100 200

VERTICAL SCALE: SCALE: 1" = 200'

200 0 200 400

LEGEND

- PROPOSED LIMIT OF DISTURBANCE
- STREAM
- USDA FOREST SERVICE (NATIONAL FOREST) LANDS
- APPALACHIAN NATIONAL SCENIC TRAIL
- EXISTING ROAD/TRAIL
- EXISTING PROPERTY LINE
- EXISTING STATE LINE
- EXISTING COUNTY LINE
- POND
- WETLAND
- ACID FORMING MATERIAL
- AGRICULTURAL LAND USE BOUNDARY
- PROPOSED ACCESS ROAD CENTERLINE
- PROPOSED PIPELINE
- PROPOSED SILT FENCE (SEE NOTE 5)
- PROPOSED SUPER SILT FENCE (SEE DETAIL MVP–ES9.2)
- PROPOSED REINFORCED FILTRATION DEVICE (SEE DETAILS MVP–ES9, 9.1, 9.2, 9.3)
- ORANGE CONSTRUCTION SAFETY FENCE
- PROPOSED COMPOST FILTER SOCK (SEE DETAILS MVP–ES3, 3.1, 3.2)
- PROPOSED COMPOST FILTER SOCK (SEE DETAILS MVP–ES3, 3.1, 3.2)
- PROPOSED COMPOST FILTER SOCK (SEE DETAILS MVP–ES3, 3.1, 3.2)
- GRASS–LINED CHANNEL (SEE DETAIL MVP–ES39)
- CLEAN WATER DIVERSION PIPE
- CLEAN WATER DIVERSION DIKE (SEE DETAIL MVP–ES50 AND MVP–ES51)
- STREAM FLOW DIRECTION
- FEMA 100 YEAR FLOODPLAIN
- DRAINAGE AREA BOUNDARY
- TIMBER MAT (SEE DETAIL MVP–ES37)
- STEEP SLOPE EROSION CONTROL (SEE NOTE 2)
- STEEP SLOPE AREAS (SEE NOTE 4)
- PROPOSED ROCK CONSTRUCTION ENTRANCE
- PROPOSED TRENCH BREAKER (SEE DETAIL MVP–20)
- TEMPORARY ROW DIVERSION/WATER BAR (VADEQ STD & SPEC 3.11)
- PERMANENT SLOPE BREAKER/ROW DIVERSION/WATER BAR (SEE DETAILS MVP–17, ES38, AND SCHEDULE)

NOTES:

1. TOPSOIL SEGREGATION WILL BE PERFORMED IN ALL IMMEDIATE CONSTRUCTION AREAS OF THE PROJECT IN ACCORDANCE WITH DETAILS MVP–ES46.1 THROUGH MVP–ES46.3.
2. FLEXTERRA, EARTHGUARD OR EQUIVALENT MAY BE USED AS A SUBSTITUTE TO EROSION CONTROL BLANKET AS DIRECTED BY MVP.
3. CONTRACTOR IS RESPONSIBLE TO IDENTIFY ALL UTILITIES. THE UTILITY LINES SHOWN ON THE PLAN ARE FOR INFORMATIONAL PURPOSES ONLY AND DO NOT REPRESENT SURVEYED LINE INFORMATION.
4. SLOPES OF 30" OR GREATER EXIST. CONSTRUCTION FOR STEEP SLOPES TO BE PERFORMED USING STEEP SLOPE TECHNIQUES IDENTIFIED IN THE DETAIL SHEETS. ALSO REFER TO THE SITE–SPECIFIC DESIGN OF STABILIZATION MEASURES IN SELECTED HIGH–HAZARD PORTIONS OF THE ROUTE OF THE PROPOSED MOUNTAIN VALLEY PIPLELINE PROJECT.
5. WHERE CONSTRUCTION CONDITIONS PRECLUDE THE USE OF DIVERSION DITCHES DUE TO SITE CONDITIONS THE CONTRACTOR WILL INSTALL SILT FENCE AT THE DIRECTION OF MVP.
6. IMPROVEMENTS TO PERMANENT AND TEMPORARY ACCESS ROADS WILL BE PERFORMED PER THE SITE SPECIFIC ACCESS ROAD DETAILS.
7. TEMPORARY ACCESS ROAD CROSSING OF STREAMS AND WETLANDS WILL UTILIZE TIMBERMATS. ANY PERMANENT ROAD CROSSINGS WILL BE CONDUCTED VIA CULVERTS.
8. ALL NON VMRC STREAM CROSSINGS WILL BE PERFORMED AS DESCRIBED IN THE STREAM CROSSING TABLE INCLUDED IN THIS PACKAGE.

TETRA TECH CAD FILE PATH: X:\CADD_Pittsburgh\EQT\7157 – MVP\13 – Montgomery\E&S\E&S Version 5.0.0\7157ES14.05(S10).dwg PLOTTED ON: 3/2/2018 11:41 AM PLOTTED BY: Zeigler, Justin PLOT FILE: ENVIRONMENTAL_COLOR.ctb

NO.	DATE:	DWN.:	CHKD.:	APPD.:	DESCRIPTION:
5	03/04/18	KAL	RE	DW	ADDRESS VADEQ COMMENTS
4	02/27/18	KAL	RE	DW	ADDRESS VADEQ COMMENTS
3	02/05/18	KAL	RE	DW	ADDRESS VADEQ COMMENTS
2	11/21/17	KAL	RE	DW	ADDRESS VADEQ COMMENTS
1	09/21/17	KAL	RE	DW	PLAN SUBMISSION

REVISIONS:

Mountain Valley PIPELINE

EROSION AND SEDIMENT CONTROL PLANS

MOUNTAIN VALLEY PIPELINE PROJECT – H600 LINE

SPREAD 10 – MONTGOMERY COUNTY, VIRGINIA

MOUNTAIN VALLEY PIPELINE, LLC
555 SOUTHPOINTE BOULEVARD, SUITE 200
CANONSBURG, PA 15311


TETRA TECH
complex world | CLEAR SOLUTIONS™
661 ANDERSEN DRIVE
FOSTER PLAZA 7
PITTSBURGH, PA 15220

EROSION AND SEDIMENT CONTROL PLANS

COMMONWEALTH OF VIRGINIA
DAVID J. WALLNER
Lic. No. 0402057593
PROFESSIONAL ENGINEER

DRAWN BY:	KAL
CHECKED BY:	RE
APPROVED BY:	DW
DATE:	03/04/2018
SCALE:	AS SHOWN
REVISION	5


SHT. NO. 14.05ES OF 14.81ES

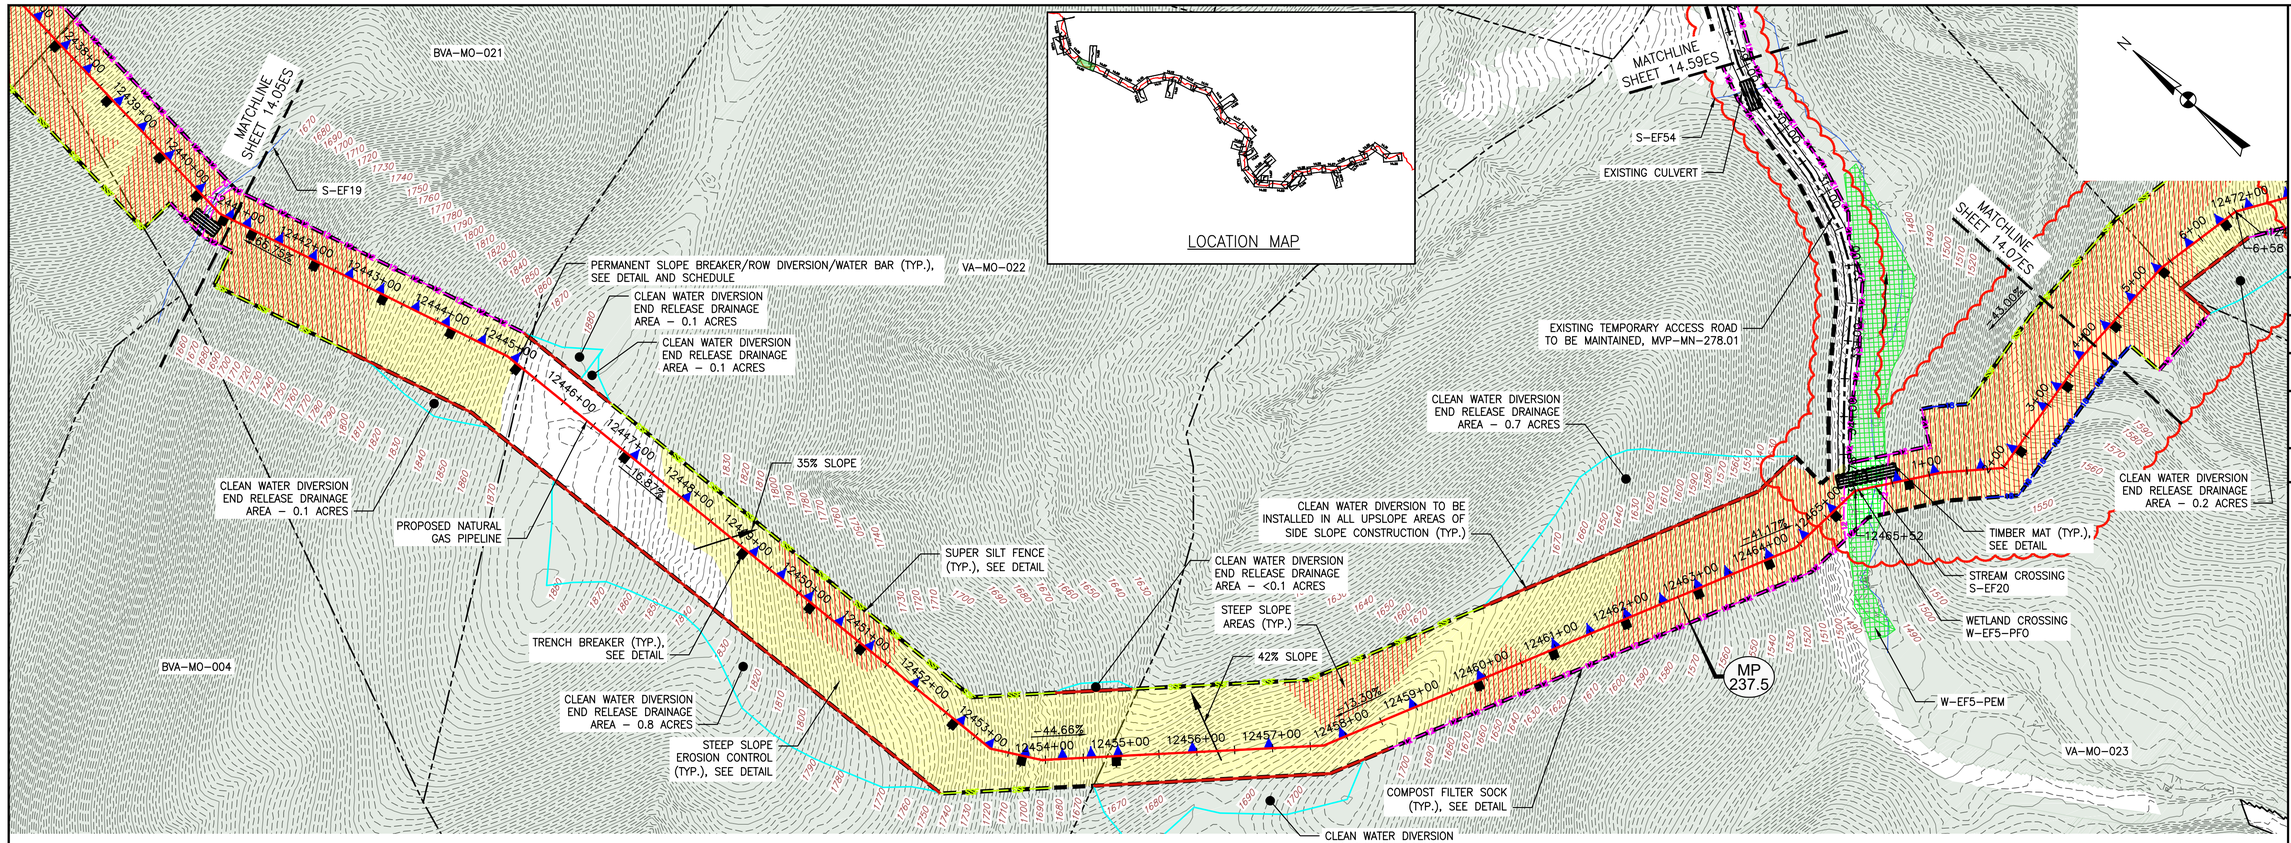

PLAN

SCALE: 1" = 100'

100 0 100 200

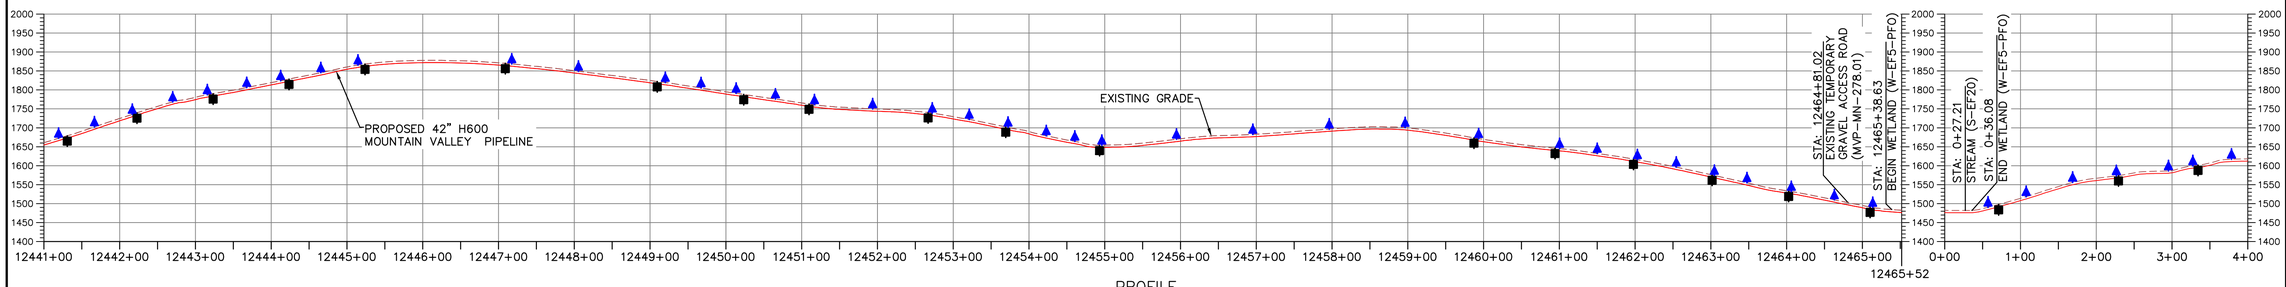

PROFILE

HORIZONTAL SCALE: SCALE: 1" = 100'

100 0 100 200

VERTICAL SCALE: SCALE: 1" = 200'

200 0 200 400

LEGEND

- PROPOSED LIMIT OF DISTURBANCE
- STREAM
- USDA FOREST SERVICE (NATIONAL FOREST) LANDS
- APPALACHIAN NATIONAL SCENIC TRAIL
- EXISTING ROAD/TRAIL
- EXISTING PROPERTY LINE
- EXISTING STATE LINE
- EXISTING COUNTY LINE
- POND
- WETLAND
- ACID FORMING MATERIAL
- EXISTING FOREST
- PROPOSED ACCESS ROAD CENTERLINE
- PROPOSED PIPELINE
- PROPOSED SILT FENCE (SEE NOTE 5)
- PROPOSED SUPER SILT FENCE (SEE DETAIL MVP-ES9.2)
- PROPOSED REINFORCED FILTRATION DEVICE (SEE DETAILS MVP-ES9, 9.1, 9.2, 9.3)
- ORANGE CONSTRUCTION SAFETY FENCE
- PROPOSED COMPOST FILTER SOCK (SEE DETAILS MVP-ES3, 3.1, 3.2)
- PROPOSED COMPOST FILTER SOCK (SEE DETAILS MVP-ES3, 3.1, 3.2)
- PROPOSED COMPOST FILTER SOCK (SEE DETAILS MVP-ES3, 3.1, 3.2)
- GRASS-LINED CHANNEL (SEE DETAIL MVP-ES39)
- CLEAN WATER DIVERSION PIPE
- CLEAN WATER DIVERSION DIKE (SEE DETAIL MVP-ES50 AND MVP-ES51)
- STREAM FLOW DIRECTION
- FEMA 100 YEAR FLOODPLAIN
- DRAINAGE AREA BOUNDARY
- TIMBER MAT (SEE DETAIL MVP-ES37)
- STEEP SLOPE EROSION CONTROL (SEE NOTE 2)
- STEEP SLOPE AREAS (SEE NOTE 4)
- PROPOSED ROCK CONSTRUCTION ENTRANCE
- PROPOSED TRENCH BREAKER (SEE DETAIL MVP-20)
- TEMPORARY ROW DIVERSION/WATER BAR (VADEQ STD & SPEC 3.11)
- PERMANENT SLOPE BREAKER/ROW DIVERSION/WATER BAR (SEE DETAILS MVP-17, ES38, AND SCHEDULE)

NOTES:

1. TOPSOIL SEGREGATION WILL BE PERFORMED IN ALL IMMEDIATE CONSTRUCTION AREAS OF THE PROJECT IN ACCORDANCE WITH DETAILS MVP-ES46.1 THROUGH MVP-ES46.3.
2. FLEXTERRA, EARTHGUARD OR EQUIVALENT MAY BE USED AS A SUBSTITUTE TO EROSION CONTROL BLANKET AS DIRECTED BY MVP.
3. CONTRACTOR IS RESPONSIBLE TO IDENTIFY ALL UTILITIES. THE UTILITY LINES SHOWN ON THE PLAN ARE FOR INFORMATIONAL PURPOSES ONLY AND DO NOT REPRESENT SURVEYED LINE INFORMATION.
4. SLOPES OF 30' OR GREATER EXIST. CONSTRUCTION FOR STEEP SLOPES TO BE PERFORMED USING STEEP SLOPE TECHNIQUES IDENTIFIED IN THE DETAIL SHEETS. ALSO REFER TO THE SITE-SPECIFIC DESIGN OF STABILIZATION MEASURES IN SELECTED HIGH-HAZARD PORTIONS OF THE ROUTE OF THE PROPOSED MOUNTAIN VALLEY PIPELINE PROJECT.
5. WHERE CONSTRUCTION CONDITIONS PRECLUDE THE USE OF DIVERSION DITCHES DUE TO SITE CONDITIONS THE CONTRACTOR WILL INSTALL SILT FENCE AT THE DIRECTION OF MVP.
6. IMPROVEMENTS TO PERMANENT AND TEMPORARY ACCESS ROADS WILL BE PERFORMED PER THE SITE SPECIFIC ACCESS ROAD DETAILS.
7. TEMPORARY ACCESS ROAD CROSSING OF STREAMS AND WETLANDS WILL UTILIZE TIMBERMATS. ANY PERMANENT ROAD CROSSINGS WILL BE CONDUCTED VIA CULVERTS.
8. ALL NON VWRC STREAM CROSSINGS WILL BE PERFORMED AS DESCRIBED IN THE STREAM CROSSING TABLE INCLUDED IN THIS PACKAGE.

REVISIONS:

NO.:	DATE:	DWN.:	CHKD.:	APPD.:	DESCRIPTION:
–	02/08/19	GAR	RE	DW	ADDRESS VADEQ COMMENTS TO H-9 FIELD MODIFICATION SUBMITTAL
7	10/01/18	GAR	RE	DW	FIELD MODIFICATION
6	03/16/18	KAL	RE	DW	ADDRESS VADEQ COMMENTS
5	03/04/18	KAL	RE	DW	ADDRESS VADEQ COMMENTS
4	02/27/18	KAL	RE	DW	ADDRESS VADEQ COMMENTS
3	02/05/18	KAL	RE	DW	ADDRESS VADEQ COMMENTS

Mountain Valley PIPELINE

EROSION AND SEDIMENT CONTROL PLANS

MOUNTAIN VALLEY PIPELINE PROJECT – H600 LINE

SPREAD 10 – MONTGOMERY COUNTY, VIRGINIA

MOUNTAIN VALLEY PIPELINE, LLC
2200 ENERGY DRIVE
CANONSBURG, PA 15311

TETRA TECH
complex world | CLEAR SOLUTIONS™
661 ANDERSEN DRIVE
FOSTER PLAZA 7
PITTSBURGH, PA 15220

EROSION AND SEDIMENT CONTROL PLANS


COMMONWEALTH OF VIRGINIA
DAVID J. WALLNER
Lic. No. 0402057593
PROFESSIONAL ENGINEER

DRAWN BY:	GAR
CHECKED BY:	RE
APPROVED BY:	DW
DATE:	02/08/2019
SCALE:	AS SHOWN

REVISION –

SHT. NO. 14.06ES OF 14.81ES


TETRA TECH CAD FILE PATH: X:\CADD_Pittsburgh\EQT\7157 – MVP\13 – Montgomery\E&S\E&S Version 5.0.0\7157ES14.06(S10).dwg PLOTTED ON: 4/10/2019 2:03 PM PLOTTED BY: Kuslowski, Jim PLOT FILE: ENVIRONMENTAL_COLOR.ctb

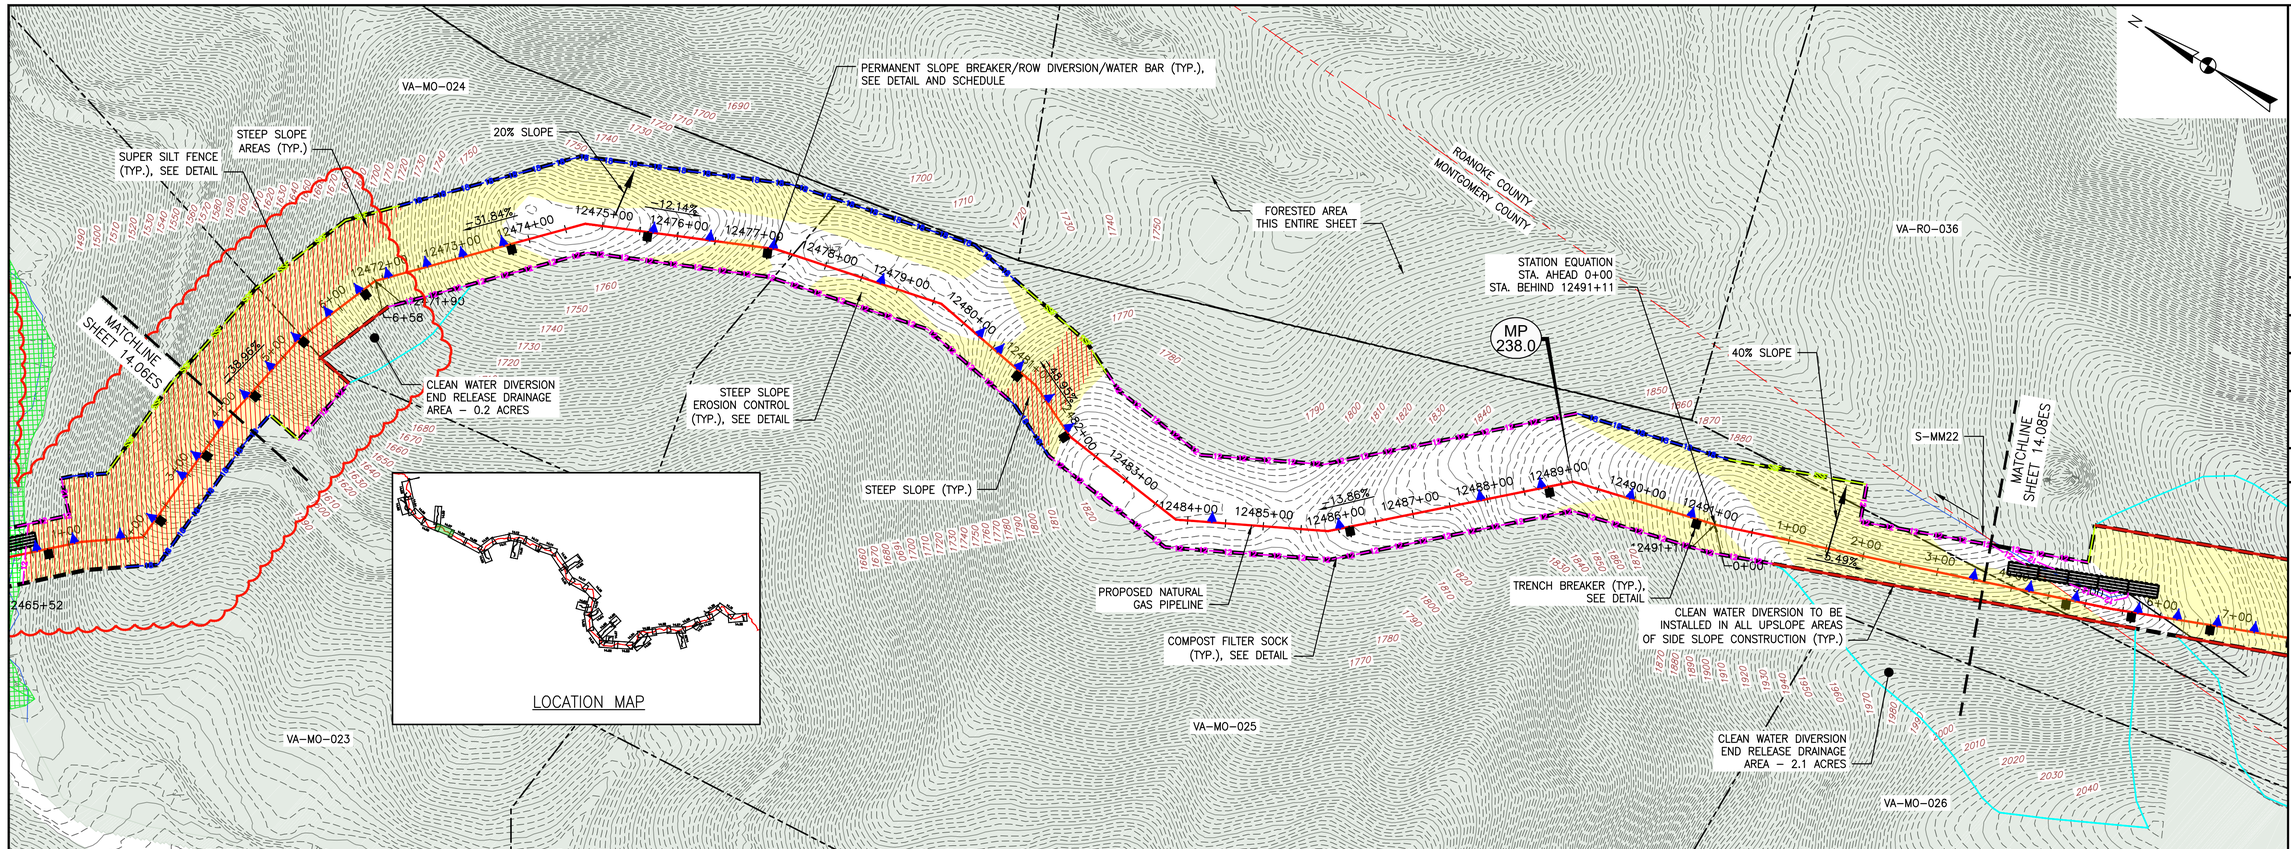

PLAN

SCALE: 1" = 100'

100 0 100 200

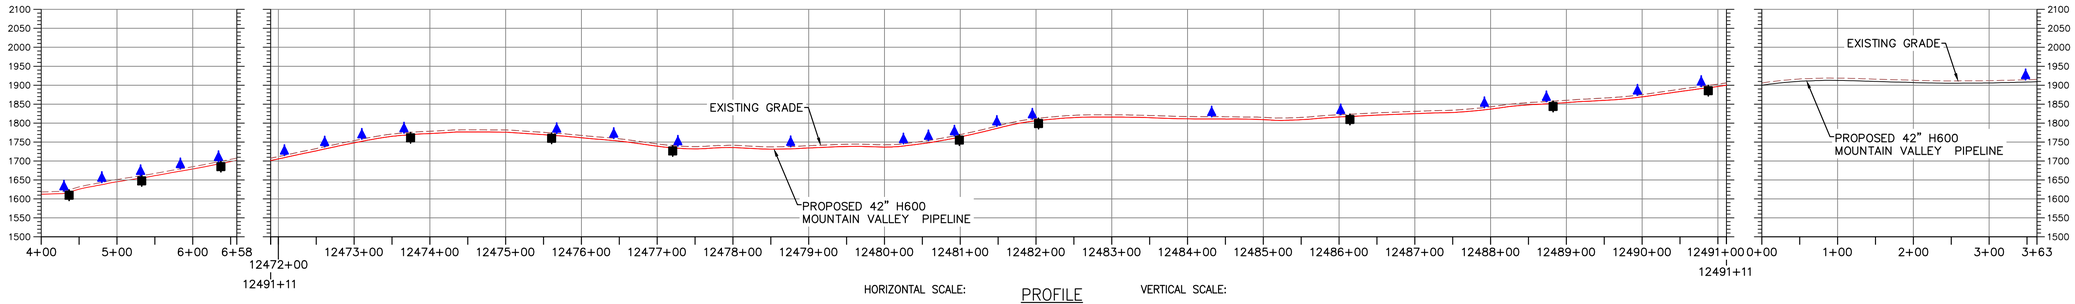

PROFILE

HORIZONTAL SCALE: SCALE: 1" = 100'

100 0 100 200

VERTICAL SCALE: SCALE: 1" = 200'

200 0 200 400

LEGEND

- PROPOSED LIMIT OF DISTURBANCE
- STREAM
- USDA FOREST SERVICE (NATIONAL FOREST) LANDS
- AMST — AMST — APPALACHIAN NATIONAL SCENIC TRAIL
- EXISTING ROAD/TRAIL
- EXISTING PROPERTY LINE
- EXISTING STATE LINE
- EXISTING COUNTY LINE
- POND
- WETLAND
- AFM — AFM — ACID FORMING MATERIAL
- EXISTING FOREST
- PROPOSED ACCESS ROAD CENTERLINE
- PROPOSED PIPELINE
- SF — SF — PROPOSED SILT FENCE (SEE NOTE 5)
- SSF — SSF — PROPOSED SUPER SILT FENCE (SEE DETAIL MVP-ES9.2)
- RFD — RFD — PROPOSED REINFORCED FILTRATION DEVICE (SEE DETAILS MVP-ES9, 9.1, 9.2, 9.3)
- OCSF — ORANGE CONSTRUCTION SAFETY FENCE
- 12 — 12 — 12 — 12 — PROPOSED COMPOST FILTER SOCK (SEE DETAILS MVP-ES3, 3.1, 3.2)
- 18 — 18 — 18 — 18 — PROPOSED COMPOST FILTER SOCK (SEE DETAILS MVP-ES3, 3.1, 3.2)
- 24 — 24 — 24 — 24 — PROPOSED COMPOST FILTER SOCK (SEE DETAILS MVP-ES3, 3.1, 3.2)
- GRASS-LINED CHANNEL (SEE DETAIL MVP-ES39)
- CLEAN WATER DIVERSION PIPE
- CLEAN WATER DIVERSION DIKE (SEE DETAIL MVP-ES50 AND MVP-ES51)
- STREAM FLOW DIRECTION
- FEMA 100 YEAR FLOODPLAIN
- DRAINAGE AREA BOUNDARY
- TIMBER MAT (SEE DETAIL MVP-ES37)
- STEEP SLOPE EROSION CONTROL (SEE NOTE 2)
- STEEP SLOPE AREAS (SEE NOTE 4)
- PROPOSED ROCK CONSTRUCTION ENTRANCE
- PROPOSED TRENCH BREAKER (SEE DETAIL MVP-20)
- TEMPORARY ROW DIVERSION/WATER BAR (VADEQ STD & SPEC 3.11)
- PERMANENT SLOPE BREAKER/ROW DIVERSION/WATER BAR (SEE DETAILS MVP-17, ES38, AND SCHEDULE)

NOTES:

1. TOPSOIL SEGREGATION WILL BE PERFORMED IN ALL IMMEDIATE CONSTRUCTION AREAS OF THE PROJECT IN ACCORDANCE WITH DETAILS MVP-ES46.1 THROUGH MVP-ES46.3.
2. FLEXTERRA, EARTHGUARD OR EQUIVALENT MAY BE USED AS A SUBSTITUTE TO EROSION CONTROL BLANKET AS DIRECTED BY MVP.
3. CONTRACTOR IS RESPONSIBLE TO IDENTIFY ALL UTILITIES. THE UTILITY LINES SHOWN ON THE PLAN ARE FOR INFORMATIONAL PURPOSES ONLY AND DO NOT REPRESENT SURVEYED LINE INFORMATION.
4. SLOPES OF 30' OR GREATER EXIST. CONSTRUCTION FOR STEEP SLOPES TO BE PERFORMED USING STEEP SLOPE TECHNIQUES IDENTIFIED IN THE DETAIL SHEETS. ALSO REFER TO THE SITE-SPECIFIC DESIGN OF STABILIZATION MEASURES IN SELECTED HIGH-HAZARD PORTIONS OF THE ROUTE OF THE PROPOSED MOUNTAIN VALLEY PIPELINE PROJECT.
5. WHERE CONSTRUCTION CONDITIONS PRECLUDE THE USE OF DIVERSION DITCHES DUE TO SITE CONDITIONS THE CONTRACTOR WILL INSTALL SILT FENCE AT THE DIRECTION OF MVP.
6. IMPROVEMENTS TO PERMANENT AND TEMPORARY ACCESS ROADS WILL BE PERFORMED PER THE SITE SPECIFIC ACCESS ROAD DETAILS.
7. TEMPORARY ACCESS ROAD CROSSING OF STREAMS AND WETLANDS WILL UTILIZE TIMBERMATS. ANY PERMANENT ROAD CROSSINGS WILL BE CONDUCTED VIA CULVERTS.
8. ALL NON VWRC STREAM CROSSINGS WILL BE PERFORMED AS DESCRIBED IN THE STREAM CROSSING TABLE INCLUDED IN THIS PACKAGE.

NO.:	DATE:	DWN.:	CHKD.:	APPD.:	DESCRIPTION:
–	02/08/19	GAR	RE	DW	ADDRESS VADEQ COMMENTS TO H-9 FIELD MODIFICATION SUBMITTAL
7	10/01/18	GAR	RE	DW	FIELD MODIFICATION
6	03/16/18	KAL	RE	DW	ADDRESS VADEQ COMMENTS
5	03/04/18	KAL	RE	DW	ADDRESS VADEQ COMMENTS
4	02/27/18	KAL	RE	DW	ADDRESS VADEQ COMMENTS
3	02/05/18	KAL	RE	DW	ADDRESS VADEQ COMMENTS

REVISIONS:

Mountain Valley PIPELINE

EROSION AND SEDIMENT CONTROL PLANS

MOUNTAIN VALLEY PIPELINE PROJECT – H600 LINE

SPREAD 10 – MONTGOMERY COUNTY, VIRGINIA

MOUNTAIN VALLEY PIPELINE, LLC

2200 ENERGY DRIVE

CANONSBURG, PA 15311

TETRA TECH

complex world | CLEAR SOLUTIONS™

661 ANDERSEN DRIVE
FOSTER PLAZA 7
PITTSBURGH, PA 15220


EROSION AND SEDIMENT CONTROL PLANS

COMMONWEALTH OF VIRGINIA
DAVID J. WALLNER
Lic. No. 0402057593
PROFESSIONAL ENGINEER

DRAWN BY:	GAR
CHECKED BY:	RE
APPROVED BY:	DW
DATE:	02/08/2019
SCALE:	AS SHOWN
REVISION	–

SHT. NO. 14.07ES OF 14.81ES


TETRA TECH CAD FILE PATH: X:\CADD_Pittsburgh\EQT\7157 – MVP\13 – Montgomery\E&S\E&S Version 5.0.0\7157ES14.07(S10).dwg PLOTTED ON: 4/10/2019 2:04 PM PLOTTED BY: Kusiowski, Jim PLOT FILE: ENVIRONMENTAL_COLOR.ctb

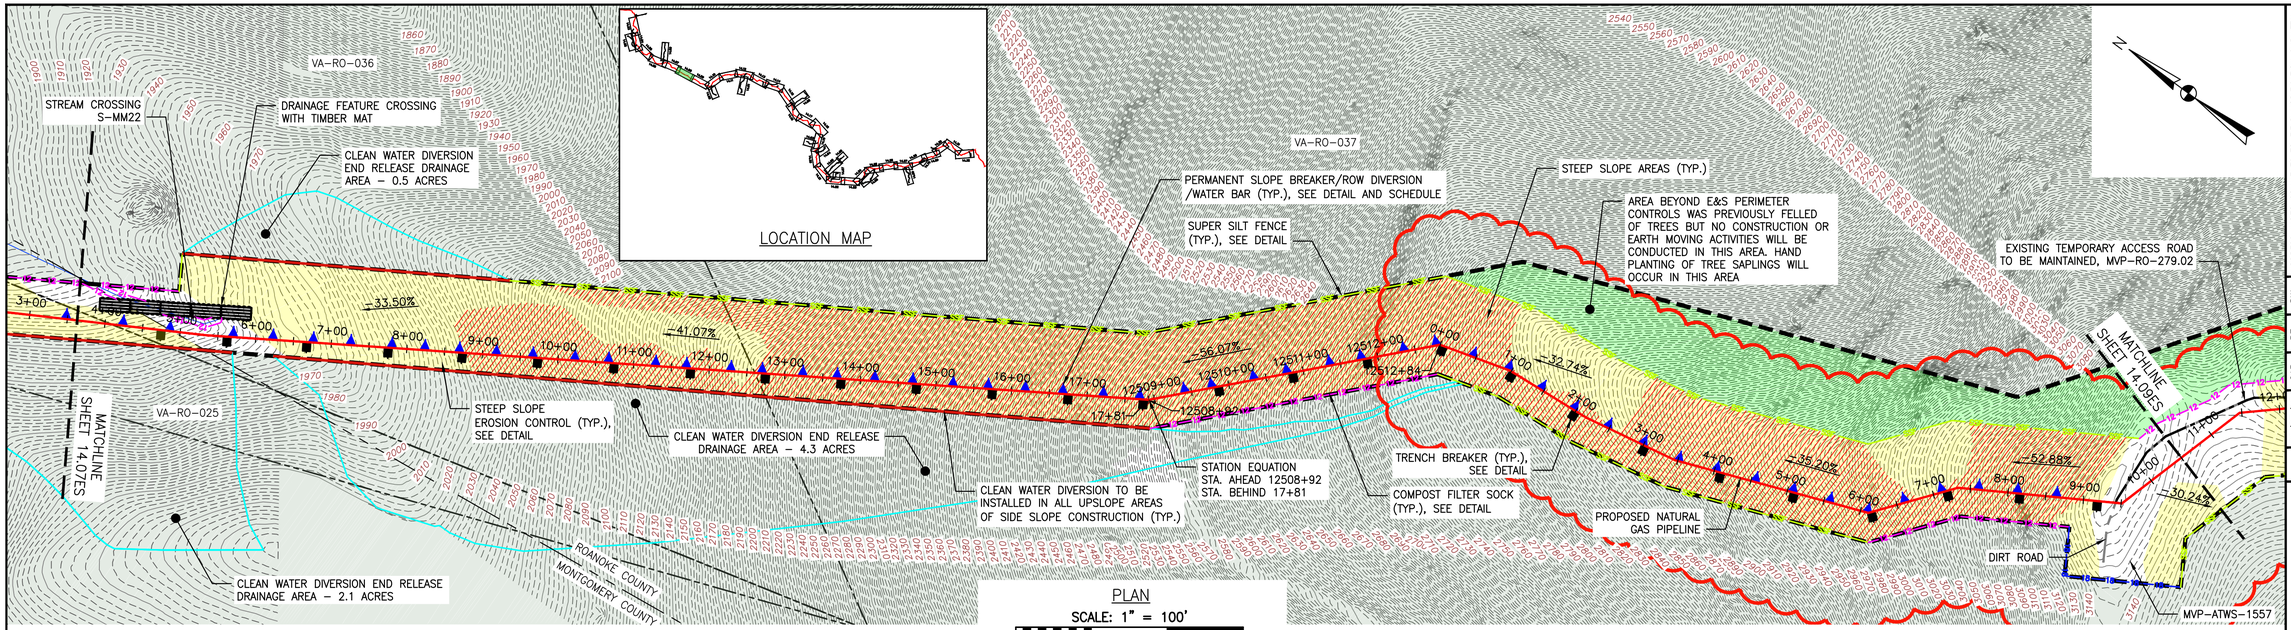

PLAN

SCALE: 1" = 100'

100 0 100 200

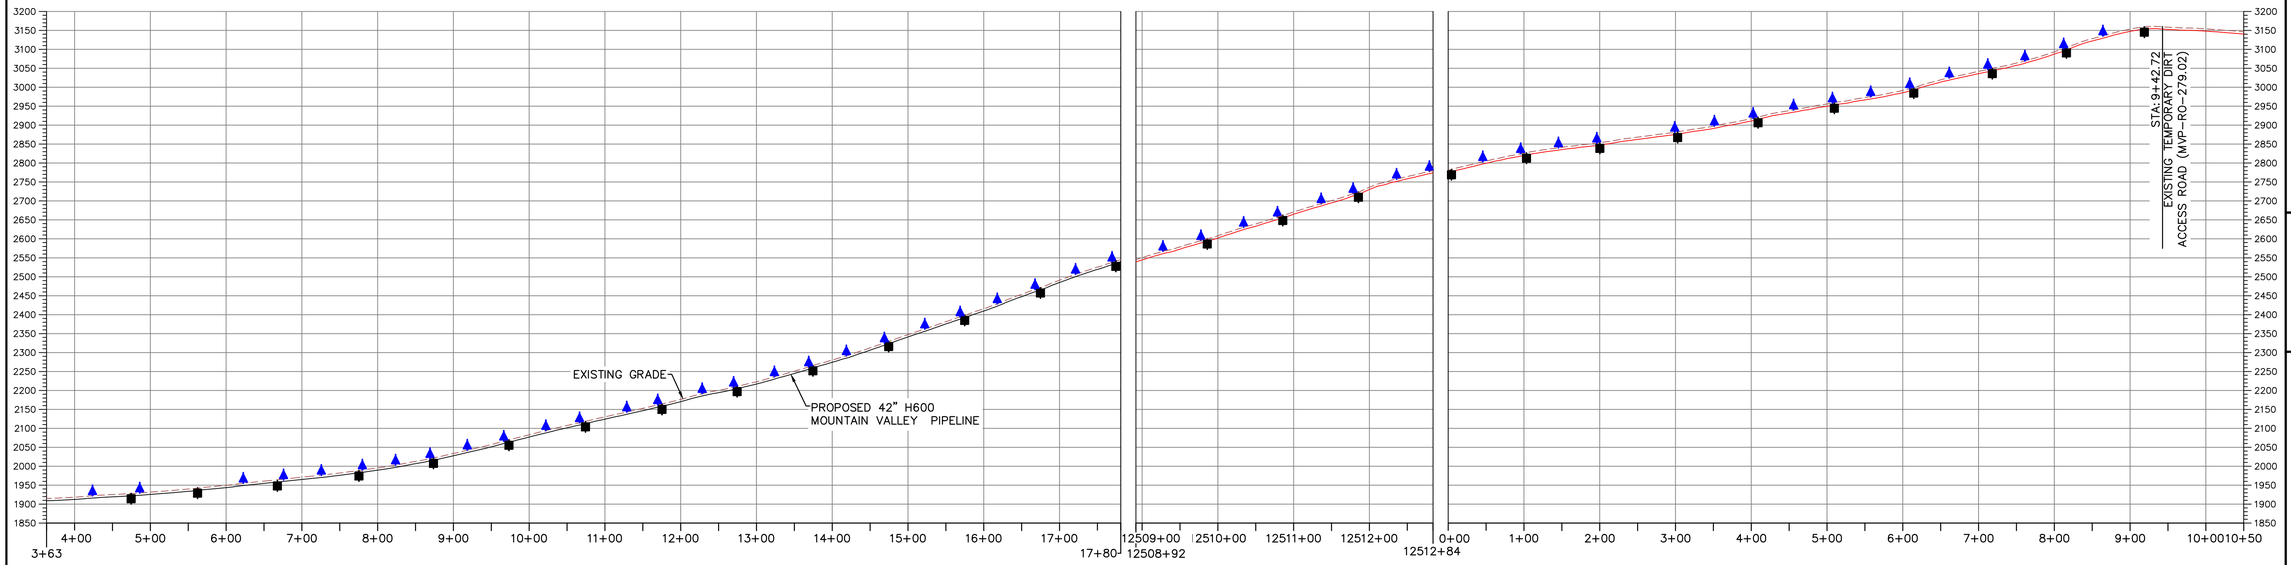

PROFILE

HORIZONTAL SCALE: SCALE: 1" = 100'

100 0 100 200

VERTICAL SCALE: SCALE: 1" = 200'

200 0 200 400

LEGEND

- PROPOSED LIMIT OF DISTURBANCE
- STREAM
- USDA FOREST SERVICE (NATIONAL FOREST) LANDS
- APPALACHIAN NATIONAL SCENIC TRAIL
- EXISTING ROAD/TRAIL
- EXISTING PROPERTY LINE
- EXISTING STATE LINE
- EXISTING COUNTY LINE
- POND
- WETLAND
- ACID FORMING MATERIAL
- EXISTING FOREST
- PROPOSED ACCESS ROAD CENTERLINE
- PROPOSED PIPELINE
- PROPOSED SILT FENCE (SEE NOTE 5)
- PROPOSED SUPER SILT FENCE (SEE DETAIL MVP-ES9.2)
- PROPOSED REINFORCED FILTRATION DEVICE (SEE DETAILS MVP-ES9, 9.1, 9.2, 9.3)
- ORANGE CONSTRUCTION SAFETY FENCE
- PROPOSED COMPOST FILTER SOCK (SEE DETAILS MVP-ES3, 3.1, 3.2)
- PROPOSED COMPOST FILTER SOCK (SEE DETAILS MVP-ES3, 3.1, 3.2)
- PROPOSED COMPOST FILTER SOCK (SEE DETAILS MVP-ES3, 3.1, 3.2)
- GRASS-LINED CHANNEL (SEE DETAIL MVP-ES39)
- CLEAN WATER DIVERSION PIPE
- CLEAN WATER DIVERSION DIKE (SEE DETAIL MVP-ES50 AND MVP-ES51)
- STREAM FLOW DIRECTION
- FEMA 100 YEAR FLOODPLAIN
- DRAINAGE AREA BOUNDARY
- TIMBER MAT (SEE DETAIL MVP-ES37)
- STEEP SLOPE EROSION CONTROL (SEE NOTE 2)
- STEEP SLOPE AREAS (SEE NOTE 4)
- PROPOSED ROCK CONSTRUCTION ENTRANCE
- PROPOSED TRENCH BREAKER (SEE DETAIL MVP-20)
- TEMPORARY ROW DIVERSION/WATER BAR (SEE DETAIL MP-17)
- PERMANENT SLOPE BREAKER/ROW DIVERSION/WATER BAR (SEE DETAIL MVP-17)
- AREA WHERE HAND PLANTING OF TREE SAPLINGS WILL OCCUR

NOTES:

1. TOPSOIL SEGREGATION WILL BE PERFORMED IN ALL IMMEDIATE CONSTRUCTION AREAS OF THE PROJECT IN ACCORDANCE WITH DETAILS MVP-ES46.1 THROUGH MVP-ES46.3.
2. FLEXTERRA, EARTHGUARD OR EQUIVALENT MAY BE USED AS A SUBSTITUTE TO EROSION CONTROL BLANKET AS DIRECTED BY MVP.
3. CONTRACTOR IS RESPONSIBLE TO IDENTIFY ALL UTILITIES. THE UTILITY LINES SHOWN ON THE PLAN ARE FOR INFORMATIONAL PURPOSES ONLY AND DO NOT REPRESENT SURVEYED LINE INFORMATION.
4. SLOPES OF 30° OR GREATER EXIST. CONSTRUCTION FOR STEEP SLOPES TO BE PERFORMED USING STEEP SLOPE TECHNIQUES IDENTIFIED IN THE DETAIL SHEETS. ALSO REFER TO THE SITE-SPECIFIC DESIGN OF STABILIZATION MEASURES IN SELECTED HIGH-HAZARD PORTIONS OF THE ROUTE OF THE PROPOSED MOUNTAIN VALLEY PIPLELINE PROJECT.
5. WHERE CONSTRUCTION CONDITIONS PRECLUDE THE USE OF DIVERSION DITCHES DUE TO SITE CONDITIONS THE CONTRACTOR WILL INSTALL SILT FENCE AT THE DIRECTION OF MVP.
6. IMPROVEMENTS TO PERMANENT AND TEMPORARY ACCESS ROADS WILL BE PERFORMED PER THE SITE SPECIFIC ACCESS ROAD DETAILS.
7. TEMPORARY ACCESS ROAD CROSSING OF STREAMS AND WETLANDS WILL UTILIZE TIMBERMATS. ANY PERMANENT ROAD CROSSINGS WILL BE CONDUCTED VIA CULVERTS.
8. ALL NON VMRC STREAM CROSSINGS WILL BE PERFORMED AS DESCRIBED IN THE STREAM CROSSING TABLE INCLUDED IN THIS PACKAGE.

NO.:	DATE:	DWN.:	CHKD.:	APPD.:	DESCRIPTION:
–	06/07/19	GAR	RE	DW	ADDRESS VADEQ COMMENTS TO FIELD MODIFICATION SUBMITTAL
–	03/26/19	JWK	RE	DW	ADDRESS VADEQ COMMENTS TO FIELD MODIFICATION SUBMITTAL
6	07/31/18	JJZ	RE	DW	FIELD MODIFICATION
5	03/04/18	KAL	RE	DW	ADDRESS VADEQ COMMENTS
4	02/27/18	KAL	RE	DW	ADDRESS VADEQ COMMENTS
3	02/05/18	KAL	RE	DW	ADDRESS VADEQ COMMENTS

REVISIONS:

Mountain Valley PIPELINE

EROSION AND SEDIMENT CONTROL PLANS

MOUNTAIN VALLEY PIPELINE PROJECT – H600 LINE

SPREAD 10 – ROANOKE COUNTY, VIRGINIA


MOUNTAIN VALLEY PIPELINE, LLC
2200 ENERGY DRIVE
CANONSBURG, PA 15311


TETRA TECH
complex world | CLEAR SOLUTIONS™
661 ANDERSEN DRIVE
FOSTER PLAZA 7
PITTSBURGH, PA 15220

EROSION AND SEDIMENT CONTROL PLANS

COMMONWEALTH OF VIRGINIA
DAVID J. WALLNER
No. 0402057593
PROFESSIONAL ENGINEER

DRAWN BY:	JK
CHECKED BY:	RE
APPROVED BY:	DW
DATE:	06/07/2019
SCALE:	AS SHOWN
SHT. NO.	14.08ES OF 14.81ES

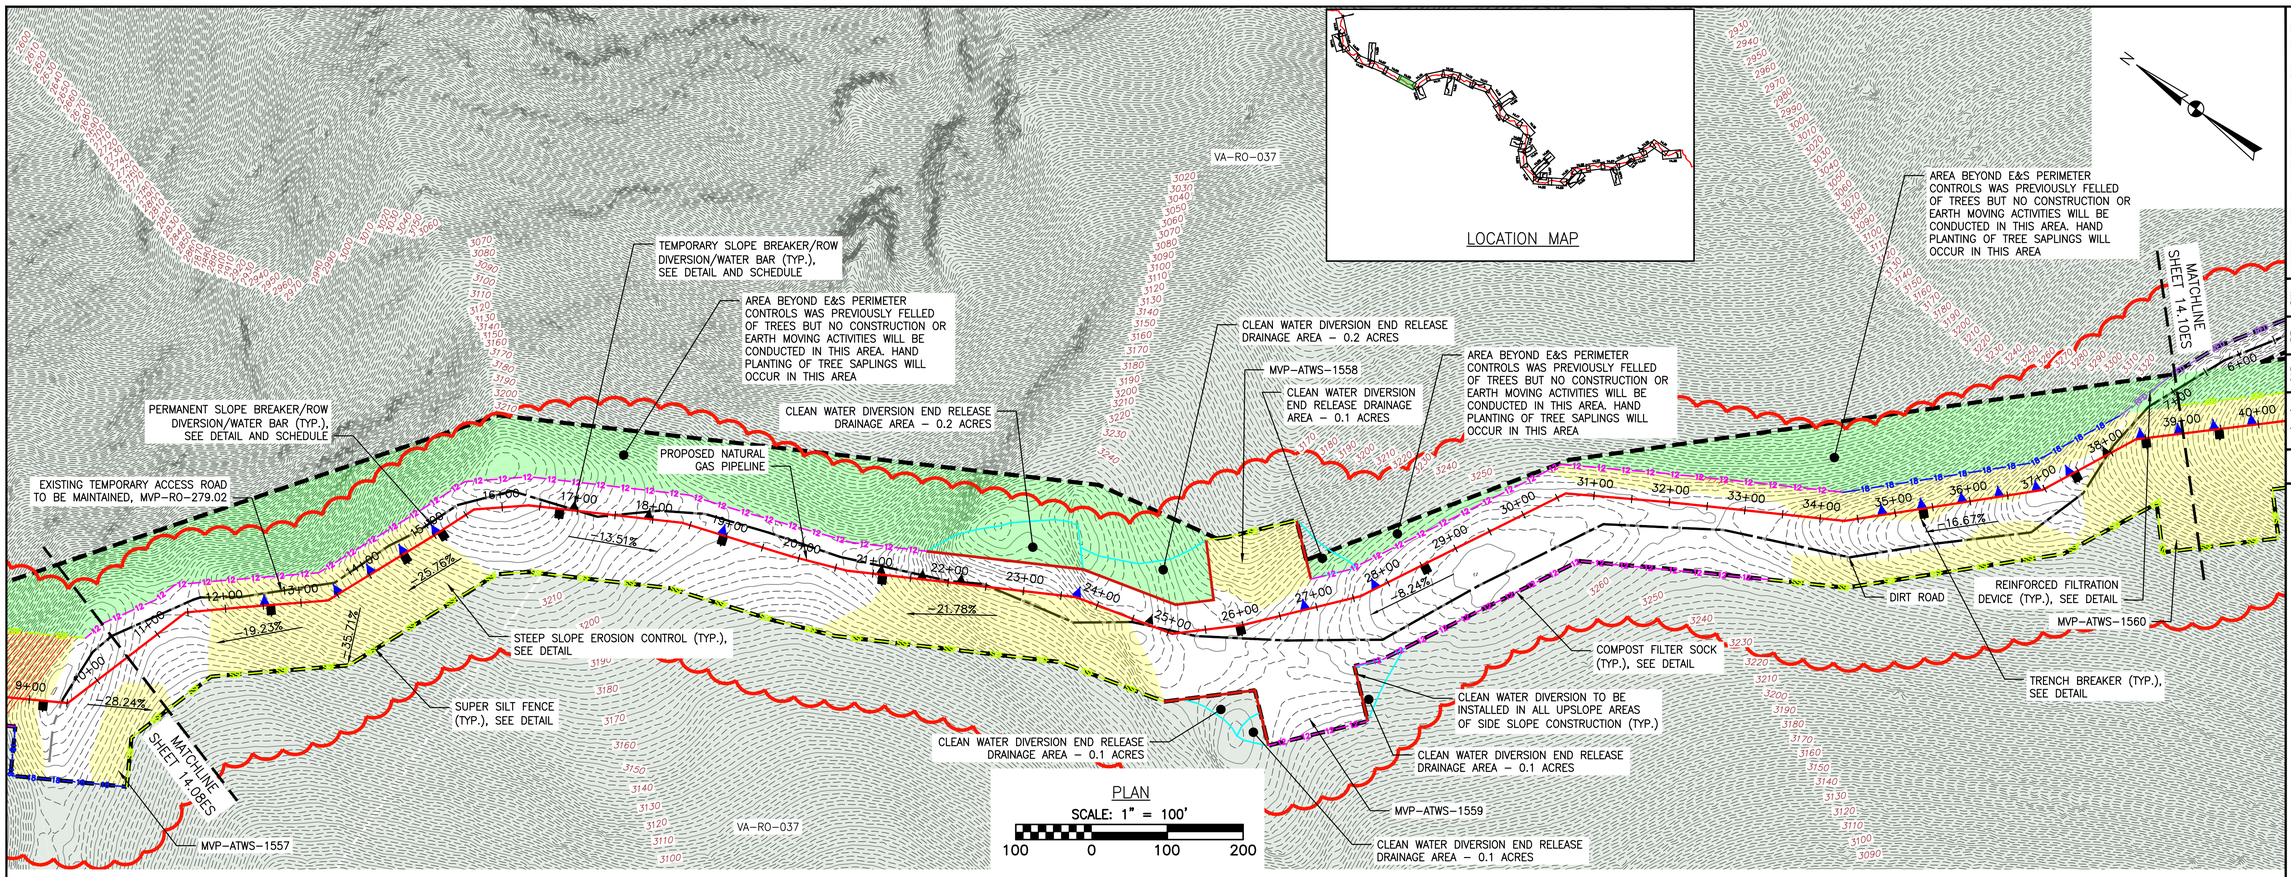

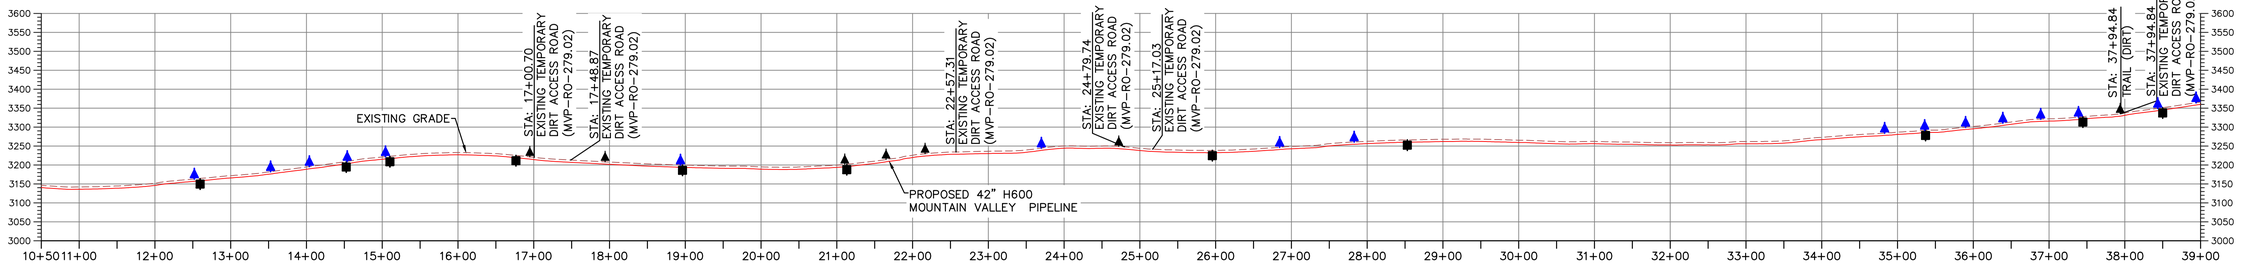

PROFILE

HORIZONTAL SCALE: SCALE: 1" = 100'
100 0 100 200

VERTICAL SCALE: SCALE: 1" = 200'
200 0 200 400

LEGEND

- PROPOSED LIMIT OF DISTURBANCE
- STREAM
- USDA FOREST SERVICE (NATIONAL FOREST) LANDS
- APPALACHIAN NATIONAL SCENIC TRAIL
- EXISTING ROAD/TRAIL
- EXISTING PROPERTY LINE
- EXISTING STATE LINE
- EXISTING COUNTY LINE
- POND
- WETLAND
- ACID FORMING MATERIAL
- EXISTING FOREST
- PROPOSED ACCESS ROAD CENTERLINE
- PROPOSED PIPELINE
- PROPOSED SILT FENCE (SEE NOTE 5)
- PROPOSED SUPER SILT FENCE (SEE DETAIL MVP-ES9.2)
- PROPOSED REINFORCED FILTRATION DEVICE (SEE DETAILS MVP-ES9, 9.1, 9.2, 9.3)
- ORANGE CONSTRUCTION SAFETY FENCE
- PROPOSED COMPOST FILTER SOCK (SEE DETAILS MVP-ES3, 3.1, 3.2)
- PROPOSED COMPOST FILTER SOCK (SEE DETAILS MVP-ES3, 3.1, 3.2)
- PROPOSED COMPOST FILTER SOCK (SEE DETAILS MVP-ES3, 3.1, 3.2)
- GRASS-LINED CHANNEL (SEE DETAIL MVP-ES39)
- CLEAN WATER DIVERSION PIPE
- CLEAN WATER DIVERSION DIKE (SEE DETAIL MVP-ES50 AND MVP-ES51)
- STREAM FLOW DIRECTION
- FEMA 100 YEAR FLOODPLAIN
- DRAINAGE AREA BOUNDARY
- TIMBER MAT (SEE DETAIL MVP-ES37)
- STEEP SLOPE EROSION CONTROL (SEE NOTE 2)
- STEEP SLOPE AREAS (SEE NOTE 4)
- PROPOSED ROCK CONSTRUCTION ENTRANCE
- PROPOSED TRENCH BREAKER (SEE DETAIL MVP-20)
- TEMPORARY ROW DIVERSION/WATER BAR (SEE DETAIL MP-17)
- PERMANENT SLOPE BREAKER/ROW DIVERSION/WATER BAR (SEE DETAIL MVP-17)
- AREA WHERE HAND PLANTING OF TREE SAPLINGS WILL OCCUR

NOTES:

1. TOPSOIL SEGREGATION WILL BE PERFORMED IN ALL IMMEDIATE CONSTRUCTION AREAS OF THE PROJECT IN ACCORDANCE WITH DETAILS MVP-ES46.1 THROUGH MVP-ES46.3.
2. FLEXTERRA, EARTHGUARD OR EQUIVALENT MAY BE USED AS A SUBSTITUTE TO EROSION CONTROL BLANKET AS DIRECTED BY MVP.
3. CONTRACTOR IS RESPONSIBLE TO IDENTIFY ALL UTILITIES. THE UTILITY LINES SHOWN ON THE PLAN ARE FOR INFORMATIONAL PURPOSES ONLY AND DO NOT REPRESENT SURVEYED LINE INFORMATION.
4. SLOPES OF 30° OR GREATER EXIST. CONSTRUCTION FOR STEEP SLOPES TO BE PERFORMED USING STEEP SLOPE TECHNIQUES IDENTIFIED IN THE DETAIL SHEETS. ALSO REFER TO THE SITE-SPECIFIC DESIGN OF STABILIZATION MEASURES IN SELECTED HIGH-HAZARD PORTIONS OF THE ROUTE OF THE PROPOSED MOUNTAIN VALLEY PIPELINE PROJECT.
5. WHERE CONSTRUCTION CONDITIONS PRECLUDE THE USE OF DIVERSION DITCHES DUE TO SITE CONDITIONS THE CONTRACTOR WILL INSTALL SILT FENCE AT THE DIRECTION OF MVP.
6. IMPROVEMENTS TO PERMANENT AND TEMPORARY ACCESS ROADS WILL BE PERFORMED PER THE SITE SPECIFIC ACCESS ROAD DETAILS.
7. TEMPORARY ACCESS ROAD CROSSING OF STREAMS AND WETLANDS WILL UTILIZE TIMBERMATS. ANY PERMANENT ROAD CROSSINGS WILL BE CONDUCTED VIA CULVERTS.
8. ALL NON VMRC STREAM CROSSINGS WILL BE PERFORMED AS DESCRIBED IN THE STREAM CROSSING TABLE INCLUDED IN THIS PACKAGE.

NO.:	DATE:	DWN.:	CHKD.:	APPD.:	DESCRIPTION:
6	07/31/18	JJZ	RE	DW	FIELD MODIFICATION
5	03/04/18	KAL	RE	DW	ADDRESS VADEQ COMMENTS
4	02/27/18	KAL	RE	DW	ADDRESS VADEQ COMMENTS
3	02/05/18	KAL	RE	DW	ADDRESS VADEQ COMMENTS
–	06/07/19	GAR	RE	DW	ADDRESS VADEQ COMMENTS TO FIELD MODIFICATION SUBMITTAL
–	03/26/19	JWK	RE	DW	ADDRESS VADEQ COMMENTS TO FIELD MODIFICATION SUBMITTAL

REVISIONS:

Mountain Valley PIPELINE

EROSION AND SEDIMENT CONTROL PLANS

MOUNTAIN VALLEY PIPELINE PROJECT – H600 LINE

SPREAD 10 – ROANOKE COUNTY, VIRGINIA

MOUNTAIN VALLEY PIPELINE, LLC
2200 ENERGY DRIVE
CANONSBURG, PA 15311


TETRA TECH
complex world | CLEAR SOLUTIONS™
661 ANDERSEN DRIVE
FOSTER PLAZA 7
PITTSBURGH, PA 15220

EROSION AND SEDIMENT CONTROL PLANS

COMMONWEALTH OF VIRGINIA
DAVID J. WALLNER
Lic. No. 0402057593
PROFESSIONAL ENGINEER

DRAWN BY:	JK
CHECKED BY:	RE
APPROVED BY:	DW
DATE:	06/07/2019
SCALE:	AS SHOWN
REVISION	–
SHT. NO.	14.09ES OF 14.81ES

TETRA TECH CAD FILE PATH: X:\CADD_Pittsburgh\EQT\7157 – MVP\14 – Roanoke\E&S\E&S VERSION 5.0.0\7157ES14.09(S10).dwg PLOTTED ON: 6/10/2019 10:35 AM PLOTTED BY: Rickabough, Greg PLOT FILE: ENVIRONMENTAL_COLOR.ctb

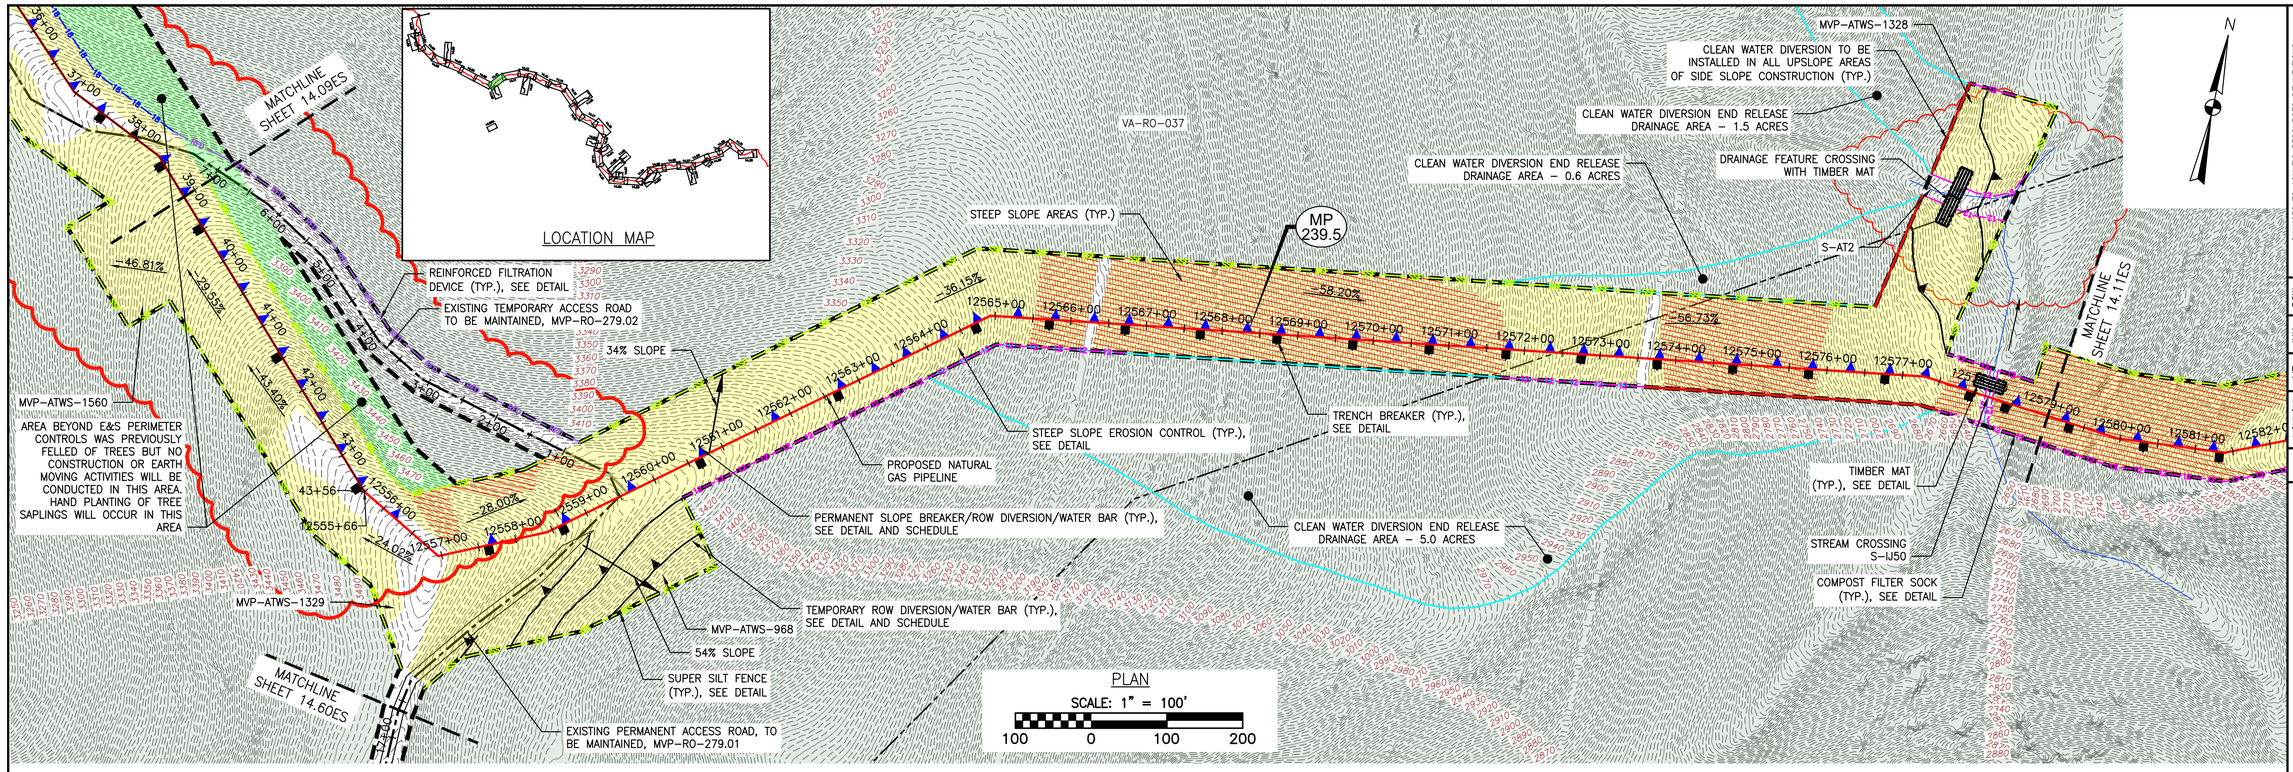

LEGEND

- PROPOSED LIMIT OF DISTURBANCE
- STREAM
- USDA FOREST SERVICE (NATIONAL FOREST) LANDS
- APPALACHIAN NATIONAL SCENIC TRAIL
- EXISTING ROAD/TRAIL
- EXISTING PROPERTY LINE
- EXISTING STATE LINE
- EXISTING COUNTY LINE
- POND
- WETLAND
- ACID FORMING MATERIAL
- EXISTING FOREST
- PROPOSED ACCESS ROAD CENTERLINE
- PROPOSED PIPELINE
- PROPOSED SILT FENCE (SEE NOTE 5)
- PROPOSED SUPER SILT FENCE (SEE DETAIL MVP-ES9.2)
- PROPOSED REINFORCED FILTRATION DEVICE (SEE DETAILS MVP-ES9, 9.1, 9.2, 9.3)
- ORANGE CONSTRUCTION SAFETY FENCE
- PROPOSED COMPOST FILTER SOCK (SEE DETAILS MVP-ES3, 3.1, 3.2)
- PROPOSED COMPOST FILTER SOCK (SEE DETAILS MVP-ES3, 3.1, 3.2)
- PROPOSED COMPOST FILTER SOCK (SEE DETAILS MVP-ES3, 3.1, 3.2)
- GRASS-LINED CHANNEL (SEE DETAIL MVP-ES39)
- CLEAN WATER DIVERSION PIPE
- CLEAN WATER DIVERSION DIKE (SEE DETAIL MVP-ES50 AND MVP-ES51)
- STREAM FLOW DIRECTION
- FEMA 100 YEAR FLOODPLAIN
- DRAINAGE AREA BOUNDARY
- TIMBER MAT (SEE DETAIL MVP-ES37)
- STEEP SLOPE EROSION CONTROL (SEE NOTE 2)
- STEEP SLOPE AREAS (SEE NOTE 4)
- PROPOSED ROCK CONSTRUCTION ENTRANCE
- PROPOSED TRENCH BREAKER (SEE DETAIL MVP-20)
- TEMPORARY ROW DIVERSION/WATER BAR (SEE DETAIL MP-17)
- PERMANENT SLOPE BREAKER/ROW DIVERSION/WATER BAR (SEE DETAIL MVP-17)
- AREA WHERE HAND PLANTING OF TREE SAPLINGS WILL OCCUR

COMMONWEALTH OF VIRGINIA
12/7/23
DANIEL C. WITT
Lic. No. 65093
PROFESSIONAL ENGINEER

THIS SEAL APPLIES TO REVISIONS DATED 12-07-23

NOTES:

1. TOPSOIL SEGREGATION WILL BE PERFORMED IN ALL IMMEDIATE CONSTRUCTION AREAS OF THE PROJECT IN ACCORDANCE WITH DETAILS MVP-ES46.1 THROUGH MVP-ES46.3.
2. FLEXTERRA, EARTHGUARD OR EQUIVALENT MAY BE USED AS A SUBSTITUTE TO EROSION CONTROL BLANKET AS DIRECTED BY MVP.
3. CONTRACTOR IS RESPONSIBLE TO IDENTIFY ALL UTILITIES. THE UTILITY LINES SHOWN ON THE PLAN ARE FOR INFORMATIONAL PURPOSES ONLY AND DO NOT REPRESENT SURVEYED LINE INFORMATION.
4. SLOPES OF 30° OR GREATER EXIST. CONSTRUCTION FOR STEEP SLOPES TO BE PERFORMED USING STEEP SLOPE TECHNIQUES IDENTIFIED IN THE DETAIL SHEETS. ALSO REFER TO THE SITE-SPECIFIC DESIGN OF STABILIZATION MEASURES IN SELECTED HIGH-HAZARD PORTIONS OF THE ROUTE OF THE PROPOSED MOUNTAIN VALLEY PIPLELINE PROJECT.
5. WHERE CONSTRUCTION CONDITIONS PRECLUDE THE USE OF DIVERSION DITCHES DUE TO SITE CONDITIONS THE CONTRACTOR WILL INSTALL SILT FENCE AT THE DIRECTION OF MVP.
6. IMPROVEMENTS TO PERMANENT AND TEMPORARY ACCESS ROADS WILL BE PERFORMED PER THE SITE SPECIFIC ACCESS ROAD DETAILS.
7. TEMPORARY ACCESS ROAD CROSSING OF STREAMS AND WETLANDS WILL UTILIZE TIMBERMATS. ANY PERMANENT ROAD CROSSINGS WILL BE CONDUCTED VIA CULVERTS.
8. ALL NON VMRC STREAM CROSSINGS WILL BE PERFORMED AS DESCRIBED IN THE STREAM CROSSING TABLE INCLUDED IN THIS PACKAGE.

NO.:	DATE:	DWN.:	CHKD.:	APPD.:	DESCRIPTION:
–	12/07/23	JJZ	RE	DW	CHANGES TO AQUATIC RESOURCES DELINEATIONS
–	06/07/19	GAR	RE	DW	ADDRESS VADEQ COMMENTS TO FIELD MODIFICATION SUBMITTAL
–	03/26/19	JWK	RE	DW	ADDRESS VADEQ COMMENTS TO FIELD MODIFICATION SUBMITTAL
6	07/31/18	JJZ	RE	DW	FIELD MODIFICATION
5	03/04/18	KAL	RE	DW	ADDRESS VADEQ COMMENTS
4	02/27/18	KAL	RE	DW	ADDRESS VADEQ COMMENTS

REVISIONS:

Mountain Valley PIPELINE

EROSION AND SEDIMENT CONTROL PLANS
MOUNTAIN VALLEY PIPELINE PROJECT – H600 LINE
SPREAD 10 – ROANOKE COUNTY, VIRGINIA

MOUNTAIN VALLEY PIPELINE, LLC
2200 ENERGY DRIVE
CANONSBURG, PA 15311


TETRA TECH
complex world | CLEAR SOLUTIONS™
661 ANDERSEN DRIVE
FOSTER PLAZA 7
PITTSBURGH, PA 15220


EROSION AND SEDIMENT CONTROL PLANS

COMMONWEALTH OF VIRGINIA
DAVID J. WALLNER
Lic. No. 0402057593
PROFESSIONAL ENGINEER

DRAWN BY:	JZ
CHECKED BY:	IHH
APPROVED BY:	DCW
DATE:	12/07/2023
SCALE:	AS SHOWN
REVISION	1
SHT. NO.	14.10ES OF 14.81ES

TETRA TECH CAD FILE PATH: X:\CADD_Pittsburgh\EQT\7157 – MVP\14 – Roanoke\E&S\E&S VERSION 5.0.0\7157ES14.10(S10).dwg PLOTTED ON: 12/7/2023 2:28 PM PLOTTED BY: Zeigler, Justin PLOT FILE: ENVIRONMENTAL_COLOR.ctb

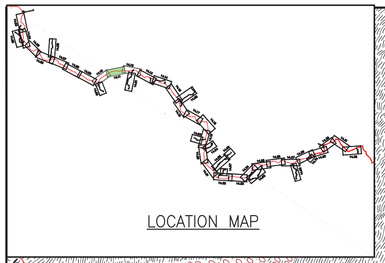

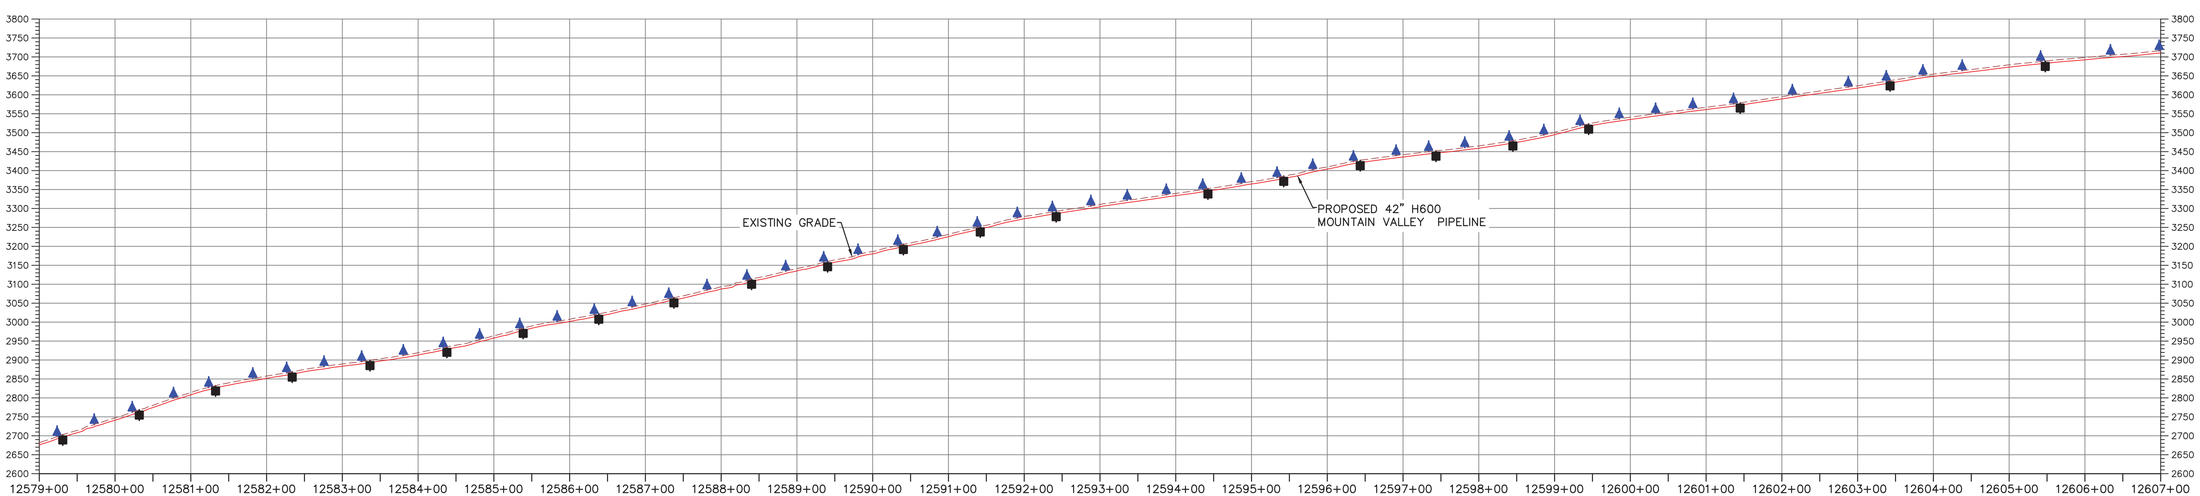

PROFILE

HORIZONTAL SCALE: SCALE: 1" = 100' (100 0 100 200)

VERTICAL SCALE: SCALE: 1" = 200' (200 0 200 400)

LEGEND

- PROPOSED LIMIT OF DISTURBANCE
- STREAM
- USDA FOREST SERVICE (NATIONAL FOREST) LANDS
- APPALACHIAN NATIONAL SCENIC TRAIL
- EXISTING ROAD/TRAIL
- EXISTING PROPERTY LINE
- EXISTING STATE LINE
- EXISTING COUNTY LINE
- POND
- WETLAND
- ACID FORMING MATERIAL
- AGRICULTURAL LAND USE BOUNDARY
- PROPOSED ACCESS ROAD CENTERLINE
- PROPOSED PIPELINE
- PROPOSED SILT FENCE (SEE NOTE 5)
- PROPOSED SUPER SILT FENCE (SEE DETAIL MVP-ES9.2)
- PROPOSED REINFORCED FILTRATION DEVICE (SEE DETAILS MVP-ES9, 9.1, 9.2, 9.3)
- ORANGE CONSTRUCTION SAFETY FENCE
- PROPOSED COMPOST FILTER SOCK (SEE DETAILS MVP-ES3, 3.1, 3.2)
- PROPOSED COMPOST FILTER SOCK (SEE DETAILS MVP-ES3, 3.1, 3.2)
- PROPOSED COMPOST FILTER SOCK (SEE DETAILS MVP-ES3, 3.1, 3.2)
- GRASS-LINED CHANNEL (SEE DETAIL MVP-ES39)
- CLEAN WATER DIVERSION PIPE
- CLEAN WATER DIVERSION DIKE (SEE DETAIL MVP-ES50 AND MVP-ES51)
- STREAM FLOW DIRECTION
- FEMA 100 YEAR FLOODPLAIN
- DRAINAGE AREA BOUNDARY
- TIMBER MAT (SEE DETAIL MVP-ES37)
- STEEP SLOPE EROSION CONTROL (SEE NOTE 2)
- STEEP SLOPE AREAS (SEE NOTE 4)
- PROPOSED ROCK CONSTRUCTION ENTRANCE
- PROPOSED TRENCH BREAKER (SEE DETAIL MVP-20)
- TEMPORARY ROW DIVERSION/WATER BAR (VADEQ STD & SPEC 3.11)
- PERMANENT SLOPE BREAKER/ROW DIVERSION/WATER BAR (SEE DETAILS MVP-17, ES38, AND SCHEDULE)

NOTES:

1. TOPSOIL SEGREGATION WILL BE PERFORMED IN ALL IMMEDIATE CONSTRUCTION AREAS OF THE PROJECT IN ACCORDANCE WITH DETAILS MVP-ES46.1 THROUGH MVP-ES46.3.
2. FLEXTERRA, EARTHGUARD OR EQUIVALENT MAY BE USED AS A SUBSTITUTE TO EROSION CONTROL BLANKET AS DIRECTED BY MVP.
3. CONTRACTOR IS RESPONSIBLE TO IDENTIFY ALL UTILITIES. THE UTILITY LINES SHOWN ON THE PLAN ARE FOR INFORMATIONAL PURPOSES ONLY AND DO NOT REPRESENT SURVEYED LINE INFORMATION.
4. SLOPES OF 30% OR GREATER EXIST. CONSTRUCTION FOR STEEP SLOPES TO BE PERFORMED USING STEEP SLOPE TECHNIQUES IDENTIFIED IN THE DETAIL SHEETS. ALSO REFER TO THE SITE-SPECIFIC DESIGN OF STABILIZATION MEASURES IN SELECTED HIGH-HAZARD PORTIONS OF THE ROUTE OF THE PROPOSED MOUNTAIN VALLEY PIPLELINE PROJECT.
5. WHERE CONSTRUCTION CONDITIONS PRECLUDE THE USE OF DIVERSION DITCHES DUE TO SITE CONDITIONS THE CONTRACTOR WILL INSTALL SILT FENCE AT THE DIRECTION OF MVP.
6. IMPROVEMENTS TO PERMANENT AND TEMPORARY ACCESS ROADS WILL BE PERFORMED PER THE SITE SPECIFIC ACCESS ROAD DETAILS.
7. TEMPORARY ACCESS ROAD CROSSING OF STREAMS AND WETLANDS WILL UTILIZE TIMBERMATS. ANY PERMANENT ROAD CROSSINGS WILL BE CONDUCTED VIA CULVERTS.
8. ALL NON VMRC STREAM CROSSINGS WILL BE PERFORMED AS DESCRIBED IN THE STREAM CROSSING TABLE INCLUDED IN THIS PACKAGE.

NO.	DATE:	DWN.:	CHKD.:	APPD.:	DESCRIPTION:
5	03/04/18	KAL	RE	DW	ADDRESS VADEQ COMMENTS
4	02/27/18	KAL	RE	DW	ADDRESS VADEQ COMMENTS
3	02/05/18	KAL	RE	DW	ADDRESS VADEQ COMMENTS
2	11/21/17	KAL	RE	DW	ADDRESS VADEQ COMMENTS
1	09/21/17	KAL	RE	DW	PLAN SUBMISSION

REVISIONS:

Mountain Valley

EROSION AND SEDIMENT CONTROL PLANS

MOUNTAIN VALLEY PIPELINE PROJECT – H600 LINE

SPREAD 10 – ROANOKE COUNTY, VIRGINIA

MOUNTAIN VALLEY PIPELINE, LLC

555 SOUTHPOINTE BOULEVARD, SUITE 200

CANONSBURG, PA 15311

TETRA TECH

complex world | CLEAR SOLUTIONS™


661 ANDERSEN DRIVE
FOSTER PLAZA 7
PITTSBURGH, PA 15220

EROSION AND SEDIMENT CONTROL PLANS

COMMONWEALTH OF VIRGINIA
DAVID J. WALLNER
Lic. No. 0402057593
PROFESSIONAL ENGINEER

DRAWN BY:	KAL
CHECKED BY:	RE
APPROVED BY:	DW
DATE:	03/04/2018
SCALE:	AS SHOWN
REVISION	5
SHT. NO.	14.11 OF 14.81ES


TETRA TECH CAD FILE PATH: X:\CADD_Pittsburgh\EQT\7157 – MVP\14 – Roanoke\E&S\E&S VERSION 5.0.0\7157ES14.11(S10).dwg PLOTTED ON: 3/2/2018 12:21 PM PLOTTED BY: Zeigler, Justin PLOT FILE: ENVIRONMENTAL_COLOR.ctb

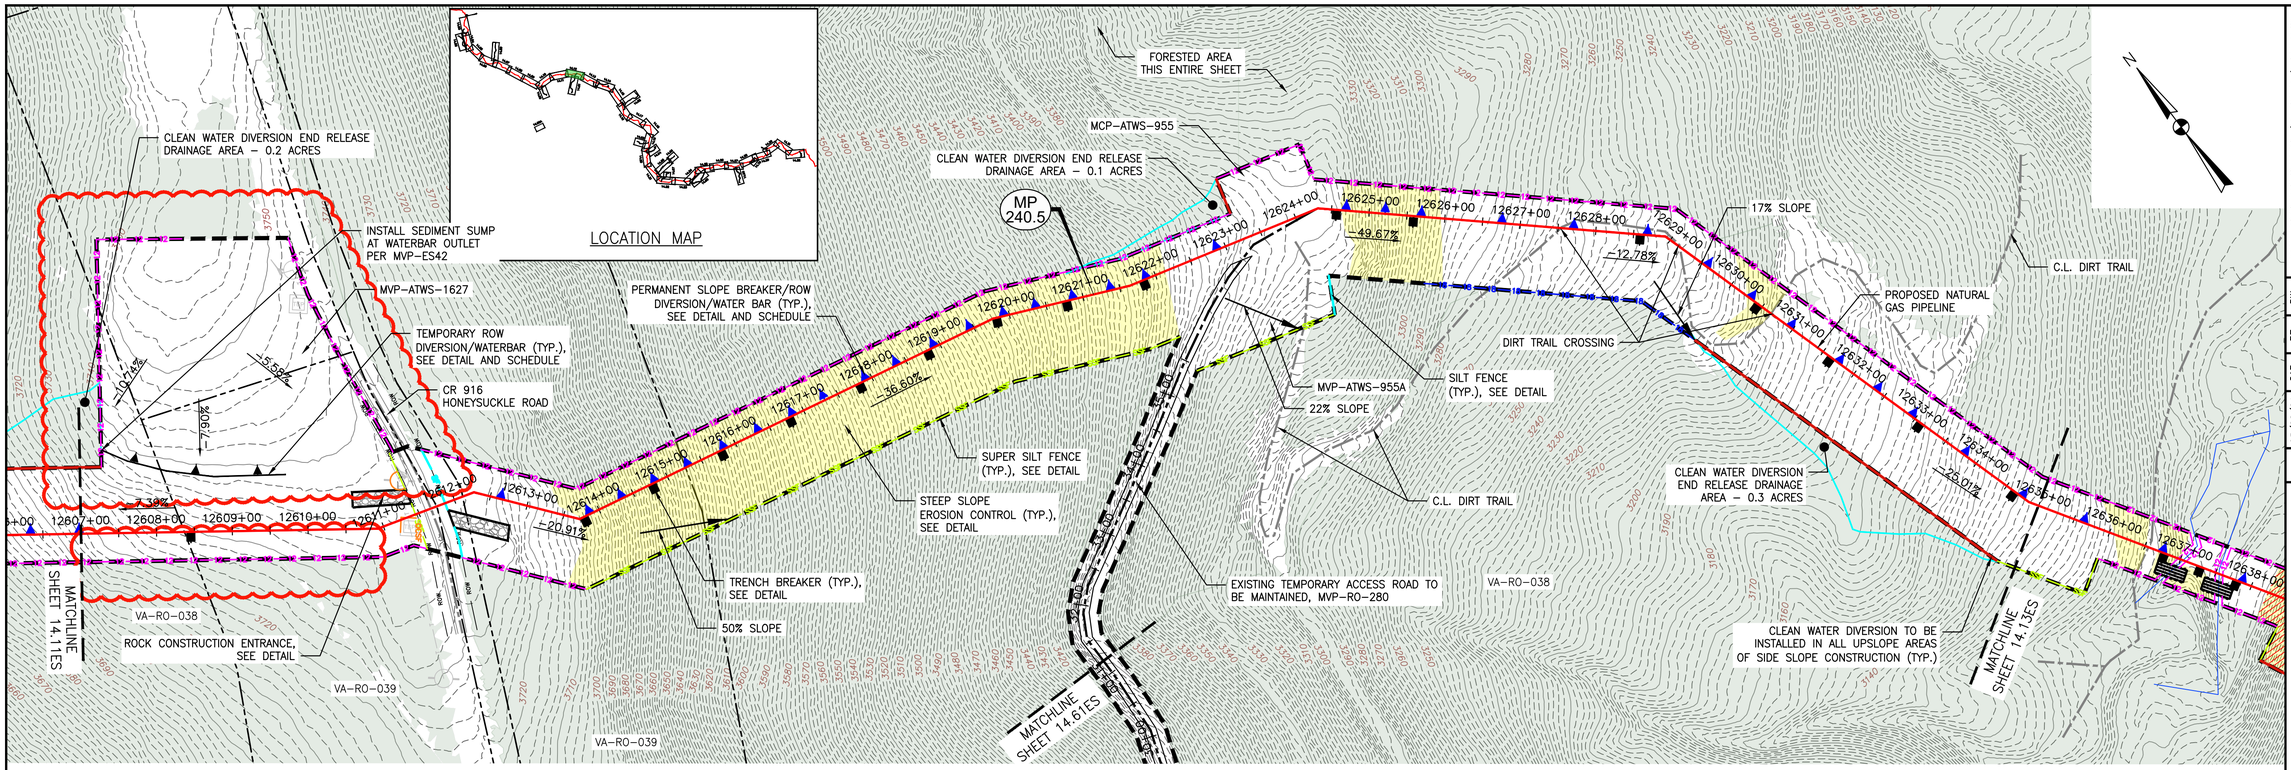

PLAN

SCALE: 1" = 100'

100 0 100 200

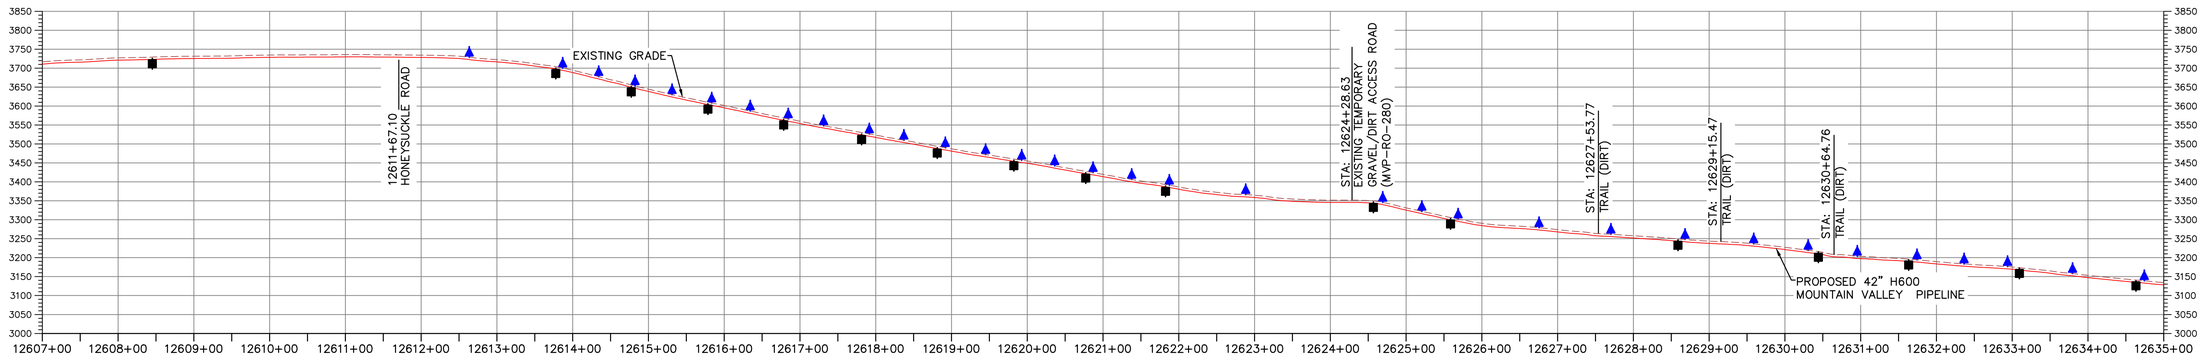

PROFILE

HORIZONTAL SCALE: SCALE: 1" = 100'

100 0 100 200

VERTICAL SCALE: SCALE: 1" = 200'

200 0 200 400

LEGEND

- PROPOSED LIMIT OF DISTURBANCE
- STREAM
- USDA FOREST SERVICE (NATIONAL FOREST) LANDS
- APPALACHIAN NATIONAL SCENIC TRAIL
- EXISTING ROAD/TRAIL
- EXISTING PROPERTY LINE
- EXISTING STATE LINE
- EXISTING COUNTY LINE
- POND
- WETLAND
- ACID FORMING MATERIAL
- EXISTING FOREST
- PROPOSED ACCESS ROAD CENTERLINE
- PROPOSED PIPELINE
- PROPOSED SILT FENCE (SEE NOTE 5)
- PROPOSED SUPER SILT FENCE (SEE DETAIL MVP–ES9.2)
- PROPOSED REINFORCED FILTRATION DEVICE (SEE DETAILS MVP–ES9, 9.1, 9.2, 9.3)
- ORANGE CONSTRUCTION SAFETY FENCE
- PROPOSED COMPOST FILTER SOCK (SEE DETAILS MVP–ES3, 3.1, 3.2)
- PROPOSED COMPOST FILTER SOCK (SEE DETAILS MVP–ES3, 3.1, 3.2)
- PROPOSED COMPOST FILTER SOCK (SEE DETAILS MVP–ES3, 3.1, 3.2)
- GRASS–LINED CHANNEL (SEE DETAIL MVP–ES39)
- CLEAN WATER DIVERSION PIPE
- CLEAN WATER DIVERSION DIKE (SEE DETAIL MVP–ES50 AND MVP–ES51)
- STREAM FLOW DIRECTION
- FEMA 100 YEAR FLOODPLAIN
- DRAINAGE AREA BOUNDARY
- TIMBER MAT (SEE DETAIL MVP–ES37)
- STEEP SLOPE EROSION CONTROL (SEE NOTE 2)
- STEEP SLOPE AREAS (SEE NOTE 4)
- PROPOSED ROCK CONSTRUCTION ENTRANCE
- PROPOSED TRENCH BREAKER (SEE DETAIL MVP–20)
- TEMPORARY ROW DIVERSION/WATER BAR (SEE DETAIL MP–17)
- PERMANENT SLOPE BREAKER/ROW DIVERSION/WATER BAR (SEE DETAIL MVP–17)

NOTES:

1. TOPSOIL SEGREGATION WILL BE PERFORMED IN ALL IMMEDIATE CONSTRUCTION AREAS OF THE PROJECT IN ACCORDANCE WITH DETAILS MVP–ES46.1 THROUGH MVP–ES46.3.
2. FLEXTERRA, EARTHGUARD OR EQUIVALENT MAY BE USED AS A SUBSTITUTE TO EROSION CONTROL BLANKET AS DIRECTED BY MVP.
3. CONTRACTOR IS RESPONSIBLE TO IDENTIFY ALL UTILITIES. THE UTILITY LINES SHOWN ON THE PLAN ARE FOR INFORMATIONAL PURPOSES ONLY AND DO NOT REPRESENT SURVEYED LINE INFORMATION.
4. SLOPES OF 30" OR GREATER EXIST. CONSTRUCTION FOR STEEP SLOPES TO BE PERFORMED USING STEEP SLOPE TECHNIQUES IDENTIFIED IN THE DETAIL SHEETS. ALSO REFER TO THE SITE–SPECIFIC DESIGN OF STABILIZATION MEASURES IN SELECTED HIGH–HAZARD PORTIONS OF THE ROUTE OF THE PROPOSED MOUNTAIN VALLEY PIPLELINE PROJECT.
5. WHERE CONSTRUCTION CONDITIONS PRECLUDE THE USE OF DIVERSION DITCHES DUE TO SITE CONDITIONS THE CONTRACTOR WILL INSTALL SILT FENCE AT THE DIRECTION OF MVP.
6. IMPROVEMENTS TO PERMANENT AND TEMPORARY ACCESS ROADS WILL BE PERFORMED PER THE SITE SPECIFIC ACCESS ROAD DETAILS.
7. TEMPORARY ACCESS ROAD CROSSING OF STREAMS AND WETLANDS WILL UTILIZE TIMBERMATS. ANY PERMANENT ROAD CROSSINGS WILL BE CONDUCTED VIA CULVERTS.
8. ALL NON VMRC STREAM CROSSINGS WILL BE PERFORMED AS DESCRIBED IN THE STREAM CROSSING TABLE INCLUDED IN THIS PACKAGE.

TETRA TECH CAD FILE PATH: X:\CADD_Pittsburgh\EQT\7157 – MVP\14 – Roanoke\E&S\E&S VERSION 5.0.0\7157ES14.12(S10).dwg PLOTTED ON: 5/28/2021 1:54 PM PLOTTED BY: Rickabough, Greg PLOT FILE: ENVIRONMENTAL_COLOR.ctb

NO.	DATE:	DWN.:	CHKD.:	APPD.:	DESCRIPTION:
–	05/28/21	GAR	RE	DW	ADDRESS VADEQ COMMENTS TO MP 240.1 (MVP–ATWS–1627) MOD SUBMITTAL
–	08/22/19	JJZ	RE	DW	ADDRESS VADEQ COMMENTS TO MP 240.1 (MVP–ATWS–1627) MOD SUBMITTAL
–	05/14/19	JWK	RE	DW	FIELD MODIFICATION – MP 240.1 (MVP–ATWS–1627)
5	03/04/18	KAL	RE	DW	ADDRESS VADEQ COMMENTS
4	02/27/18	KAL	RE	DW	ADDRESS VADEQ COMMENTS
3	02/05/18	KAL	RE	DW	ADDRESS VADEQ COMMENTS

REVISIONS:

Mountain Valley PIPELINE

EROSION AND SEDIMENT CONTROL PLANS

MOUNTAIN VALLEY PIPELINE PROJECT – H600 LINE

SPREAD 10 – ROANOKE COUNTY, VIRGINIA

MOUNTAIN VALLEY PIPELINE, LLC
2200 ENERGY DRIVE
CANONSBURG, PA 15311


TETRA TECH
complex world | CLEAR SOLUTIONS™
661 ANDERSEN DRIVE
FOSTER PLAZA 7
PITTSBURGH, PA 15220

EROSION AND SEDIMENT CONTROL PLANS

COMMONWEALTH OF VIRGINIA
DAVID J. WALLNER
Lic. No. 57593
PROFESSIONAL ENGINEER
5/28/2021

DRAWN BY:	GR
CHECKED BY:	RE
APPROVED BY:	DW
DATE:	05/28/21
SCALE:	AS SHOWN
REVISION	–


SHT. NO. 14.12ES OF 14.81ES

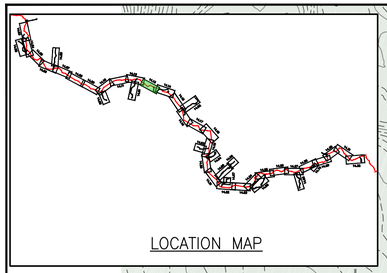

PLAN

SCALE: 1" = 100'

100 0 100 200

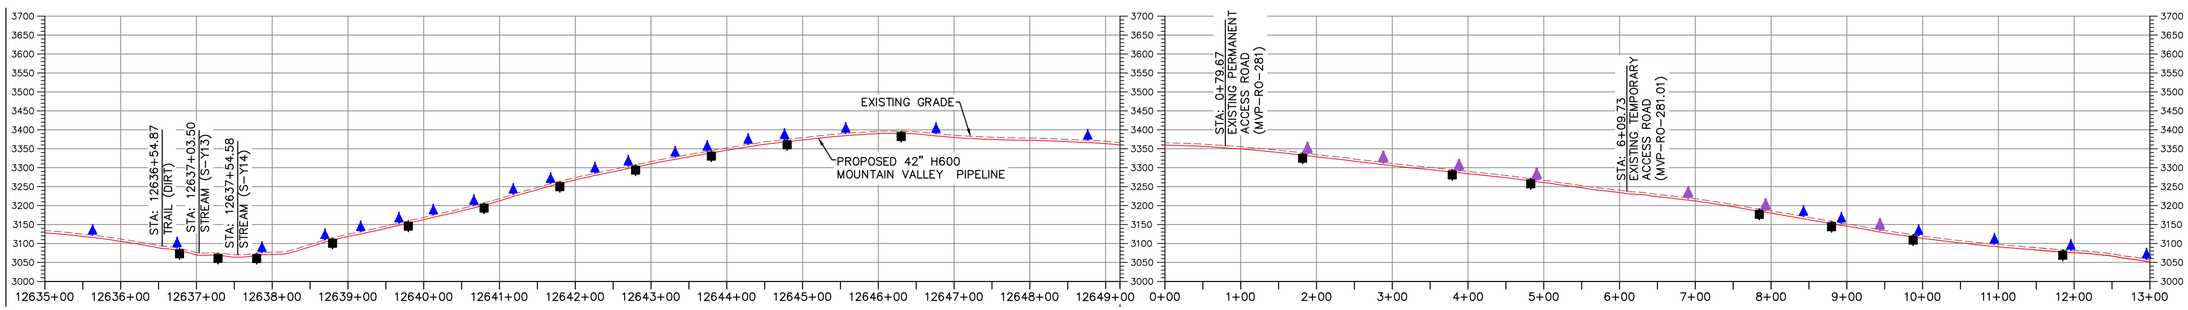

PROFILE

HORIZONTAL SCALE:

SCALE: 1" = 100'

100 0 100 200

VERTICAL SCALE:

SCALE: 1" = 200'

200 0 200 400

LEGEND

- PROPOSED LIMIT OF DISTURBANCE
- STREAM
- USDA FOREST SERVICE (NATIONAL FOREST) LANDS
- APPALACHIAN NATIONAL SCENIC TRAIL
- EXISTING ROAD/TRAIL
- EXISTING PROPERTY LINE
- EXISTING STATE LINE
- EXISTING COUNTY LINE
- POND
- WETLAND
- ACID FORMING MATERIAL
- EXISTING FOREST
- PROPOSED ACCESS ROAD CENTERLINE
- PROPOSED PIPELINE
- PROPOSED SILT FENCE (SEE NOTE 5)
- PROPOSED SUPER SILT FENCE (SEE DETAIL MVP–ES9.2)
- PROPOSED REINFORCED FILTRATION DEVICE (SEE DETAILS MVP–ES9, 9.1, 9.2, 9.3)
- ORANGE CONSTRUCTION SAFETY FENCE
- PROPOSED COMPOST FILTER SOCK (SEE DETAILS MVP–ES3, 3.1, 3.2)
- PROPOSED COMPOST FILTER SOCK (SEE DETAILS MVP–ES3, 3.1, 3.2)
- PROPOSED COMPOST FILTER SOCK (SEE DETAILS MVP–ES3, 3.1, 3.2)
- GRASS–LINED CHANNEL (SEE DETAIL MVP–ES39)
- CLEAN WATER DIVERSION PIPE
- CLEAN WATER DIVERSION DIKE (SEE DETAIL MVP–ES50 AND MVP–ES51)
- STREAM FLOW DIRECTION
- FEMA 100 YEAR FLOODPLAIN
- DRAINAGE AREA BOUNDARY
- TIMBER MAT (SEE DETAIL MVP–ES37)
- STEEP SLOPE EROSION CONTROL (SEE NOTE 2)
- STEEP SLOPE AREAS (SEE NOTE 4)
- PROPOSED ROCK CONSTRUCTION ENTRANCE
- PROPOSED TRENCH BREAKER (SEE DETAIL MVP–20)
- TEMPORARY ROW DIVERSION/WATER BAR (SEE DETAIL MP–17)
- PERMANENT SLOPE BREAKER/ROW DIVERSION/WATER BAR (SEE DETAIL MVP–17)

NOTES:

1. TOPSOIL SEGREGATION WILL BE PERFORMED IN ALL IMMEDIATE CONSTRUCTION AREAS OF THE PROJECT IN ACCORDANCE WITH DETAILS MVP–ES46.1 THROUGH MVP–ES46.3.
2. FLEXTERRA, EARTHGUARD OR EQUIVALENT MAY BE USED AS A SUBSTITUTE TO EROSION CONTROL BLANKET AS DIRECTED BY MVP.
3. CONTRACTOR IS RESPONSIBLE TO IDENTIFY ALL UTILITIES. THE UTILITY LINES SHOWN ON THE PLAN ARE FOR INFORMATIONAL PURPOSES ONLY AND DO NOT REPRESENT SURVEYED LINE INFORMATION.
4. SLOPES OF 30" OR GREATER EXIST. CONSTRUCTION FOR STEEP SLOPES TO BE PERFORMED USING STEEP SLOPE TECHNIQUES IDENTIFIED IN THE DETAIL SHEETS. ALSO REFER TO THE SITE–SPECIFIC DESIGN OF STABILIZATION MEASURES IN SELECTED HIGH–HAZARD PORTIONS OF THE ROUTE OF THE PROPOSED MOUNTAIN VALLEY PIPLELINE PROJECT.
5. WHERE CONSTRUCTION CONDITIONS PRECLUDE THE USE OF DIVERSION DITCHES DUE TO SITE CONDITIONS THE CONTRACTOR WILL INSTALL SILT FENCE AT THE DIRECTION OF MVP.
6. IMPROVEMENTS TO PERMANENT AND TEMPORARY ACCESS ROADS WILL BE PERFORMED PER THE SITE SPECIFIC ACCESS ROAD DETAILS.
7. TEMPORARY ACCESS ROAD CROSSING OF STREAMS AND WETLANDS WILL UTILIZE TIMBERMATS. ANY PERMANENT ROAD CROSSINGS WILL BE CONDUCTED VIA CULVERTS.
8. ALL NON VMRC STREAM CROSSINGS WILL BE PERFORMED AS DESCRIBED IN THE STREAM CROSSING TABLE INCLUDED IN THIS PACKAGE.

NO.:	DATE:	DWN.:	CHKD.:	APPD.:	DESCRIPTION:
6	07/31/18	KAL	RE	DW	FIELD MODIFICATION
5	03/04/18	KAL	RE	DW	ADDRESS VADEQ COMMENTS
4	02/27/18	KAL	RE	DW	ADDRESS VADEQ COMMENTS
3	02/05/18	KAL	RE	DW	ADDRESS VADEQ COMMENTS
2	11/21/17	KAL	RE	DW	ADDRESS VADEQ COMMENTS
1	09/21/17	KAL	RE	DW	PLAN SUBMISSION

REVISIONS:

Mountain Valley PIPELINE

EROSION AND SEDIMENT CONTROL PLANS

MOUNTAIN VALLEY PIPELINE PROJECT – H600 LINE

SPREAD 10 – ROANOKE COUNTY, VIRGINIA


MOUNTAIN VALLEY PIPELINE, LLC
555 SOUTHPOINTE BOULEVARD, SUITE 200
CANONSBURG, PA 15311

TETRA TECH
complex world | CLEAR SOLUTIONS™
661 ANDERSEN DRIVE
FOSTER PLAZA 7
PITTSBURGH, PA 15220

EROSION AND SEDIMENT CONTROL PLANS


COMMONWEALTH OF VIRGINIA
DAVID J. WALLNER
Lic. No. 0402057593
PROFESSIONAL ENGINEER

DRAWN BY:	KAL
CHECKED BY:	RE
APPROVED BY:	DW
DATE:	07/31/2018
SCALE:	AS SHOWN
6 REVISION	
SHT. NO.	14.13ES OF 14.81ES

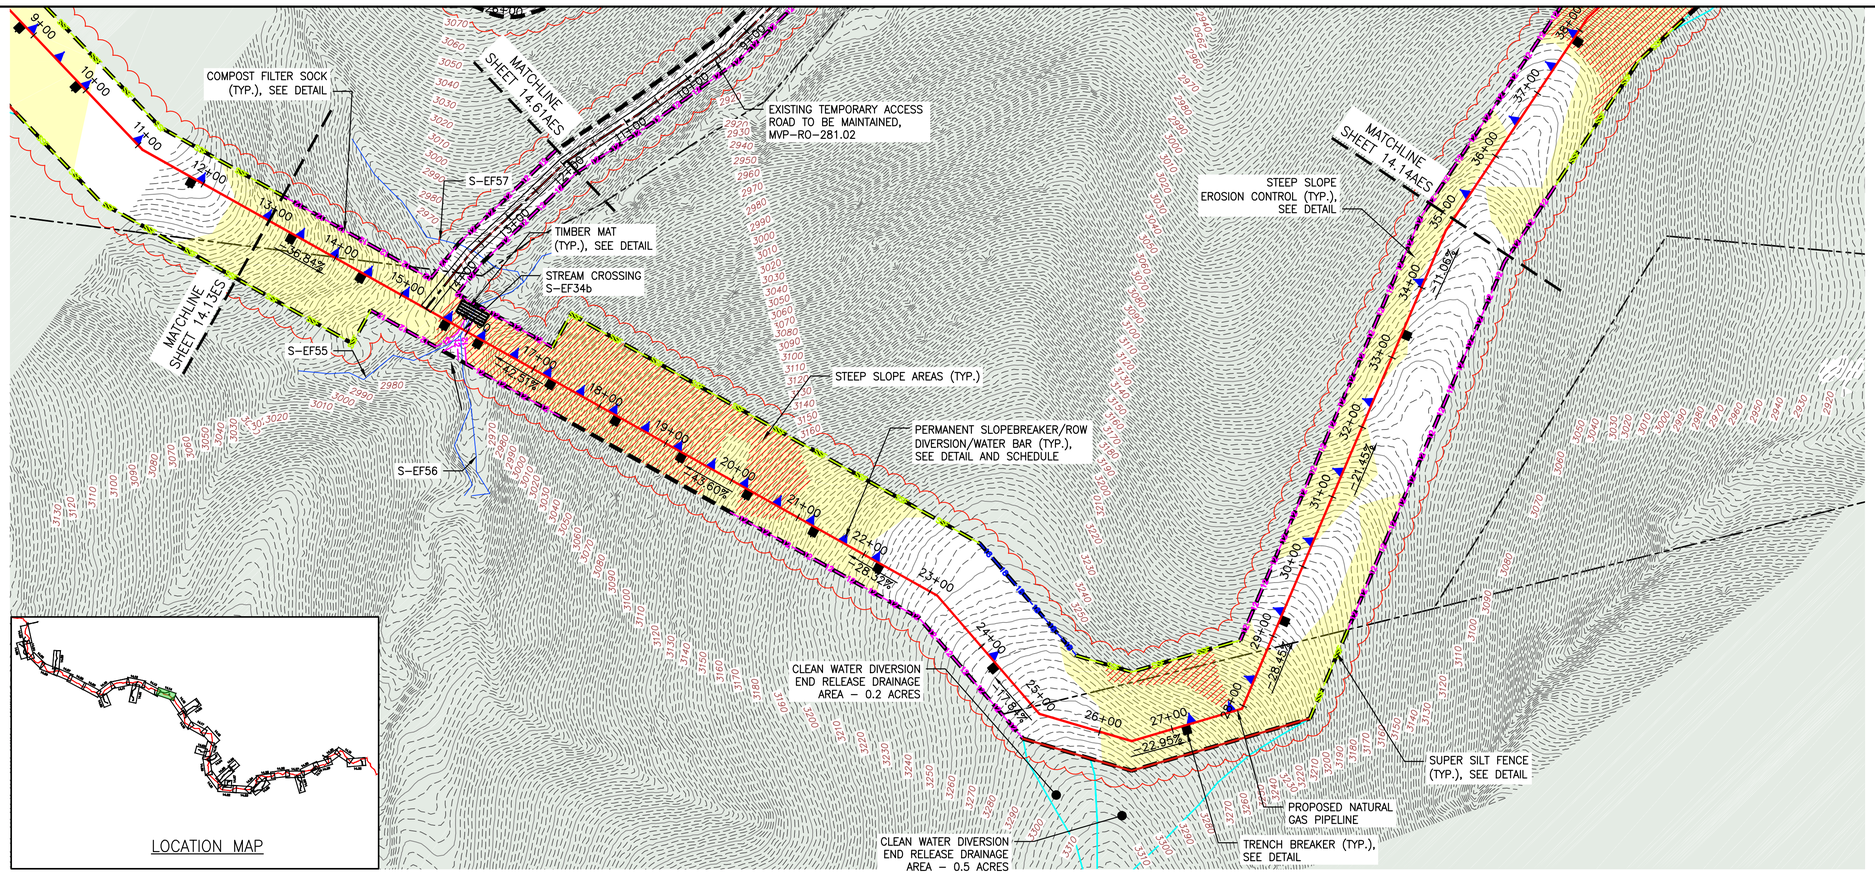

PLAN

SCALE: 1" = 100'

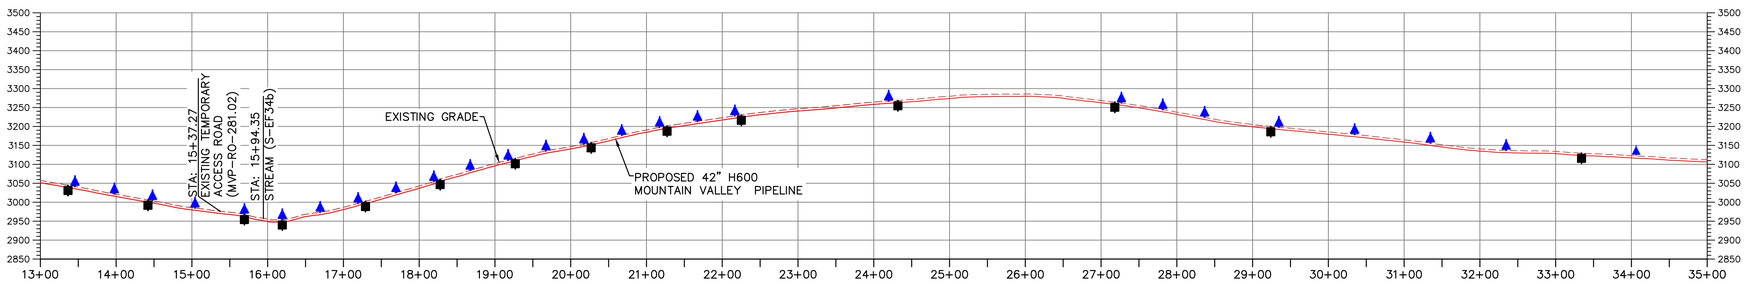

PROFILE

HORIZONTAL SCALE: SCALE: 1" = 100'

VERTICAL SCALE: SCALE: 1" = 200'

LEGEND

- PROPOSED LIMIT OF DISTURBANCE
- STREAM
- USDA FOREST SERVICE (NATIONAL FOREST) LANDS
- APPALACHIAN NATIONAL SCENIC TRAIL
- EXISTING ROAD/TRAIL
- EXISTING PROPERTY LINE
- EXISTING STATE LINE
- EXISTING COUNTY LINE
- POND
- WETLAND
- ACID FORMING MATERIAL
- EXISTING FOREST
- PROPOSED ACCESS ROAD CENTERLINE
- PROPOSED PIPELINE
- PROPOSED SILT FENCE (SEE NOTE 5)
- PROPOSED SUPER SILT FENCE (SEE DETAIL MVP-ES9.2)
- PROPOSED REINFORCED FILTRATION DEVICE (SEE DETAILS MVP-ES9, 9.1, 9.2, 9.3)
- ORANGE CONSTRUCTION SAFETY FENCE
- PROPOSED COMPOST FILTER SOCK (SEE DETAILS MVP-ES3, 3.1, 3.2)
- PROPOSED COMPOST FILTER SOCK (SEE DETAILS MVP-ES3, 3.1, 3.2)
- PROPOSED COMPOST FILTER SOCK (SEE DETAILS MVP-ES3, 3.1, 3.2)
- GRASS-LINED CHANNEL (SEE DETAIL MVP-ES39)
- CLEAN WATER DIVERSION PIPE
- CLEAN WATER DIVERSION DIKE (SEE DETAIL MVP-ES50 AND MVP-ES51)
- STREAM FLOW DIRECTION
- FEMA 100 YEAR FLOODPLAIN
- DRAINAGE AREA BOUNDARY
- TIMBER MAT (SEE DETAIL MVP-ES37)
- STEEP SLOPE EROSION CONTROL (SEE NOTE 2)
- STEEP SLOPE AREAS (SEE NOTE 4)
- PROPOSED ROCK CONSTRUCTION ENTRANCE
- PROPOSED TRENCH BREAKER (SEE DETAIL MVP-20)
- TEMPORARY ROW DIVERSION/WATER BAR (SEE DETAIL MP-17)
- PERMANENT SLOPE BREAKER/ROW DIVERSION/WATER BAR (SEE DETAIL MVP-17)

NOTES:

1. TOPSOIL SEGREGATION WILL BE PERFORMED IN ALL IMMEDIATE CONSTRUCTION AREAS OF THE PROJECT IN ACCORDANCE WITH DETAILS MVP-ES46.1 THROUGH MVP-ES46.3.
2. FLEXTERRA, EARTHGUARD OR EQUIVALENT MAY BE USED AS A SUBSTITUTE TO EROSION CONTROL BLANKET AS DIRECTED BY MVP.
3. CONTRACTOR IS RESPONSIBLE TO IDENTIFY ALL UTILITIES. THE UTILITY LINES SHOWN ON THE PLAN ARE FOR INFORMATIONAL PURPOSES ONLY AND DO NOT REPRESENT SURVEYED LINE INFORMATION.
4. SLOPES OF 30° OR GREATER EXIST. CONSTRUCTION FOR STEEP SLOPES TO BE PERFORMED USING STEEP SLOPE TECHNIQUES IDENTIFIED IN THE DETAIL SHEETS. ALSO REFER TO THE SITE-SPECIFIC DESIGN OF STABILIZATION MEASURES IN SELECTED HIGH-HAZARD PORTIONS OF THE ROUTE OF THE PROPOSED MOUNTAIN VALLEY PIPLELINE PROJECT.
5. WHERE CONSTRUCTION CONDITIONS PRECLUDE THE USE OF DIVERSION DITCHES DUE TO SITE CONDITIONS THE CONTRACTOR WILL INSTALL SILT FENCE AT THE DIRECTION OF MVP.
6. IMPROVEMENTS TO PERMANENT AND TEMPORARY ACCESS ROADS WILL BE PERFORMED PER THE SITE SPECIFIC ACCESS ROAD DETAILS.
7. TEMPORARY ACCESS ROAD CROSSING OF STREAMS AND WETLANDS WILL UTILIZE TIMBERMATS. ANY PERMANENT ROAD CROSSINGS WILL BE CONDUCTED VIA CULVERTS.
8. ALL NON VMRC STREAM CROSSINGS WILL BE PERFORMED AS DESCRIBED IN THE STREAM CROSSING TABLE INCLUDED IN THIS PACKAGE.

NO.:	DATE:	DWN.:	CHKD.:	APPD.:	DESCRIPTION:
6	07/31/18	KAL	RE	DW	FIELD MODIFICATION
5	03/04/18	KAL	RE	DW	ADDRESS VADEQ COMMENTS
4	02/27/18	KAL	RE	DW	ADDRESS VADEQ COMMENTS
3	02/05/18	KAL	RE	DW	ADDRESS VADEQ COMMENTS
2	11/21/17	KAL	RE	DW	ADDRESS VADEQ COMMENTS
1	09/21/17	KAL	RE	DW	PLAN SUBMISSION

REVISIONS:

Mountain Valley PIPELINE

EROSION AND SEDIMENT CONTROL PLANS

MOUNTAIN VALLEY PIPELINE PROJECT - H600 LINE

SPREAD 10 - ROANOKE COUNTY, VIRGINIA

MOUNTAIN VALLEY PIPELINE, LLC
555 SOUTHPOINTE BOULEVARD, SUITE 200
CANONSBURG, PA 15311

TETRA TECH
complex world | CLEAR SOLUTIONS™
661 ANDERSEN DRIVE
FOSTER PLAZA 7
PITTSBURGH, PA 15220


EROSION AND SEDIMENT CONTROL PLANS


COMMONWEALTH OF VIRGINIA
DAVID J. WALLNER
Lic. No. 0402057593
PROFESSIONAL ENGINEER

DRAWN BY:	KAL
CHECKED BY:	RE
APPROVED BY:	DW
DATE:	07/31/2018
SCALE:	AS SHOWN
REVISION	6

SHT. NO. 14.14ES OF 14.81ES

TETRA TECH CAD FILE PATH: X:\CADD_Pittsburgh\EQT\7157 - MVP\14 - Roanoke\E&S\E&S VERSION 5.0.0\7157ES14.14(S10).dwg PLOTTED ON: 7/31/2018 10:27 AM PLOTTED BY: Kusiowski, Jim PLOT FILE: ENVIRONMENTAL_COLOR.ctb

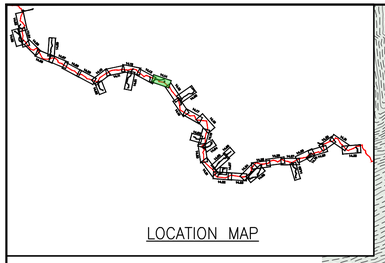


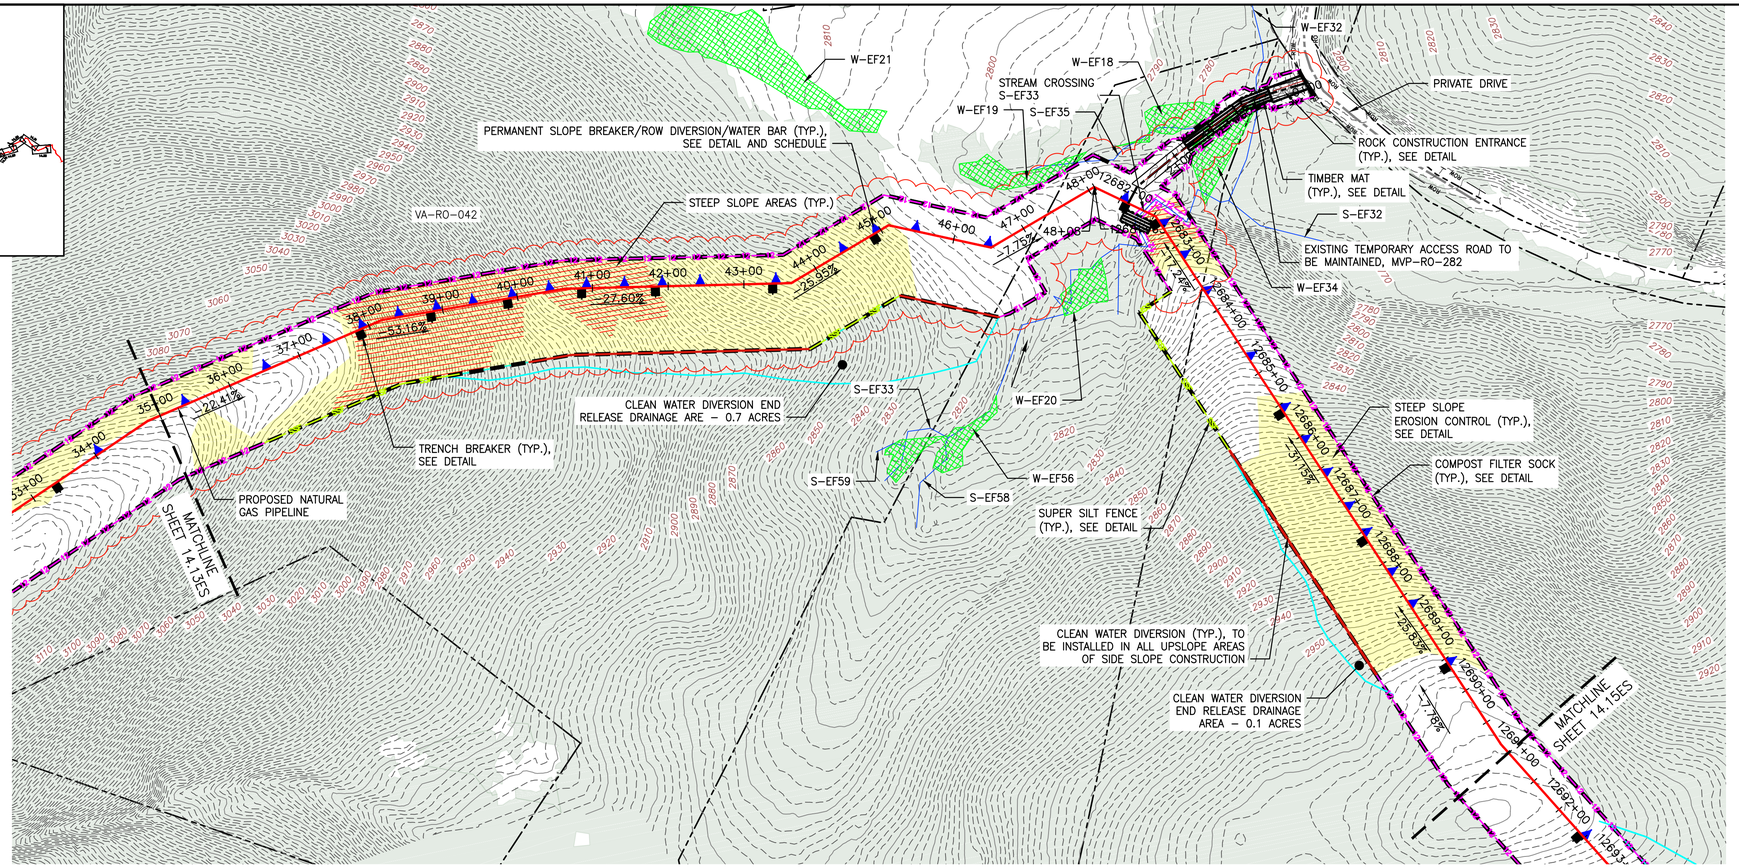

PLAN

SCALE: 1" = 100'

100 0 100 200

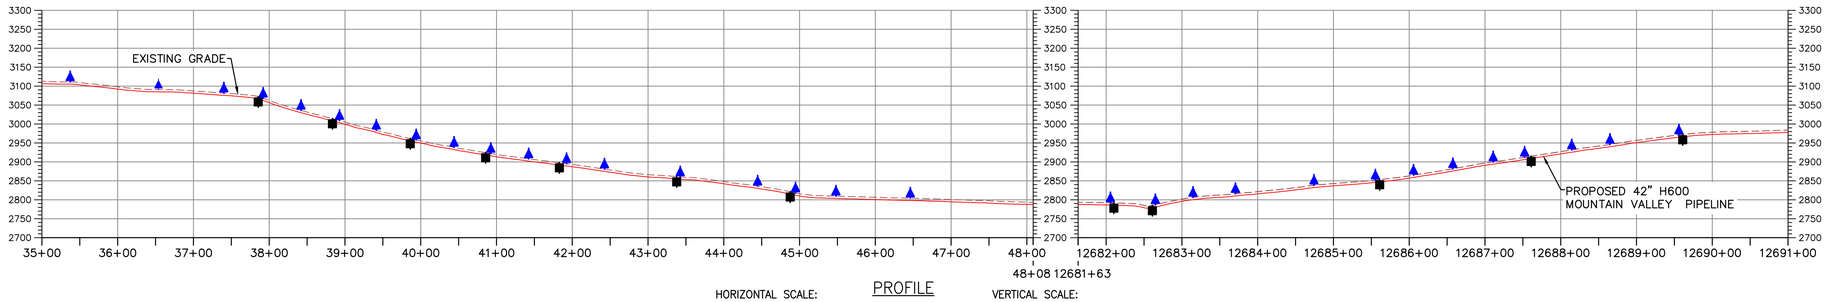

PROFILE

HORIZONTAL SCALE: SCALE: 1" = 100'

100 0 100 200

VERTICAL SCALE: SCALE: 1" = 200'

200 0 200 400

LEGEND

- PROPOSED LIMIT OF DISTURBANCE
- STREAM
- USDA FOREST SERVICE (NATIONAL FOREST) LANDS
- APPALACHIAN NATIONAL SCENIC TRAIL
- EXISTING ROAD/TRAIL
- EXISTING PROPERTY LINE
- EXISTING STATE LINE
- EXISTING COUNTY LINE
- POND
- WETLAND
- ACID FORMING MATERIAL
- EXISTING FOREST
- PROPOSED ACCESS ROAD CENTERLINE
- PROPOSED PIPELINE
- PROPOSED SILT FENCE (SEE NOTE 5)
- PROPOSED SUPER SILT FENCE (SEE DETAIL MVP-ES9.2)
- PROPOSED REINFORCED FILTRATION DEVICE (SEE DETAILS MVP-ES9, 9.1, 9.2, 9.3)
- ORANGE CONSTRUCTION SAFETY FENCE
- PROPOSED COMPOST FILTER SOCK (SEE DETAILS MVP-ES3, 3.1, 3.2)
- PROPOSED COMPOST FILTER SOCK (SEE DETAILS MVP-ES3, 3.1, 3.2)
- PROPOSED COMPOST FILTER SOCK (SEE DETAILS MVP-ES3, 3.1, 3.2)
- GRASS-LINED CHANNEL (SEE DETAIL MVP-ES39)
- CLEAN WATER DIVERSION PIPE
- CLEAN WATER DIVERSION DIKE (SEE DETAIL MVP-ES50 AND MVP-ES51)
- STREAM FLOW DIRECTION
- FEMA 100 YEAR FLOODPLAIN
- DRAINAGE AREA BOUNDARY
- TIMBER MAT (SEE DETAIL MVP-ES37)
- STEEP SLOPE EROSION CONTROL (SEE NOTE 2)
- STEEP SLOPE AREAS (SEE NOTE 4)
- PROPOSED ROCK CONSTRUCTION ENTRANCE
- PROPOSED TRENCH BREAKER (SEE DETAIL MVP-20)
- TEMPORARY ROW DIVERSION/WATER BAR (SEE DETAIL MP-17)
- PERMANENT SLOPE BREAKER/ROW DIVERSION/WATER BAR (SEE DETAIL MVP-17)

NOTES:

1. TOPSOIL SEGREGATION WILL BE PERFORMED IN ALL IMMEDIATE CONSTRUCTION AREAS OF THE PROJECT IN ACCORDANCE WITH DETAILS MVP-ES46.1 THROUGH MVP-ES46.3.
2. FLEXTERRA, EARTHGUARD OR EQUIVALENT MAY BE USED AS A SUBSTITUTE TO EROSION CONTROL BLANKET AS DIRECTED BY MVP.
3. CONTRACTOR IS RESPONSIBLE TO IDENTIFY ALL UTILITIES. THE UTILITY LINES SHOWN ON THE PLAN ARE FOR INFORMATIONAL PURPOSES ONLY AND DO NOT REPRESENT SURVEYED LINE INFORMATION.
4. SLOPES OF 30° OR GREATER EXIST. CONSTRUCTION FOR STEEP SLOPES TO BE PERFORMED USING STEEP SLOPE TECHNIQUES IDENTIFIED IN THE DETAIL SHEETS. ALSO REFER TO THE SITE-SPECIFIC DESIGN OF STABILIZATION MEASURES IN SELECTED HIGH-HAZARD PORTIONS OF THE ROUTE OF THE PROPOSED MOUNTAIN VALLEY PIPELINE PROJECT.
5. WHERE CONSTRUCTION CONDITIONS PRECLUDE THE USE OF DIVERSION DITCHES DUE TO SITE CONDITIONS THE CONTRACTOR WILL INSTALL SILT FENCE AT THE DIRECTION OF MVP.
6. IMPROVEMENTS TO PERMANENT AND TEMPORARY ACCESS ROADS WILL BE PERFORMED PER THE SITE SPECIFIC ACCESS ROAD DETAILS.
7. TEMPORARY ACCESS ROAD CROSSING OF STREAMS AND WETLANDS WILL UTILIZE TIMBERMATS. ANY PERMANENT ROAD CROSSINGS WILL BE CONDUCTED VIA CULVERTS.
8. ALL NON VMRC STREAM CROSSINGS WILL BE PERFORMED AS DESCRIBED IN THE STREAM CROSSING TABLE INCLUDED IN THIS PACKAGE.

NO.:	DATE:	DWN.:	CHKD.:	APPD.:	DESCRIPTION:
6	07/31/18	KAL	RE	DW	FIELD MODIFICATION
5	03/04/18	KAL	RE	DW	ADDRESS VADEQ COMMENTS
4	02/27/18	KAL	RE	DW	ADDRESS VADEQ COMMENTS
3	02/05/18	KAL	RE	DW	ADDRESS VADEQ COMMENTS
2	11/21/17	KAL	RE	DW	ADDRESS VADEQ COMMENTS
1	09/21/17	KAL	RE	DW	PLAN SUBMISSION

REVISIONS:

Mountain Valley PIPELINE

EROSION AND SEDIMENT CONTROL PLANS

MOUNTAIN VALLEY PIPELINE PROJECT – H600 LINE

SPREAD 10 – ROANOKE COUNTY, VIRGINIA

MOUNTAIN VALLEY PIPELINE, LLC
555 SOUTHPOINTE BOULEVARD, SUITE 200
CANONSBURG, PA 15311

TETRA TECH
complex world | CLEAR SOLUTIONS™
661 ANDERSEN DRIVE
FOSTER PLAZA 7
PITTSBURGH, PA 15220


EROSION AND SEDIMENT CONTROL PLANS

COMMONWEALTH OF VIRGINIA
DAVID J. WALLNER
Lic. No. 0402057593
PROFESSIONAL ENGINEER


DRAWN BY:	KAL
CHECKED BY:	RE
APPROVED BY:	DW
DATE:	07/31/2018
SCALE:	AS SHOWN
REVISION	6

SHT. NO. 14.14AES OF 14.81ES

TETRA TECH CAD FILE PATH: X:\CADD_Pittsburgh\EQT\7157 – MVP\14 – Roanoke\E&S\E&S VERSION 5.0.0\7157ES14.14A(S10).dwg PLOTTED ON: 7/31/2018 10:28 AM PLOTTED BY: Kusiowski, Jim PLOT FILE: ENVIRONMENTAL_COLOR.ctb

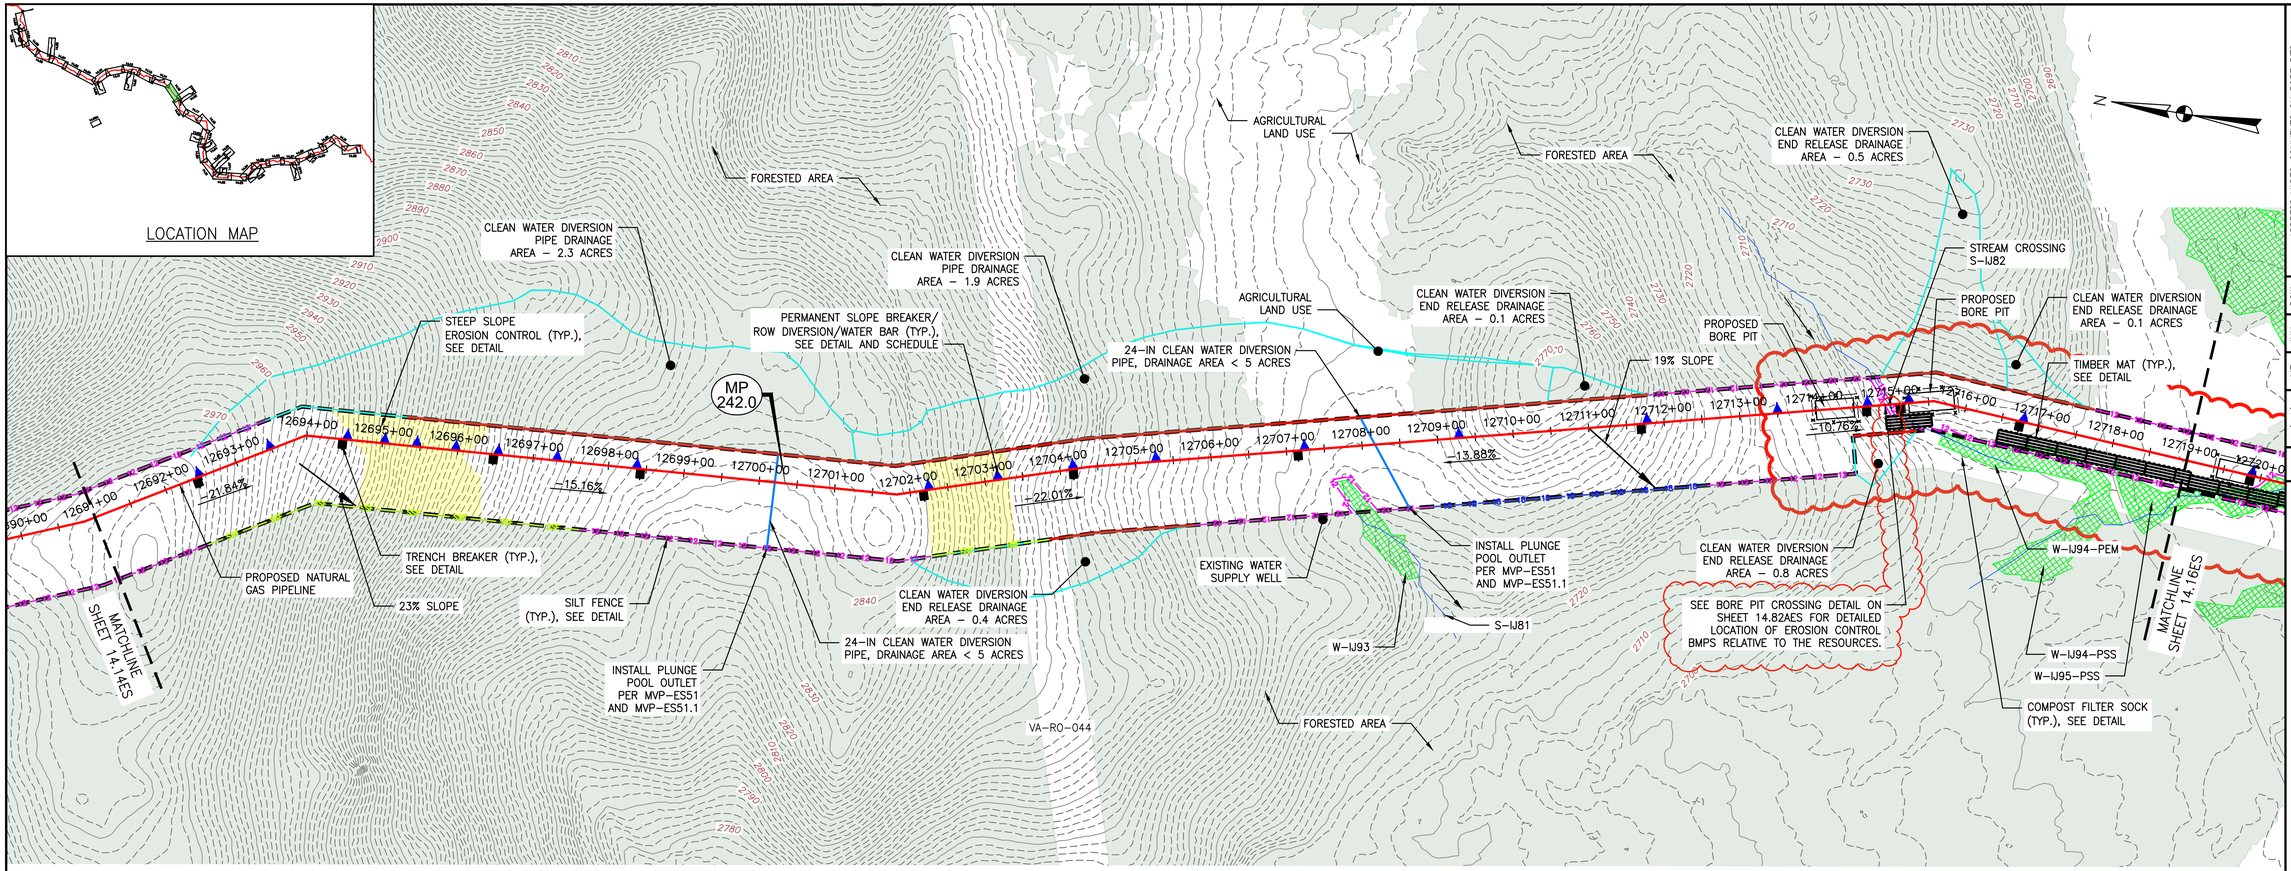

PLAN
SCALE: 1" = 100'
100 0 100 200

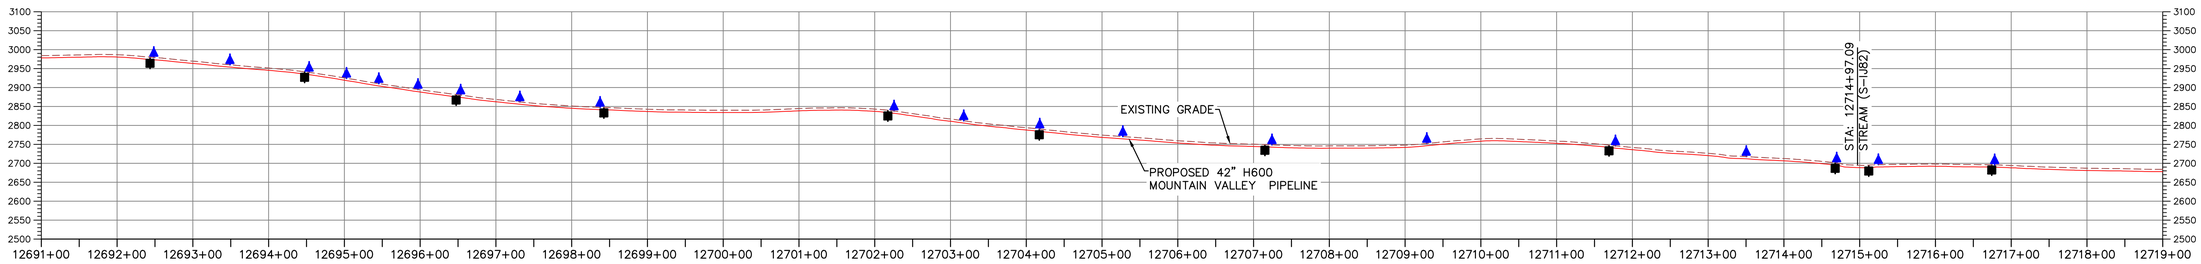

PROFILE
HORIZONTAL SCALE: SCALE: 1" = 100'
100 0 100 200
VERTICAL SCALE: SCALE: 1" = 200'
200 0 200 400

LEGEND

- PROPOSED LIMIT OF DISTURBANCE
- STREAM
- USDA FOREST SERVICE (NATIONAL FOREST) LANDS
- APPALACHIAN NATIONAL SCENIC TRAIL
- EXISTING ROAD/TRAIL
- EXISTING PROPERTY LINE
- EXISTING STATE LINE
- EXISTING COUNTY LINE
- POND
- WETLAND
- ACID FORMING MATERIAL
- EXISTING FOREST
- PROPOSED ACCESS ROAD CENTERLINE
- PROPOSED PIPELINE
- PROPOSED SILT FENCE (SEE NOTE 5)
- PROPOSED SUPER SILT FENCE (SEE DETAIL MVP-ES9.2)
- PROPOSED REINFORCED FILTRATION DEVICE (SEE DETAILS MVP-ES9, 9.1, 9.2, 9.3)
- ORANGE CONSTRUCTION SAFETY FENCE
- PROPOSED COMPOST FILTER SOCK (SEE DETAILS MVP-ES3, 3.1, 3.2)
- PROPOSED COMPOST FILTER SOCK (SEE DETAILS MVP-ES3, 3.1, 3.2)
- PROPOSED COMPOST FILTER SOCK (SEE DETAILS MVP-ES3, 3.1, 3.2)
- GRASS-LINED CHANNEL (SEE DETAIL MVP-ES39)
- CLEAN WATER DIVERSION PIPE
- CLEAN WATER DIVERSION DIKE (SEE DETAIL MVP-ES50 AND MVP-ES51)
- STREAM FLOW DIRECTION
- FEMA 100 YEAR FLOODPLAIN
- DRAINAGE AREA BOUNDARY
- TIMBER MAT (SEE DETAIL MVP-ES37)
- STEEP SLOPE EROSION CONTROL (SEE NOTE 2)
- STEEP SLOPE AREAS (SEE NOTE 4)
- PROPOSED ROCK CONSTRUCTION ENTRANCE
- PROPOSED TRENCH BREAKER (SEE DETAIL MVP-20)
- TEMPORARY ROW DIVERSION/WATER BAR (SEE DETAIL MP-17)
- PERMANENT SLOPE BREAKER/ROW DIVERSION/WATER BAR (SEE DETAIL MVP-17)

COMMONWEALTH OF VIRGINIA
6/16/23
DANIEL C. WITT
Lic. No. 65093
PROFESSIONAL ENGINEER
THIS SEAL APPLIES ONLY TO REVISIONS DATED 06-16-2023

NOTES:

1. TOPSOIL SEGREGATION WILL BE PERFORMED IN ALL IMMEDIATE CONSTRUCTION AREAS OF THE PROJECT IN ACCORDANCE WITH DETAILS MVP-ES46.1 THROUGH MVP-ES46.3.
2. FLEXTERRA, EARTHGUARD OR EQUIVALENT MAY BE USED AS A SUBSTITUTE TO EROSION CONTROL BLANKET AS DIRECTED BY MVP.
3. CONTRACTOR IS RESPONSIBLE TO IDENTIFY ALL UTILITIES. THE UTILITY LINES SHOWN ON THE PLAN ARE FOR INFORMATIONAL PURPOSES ONLY AND DO NOT REPRESENT SURVEYED LINE INFORMATION.
4. SLOPES OF 30' OR GREATER EXIST. CONSTRUCTION FOR STEEP SLOPES TO BE PERFORMED USING STEEP SLOPE TECHNIQUES IDENTIFIED IN THE DETAIL SHEETS. ALSO REFER TO THE SITE-SPECIFIC DESIGN OF STABILIZATION MEASURES IN SELECTED HIGH-HAZARD PORTIONS OF THE ROUTE OF THE PROPOSED MOUNTAIN VALLEY PIPELINE PROJECT.
5. WHERE CONSTRUCTION CONDITIONS PRECLUDE THE USE OF DIVERSION DITCHES DUE TO SITE CONDITIONS THE CONTRACTOR WILL INSTALL SILT FENCE AT THE DIRECTION OF MVP.
6. IMPROVEMENTS TO PERMANENT AND TEMPORARY ACCESS ROADS WILL BE PERFORMED PER THE SITE SPECIFIC ACCESS ROAD DETAILS.
7. TEMPORARY ACCESS ROAD CROSSING OF STREAMS AND WETLANDS WILL UTILIZE TIMBERMATS. ANY PERMANENT ROAD CROSSINGS WILL BE CONDUCTED VIA CULVERTS.
8. ALL NON VMRC STREAM CROSSINGS WILL BE PERFORMED AS DESCRIBED IN THE STREAM CROSSING TABLE INCLUDED IN THIS PACKAGE.

TETRA TECH CAD FILE PATH: X:\CADD_Pittsburgh\EQT\7157 – MVP\14 – Roanoke\E&S\E&S VERSION 5.0.0\7157ES14.15(S10).dwg PLOTTED ON: 6/15/2023 11:07 AM PLOTTED BY: Zeigler, Justin PLOT FILE: ENVIRONMENTAL_COLOR.ctb

NO.:	DATE:	DWN.:	CHKD.:	APPD.:	DESCRIPTION:
3	02/05/18	KAL	RE	DW	ADDRESS VADEQ COMMENTS
4	02/27/18	KAL	RE	DW	ADDRESS VADEQ COMMENTS
5	03/04/18	KAL	RE	DW	ADDRESS VADEQ COMMENTS
–	05/12/21	GAR	RE	DW	CROSSING METHOD CHANGE FROM OPEN CUT TO BORE
–	06/07/23	JJZ	TD	DCW	ADDRESS DEQ COMMENTS ON CROSSING CHANGE METHOD
–	06/16/23	JJZ	IHH	DCW	ADDRESS VADEQ COMMENTS ON BORE PITS

REVISIONS:

Mountain Valley PIPELINE

EROSION AND SEDIMENT CONTROL PLANS
MOUNTAIN VALLEY PIPELINE PROJECT – H600 LINE
SPREAD 10 – ROANOKE COUNTY, VIRGINIA


MOUNTAIN VALLEY PIPELINE, LLC
2200 ENERGY DRIVE
CANONSBURG, PA 15311


TETRA TECH
complex world | CLEAR SOLUTIONS™
661 ANDERSEN DRIVE
FOSTER PLAZA 7
PITTSBURGH, PA 15220

EROSION AND SEDIMENT CONTROL PLANS

COMMONWEALTH OF VIRGINIA
DAVID J. WALLNER
Lic. No. 57593
5/12/2021
PROFESSIONAL ENGINEER

DRAWN BY:	JJZ
CHECKED BY:	IHH
APPROVED BY:	DCW
DATE:	06/16/2023
SCALE:	AS SHOWN
REVISION	–
SHT. NO.	14.15ES OF 14.81ES

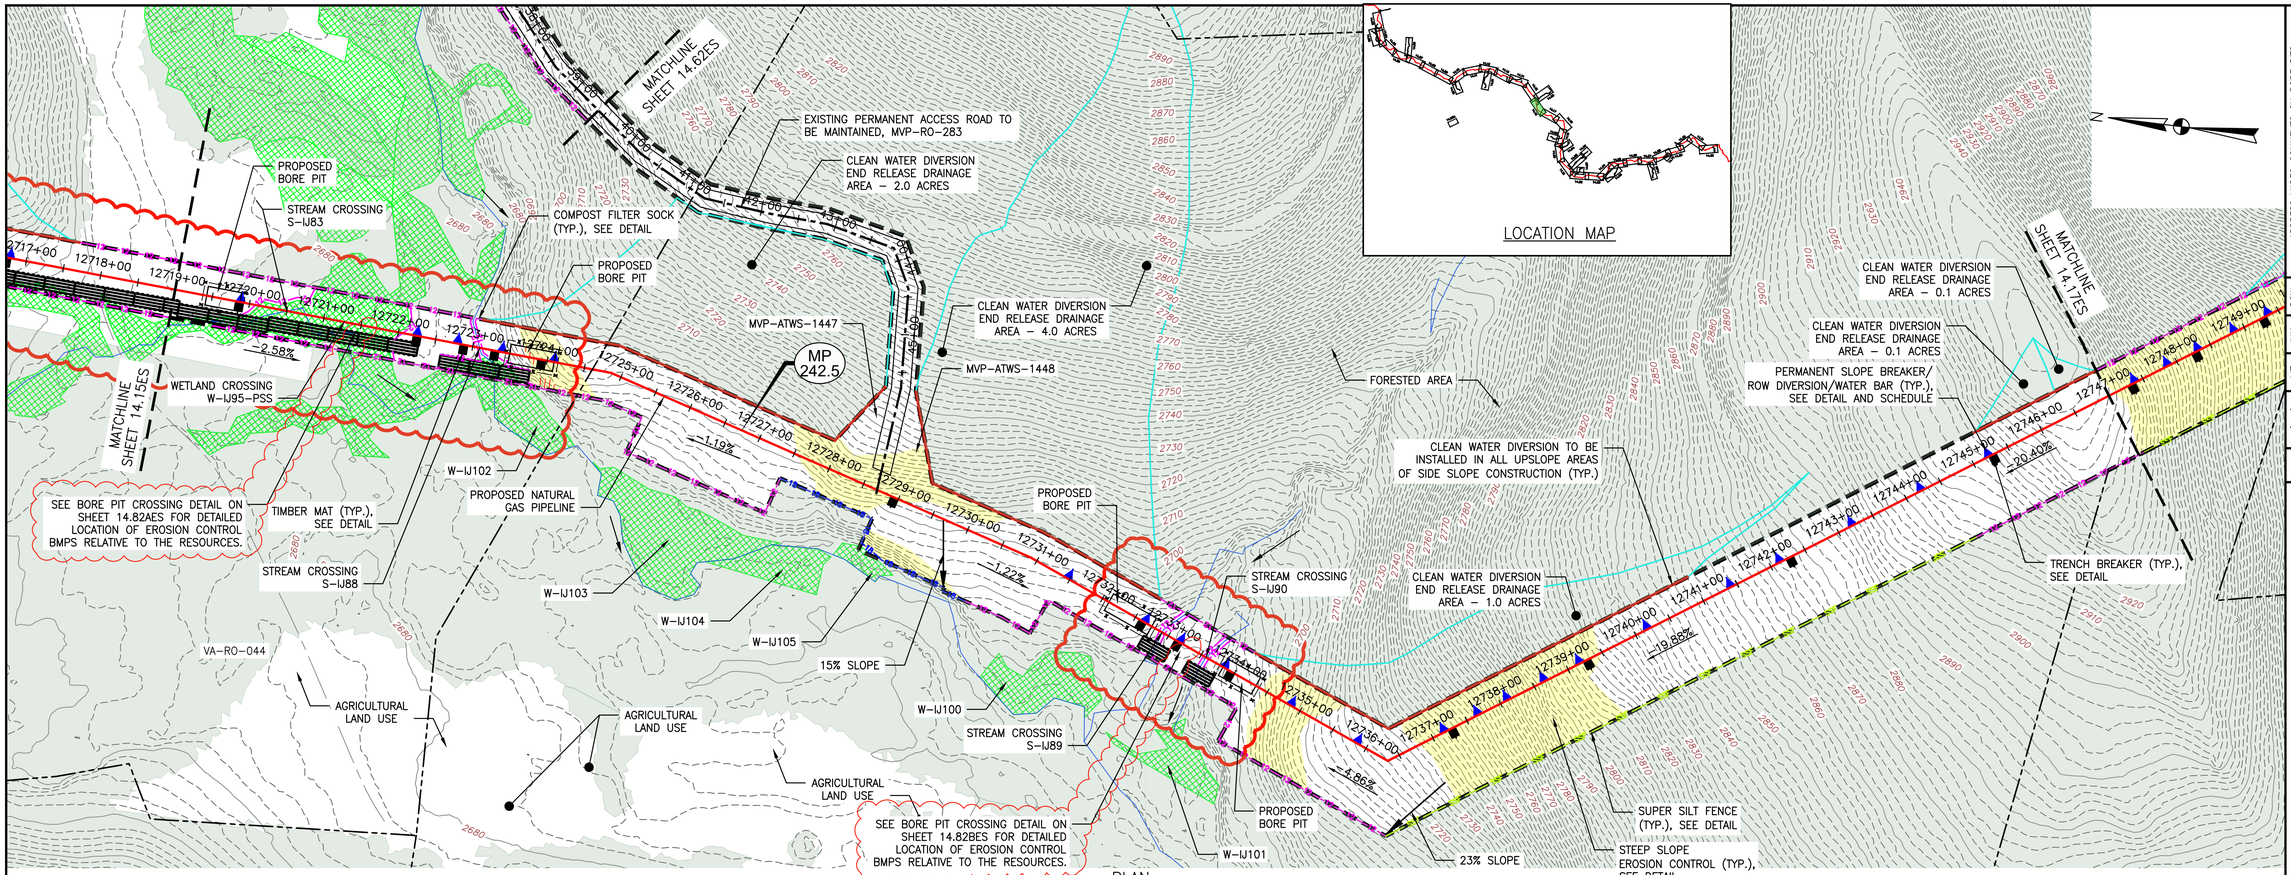

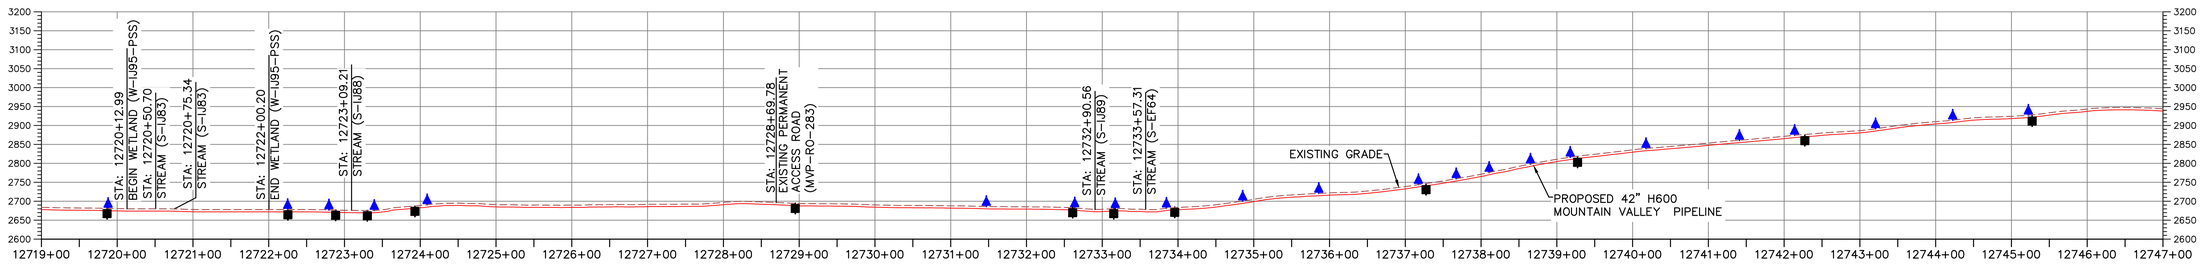

LEGEND

- PROPOSED LIMIT OF DISTURBANCE
- STREAM
- USDA FOREST SERVICE (NATIONAL FOREST) LANDS
- APPALACHIAN NATIONAL SCENIC TRAIL
- EXISTING ROAD/TRAIL
- EXISTING PROPERTY LINE
- EXISTING STATE LINE
- EXISTING COUNTY LINE
- POND
- WETLAND
- ACID FORMING MATERIAL
- EXISTING FOREST
- PROPOSED ACCESS ROAD CENTERLINE
- PROPOSED PIPELINE
- PROPOSED SILT FENCE (SEE NOTE 5)
- PROPOSED SUPER SILT FENCE (SEE DETAIL MVP-ES9.2)
- PROPOSED REINFORCED FILTRATION DEVICE (SEE DETAILS MVP-ES9, 9.1, 9.2, 9.3)
- ORANGE CONSTRUCTION SAFETY FENCE
- PROPOSED COMPOST FILTER SOCK (SEE DETAILS MVP-ES3, 3.1, 3.2)
- PROPOSED COMPOST FILTER SOCK (SEE DETAILS MVP-ES3, 3.1, 3.2)
- PROPOSED COMPOST FILTER SOCK (SEE DETAILS MVP-ES3, 3.1, 3.2)
- GRASS-LINED CHANNEL (SEE DETAIL MVP-ES39)
- CLEAN WATER DIVERSION PIPE
- CLEAN WATER DIVERSION DIKE (SEE DETAIL MVP-ES50 AND MVP-ES51)
- STREAM FLOW DIRECTION
- FEMA 100 YEAR FLOODPLAIN
- DRAINAGE AREA BOUNDARY
- TIMBER MAT (SEE DETAIL MVP-ES37)
- STEEP SLOPE EROSION CONTROL (SEE NOTE 2)
- STEEP SLOPE AREAS (SEE NOTE 4)
- PROPOSED ROCK CONSTRUCTION ENTRANCE
- PROPOSED TRENCH BREAKER (SEE DETAIL MVP-20)
- TEMPORARY ROW DIVERSION/WATER BAR (SEE DETAIL MP-17)
- PERMANENT SLOPE BREAKER/ROW DIVERSION/WATER BAR (SEE DETAIL MVP-17)

COMMONWEALTH OF VIRGINIA
DANIEL C. WITT
Lic. No. 65093
PROFESSIONAL ENGINEER
8/1/23

THIS SEAL APPLIES ONLY TO REVISIONS DATED 08-01-2023

NOTES:

1. TOPSOIL SEGREGATION WILL BE PERFORMED IN ALL IMMEDIATE CONSTRUCTION AREAS OF THE PROJECT IN ACCORDANCE WITH DETAILS MVP-ES46.1 THROUGH MVP-ES46.3.
2. FLEXTERRA, EARTHGUARD OR EQUIVALENT MAY BE USED AS A SUBSTITUTE TO EROSION CONTROL BLANKET AS DIRECTED BY MVP.
3. CONTRACTOR IS RESPONSIBLE TO IDENTIFY ALL UTILITIES. THE UTILITY LINES SHOWN ON THE PLAN ARE FOR INFORMATIONAL PURPOSES ONLY AND DO NOT REPRESENT SURVEYED LINE INFORMATION.
4. SLOPES OF 30' OR GREATER EXIST. CONSTRUCTION FOR STEEP SLOPES TO BE PERFORMED USING STEEP SLOPE TECHNIQUES IDENTIFIED IN THE DETAIL SHEETS. ALSO REFER TO THE SITE-SPECIFIC DESIGN OF STABILIZATION MEASURES IN SELECTED HIGH-HAZARD PORTIONS OF THE ROUTE OF THE PROPOSED MOUNTAIN VALLEY PIPLELINE PROJECT.
5. WHERE CONSTRUCTION CONDITIONS PRECLUDE THE USE OF DIVERSION DITCHES DUE TO SITE CONDITIONS THE CONTRACTOR WILL INSTALL SILT FENCE AT THE DIRECTION OF MVP.
6. IMPROVEMENTS TO PERMANENT AND TEMPORARY ACCESS ROADS WILL BE PERFORMED PER THE SITE SPECIFIC ACCESS ROAD DETAILS.
7. TEMPORARY ACCESS ROAD CROSSING OF STREAMS AND WETLANDS WILL UTILIZE TIMBERMATS. ANY PERMANENT ROAD CROSSINGS WILL BE CONDUCTED VIA CULVERTS.
8. ALL NON VMRC STREAM CROSSINGS WILL BE PERFORMED AS DESCRIBED IN THE STREAM CROSSING TABLE INCLUDED IN THIS PACKAGE.

NO.:	DATE:	DWN.:	CHKD.:	APPD.:	DESCRIPTION:
–	08/01/23	JJZ	IHH	DCW	ADDRESS VADEQ COMMENTS ON BORE PITS
–	06/16/23	JJZ	IHH	DCW	ADDRESS VADEQ COMMENTS ON BORE PITS
–	04/07/23	JJZ	TD	DCW	ADDRESS DEQ COMMENTS ON CROSSING CHANGE METHOD
–	05/12/21	GAR	RE	DW	CROSSING METHOD CHANGE FROM OPEN CUT TO BORE
5	03/04/18	KAL	RE	DW	ADDRESS VADEQ COMMENTS
4	02/27/18	KAL	RE	DW	ADDRESS VADEQ COMMENTS

REVISIONS:

Mountain Valley PIPELINE

EROSION AND SEDIMENT CONTROL PLANS

MOUNTAIN VALLEY PIPELINE PROJECT – H600 LINE

SPREAD 10 – ROANOKE COUNTY, VIRGINIA

MOUNTAIN VALLEY PIPELINE, LLC
2200 ENERGY DRIVE
CANONSBURG, PA 15311

TETRA TECH
complex world | CLEAR SOLUTIONS™
661 ANDERSEN DRIVE
FOSTER PLAZA 7
PITTSBURGH, PA 15220

EROSION AND SEDIMENT CONTROL PLANS


COMMONWEALTH OF VIRGINIA
DAVID J. WALLNER
Lic. No. 57593
PROFESSIONAL ENGINEER
5/12/2021

DRAWN BY:	JJZ
CHECKED BY:	IHH
APPROVED BY:	DCW
DATE:	08/01/2023
SCALE:	AS SHOWN
REVISION	–

SHT. NO. 14.16ES OF 14.81ES

TETRA TECH CAD FILE PATH: X:\CADD_Pittsburgh\EQT\7157 – MVP\14 – Roanoke\E&S\E&S VERSION 5.0.0\7157ES14.16(S10).dwg PLOTTED ON: 8/2/2023 8:19 AM PLOTTED BY: Zeigler, Justin PLOT FILE: ENVIRONMENTAL_COLOR.ctb


LOCATION MAP

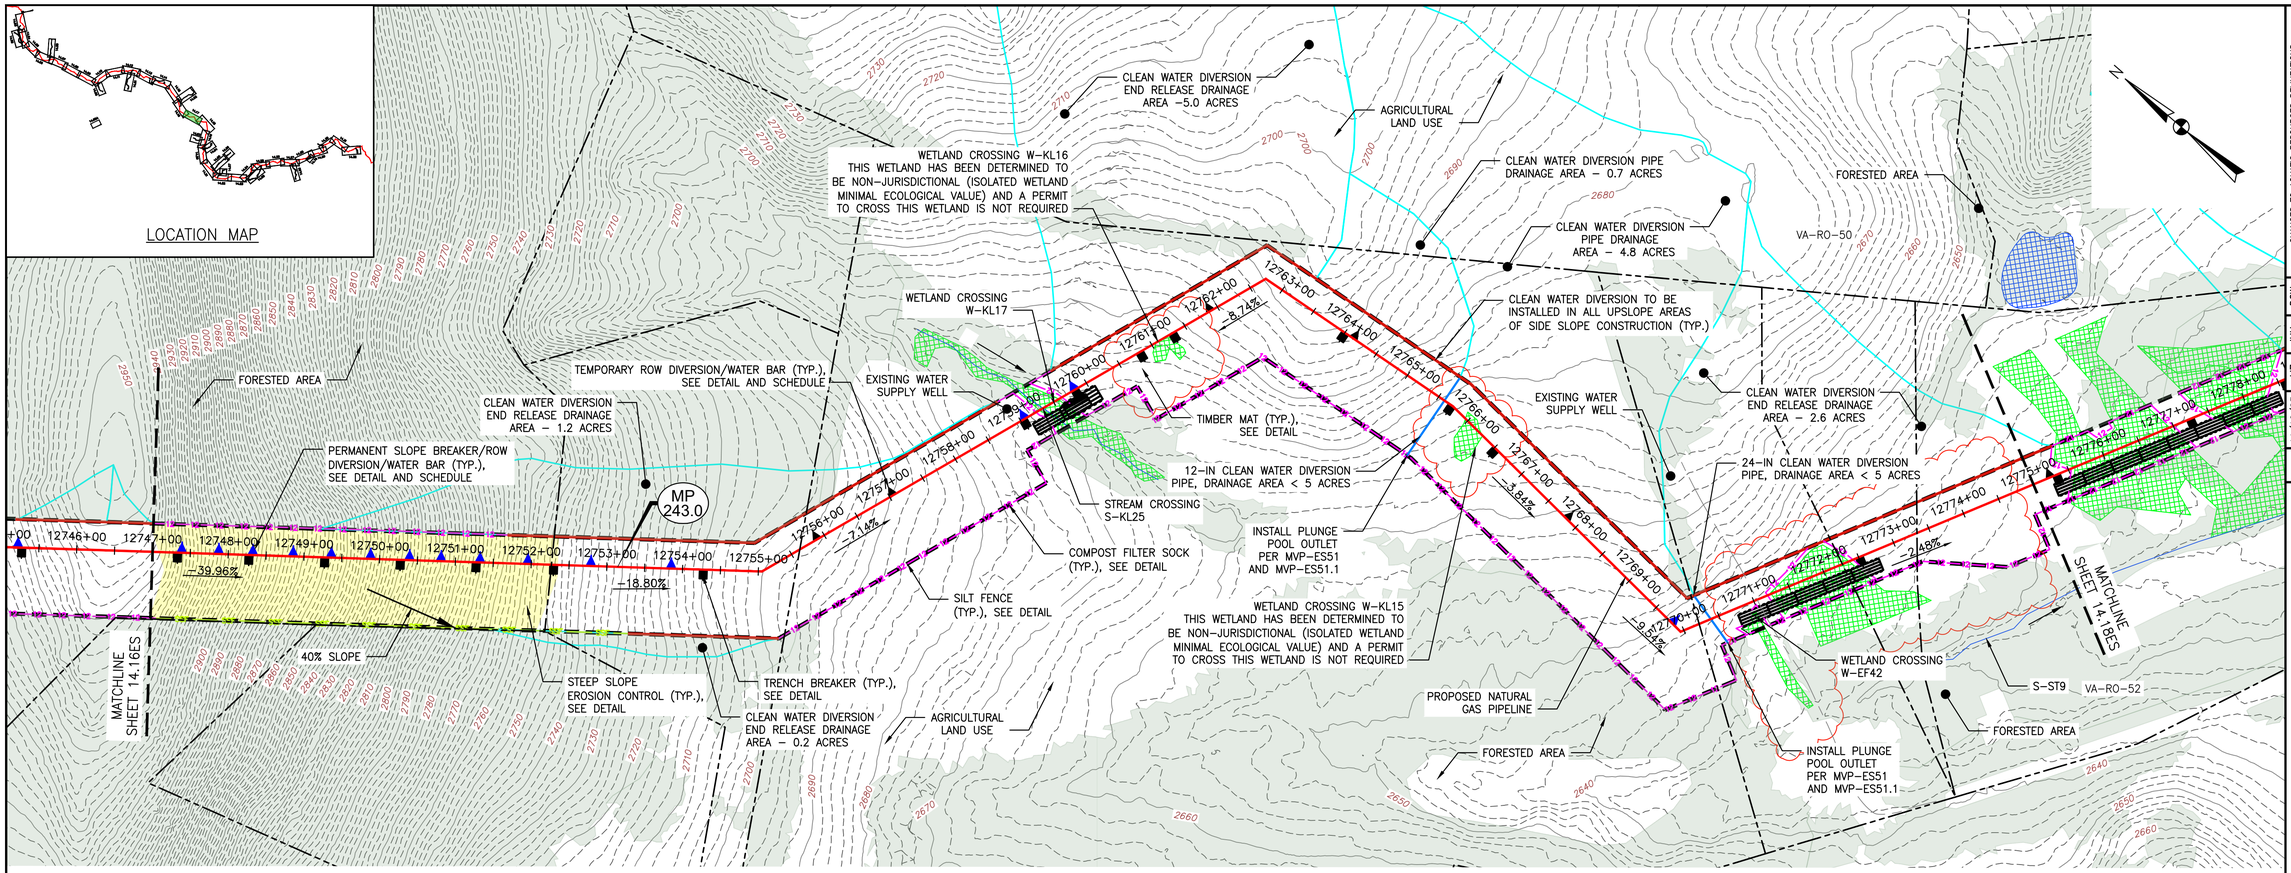

PLAN

SCALE: 1" = 100'

100 0 100 200

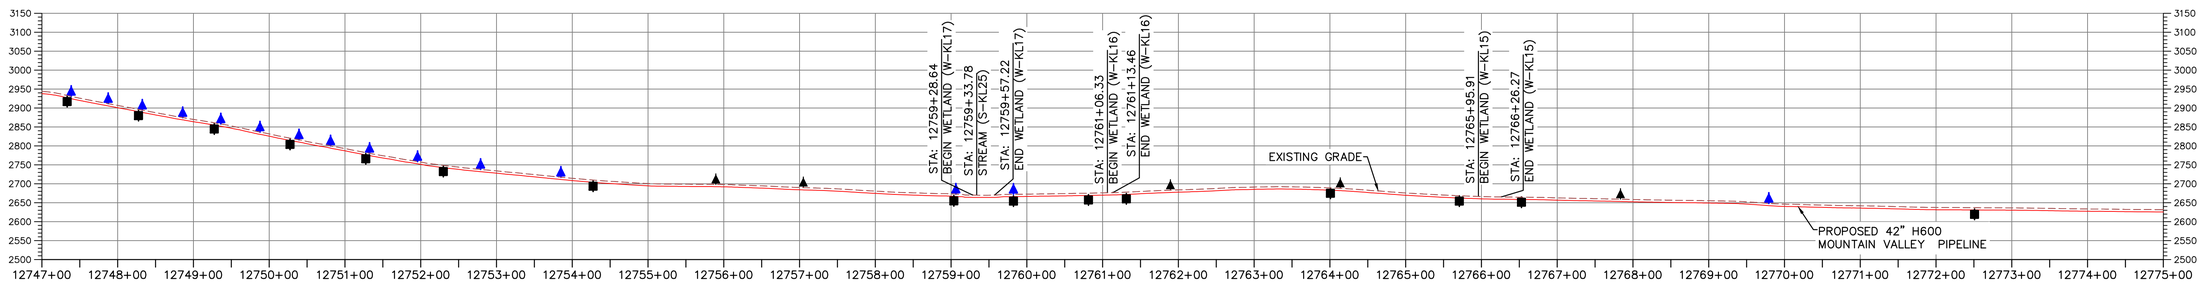

PROFILE

HORIZONTAL SCALE: SCALE: 1" = 100'

100 0 100 200

VERTICAL SCALE: SCALE: 1" = 200'

200 0 200 400

LEGEND

- PROPOSED LIMIT OF DISTURBANCE
- STREAM
- USDA FOREST SERVICE (NATIONAL FOREST) LANDS
- APPALACHIAN NATIONAL SCENIC TRAIL
- EXISTING ROAD/TRAIL
- EXISTING PROPERTY LINE
- EXISTING STATE LINE
- EXISTING COUNTY LINE
- POND
- WETLAND
- ACID FORMING MATERIAL
- EXISTING FOREST
- PROPOSED ACCESS ROAD CENTERLINE
- PROPOSED PIPELINE
- PROPOSED SILT FENCE (SEE NOTE 5)
- PROPOSED SUPER SILT FENCE (SEE DETAIL MVP–ES9.2)
- PROPOSED REINFORCED FILTRATION DEVICE (SEE DETAILS MVP–ES9, 9.1, 9.2, 9.3)
- ORANGE CONSTRUCTION SAFETY FENCE
- PROPOSED COMPOST FILTER SOCK (SEE DETAILS MVP–ES3, 3.1, 3.2)
- PROPOSED COMPOST FILTER SOCK (SEE DETAILS MVP–ES3, 3.1, 3.2)
- PROPOSED COMPOST FILTER SOCK (SEE DETAILS MVP–ES3, 3.1, 3.2)
- GRASS–LINED CHANNEL (SEE DETAIL MVP–ES39)
- CLEAN WATER DIVERSION PIPE
- CLEAN WATER DIVERSION DIKE (SEE DETAIL MVP–ES50 AND MVP–ES51)
- STREAM FLOW DIRECTION
- FEMA 100 YEAR FLOODPLAIN
- DRAINAGE AREA BOUNDARY
- TIMBER MAT (SEE DETAIL MVP–ES37)
- STEEP SLOPE EROSION CONTROL (SEE NOTE 2)
- STEEP SLOPE AREAS (SEE NOTE 4)
- PROPOSED ROCK CONSTRUCTION ENTRANCE
- PROPOSED TRENCH BREAKER (SEE DETAIL MVP–20)
- TEMPORARY ROW DIVERSION/WATER BAR (SEE DETAIL MP–17)
- PERMANENT SLOPE BREAKER/ROW DIVERSION/WATER BAR (SEE DETAIL MVP–17)

COMMONWEALTH OF VIRGINIA
11/10/23
DANIEL C. WITT
Lic. No. 65093
PROFESSIONAL ENGINEER

THIS SEAL ONLY APPLIES TO REVISIONS DATED 11–10–23

NOTES:

1. TOPSOIL SEGREGATION WILL BE PERFORMED IN ALL IMMEDIATE CONSTRUCTION AREAS OF THE PROJECT IN ACCORDANCE WITH DETAILS MVP–ES46.1 THROUGH MVP–ES46.3.
2. FLEXTERRA, EARTHGUARD OR EQUIVALENT MAY BE USED AS A SUBSTITUTE TO EROSION CONTROL BLANKET AS DIRECTED BY MVP.
3. CONTRACTOR IS RESPONSIBLE TO IDENTIFY ALL UTILITIES. THE UTILITY LINES SHOWN ON THE PLAN ARE FOR INFORMATIONAL PURPOSES ONLY AND DO NOT REPRESENT SURVEYED LINE INFORMATION.
4. SLOPES OF 30" OR GREATER EXIST. CONSTRUCTION FOR STEEP SLOPES TO BE PERFORMED USING STEEP SLOPE TECHNIQUES IDENTIFIED IN THE DETAIL SHEETS. ALSO REFER TO THE SITE–SPECIFIC DESIGN OF STABILIZATION MEASURES IN SELECTED HIGH–HAZARD PORTIONS OF THE ROUTE OF THE PROPOSED MOUNTAIN VALLEY PIPELINE PROJECT.
5. WHERE CONSTRUCTION CONDITIONS PRECLUDE THE USE OF DIVERSION DITCHES DUE TO SITE CONDITIONS THE CONTRACTOR WILL INSTALL SILT FENCE AT THE DIRECTION OF MVP.
6. IMPROVEMENTS TO PERMANENT AND TEMPORARY ACCESS ROADS WILL BE PERFORMED PER THE SITE SPECIFIC ACCESS ROAD DETAILS.
7. TEMPORARY ACCESS ROAD CROSSING OF STREAMS AND WETLANDS WILL UTILIZE TIMBERMATS. ANY PERMANENT ROAD CROSSINGS WILL BE CONDUCTED VIA CULVERTS.
8. ALL NON VMRC STREAM CROSSINGS WILL BE PERFORMED AS DESCRIBED IN THE STREAM CROSSING TABLE INCLUDED IN THIS PACKAGE.

TETRA TECH CAD FILE PATH: X:\CADD_Pittsburgh\EQT\7157 – MVP\14 – Roanoke\E&S\E&S VERSION 5.0.0\7157ES14.17(S10).dwg PLOTTED ON: 11/10/2023 11:37 AM PLOTTED BY: Zeigler, Justin PLOT FILE: ENVIRONMENTAL_COLOR.ctb

REVISIONS:

NO.:	DATE:	DWN.:	CHKD.:	APPD.:	DESCRIPTION:
–	11/10/23	JJZ	IHH	DCW	CHANGES TO AQUATIC RESOURCES DELINEATIONS
5	03/04/18	KAL	RE	DW	ADDRESS VADEQ COMMENTS
4	02/27/18	JJZ	RE	DW	ADDRESS VADEQ COMMENTS
3	02/05/18	KAL	RE	DW	ADDRESS VADEQ COMMENTS
2	11/21/17	KAL	RE	DW	ADDRESS VADEQ COMMENTS
1	09/21/17	KAL	RE	DW	ADDRESS VADEQ COMMENTS

Mountain Valley PIPELINE

EROSION AND SEDIMENT CONTROL PLANS

MOUNTAIN VALLEY PIPELINE PROJECT – H600 LINE

SPREAD 10 – ROANOKE COUNTY, VIRGINIA

MOUNTAIN VALLEY PIPELINE, LLC
2200 ENERGY DRIVE
CANONSBURG, PA 15311


TETRA TECH
complex world | CLEAR SOLUTIONS™
661 ANDERSEN DRIVE
FOSTER PLAZA 7
PITTSBURGH, PA 15220

EROSION AND SEDIMENT CONTROL PLANS

COMMONWEALTH OF VIRGINIA
DAVID J. WALLNER
Lic. No. 0402057593
PROFESSIONAL ENGINEER

DRAWN BY:	JZ
CHECKED BY:	IHH
APPROVED BY:	DCW
DATE:	11/10/2023
SCALE:	AS SHOWN


SHT. NO. 14.17ES OF 14.81ES

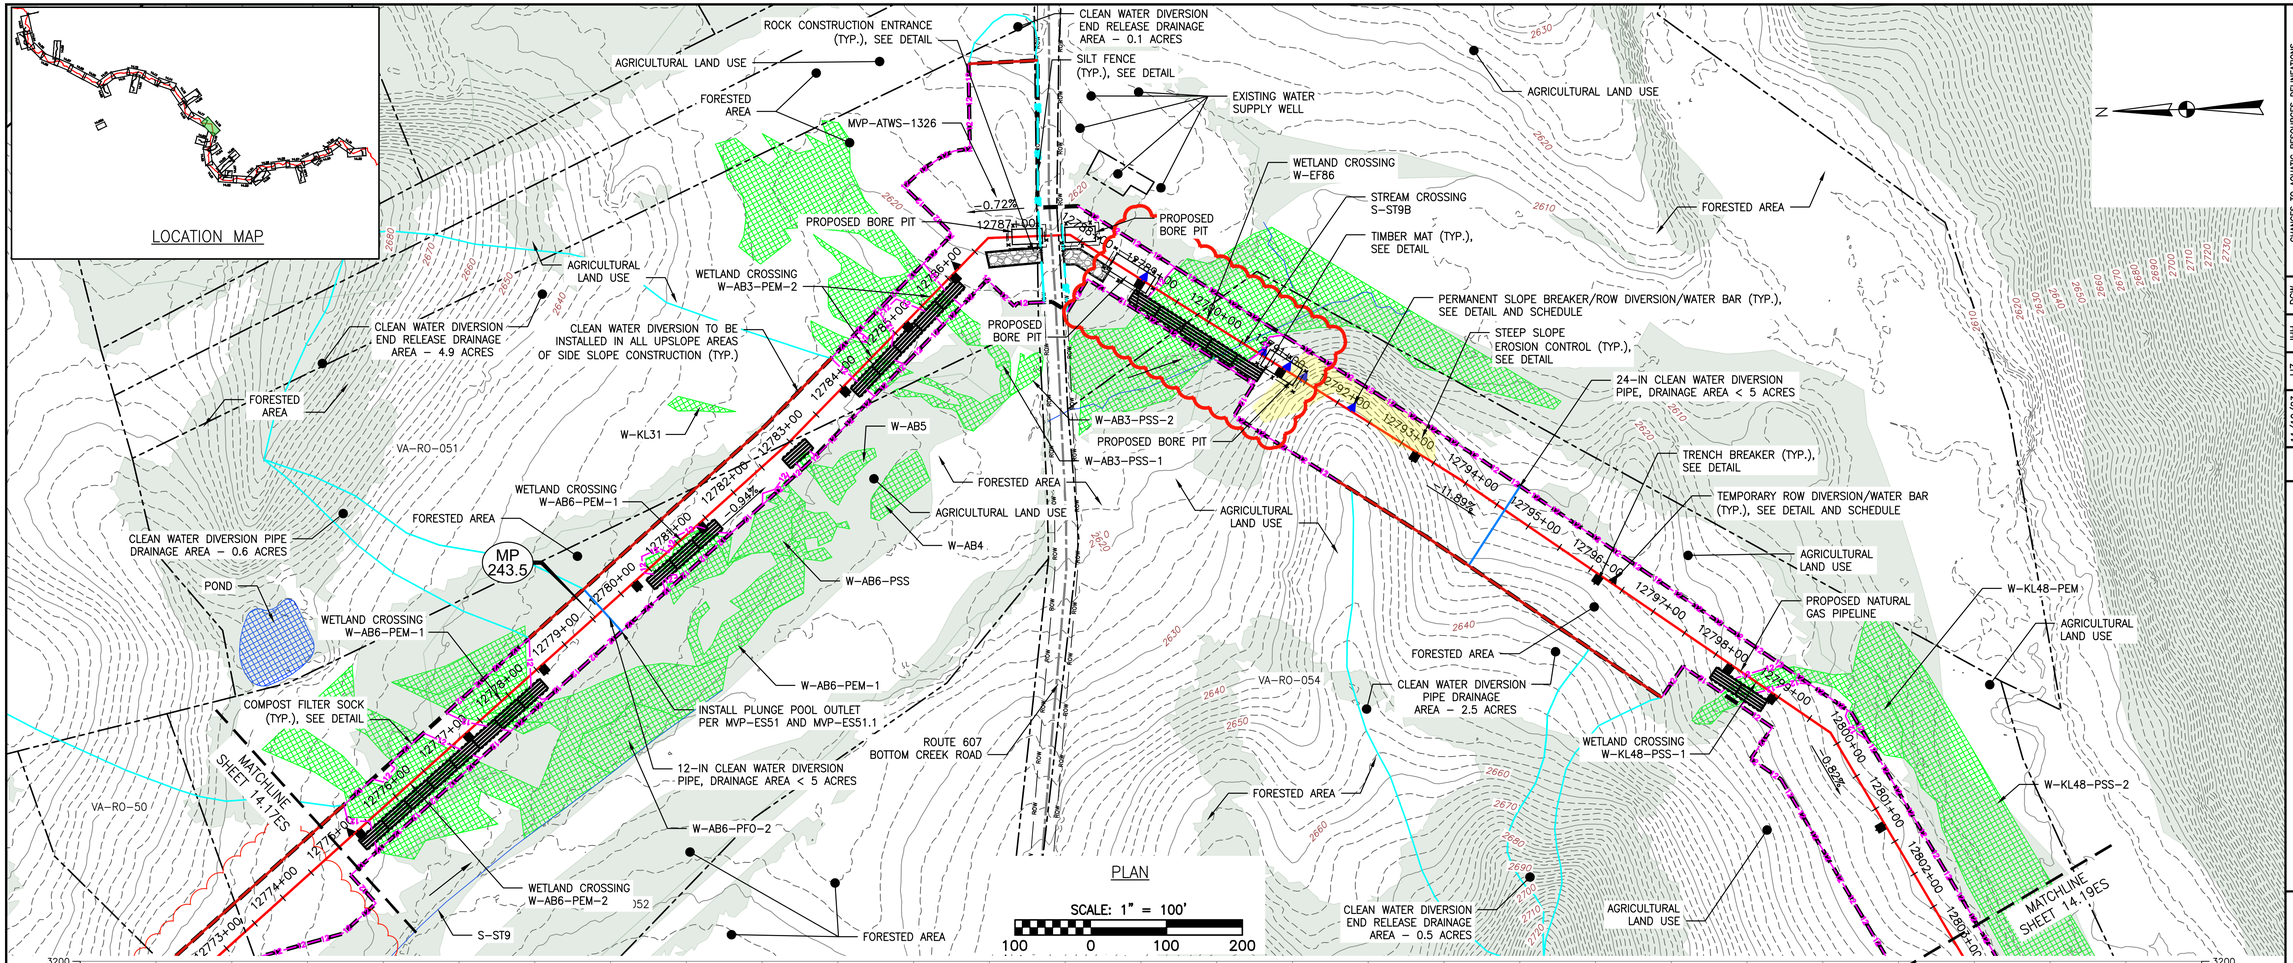

PLAN

SCALE: 1" = 100'

100 0 100 200

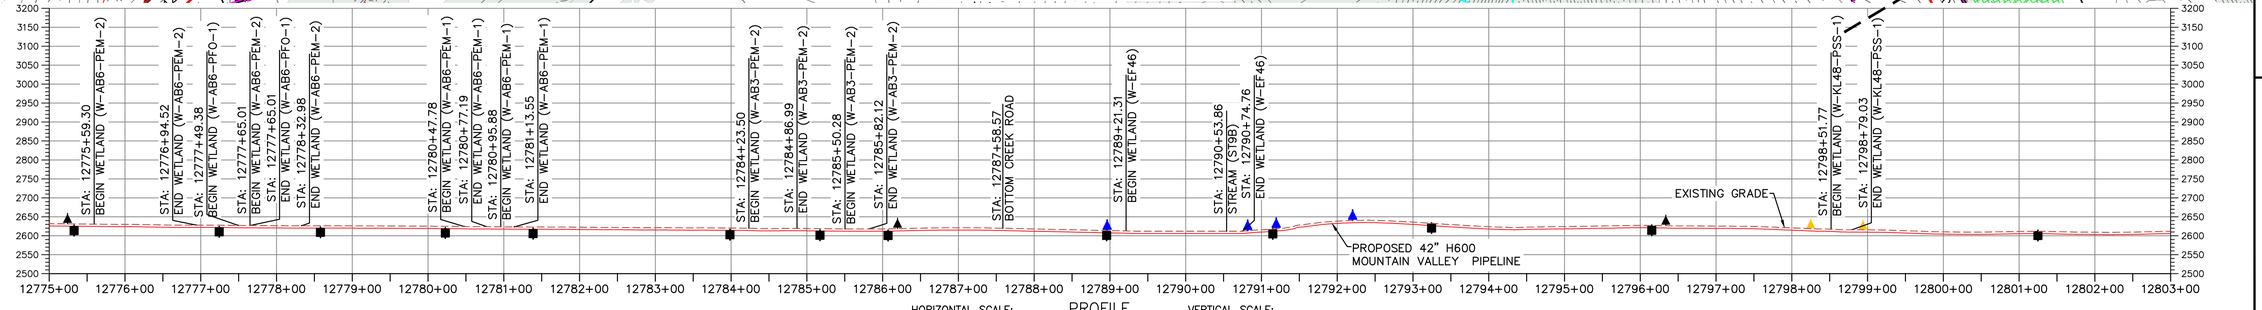

HORIZONTAL SCALE: SCALE: 1" = 100'

100 0 100 200

PROFILE

VERTICAL SCALE: SCALE: 1" = 200'

200 0 200 400

LEGEND

- PROPOSED LIMIT OF DISTURBANCE
- STREAM
- USDA FOREST SERVICE (NATIONAL FOREST) LANDS
- ANST — ANST — APPALACHIAN NATIONAL SCENIC TRAIL
- EXISTING ROAD/TRAIL
- EXISTING PROPERTY LINE
- EXISTING STATE LINE
- EXISTING COUNTY LINE
- POND
- WETLAND
- AFM — AFM — ACID FORMING MATERIAL
- EXISTING FOREST
- PROPOSED ACCESS ROAD CENTERLINE
- PROPOSED PIPELINE
- SF — SF — PROPOSED SILT FENCE (SEE NOTE 5)
- SSF — SSF — PROPOSED SUPER SILT FENCE (SEE DETAIL MVP-ES9.2)
- RFD — RFD — PROPOSED REINFORCED FILTRATION DEVICE (SEE DETAILS MVP-ES9, 9.1, 9.2, 9.3)
- OCSF — ORANGE CONSTRUCTION SAFETY FENCE
- 12 — 12 — 12 — 12 — PROPOSED COMPOST FILTER SOCK (SEE DETAILS MVP-ES3, 3.1, 3.2)
- 18 — 18 — 18 — 18 — PROPOSED COMPOST FILTER SOCK (SEE DETAILS MVP-ES3, 3.1, 3.2)
- 24 — 24 — 24 — 24 — PROPOSED COMPOST FILTER SOCK (SEE DETAILS MVP-ES3, 3.1, 3.2)
- GRASS-LINED CHANNEL (SEE DETAIL MVP-ES39)
- CLEAN WATER DIVERSION PIPE
- CLEAN WATER DIVERSION DIKE (SEE DETAIL MVP-ES50 AND MVP-ES51)
- STREAM FLOW DIRECTION
- FEMA 100 YEAR FLOODPLAIN
- DRAINAGE AREA BOUNDARY
- TIMBER MAT (SEE DETAIL MVP-ES37)
- STEEP SLOPE EROSION CONTROL (SEE NOTE 2)
- STEEP SLOPE AREAS (SEE NOTE 4)
- PROPOSED ROCK CONSTRUCTION ENTRANCE
- PROPOSED TRENCH BREAKER (SEE DETAIL MVP-20)
- TEMPORARY ROW DIVERSION/WATER BAR (SEE DETAIL MP-17)
- PERMANENT SLOPE BREAKER/ROW DIVERSION/WATER BAR (SEE DETAIL MVP-17)

COMMONWEALTH OF VIRGINIA
11/10/23
DANIEL C. WITT
Lic. No. 65093
PROFESSIONAL ENGINEER

THIS SEAL ONLY APPLIES TO REVISIONS DATED 11-10-23

NOTES:

1. TOPSOIL SEGREGATION WILL BE PERFORMED IN ALL IMMEDIATE CONSTRUCTION AREAS OF THE PROJECT IN ACCORDANCE WITH DETAILS MVP-ES46.1 THROUGH MVP-ES46.3.
2. FLEXTERRA, EARTHGUARD OR EQUIVALENT MAY BE USED AS A SUBSTITUTE TO EROSION CONTROL BLANKET AS DIRECTED BY MVP.
3. CONTRACTOR IS RESPONSIBLE TO IDENTIFY ALL UTILITIES. THE UTILITY LINES SHOWN ON THE PLAN ARE FOR INFORMATIONAL PURPOSES ONLY AND DO NOT REPRESENT SURVEYED LINE INFORMATION.
4. SLOPES OF 30° OR GREATER EXIST. CONSTRUCTION FOR STEEP SLOPES TO BE PERFORMED USING STEEP SLOPE TECHNIQUES IDENTIFIED IN THE DETAIL SHEETS. ALSO REFER TO THE SITE-SPECIFIC DESIGN OF STABILIZATION MEASURES IN SELECTED HIGH-HAZARD PORTIONS OF THE ROUTE OF THE PROPOSED MOUNTAIN VALLEY PIPELINE PROJECT.
5. WHERE CONSTRUCTION CONDITIONS PRECLUDE THE USE OF DIVERSION DITCHES DUE TO SITE CONDITIONS THE CONTRACTOR WILL INSTALL SILT FENCE AT THE DIRECTION OF MVP.
6. IMPROVEMENTS TO PERMANENT AND TEMPORARY ACCESS ROADS WILL BE PERFORMED PER THE SITE SPECIFIC ACCESS ROAD DETAILS.
7. TEMPORARY ACCESS ROAD CROSSING OF STREAMS AND WETLANDS WILL UTILIZE TIMBERMATS. ANY PERMANENT ROAD CROSSINGS WILL BE CONDUCTED VIA CULVERTS.
8. ALL NON VMRC STREAM CROSSINGS WILL BE PERFORMED AS DESCRIBED IN THE STREAM CROSSING TABLE INCLUDED IN THIS PACKAGE.

TETRA TECH CAD FILE PATH: X:\CADD_Pittsburgh\EQT\7157 – MVP\14 – Roanoke\E&S\E&S VERSION 5.0.0\7157ES14.18(S10).dwg PLOTTED ON: 11/10/2023 1:50 PM PLOTTED BY: Zeigler, Justin PLOT FILE: ENVIRONMENTAL_COLOR.ctb

NO.:	DATE:	DWN.:	CHKD.:	APPD.:	DESCRIPTION:
–	11/10/23	JJZ	IHH	DCW	CHANGES TO AQUATIC RESOURCES DELINEATIONS
5	03/21/18	KAL	RE	DW	ADDRESS VADEQ COMMENTS
4	03/04/18	KAL	RE	DW	ADDRESS VADEQ COMMENTS
3	02/22/18	KAL	RE	DW	RESUBMISSION USING APPROVED STORMWATER METHODOLOGY
2	11/21/17	KAL	RE	DW	ADDRESS VADEQ COMMENTS
1	09/21/17	KAL	RE	DW	PLAN SUBMISSION

REVISIONS:

Mountain Valley PIPELINE

EROSION AND SEDIMENT CONTROL PLANS

MOUNTAIN VALLEY PIPELINE PROJECT – H600 LINE

SPREAD 10 – ROANOKE COUNTY, VIRGINIA

MOUNTAIN VALLEY PIPELINE, LLC
2200 ENERGY DRIVE
CANONSBURG, PA 15311


TETRA TECH
complex world | CLEAR SOLUTIONS™
661 ANDERSEN DRIVE
FOSTER PLAZA 7
PITTSBURGH, PA 15220


EROSION AND SEDIMENT CONTROL PLANS

COMMONWEALTH OF VIRGINIA
DAVID J. WALLNER
Lic. No. 57593
PROFESSIONAL ENGINEER
5/12/2021

DRAWN BY:	JJZ
CHECKED BY:	IHH
APPROVED BY:	DCW
DATE:	11/10/2023
SCALE:	AS SHOWN
	– REVISION

SHT. NO. 14.18ES OF 14.81ES

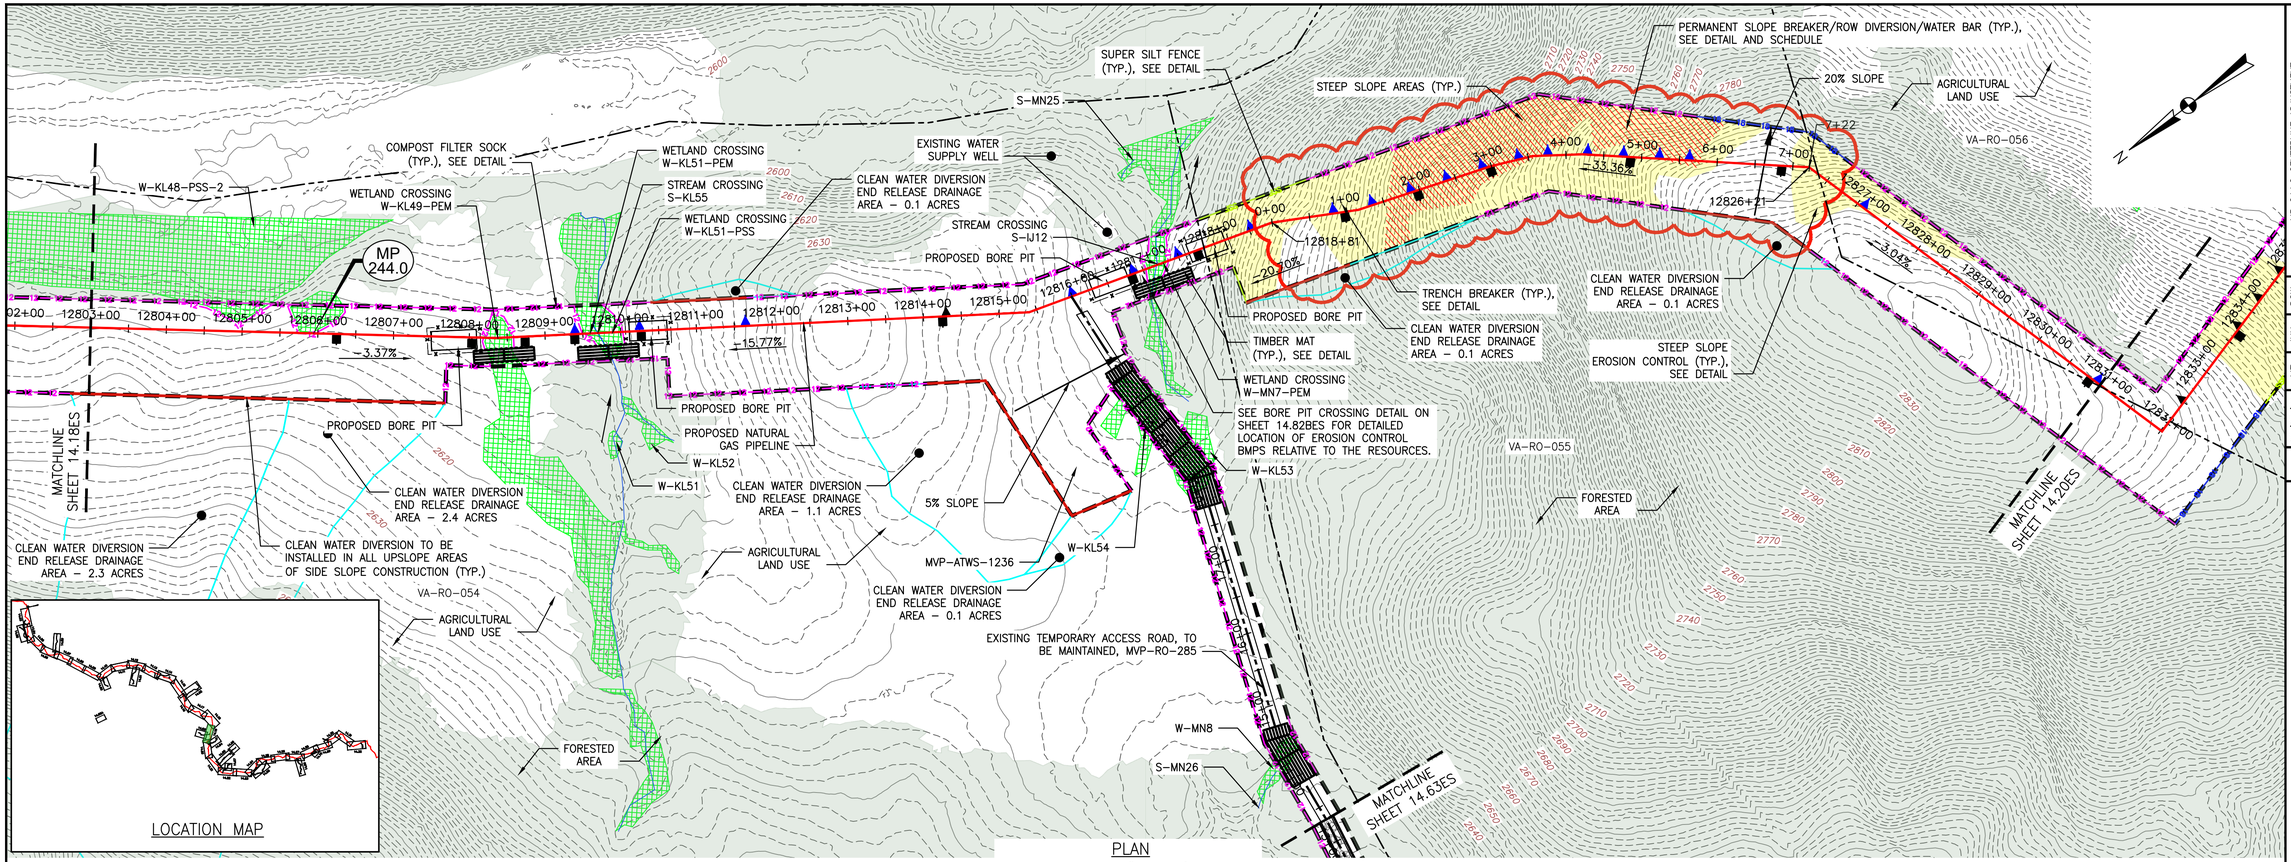

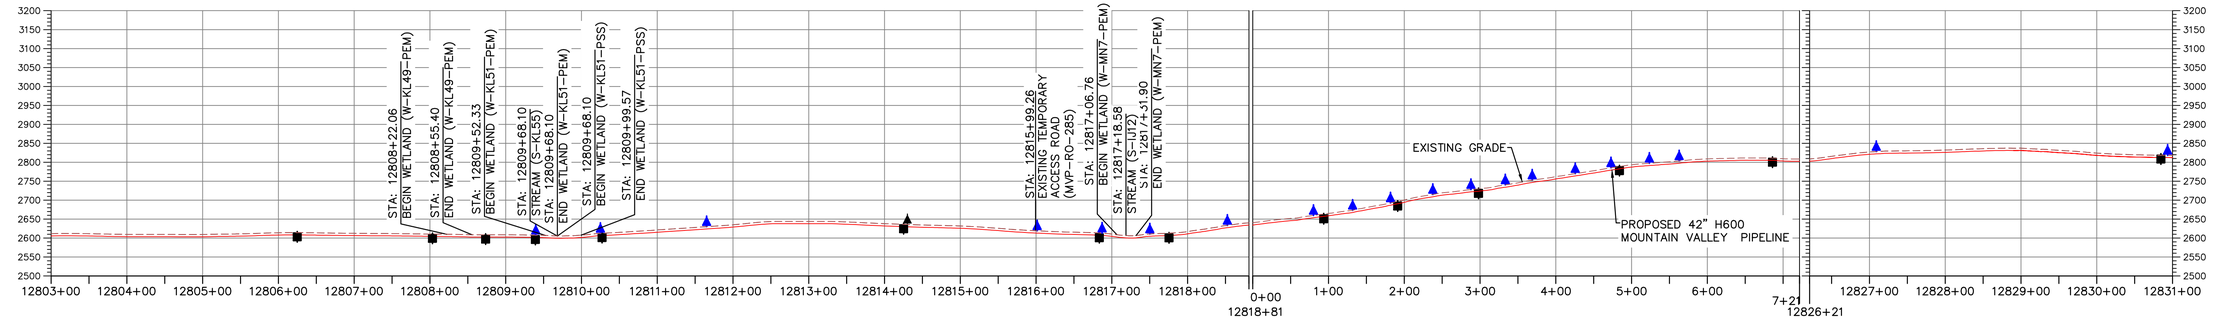

PROFILE

HORIZONTAL SCALE: SCALE: 1" = 100'
100 0 100 200

VERTICAL SCALE: SCALE: 1" = 200'
200 0 200 400

LEGEND

- PROPOSED LIMIT OF DISTURBANCE
- STREAM
- USDA FOREST SERVICE (NATIONAL FOREST) LANDS
- APPALACHIAN NATIONAL SCENIC TRAIL
- EXISTING ROAD/TRAIL
- EXISTING PROPERTY LINE
- EXISTING STATE LINE
- EXISTING COUNTY LINE
- POND
- WETLAND
- ACID FORMING MATERIAL
- EXISTING FOREST
- PROPOSED ACCESS ROAD CENTERLINE
- PROPOSED PIPELINE
- PROPOSED SILT FENCE (SEE NOTE 5)
- PROPOSED SUPER SILT FENCE (SEE DETAIL MVP-ES9.2)
- PROPOSED REINFORCED FILTRATION DEVICE (SEE DETAILS MVP-ES9, 9.1, 9.2, 9.3)
- ORANGE CONSTRUCTION SAFETY FENCE
- PROPOSED COMPOST FILTER SOCK (SEE DETAILS MVP-ES3, 3.1, 3.2)
- PROPOSED COMPOST FILTER SOCK (SEE DETAILS MVP-ES3, 3.1, 3.2)
- PROPOSED COMPOST FILTER SOCK (SEE DETAILS MVP-ES3, 3.1, 3.2)
- GRASS-LINED CHANNEL (SEE DETAIL MVP-ES39)
- CLEAN WATER DIVERSION PIPE
- CLEAN WATER DIVERSION DIKE (SEE DETAIL MVP-ES50 AND MVP-ES51)
- STREAM FLOW DIRECTION
- FEMA 100 YEAR FLOODPLAIN
- DRAINAGE AREA BOUNDARY
- TIMBER MAT (SEE DETAIL MVP-ES37)
- STEEP SLOPE EROSION CONTROL (SEE NOTE 2)
- STEEP SLOPE AREAS (SEE NOTE 4)
- PROPOSED ROCK CONSTRUCTION ENTRANCE
- PROPOSED TRENCH BREAKER (SEE DETAIL MVP-20)
- TEMPORARY ROW DIVERSION/WATER BAR (SEE DETAIL MP-17)
- PERMANENT SLOPE BREAKER/ROW DIVERSION/WATER BAR (SEE DETAIL MVP-17)

COMMONWEALTH OF VIRGINIA
7/7/23
DANIEL C. WITT
Lic. No. 65093
PROFESSIONAL ENGINEER

THIS SEAL APPIIES ONLY TO REVISIONS DATED 06-09-2023

NOTES:

1. TOPSOIL SEGREGATION WILL BE PERFORMED IN ALL IMMEDIATE CONSTRUCTION AREAS OF THE PROJECT IN ACCORDANCE WITH DETAILS MVP-ES46.1 THROUGH MVP-ES46.3.
2. FLEXTERRA, EARTHGUARD OR EQUIVALENT MAY BE USED AS A SUBSTITUTE TO EROSION CONTROL BLANKET AS DIRECTED BY MVP.
3. CONTRACTOR IS RESPONSIBLE TO IDENTIFY ALL UTILITIES. THE UTILITY LINES SHOWN ON THE PLAN ARE FOR INFORMATIONAL PURPOSES ONLY AND DO NOT REPRESENT SURVEYED LINE INFORMATION.
4. SLOPES OF 30° OR GREATER EXIST. CONSTRUCTION FOR STEEP SLOPES TO BE PERFORMED USING STEEP SLOPE TECHNIQUES IDENTIFIED IN THE DETAIL SHEETS. ALSO REFER TO THE SITE-SPECIFIC DESIGN OF STABILIZATION MEASURES IN SELECTED HIGH-HAZARD PORTIONS OF THE ROUTE OF THE PROPOSED MOUNTAIN VALLEY PIPELINE PROJECT.
5. WHERE CONSTRUCTION CONDITIONS PRECLUDE THE USE OF DIVERSION DITCHES DUE TO SITE CONDITIONS THE CONTRACTOR WILL INSTALL SILT FENCE AT THE DIRECTION OF MVP.
6. IMPROVEMENTS TO PERMANENT AND TEMPORARY ACCESS ROADS WILL BE PERFORMED PER THE SITE SPECIFIC ACCESS ROAD DETAILS.
7. TEMPORARY ACCESS ROAD CROSSING OF STREAMS AND WETLANDS WILL UTILIZE TIMBERMATS. ANY PERMANENT ROAD CROSSINGS WILL BE CONDUCTED VIA CULVERTS.
8. ALL NON VMRC STREAM CROSSINGS WILL BE PERFORMED AS DESCRIBED IN THE STREAM CROSSING TABLE INCLUDED IN THIS PACKAGE.

NO.:	DATE:	DWN.:	CHKD.:	APPD.:	DESCRIPTION:
–	06/09/23	JJZ	IHH	DCW	MP 244.2 CENTERLINE ADJUSTMENT
–	04/07/23	JJZ	TD	DCW	ADDRESS DEQ COMMENTS ON CROSSING CHANGE METHOD
–	05/12/21	GAR	RE	DW	CROSSING METHOD CHANGE FROM OPEN CUT TO BORE
5	03/04/18	KAL	RE	DW	ADDRESS VADEQ COMMENTS
4	02/27/18	KAL	RE	DW	ADDRESS VADEQ COMMENTS
3	02/05/18	KAL	RE	DW	ADDRESS VADEQ COMMENTS

REVISIONS:

Mountain Valley PIPELINE

EROSION AND SEDIMENT CONTROL PLANS

MOUNTAIN VALLEY PIPELINE PROJECT – H600 LINE

SPREAD 10 – ROANOKE COUNTY, VIRGINIA

MOUNTAIN VALLEY PIPELINE, LLC
2200 ENERGY DRIVE
CANONSBURG, PA 15311

TETRA TECH
complex world | CLEAR SOLUTIONS™
661 ANDERSEN DRIVE
FOSTER PLAZA 7
PITTSBURGH, PA 15220


EROSION AND SEDIMENT CONTROL PLANS

COMMONWEALTH OF VIRGINIA
DAVID J. WALLNER
Lic. No. 57593
5/12/2021
PROFESSIONAL ENGINEER

DRAWN BY:	JJZ
CHECKED BY:	IHH
APPROVED BY:	DCW
DATE:	06/09/2023
SCALE:	AS SHOWN
SHT. NO.	14.19ES OF 14.81ES

REVISION


TETRA TECH CAD FILE PATH: X:\CADD_Pittsburgh\EQT\7157 – MVP\14 – Roanoke\E&S\E&S VERSION 5.0.0\7157ES14.19(S10).dwg PLOTTED ON: 6/12/2023 1:06 PM PLOTTED BY: Zeigler, Justin PLOT FILE: ENVIRONMENTAL_COLOR.ctb

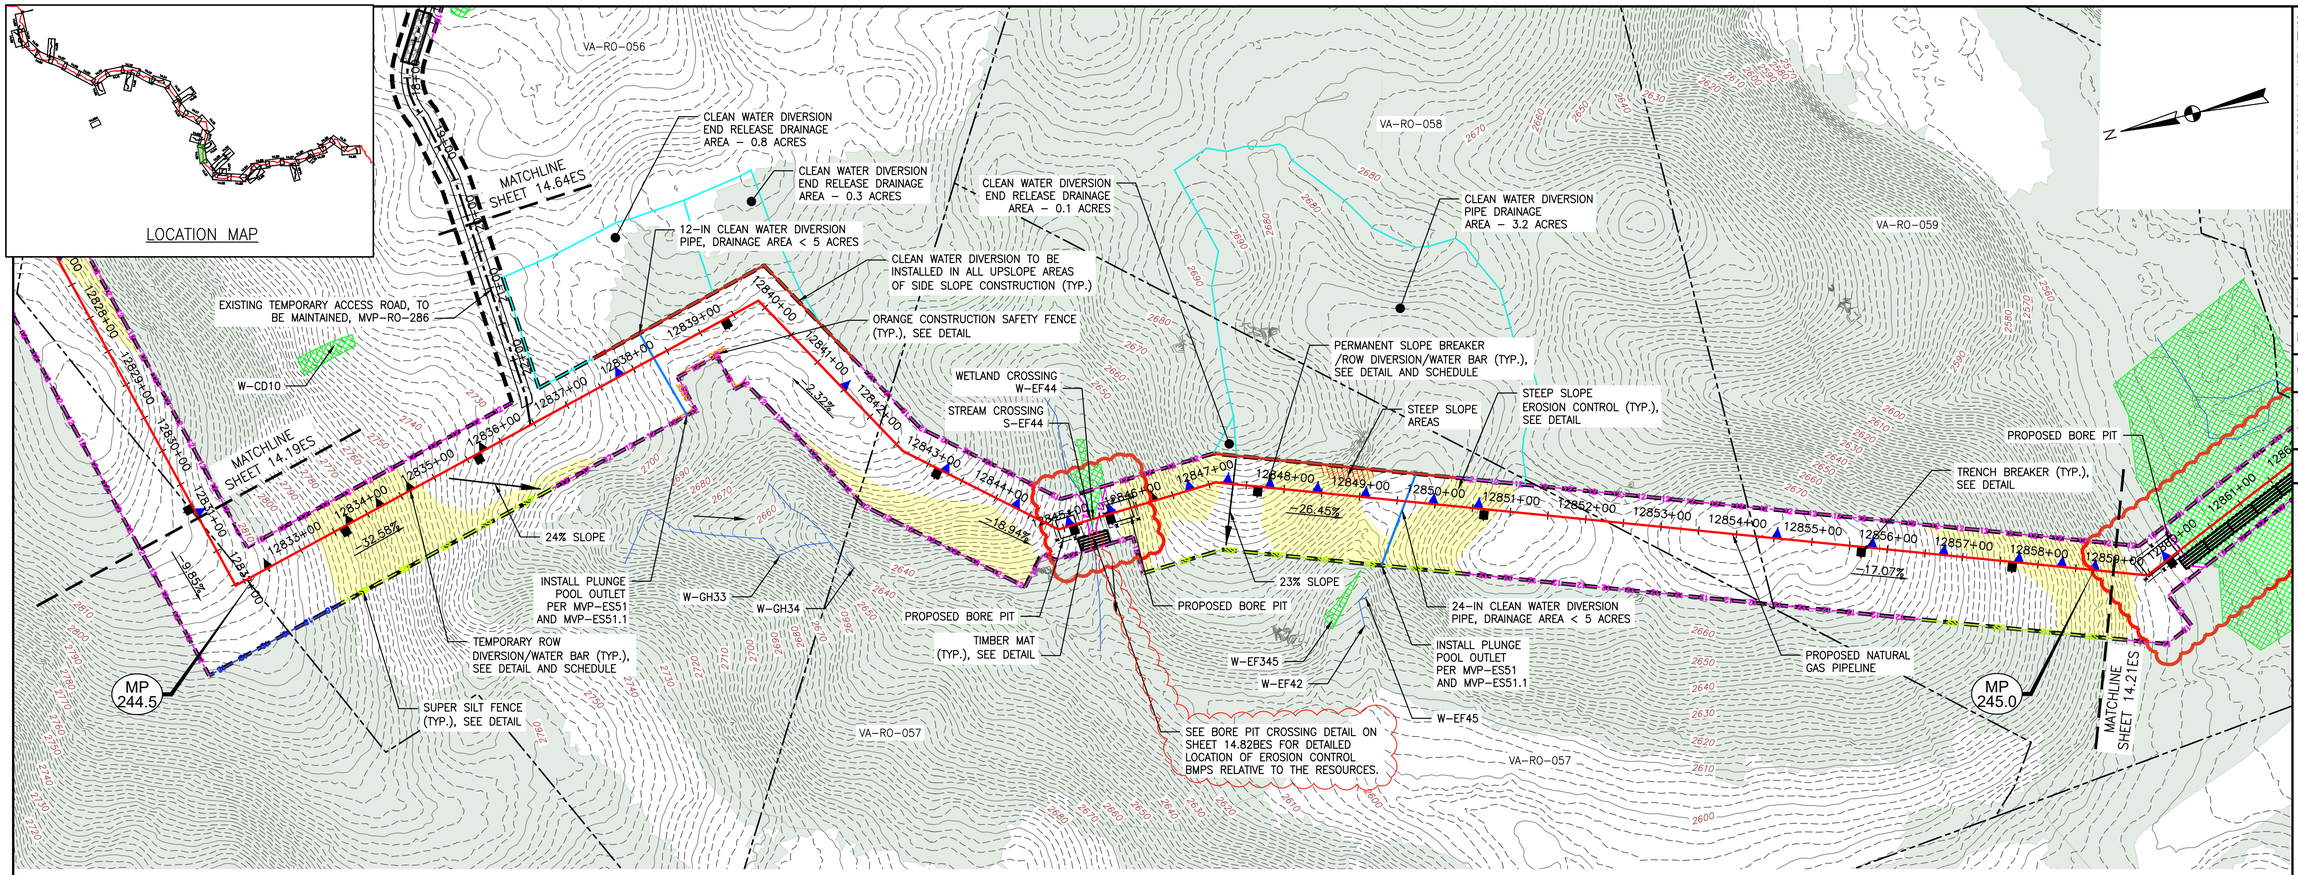

PLAN

SCALE: 1" = 100'

100 0 100 200

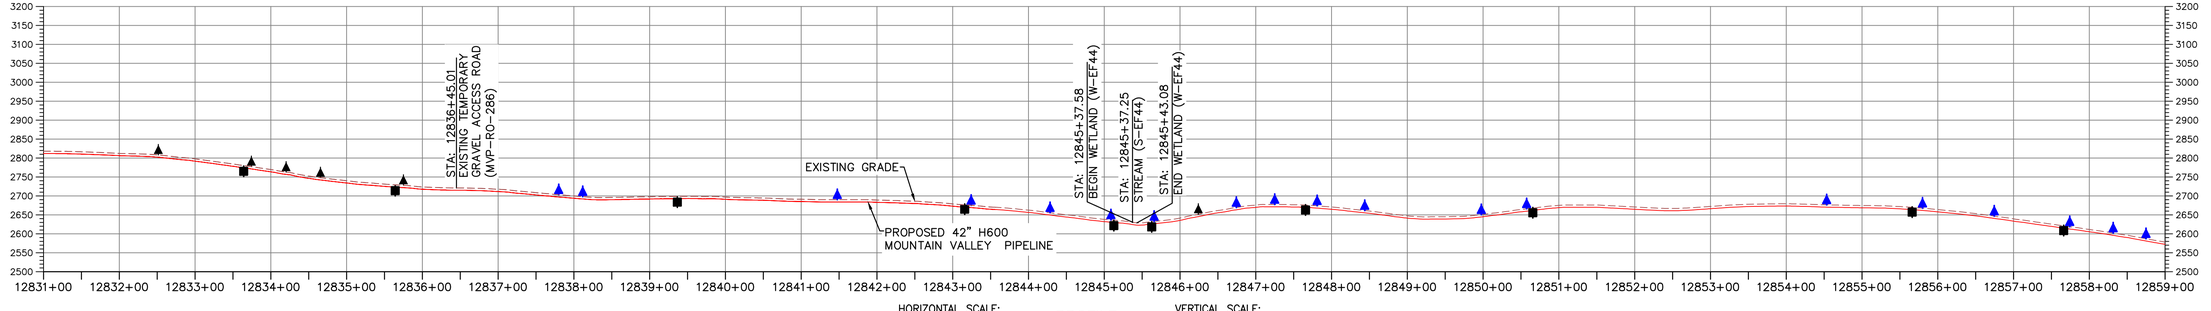

PROFILE

HORIZONTAL SCALE: SCALE: 1" = 100'

100 0 100 200

VERTICAL SCALE: SCALE: 1" = 200'

200 0 200 400

LEGEND

- PROPOSED LIMIT OF DISTURBANCE
- STREAM
- USDA FOREST SERVICE (NATIONAL FOREST) LANDS
- APPALACHIAN NATIONAL SCENIC TRAIL
- EXISTING ROAD/TRAIL
- EXISTING PROPERTY LINE
- EXISTING STATE LINE
- EXISTING COUNTY LINE
- POND
- WETLAND
- ACID FORMING MATERIAL
- EXISTING FOREST
- PROPOSED ACCESS ROAD CENTERLINE
- PROPOSED PIPELINE
- PROPOSED SILT FENCE (SEE NOTE 5)
- PROPOSED SUPER SILT FENCE (SEE DETAIL MVP-ES9.2)
- PROPOSED REINFORCED FILTRATION DEVICE (SEE DETAILS MVP-ES9, 9.1, 9.2, 9.3)
- ORANGE CONSTRUCTION SAFETY FENCE
- PROPOSED COMPOST FILTER SOCK (SEE DETAILS MVP-ES3, 3.1, 3.2)
- PROPOSED COMPOST FILTER SOCK (SEE DETAILS MVP-ES3, 3.1, 3.2)
- PROPOSED COMPOST FILTER SOCK (SEE DETAILS MVP-ES3, 3.1, 3.2)
- GRASS-LINED CHANNEL (SEE DETAIL MVP-ES39)
- CLEAN WATER DIVERSION PIPE
- CLEAN WATER DIVERSION DIKE (SEE DETAIL MVP-ES50 AND MVP-ES51)
- STREAM FLOW DIRECTION
- FEMA 100 YEAR FLOODPLAIN
- DRAINAGE AREA BOUNDARY
- TIMBER MAT (SEE DETAIL MVP-ES37)
- STEEP SLOPE EROSION CONTROL (SEE NOTE 2)
- STEEP SLOPE AREAS (SEE NOTE 4)
- PROPOSED ROCK CONSTRUCTION ENTRANCE
- PROPOSED TRENCH BREAKER (SEE DETAIL MVP-20)
- TEMPORARY ROW DIVERSION/WATER BAR (SEE DETAIL MP-17)
- PERMANENT SLOPE BREAKER/ROW DIVERSION/WATER BAR (SEE DETAIL MVP-17)

COMMONWEALTH OF VIRGINIA
4/7/23
DANIEL C. WITT
Lic. No. 65093
PROFESSIONAL ENGINEER

THIS SEAL APPLIES ONLY TO REVISIONS DATED 04-07-2023

NOTES:

1. TOPSOIL SEGREGATION WILL BE PERFORMED IN ALL IMMEDIATE CONSTRUCTION AREAS OF THE PROJECT IN ACCORDANCE WITH DETAILS MVP-ES46.1 THROUGH MVP-ES46.3.
2. FLEXTERRA, EARTHGUARD OR EQUIVALENT MAY BE USED AS A SUBSTITUTE TO EROSION CONTROL BLANKET AS DIRECTED BY MVP.
3. CONTRACTOR IS RESPONSIBLE TO IDENTIFY ALL UTILITIES. THE UTILITY LINES SHOWN ON THE PLAN ARE FOR INFORMATIONAL PURPOSES ONLY AND DO NOT REPRESENT SURVEYED LINE INFORMATION.
4. SLOPES OF 30' OR GREATER EXIST. CONSTRUCTION FOR STEEP SLOPES TO BE PERFORMED USING STEEP SLOPE TECHNIQUES IDENTIFIED IN THE DETAIL SHEETS. ALSO REFER TO THE SITE-SPECIFIC DESIGN OF STABILIZATION MEASURES IN SELECTED HIGH-HAZARD PORTIONS OF THE ROUTE OF THE PROPOSED MOUNTAIN VALLEY PIPELINE PROJECT.
5. WHERE CONSTRUCTION CONDITIONS PRECLUDE THE USE OF DIVERSION DITCHES DUE TO SITE CONDITIONS THE CONTRACTOR WILL INSTALL SILT FENCE AT THE DIRECTION OF MVP.
6. IMPROVEMENTS TO PERMANENT AND TEMPORARY ACCESS ROADS WILL BE PERFORMED PER THE SITE SPECIFIC ACCESS ROAD DETAILS.
7. TEMPORARY ACCESS ROAD CROSSING OF STREAMS AND WETLANDS WILL UTILIZE TIMBERMATS. ANY PERMANENT ROAD CROSSINGS WILL BE CONDUCTED VIA CULVERTS.
8. ALL NON VMRC STREAM CROSSINGS WILL BE PERFORMED AS DESCRIBED IN THE STREAM CROSSING TABLE INCLUDED IN THIS PACKAGE.

NO.:	DATE:	DWN.:	CHKD.:	APPD.:	DESCRIPTION:
–	04/07/23	JJZ	TD	DCW	ADDRESS DEQ COMMENTS ON CROSSING CHANGE METHOD
–	05/12/21	GAR	RE	DW	CROSSING METHOD CHANGE FROM OPEN CUT TO BORE
5	03/04/18	KAL	RE	DW	ADDRESS VADEQ COMMENTS
4	02/27/18	KAL	RE	DW	ADDRESS VADEQ COMMENTS
3	02/05/18	KAL	RE	DW	ADDRESS VADEQ COMMENTS
2	11/21/17	KAL	RE	DW	ADDRESS VADEQ COMMENTS

REVISIONS:

Mountain Valley PIPELINE

EROSION AND SEDIMENT CONTROL PLANS

MOUNTAIN VALLEY PIPELINE PROJECT – H600 LINE

SPREAD 10 – ROANOKE COUNTY, VIRGINIA

MOUNTAIN VALLEY PIPELINE, LLC
2200 ENERGY DRIVE
CANONSBURG, PA 15311

TETRA TECH
complex world | CLEAR SOLUTIONS™
661 ANDERSEN DRIVE
FOSTER PLAZA 7
PITTSBURGH, PA 15220


EROSION AND SEDIMENT CONTROL PLANS

COMMONWEALTH OF VIRGINIA
David J. Wallner
DAVID J. WALLNER
Lic. No. 57593
5/12/2021
PROFESSIONAL ENGINEER

DRAWN BY:	JJZ
CHECKED BY:	TD
APPROVED BY:	DCW
DATE:	04/07/2023
SCALE:	AS SHOWN
SHT. NO.	14.20ES OF 14.81ES

– REVISION

TETRA TECH CAD FILE PATH: X:\CAD_ Pittsburgh\EQT\7157 – MVP\14 – Roanoke\E&S\E&S VERSION 5.0.0\7157ES14.20(S10).dwg PLOTTED ON: 4/6/2023 2:58 PM PLOTTED BY: Zeigler, Justin PLOT FILE: ENVIRONMENTAL_COLOR.ctb

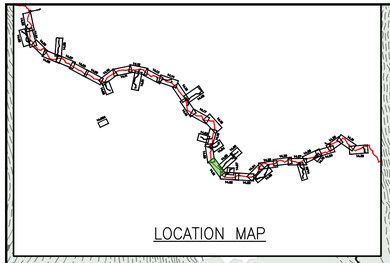


NOTES:

1. INSTALL SOIL STABILIZATION BLANKET (CC-4 OR EQUIVALENT) IN WATERBAR FLOW PATHS AND AT THE SEDIMENT SUMP SPILLWAY OUTLET.
2. INSTALL RIP RAP ENERGY DISSIPATOR AT PIPE OUTLET INTO SEDIMENT SUMP.
3. CONSTRUCTION ACCESS ROAD TO DRAIN TO SUPER SILT FENCE. INSTALL ECB ON FILL SLOPE AND ALONG SSF FLOW PATH. INSTALL CFS CHECK DAMS WITHIN THE SSF FLOW PATH.

PLAN

SCALE: 1" = 100'

100 0 100 200

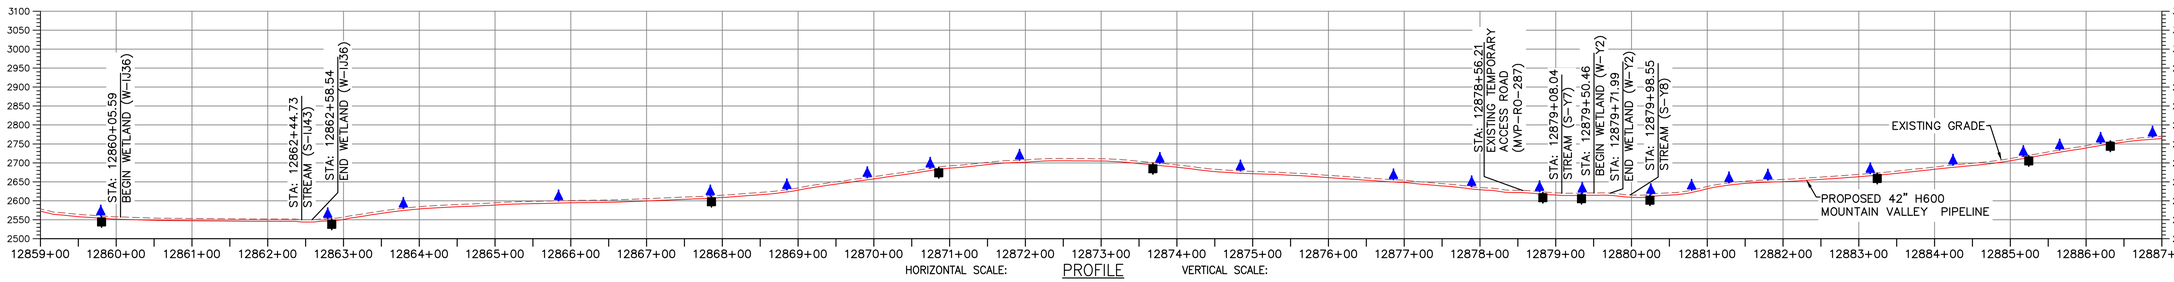

PROFILE

SCALE: 1" = 100' SCALE: 1" = 200'

100 0 100 200 200 0 200 400

LEGEND

- PROPOSED LIMIT OF DISTURBANCE
- STREAM
- USDA FOREST SERVICE (NATIONAL FOREST) LANDS
- APPALACHIAN NATIONAL SCENIC TRAIL
- EXISTING ROAD/TRAIL
- EXISTING PROPERTY LINE
- EXISTING STATE LINE
- EXISTING COUNTY LINE
- POND
- WETLAND
- ACID FORMING MATERIAL
- EXISTING FOREST
- PROPOSED ACCESS ROAD CENTERLINE
- PROPOSED PIPELINE
- PROPOSED SILT FENCE (SEE NOTE 5)
- PROPOSED SUPER SILT FENCE (SEE DETAIL MVP-ES9.2)
- PROPOSED REINFORCED FILTRATION DEVICE (SEE DETAILS MVP-ES9, 9.1, 9.2, 9.3)
- ORANGE CONSTRUCTION SAFETY FENCE
- PROPOSED COMPOST FILTER SOCK (SEE DETAILS MVP-ES3, 3.1, 3.2)
- PROPOSED COMPOST FILTER SOCK (SEE DETAILS MVP-ES3, 3.1, 3.2)
- PROPOSED COMPOST FILTER SOCK (SEE DETAILS MVP-ES3, 3.1, 3.2)
- GRASS-LINED CHANNEL (SEE DETAIL MVP-ES39)
- CLEAN WATER DIVERSION PIPE
- CLEAN WATER DIVERSION DIKE (SEE DETAIL MVP-ES50 AND MVP-ES51)
- WATERBAR/SEDIMENT SUMP/24" CPP (SEE DETAIL MVP-ES64)
- STREAM FLOW DIRECTION
- FEMA 100 YEAR FLOODPLAIN
- DRAINAGE AREA BOUNDARY
- TIMBER MAT (SEE DETAIL MVP-ES37)
- STEEP SLOPE EROSION CONTROL (SEE NOTE 2)
- STEEP SLOPE AREAS (SEE NOTE 4)
- PROPOSED ROCK CONSTRUCTION ENTRANCE
- PROPOSED TRENCH BREAKER (SEE DETAIL MVP-20)
- TEMPORARY ROW DIVERSION/WATER BAR (SEE DETAIL MP-17)
- PERMANENT SLOPE BREAKER/ROW DIVERSION/WATER BAR (SEE DETAIL MVP-17)

COMMONWEALTH OF VIRGINIA
4/7/23
DANIEL C. WITT
Lic. No. 65093
PROFESSIONAL ENGINEER

THIS SEAL APPLIES ONLY TO REVISIONS DATED 04-07-2023

NOTES:

1. TOPSOIL SEGREGATION WILL BE PERFORMED IN ALL IMMEDIATE CONSTRUCTION AREAS OF THE PROJECT IN ACCORDANCE WITH DETAILS MVP-ES46.1 THROUGH MVP-ES46.3.
2. FLEXTERRA, EARTHGUARD OR EQUIVALENT MAY BE USED AS A SUBSTITUTE TO EROSION CONTROL BLANKET AS DIRECTED BY MVP.
3. CONTRACTOR IS RESPONSIBLE TO IDENTIFY ALL UTILITIES. THE UTILITY LINES SHOWN ON THE PLAN ARE FOR INFORMATIONAL PURPOSES ONLY AND DO NOT REPRESENT SURVEYED LINE INFORMATION.
4. SLOPES OF 30' OR GREATER EXIST. CONSTRUCTION FOR STEEP SLOPES TO BE PERFORMED USING STEEP SLOPE TECHNIQUES IDENTIFIED IN THE DETAIL SHEETS. ALSO REFER TO THE SITE-SPECIFIC DESIGN OF STABILIZATION MEASURES IN SELECTED HIGH-HAZARD PORTIONS OF THE ROUTE OF THE PROPOSED MOUNTAIN VALLEY PIPLELINE PROJECT.
5. WHERE CONSTRUCTION CONDITIONS PRECLUDE THE USE OF DIVERSION DITCHES DUE TO SITE CONDITIONS THE CONTRACTOR WILL INSTALL SILT FENCE AT THE DIRECTION OF MVP.
6. IMPROVEMENTS TO PERMANENT AND TEMPORARY ACCESS ROADS WILL BE PERFORMED PER THE SITE SPECIFIC ACCESS ROAD DETAILS.
7. TEMPORARY ACCESS ROAD CROSSING OF STREAMS AND WETLANDS WILL UTILIZE TIMBERMATS. ANY PERMANENT ROAD CROSSINGS WILL BE CONDUCTED VIA CULVERTS.
8. ALL NON VMRC STREAM CROSSINGS WILL BE PERFORMED AS DESCRIBED IN THE STREAM CROSSING TABLE INCLUDED IN THIS PACKAGE.

REVISIONS:

NO.:	DATE:	DWN.:	CHKD.:	APPD.:	DESCRIPTION:
3	02/05/18	KAL	RE	DW	ADDRESS VADEQ COMMENTS
4	02/27/18	KAL	RE	DW	ADDRESS VADEQ COMMENTS
5	03/04/18	KAL	RE	DW	ADDRESS VADEQ COMMENTS
–	12/02/20	JJZ	RE	DW	MVP-RO-287 FIELD REDLINE
–	05/12/21	CAR	RE	DW	CROSSING METHOD CHANGE FROM OPEN CUT TO BORE
–	04/07/23	JJZ	TD	DCW	ADDRESS DEQ COMMENTS ON CROSSING CHANGE METHOD

Mountain Valley PIPELINE

EROSION AND SEDIMENT CONTROL PLANS

MOUNTAIN VALLEY PIPELINE PROJECT – H600 LINE

SPREAD 10 – ROANOKE COUNTY, VIRGINIA

MOUNTAIN VALLEY PIPELINE, LLC
2200 ENERGY DRIVE
CANONSBURG, PA 15317

TETRA TECH
complex world | CLEAR SOLUTIONS™
661 ANDERSEN DRIVE
FOSTER PLAZA 7
PITTSBURGH, PA 15220


EROSION AND SEDIMENT CONTROL PLANS

COMMONWEALTH OF VIRGINIA
DAVID J. WALLNER
Lic. No. 57593
PROFESSIONAL ENGINEER
5/12/2021

DRAWN BY:	JJZ
CHECKED BY:	TD
APPROVED BY:	DCW
DATE:	04/07/2023
SCALE:	AS SHOWN
SHT. NO.	14.21ES OF 14.81ES

– REVISION


TETRA TECH CAD FILE PATH: X:\CADD_Pittsburgh\EGT\7157 – MVP\14 – Roanoke\E&S\E&S VERSION 5.0.0\7157ES14.21(S10).dwg PLOTTED ON: 4/6/2023 3:05 PM PLOTTED BY: Zeigler, Justin PLOT FILE: ENVIRONMENTAL_COLOR.ctb

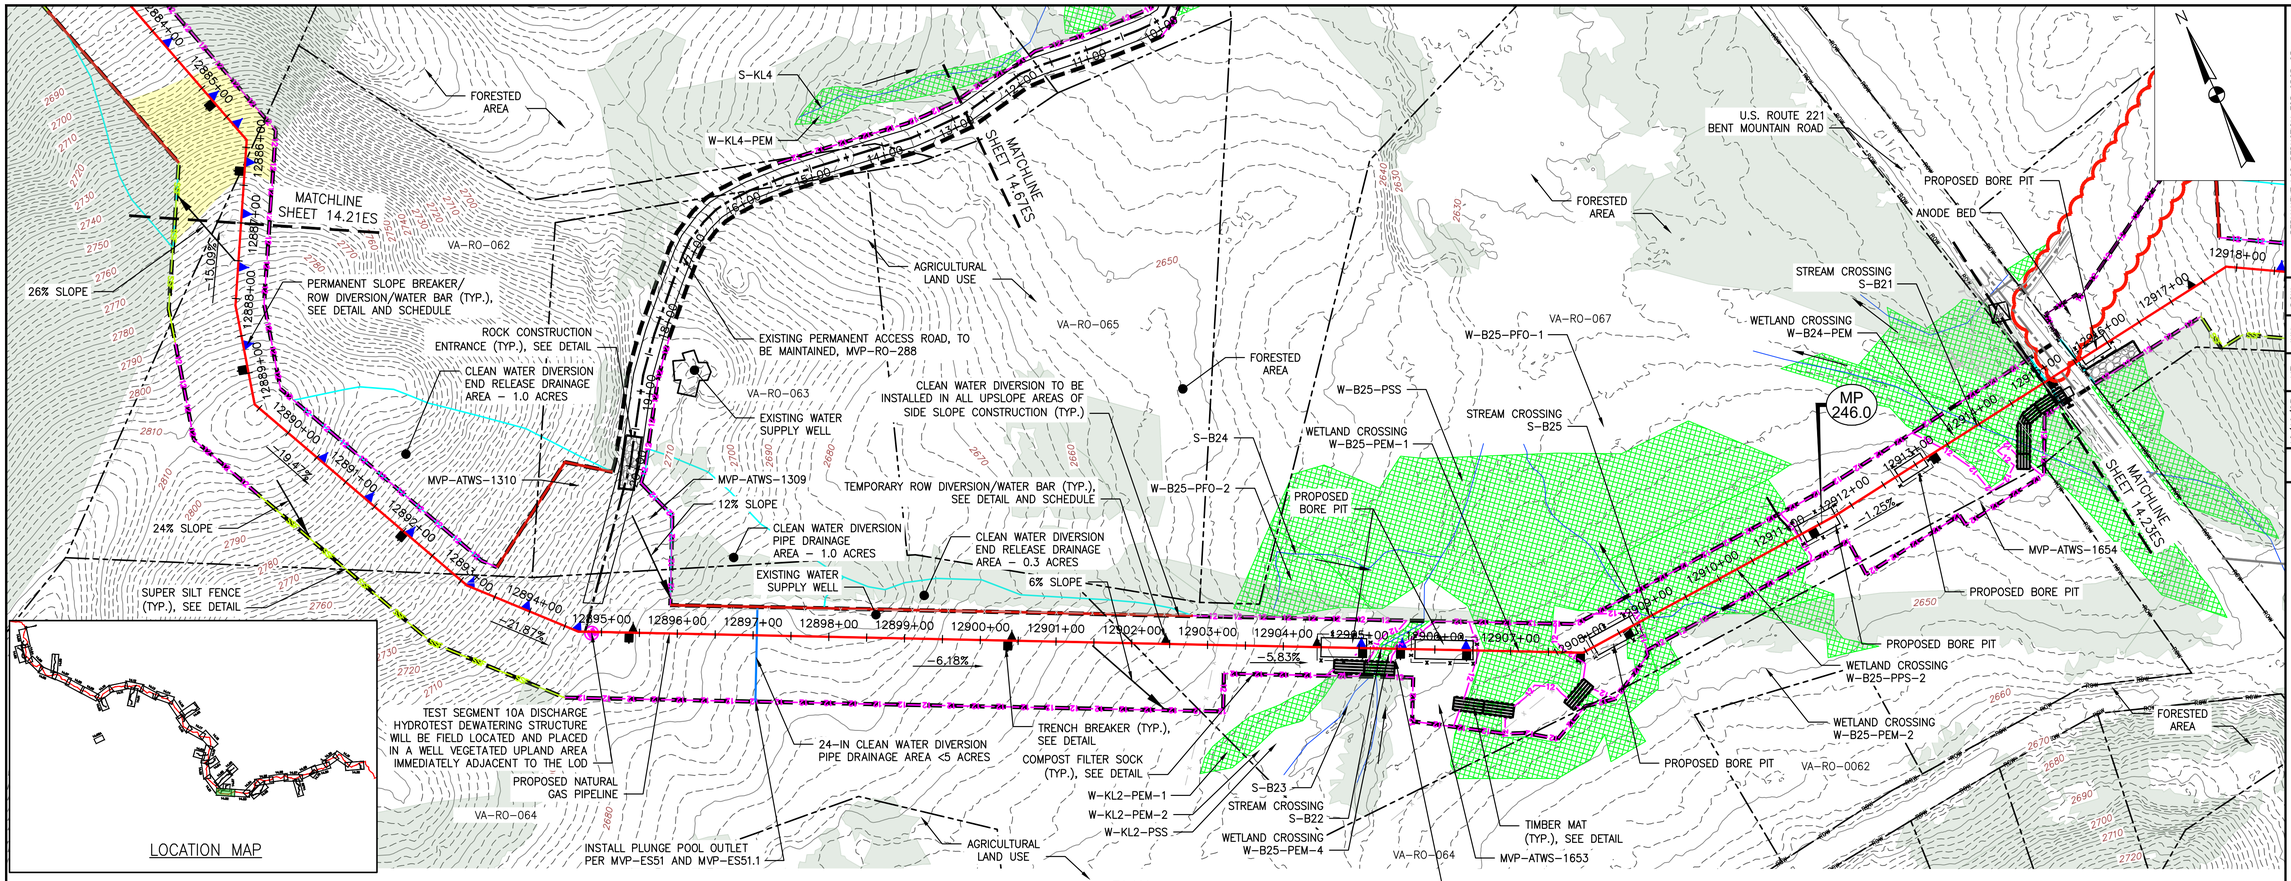

PLAN

SCALE: 1" = 100'

100 0 100 200

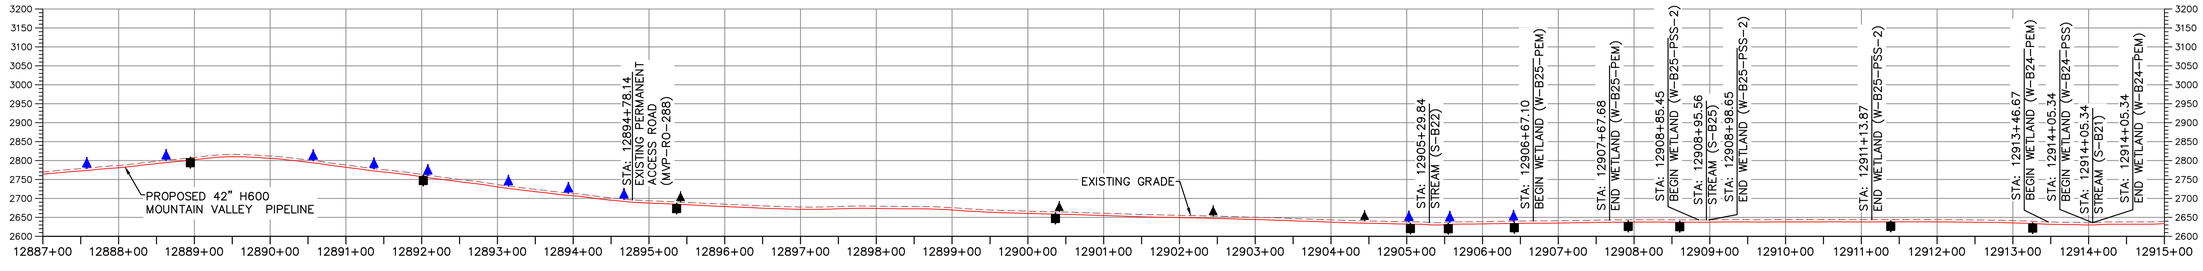

PROFILE

HORIZONTAL SCALE: SCALE: 1" = 100'

100 0 100 200

VERTICAL SCALE: SCALE: 1" = 200'

200 0 200 400

LEGEND

- PROPOSED LIMIT OF DISTURBANCE
- STREAM
- USDA FOREST SERVICE (NATIONAL FOREST) LANDS
- APPALACHIAN NATIONAL SCENIC TRAIL
- EXISTING ROAD/TRAIL
- EXISTING PROPERTY LINE
- EXISTING STATE LINE
- EXISTING COUNTY LINE
- POND
- WETLAND
- ACID FORMING MATERIAL
- EXISTING FOREST
- PROPOSED ACCESS ROAD CENTERLINE
- PROPOSED PIPELINE
- PROPOSED SILT FENCE (SEE NOTE 5)
- PROPOSED SUPER SILT FENCE (SEE DETAIL MVP-ES9.2)
- PROPOSED REINFORCED FILTRATION DEVICE (SEE DETAILS MVP-ES9, 9.1, 9.2, 9.3)
- ORANGE CONSTRUCTION SAFETY FENCE
- PROPOSED COMPOST FILTER SOCK (SEE DETAILS MVP-ES3, 3.1, 3.2)
- PROPOSED COMPOST FILTER SOCK (SEE DETAILS MVP-ES3, 3.1, 3.2)
- PROPOSED COMPOST FILTER SOCK (SEE DETAILS MVP-ES3, 3.1, 3.2)
- GRASS-LINED CHANNEL (SEE DETAIL MVP-ES39)
- CLEAN WATER DIVERSION PIPE
- CLEAN WATER DIVERSION DIKE (SEE DETAIL MVP-ES50 AND MVP-ES51)
- STREAM FLOW DIRECTION
- FEMA 100 YEAR FLOODPLAIN
- DRAINAGE AREA BOUNDARY
- TIMBER MAT (SEE DETAIL MVP-ES37)
- STEEP SLOPE EROSION CONTROL (SEE NOTE 2)
- STEEP SLOPE AREAS (SEE NOTE 4)
- PROPOSED ROCK CONSTRUCTION ENTRANCE
- PROPOSED TRENCH BREAKER (SEE DETAIL MVP-20)
- TEMPORARY ROW DIVERSION/WATER BAR (SEE DETAIL MP-17)
- PERMANENT SLOPE BREAKER/ROW DIVERSION/WATER BAR (SEE DETAIL MVP-17)

COMMONWEALTH OF VIRGINIA
10/19/23
DANIEL C. WITT
Lic. No. 65093
PROFESSIONAL ENGINEER

THIS SEAL APPLIES ONLY TO REVISIONS DATED 10-19-2023

NOTES:

1. TOPSOIL SEGREGATION WILL BE PERFORMED IN ALL IMMEDIATE CONSTRUCTION AREAS OF THE PROJECT IN ACCORDANCE WITH DETAILS MVP-ES46.1 THROUGH MVP-ES46.3.
2. FLEXTERRA, EARTHGUARD OR EQUIVALENT MAY BE USED AS A SUBSTITUTE TO EROSION CONTROL BLANKET AS DIRECTED BY MVP.
3. CONTRACTOR IS RESPONSIBLE TO IDENTIFY ALL UTILITIES. THE UTILITY LINES SHOWN ON THE PLAN ARE FOR INFORMATIONAL PURPOSES ONLY AND DO NOT REPRESENT SURVEYED LINE INFORMATION.
4. SLOPES OF 30' OR GREATER EXIST. CONSTRUCTION FOR STEEP SLOPES TO BE PERFORMED USING STEEP SLOPE TECHNIQUES IDENTIFIED IN THE DETAIL SHEETS. ALSO REFER TO THE SITE-SPECIFIC DESIGN OF STABILIZATION MEASURES IN SELECTED HIGH-HAZARD PORTIONS OF THE ROUTE OF THE PROPOSED MOUNTAIN VALLEY PIPLELINE PROJECT.
5. WHERE CONSTRUCTION CONDITIONS PRECLUDE THE USE OF DIVERSION DITCHES DUE TO SITE CONDITIONS THE CONTRACTOR WILL INSTALL SILT FENCE AT THE DIRECTION OF MVP.
6. IMPROVEMENTS TO PERMANENT AND TEMPORARY ACCESS ROADS WILL BE PERFORMED PER THE SITE SPECIFIC ACCESS ROAD DETAILS.
7. TEMPORARY ACCESS ROAD CROSSING OF STREAMS AND WETLANDS WILL UTILIZE TIMBERMATS. ANY PERMANENT ROAD CROSSINGS WILL BE CONDUCTED VIA CULVERTS.
8. ALL NON VMRC STREAM CROSSINGS WILL BE PERFORMED AS DESCRIBED IN THE STREAM CROSSING TABLE INCLUDED IN THIS PACKAGE.

NO.:	DATE:	DWN.:	CHKD.:	APPD.:	DESCRIPTION:
–	10/19/23	JJZ	IHH	DCW	PERMANENT LOD REDUCTION FOR CPDB-25
–	04/07/23	JJZ	TD	DCW	ADDRESS DEQ COMMENTS ON CROSSING CHANGE METHOD
–	05/12/21	JJZ	RE	DW	CROSSING METHOD CHANGE FROM OPEN CUT TO BORE
5	03/04/18	KAL	RE	DW	ADDRESS VADEQ COMMENTS
4	02/27/18	KAL	RE	DW	ADDRESS VADEQ COMMENTS
3	02/05/18	KAL	RE	DW	ADDRESS VADEQ COMMENTS

REVISIONS:

EROSION AND SEDIMENT CONTROL PLANS
MOUNTAIN VALLEY PIPELINE PROJECT – H600 LINE
SPREAD 10 – ROANOKE COUNTY, VIRGINIA

Mountain Valley PIPELINE

MOUNTAIN VALLEY PIPELINE, LLC
2200 ENERGY DRIVE
CANONSBURG, PA 15311


TETRA TECH
complex world | CLEAR SOLUTIONS™
661 ANDERSEN DRIVE
FOSTER PLAZA 7
PITTSBURGH, PA 15220

EROSION AND SEDIMENT CONTROL PLANS

COMMONWEALTH OF VIRGINIA
DAVID J. WALLNER
Lic. No. 57593
PROFESSIONAL ENGINEER
5/12/2021

DRAWN BY:	JJZ
CHECKED BY:	IHH
APPROVED BY:	DCW
DATE:	10/19/2023
SCALE:	AS SHOWN
	1 REVISION
SHT. NO.	14.22ES OF 14.81ES


TETRA TECH CAD FILE PATH: X:\CADD_Pittsburgh\EQT\7157 – MVP\14 – Roanoke\E&S\E&S VERSION 5.0.0\7157ES14.22(S10).dwg PLOTTED ON: 10/19/2023 3:14 PM PLOTTED BY: Zeigler, Justin PLOT FILE: ENVIRONMENTAL_COLOR.ctb

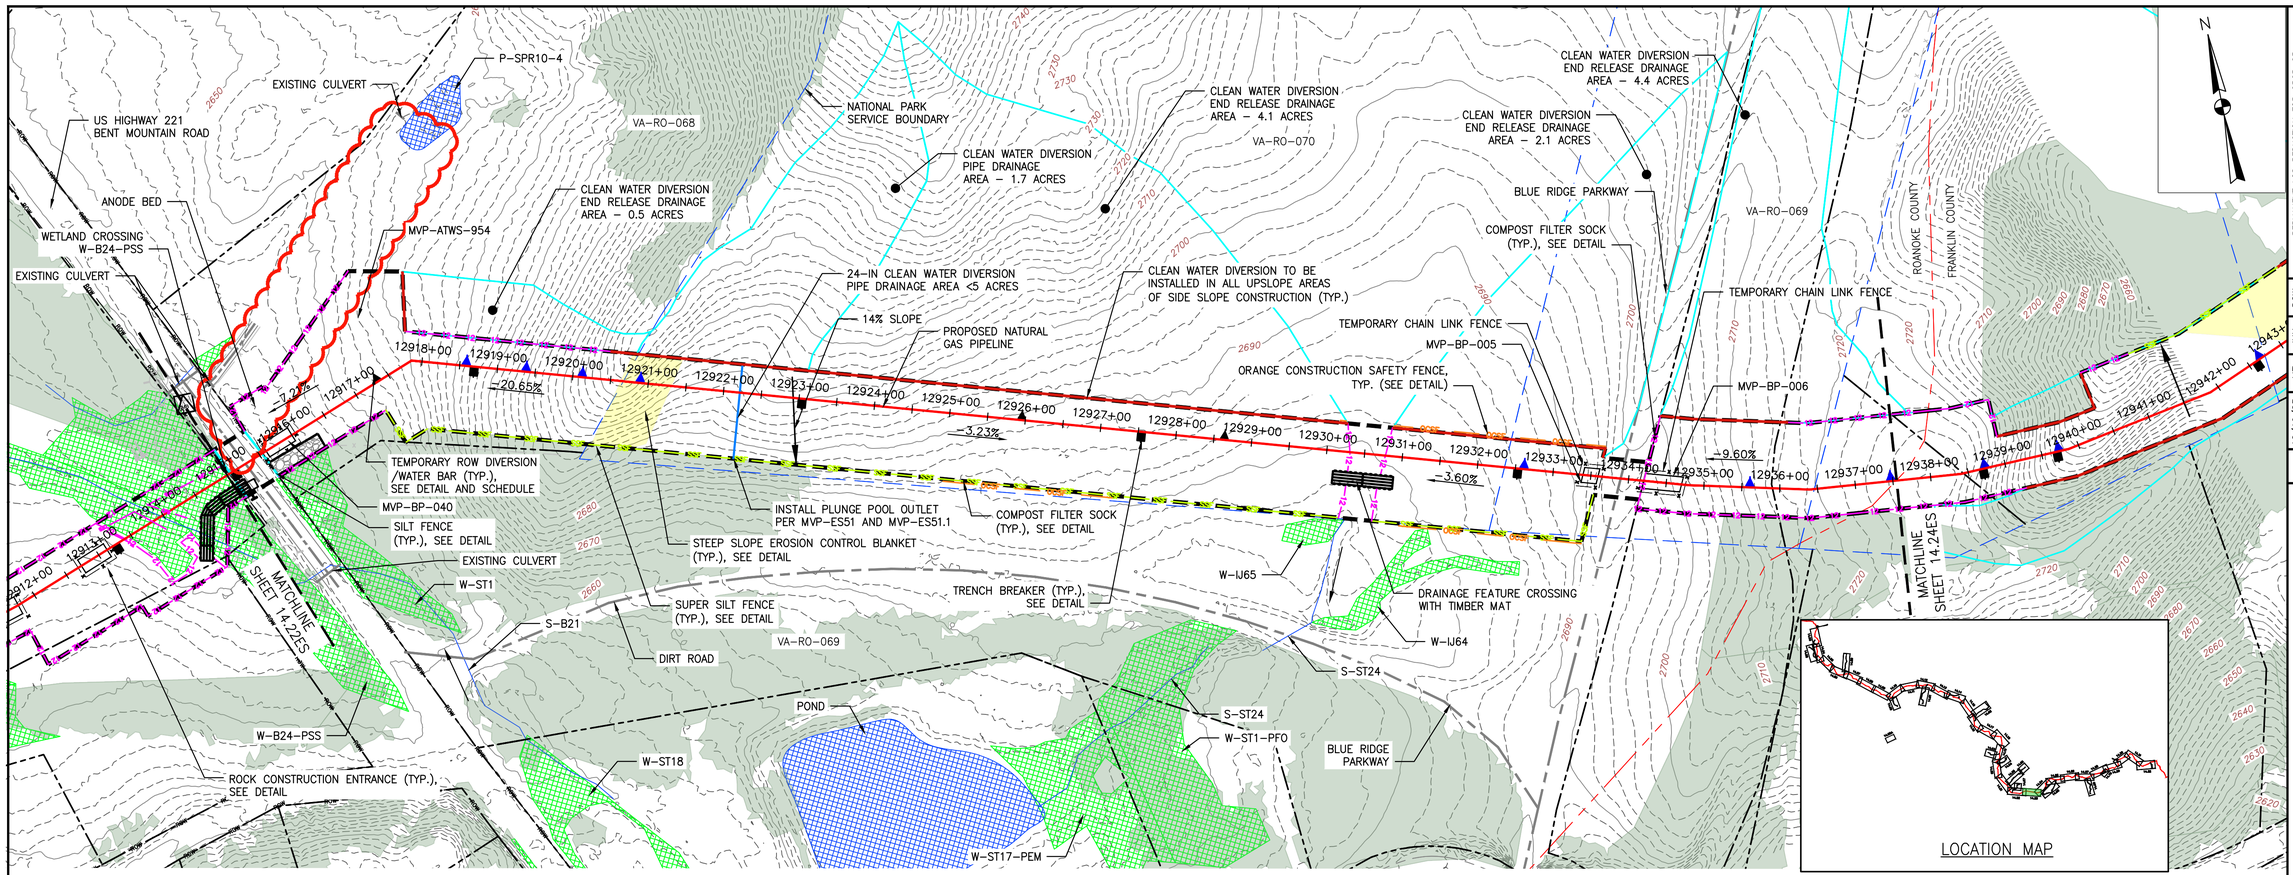

PLAN

SCALE: 1" = 100'

100 0 100 200

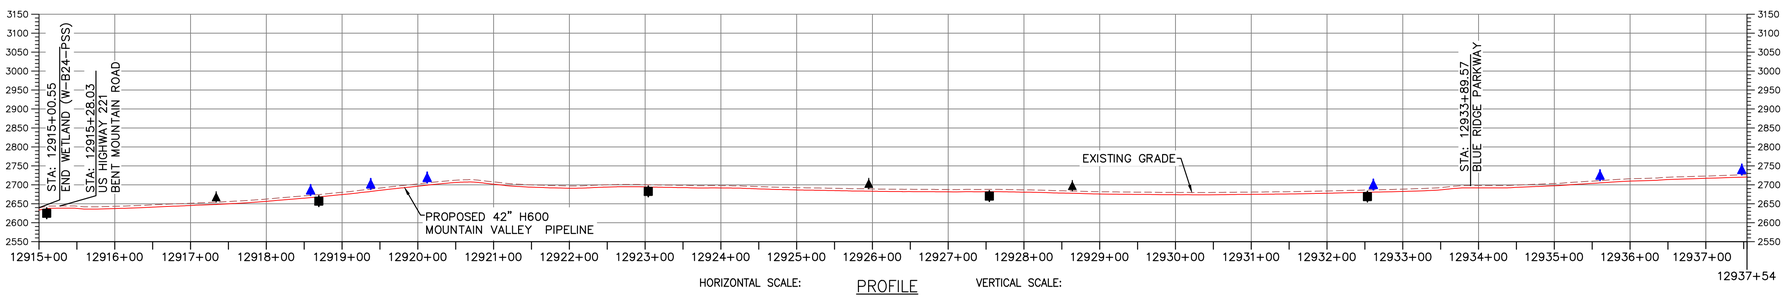

PROFILE

HORIZONTAL SCALE: SCALE: 1" = 100'

100 0 100 200

VERTICAL SCALE: SCALE: 1" = 200'

200 0 200 400

LEGEND

- PROPOSED LIMIT OF DISTURBANCE
- STREAM
- USDA FOREST SERVICE (NATIONAL FOREST) LANDS
- APPALACHIAN NATIONAL SCENIC TRAIL
- EXISTING ROAD/TRAIL
- EXISTING PROPERTY LINE
- EXISTING STATE LINE
- EXISTING COUNTY LINE
- POND
- WETLAND
- ACID FORMING MATERIAL
- EXISTING FOREST
- NATIONAL PARK SERVICE BOUNDARY
- PROPOSED ACCESS ROAD CENTERLINE
- PROPOSED PIPELINE
- PROPOSED SILT FENCE (SEE NOTE 5)
- PROPOSED SUPER SILT FENCE (SEE DETAIL MVP-ES9.2)
- PROPOSED REINFORCED FILTRATION DEVICE (SEE DETAILS MVP-ES9, 9.1, 9.2, 9.3)
- ORANGE CONSTRUCTION SAFETY FENCE
- PROPOSED COMPOST FILTER SOCK (SEE DETAILS MVP-ES3, 3.1, 3.2)
- PROPOSED COMPOST FILTER SOCK (SEE DETAILS MVP-ES3, 3.1, 3.2)
- PROPOSED COMPOST FILTER SOCK (SEE DETAILS MVP-ES3, 3.1, 3.2)
- GRASS-LINED CHANNEL (SEE DETAIL MVP-ES39)
- CLEAN WATER DIVERSION PIPE
- CLEAN WATER DIVERSION DIKE (SEE DETAIL MVP-ES50 AND MVP-ES51)
- STREAM FLOW DIRECTION
- FEMA 100 YEAR FLOODPLAIN
- DRAINAGE AREA BOUNDARY
- TIMBER MAT (SEE DETAIL MVP-ES37)
- STEEP SLOPE EROSION CONTROL (SEE NOTE 2)
- STEEP SLOPE AREAS (SEE NOTE 4)
- PROPOSED ROCK CONSTRUCTION ENTRANCE
- PROPOSED TRENCH BREAKER (SEE DETAIL MVP-20)
- TEMPORARY ROW DIVERSION/WATER BAR (SEE DETAIL MP-17)
- PERMANENT SLOPE BREAKER/ROW DIVERSION/WATER BAR (SEE DETAIL MVP-17)

COMMONWEALTH OF VIRGINIA
10/19/23
DANIEL C. WITT
Lic. No. 65093
PROFESSIONAL ENGINEER

THIS SEAL APPLIES ONLY TO REVISIONS DATED 10-19-2023

NOTES:

1. TOPSOIL SEGREGATION WILL BE PERFORMED IN ALL IMMEDIATE CONSTRUCTION AREAS OF THE PROJECT IN ACCORDANCE WITH DETAILS MVP-ES46.1 THROUGH MVP-ES46.3.
2. FLEXTERRA, EARTHGUARD OR EQUIVALENT MAY BE USED AS A SUBSTITUTE TO EROSION CONTROL BLANKET AS DIRECTED BY MVP.
3. CONTRACTOR IS RESPONSIBLE TO IDENTIFY ALL UTILITIES. THE UTILITY LINES SHOWN ON THE PLAN ARE FOR INFORMATIONAL PURPOSES ONLY AND DO NOT REPRESENT SURVEYED LINE INFORMATION.
4. SLOPES OF 30° OR GREATER EXIST. CONSTRUCTION FOR STEEP SLOPES TO BE PERFORMED USING STEEP SLOPE TECHNIQUES IDENTIFIED IN THE DETAIL SHEETS. ALSO REFER TO THE SITE-SPECIFIC DESIGN OF STABILIZATION MEASURES IN SELECTED HIGH-HAZARD PORTIONS OF THE ROUTE OF THE PROPOSED MOUNTAIN VALLEY PIPLELINE PROJECT.
5. WHERE CONSTRUCTION CONDITIONS PRECLUDE THE USE OF DIVERSION DITCHES DUE TO SITE CONDITIONS THE CONTRACTOR WILL INSTALL SILT FENCE AT THE DIRECTION OF MVP.
6. IMPROVEMENTS TO PERMANENT AND TEMPORARY ACCESS ROADS WILL BE PERFORMED PER THE SITE SPECIFIC ACCESS ROAD DETAILS.
7. TEMPORARY ACCESS ROAD CROSSING OF STREAMS AND WETLANDS WILL UTILIZE TIMBERMATS. ANY PERMANENT ROAD CROSSINGS WILL BE CONDUCTED VIA CULVERTS.
8. ALL NON VMRC STREAM CROSSINGS WILL BE PERFORMED AS DESCRIBED IN THE STREAM CROSSING TABLE INCLUDED IN THIS PACKAGE.

NO.	DATE:	DWN.:	CHKD.:	APPD.:	DESCRIPTION:
–	10/19/23	JJZ	KAL	IHH	DCW	PERMANENT LOD REDUCTION FOR CPDB-25
5	03/04/18	KAL	RE	DW	ADDRESS VADEQ COMMENTS
4	02/27/18	KAL	RE	DW	ADDRESS VADEQ COMMENTS
3	02/05/18	KAL	RE	DW	ADDRESS VADEQ COMMENTS
2	11/21/17	KAL	RE	DW	ADDRESS VADEQ COMMENTS
1	09/21/17	KAL	RE	DW	ADDRESS VADEQ COMMENTS

REVISIONS:

Mountain Valley PIPELINE

EROSION AND SEDIMENT CONTROL PLANS

MOUNTAIN VALLEY PIPELINE PROJECT – H600 LINE

SPREAD 10 – ROANOKE COUNTY, VIRGINIA

MOUNTAIN VALLEY PIPELINE, LLC

2200 ENERGY DRIVE

CANONSBURG, PA 15311

TETRA TECH

complex world | CLEAR SOLUTIONS™

661 ANDERSEN DRIVE
FOSTER PLAZA 7
PITTSBURGH, PA 15220

EROSION AND SEDIMENT CONTROL PLANS


COMMONWEALTH OF VIRGINIA
DAVID J. WALLNER
Lic. No. 57593
PROFESSIONAL ENGINEER
5/12/2021

DRAWN BY:	JJZ
CHECKED BY:	IHH
APPROVED BY:	DCW
DATE:	10/19/2023
SCALE:	AS SHOWN

– REVISION

SHT. NO. 14.23ES OF 14.81ES


TETRA TECH CAD FILE PATH: X:\CADD_Pittsburgh\EQT\7157 – MVP\14 – Roanoke\E&S\E&S VERSION 5.0.0\7157ES14.23(S10).dwg PLOTTED ON: 10/19/2023 3:13 PM PLOTTED BY: Zeigler, Justin PLOT FILE: ENVIRONMENTAL_COLOR.ctb

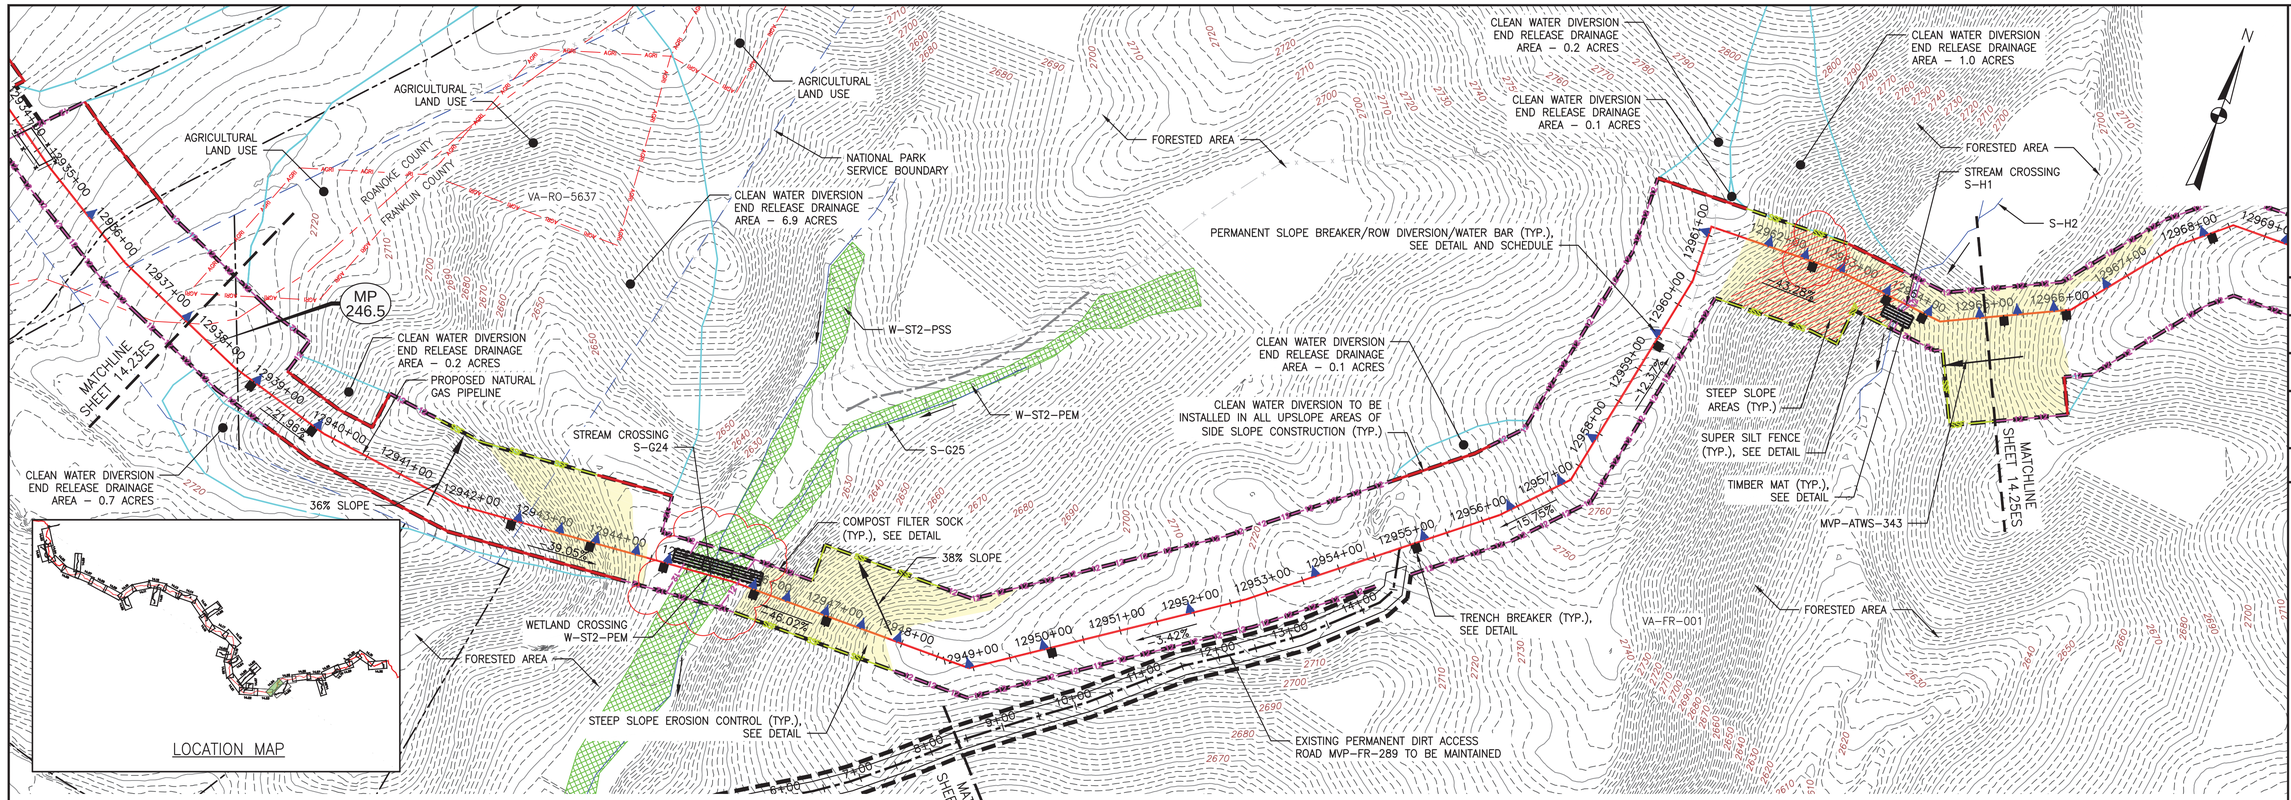

PLAN

SCALE: 1" = 100'

100 0 100 200

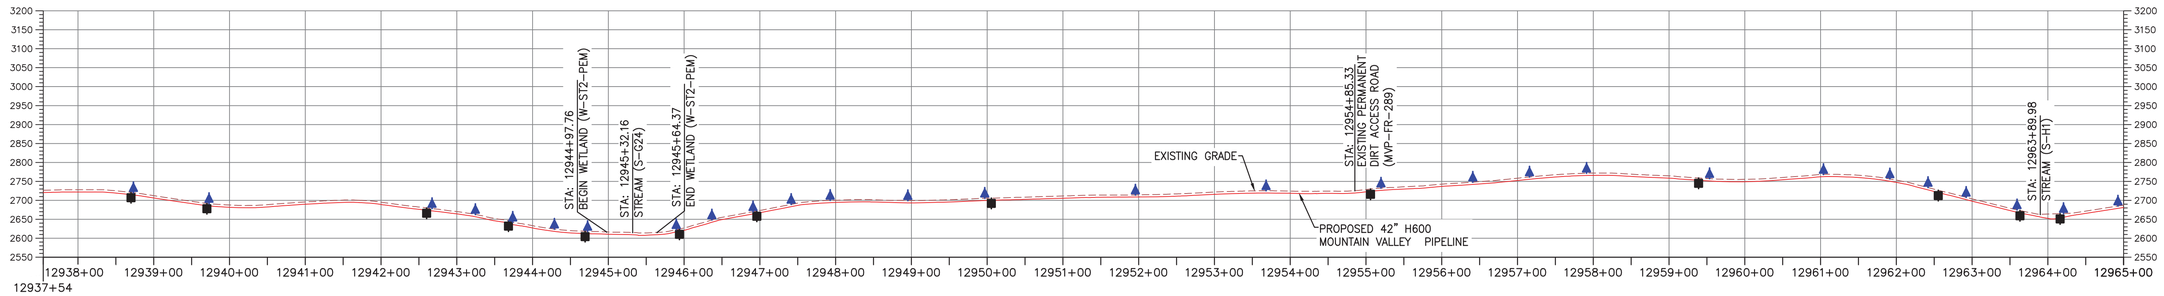

PROFILE

HORIZONTAL SCALE: SCALE: 1" = 100'

100 0 100 200

VERTICAL SCALE: SCALE: 1" = 200'

200 0 200 400

LEGEND

- PROPOSED LIMIT OF DISTURBANCE
- STREAM
- USDA FOREST SERVICE (NATIONAL FOREST) LANDS
- APPALACHIAN NATIONAL SCENIC TRAIL
- EXISTING ROAD/TRAIL
- EXISTING PROPERTY LINE
- EXISTING STATE LINE
- EXISTING COUNTY LINE
- POND
- WETLAND
- ACID FORMING MATERIAL
- AGRICULTURAL LAND USE BOUNDARY
- NATIONAL PARK SERVICE BOUNDARY
- PROPOSED ACCESS ROAD CENTERLINE
- PROPOSED PIPELINE
- PROPOSED SILT FENCE (SEE NOTE 5)
- PROPOSED SUPER SILT FENCE (SEE DETAIL MVP-ES9.2)
- PROPOSED REINFORCED FILTRATION DEVICE (SEE DETAILS MVP-ES9, 9.1, 9.2, 9.3)
- ORANGE CONSTRUCTION SAFETY FENCE
- PROPOSED COMPOST FILTER SOCK (SEE DETAILS MVP-ES3, 3.1, 3.2)
- PROPOSED COMPOST FILTER SOCK (SEE DETAILS MVP-ES3, 3.1, 3.2)
- PROPOSED COMPOST FILTER SOCK (SEE DETAILS MVP-ES3, 3.1, 3.2)
- GRASS-LINED CHANNEL (SEE DETAIL MVP-ES39)
- CLEAN WATER DIVERSION PIPE
- CLEAN WATER DIVERSION DIKE (SEE DETAIL MVP-ES50 AND MVP-ES51)
- STREAM FLOW DIRECTION
- FEMA 100 YEAR FLOODPLAIN
- DRAINAGE AREA BOUNDARY
- TIMBER MAT (SEE DETAIL MVP-ES37)
- STEEP SLOPE EROSION CONTROL (SEE NOTE 2)
- STEEP SLOPE AREAS (SEE NOTE 4)
- PROPOSED ROCK CONSTRUCTION ENTRANCE
- PROPOSED TRENCH BREAKER (SEE DETAIL MVP-20)
- TEMPORARY ROW DIVERSION/WATER BAR (VADEQ STD & SPEC 3.11)
- PERMANENT SLOPE BREAKER/ROW DIVERSION/WATER BAR (SEE DETAILS MVP-17, ES38, AND SCHEDULE)

NOTES:

1. TOPSOIL SEGREGATION WILL BE PERFORMED IN ALL IMMEDIATE CONSTRUCTION AREAS OF THE PROJECT IN ACCORDANCE WITH DETAILS MVP-ES46.1 THROUGH MVP-ES46.3.
2. FLEXTERRA, EARTHGUARD OR EQUIVALENT MAY BE USED AS A SUBSTITUTE TO EROSION CONTROL BLANKET AS DIRECTED BY MVP.
3. CONTRACTOR IS RESPONSIBLE TO IDENTIFY ALL UTILITIES. THE UTILITY LINES SHOWN ON THE PLAN ARE FOR INFORMATIONAL PURPOSES ONLY AND DO NOT REPRESENT SURVEYED LINE INFORMATION.
4. SLOPES OF 30% OR GREATER EXIST. CONSTRUCTION FOR STEEP SLOPES TO BE PERFORMED USING STEEP SLOPE TECHNIQUES IDENTIFIED IN THE DETAIL SHEETS. ALSO REFER TO THE SITE-SPECIFIC DESIGN OF STABILIZATION MEASURES IN SELECTED HIGH-HAZARD PORTIONS OF THE ROUTE OF THE PROPOSED MOUNTAIN VALLEY PIPELINE PROJECT.
5. WHERE CONSTRUCTION CONDITIONS PRECLUDE THE USE OF DIVERSION DITCHES DUE TO SITE CONDITIONS THE CONTRACTOR WILL INSTALL SILT FENCE AT THE DIRECTION OF MVP.
6. IMPROVEMENTS TO PERMANENT AND TEMPORARY ACCESS ROADS WILL BE PERFORMED PER THE SITE SPECIFIC ACCESS ROAD DETAILS.
7. TEMPORARY ACCESS ROAD CROSSING OF STREAMS AND WETLANDS WILL UTILIZE TIMBERMATS. ANY PERMANENT ROAD CROSSINGS WILL BE CONDUCTED VIA CULVERTS.
8. ALL NON VMRC STREAM CROSSINGS WILL BE PERFORMED AS DESCRIBED IN THE STREAM CROSSING TABLE INCLUDED IN THIS PACKAGE.

NO.	DATE:	DWN.:	CHKD.:	APPD.:	DESCRIPTION:
5	03/04/18	KAL	RE	DW	ADDRESS VADEQ COMMENTS
4	02/27/18	KAL	RE	DW	ADDRESS VADEQ COMMENTS
3	02/05/18	KAL	RE	DW	ADDRESS VADEQ COMMENTS
2	11/21/17	KAL	RE	DW	ADDRESS VADEQ COMMENTS
1	09/21/17	KAL	RE	DW	PLAN SUBMISSION

REVISIONS:

Mountain Valley PIPELINE

EROSION AND SEDIMENT CONTROL PLANS

MOUNTAIN VALLEY PIPELINE PROJECT – H600 LINE

SPREAD 10 – FRANKLIN COUNTY, VIRGINIA

MOUNTAIN VALLEY PIPELINE, LLC
555 SOUTHPOINTE BOULEVARD, SUITE 200
CANONSBURG, PA 15317

TETRA TECH
complex world | CLEAR SOLUTIONS™
661 ANDERSEN DRIVE
FOSTER PLAZA 7
PITTSBURGH, PA 15220


EROSION AND SEDIMENT CONTROL PLANS

COMMONWEALTH OF VIRGINIA
DAVID J. WALLNER
Lic. No. 0402057593
PROFESSIONAL ENGINEER

DRAWN BY:	KAL
CHECKED BY:	RE
APPROVED BY:	DW
DATE:	03/04/2018
SCALE:	AS SHOWN
SHT. NO.	14.24ES OF 14.81ES

REVISION


TETRA TECH CAD FILE PATH: X:\CADD_Pittsburgh\EQT\7157 – MVP\15 – Franklin\E&S\ES Version 5.0.0\7157ES14.24(S10).dwg PLOTTED ON: 3/2/2018 1:28 PM PLOTTED BY: Zeigler, Justin PLOT FILE: ENVIRONMENTAL_COLOR.ctb

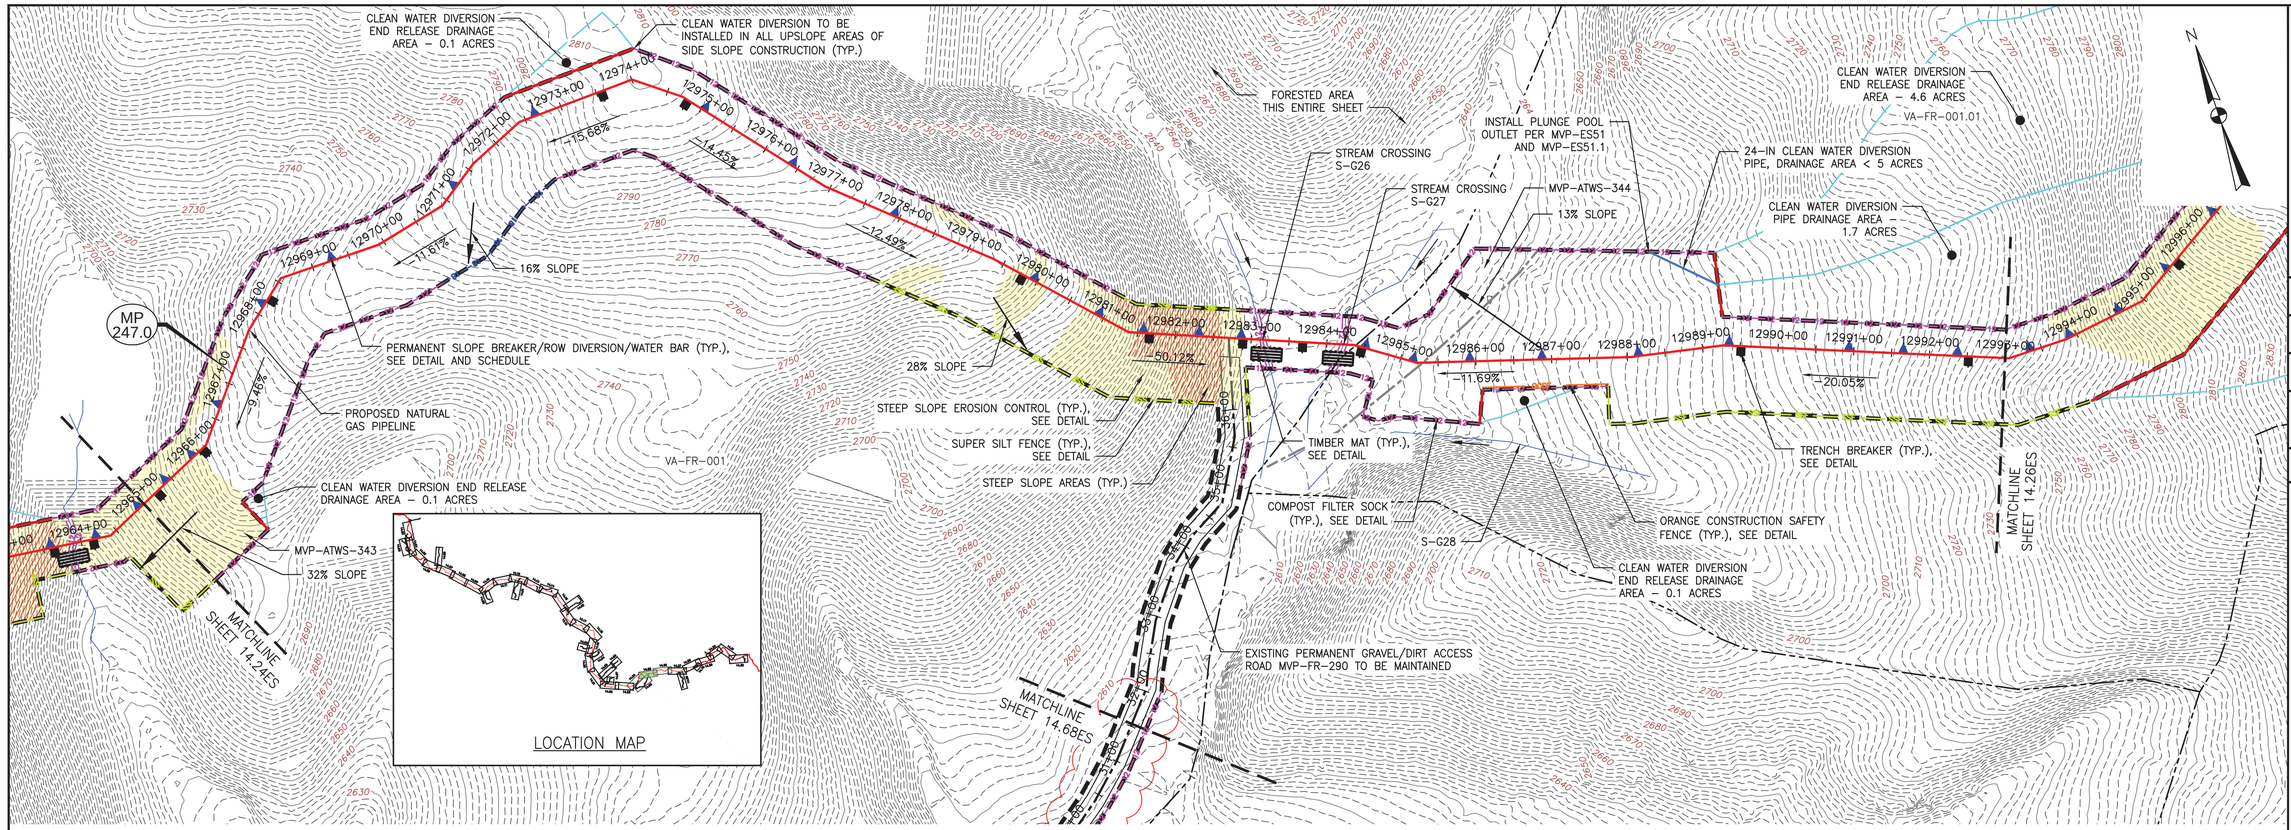

PLAN

SCALE: 1" = 100'

100 0 100 200

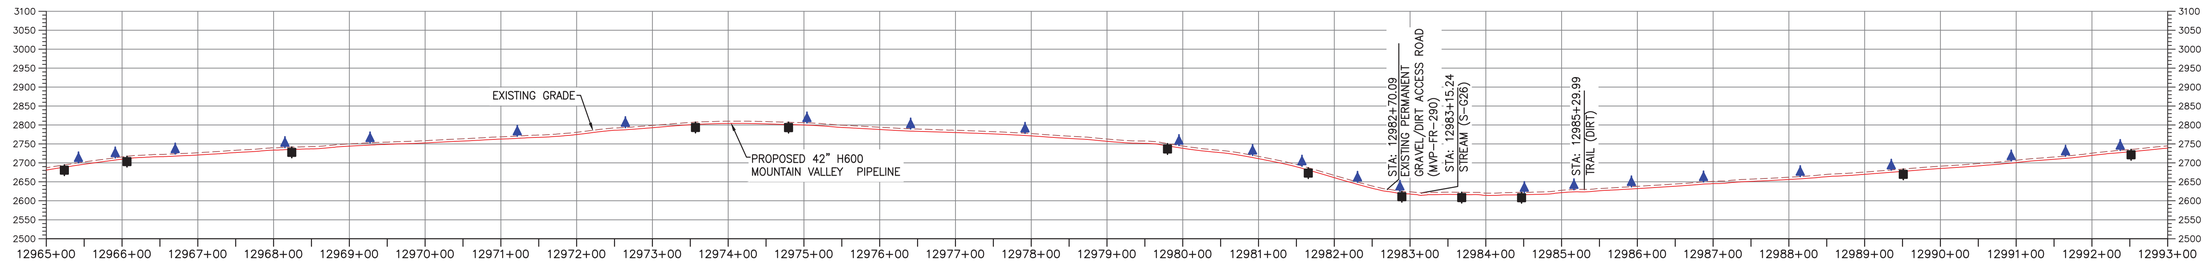

PROFILE

HORIZONTAL SCALE: SCALE: 1" = 100'

VERTICAL SCALE: SCALE: 1" = 50'

100 0 100 200 50 0 50 100

LEGEND

- PROPOSED LIMIT OF DISTURBANCE
- STREAM
- USDA FOREST SERVICE (NATIONAL FOREST) LANDS
- APPALACHIAN NATIONAL SCENIC TRAIL
- EXISTING ROAD/TRAIL
- EXISTING PROPERTY LINE
- EXISTING STATE LINE
- EXISTING COUNTY LINE
- POND
- WETLAND
- ACID FORMING MATERIAL
- AGRICULTURAL LAND USE BOUNDARY
- PROPOSED ACCESS ROAD CENTERLINE
- PROPOSED PIPELINE
- PROPOSED SILT FENCE (SEE NOTE 5)
- PROPOSED SUPER SILT FENCE (SEE DETAIL MVP–ES9.2)
- PROPOSED REINFORCED FILTRATION DEVICE (SEE DETAILS MVP–ES9, 9.1, 9.2, 9.3)
- ORANGE CONSTRUCTION SAFETY FENCE
- PROPOSED COMPOST FILTER SOCK (SEE DETAILS MVP–ES3, 3.1, 3.2)
- PROPOSED COMPOST FILTER SOCK (SEE DETAILS MVP–ES3, 3.1, 3.2)
- PROPOSED COMPOST FILTER SOCK (SEE DETAILS MVP–ES3, 3.1, 3.2)
- GRASS–LINED CHANNEL (SEE DETAIL MVP–ES39)
- CLEAN WATER DIVERSION PIPE
- CLEAN WATER DIVERSION DIKE (SEE DETAIL MVP–ES50 AND MVP–ES51)
- STREAM FLOW DIRECTION
- FEMA 100 YEAR FLOODPLAIN
- DRAINAGE AREA BOUNDARY
- TIMBER MAT (SEE DETAIL MVP–ES37)
- STEEP SLOPE EROSION CONTROL (SEE NOTE 2)
- STEEP SLOPE AREAS (SEE NOTE 4)
- PROPOSED ROCK CONSTRUCTION ENTRANCE
- PROPOSED TRENCH BREAKER (SEE DETAIL MVP–20)
- TEMPORARY ROW DIVERSION/WATER BAR (VADEQ STD & SPEC 3.11)
- PERMANENT SLOPE BREAKER/ROW DIVERSION/WATER BAR (SEE DETAILS MVP–17, ES38, AND SCHEDULE)

NOTES:

1. TOPSOIL SEGREGATION WILL BE PERFORMED IN ALL IMMEDIATE CONSTRUCTION AREAS OF THE PROJECT IN ACCORDANCE WITH DETAILS MVP–ES46.1 THROUGH MVP–ES46.3.
2. FLEXTERRA, EARTHGUARD OR EQUIVALENT MAY BE USED AS A SUBSTITUTE TO EROSION CONTROL BLANKET AS DIRECTED BY MVP.
3. CONTRACTOR IS RESPONSIBLE TO IDENTIFY ALL UTILITIES. THE UTILITY LINES SHOWN ON THE PLAN ARE FOR INFORMATIONAL PURPOSES ONLY AND DO NOT REPRESENT SURVEYED LINE INFORMATION.
4. SLOPES OF 30" OR GREATER EXIST. CONSTRUCTION FOR STEEP SLOPES TO BE PERFORMED USING STEEP SLOPE TECHNIQUES IDENTIFIED IN THE DETAIL SHEETS. ALSO REFER TO THE SITE–SPECIFIC DESIGN OF STABILIZATION MEASURES IN SELECTED HIGH–HAZARD PORTIONS OF THE ROUTE OF THE PROPOSED MOUNTAIN VALLEY PIPELINE PROJECT.
5. WHERE CONSTRUCTION CONDITIONS PRECLUDE THE USE OF DIVERSION DITCHES DUE TO SITE CONDITIONS THE CONTRACTOR WILL INSTALL SILT FENCE AT THE DIRECTION OF MVP.
6. IMPROVEMENTS TO PERMANENT AND TEMPORARY ACCESS ROADS WILL BE PERFORMED PER THE SITE SPECIFIC ACCESS ROAD DETAILS.
7. TEMPORARY ACCESS ROAD CROSSING OF STREAMS AND WETLANDS WILL UTILIZE TIMBERMATS. ANY PERMANENT ROAD CROSSINGS WILL BE CONDUCTED VIA CULVERTS.
8. ALL NON VMRC STREAM CROSSINGS WILL BE PERFORMED AS DESCRIBED IN THE STREAM CROSSING TABLE INCLUDED IN THIS PACKAGE.

NO.	DATE:	DWN.:	CHKD.:	APPD.:	DESCRIPTION:
5	03/04/18	KAL	RE	DW	ADDRESS VADEQ COMMENTS
4	02/27/18	KAL	RE	DW	ADDRESS VADEQ COMMENTS
3	02/05/18	KAL	RE	DW	ADDRESS VADEQ COMMENTS
2	11/21/17	KAL	RE	DW	ADDRESS VADEQ COMMENTS
1	09/21/17	KAL	RE	DW	PLAN SUBMISSION

REVISIONS:

Mountain Valley PIPELINE

EROSION AND SEDIMENT CONTROL PLANS

MOUNTAIN VALLEY PIPELINE PROJECT – H600 LINE

SPREAD 10 – FRANKLIN COUNTY, VIRGINIA

MOUNTAIN VALLEY PIPELINE, LLC
555 SOUTHPOINTE BOULEVARD, SUITE 200
CANONSBURG, PA 15317

TETRA TECH
complex world | CLEAR SOLUTIONS™
661 ANDERSEN DRIVE
FOSTER PLAZA 7
PITTSBURGH, PA 15220


EROSION AND SEDIMENT CONTROL PLANS

COMMONWEALTH OF VIRGINIA
DAVID J. WALLNER
Lic. No. 0402057593
PROFESSIONAL ENGINEER

DRAWN BY:	KAL
CHECKED BY:	RE
APPROVED BY:	DW
DATE:	03/04/2018
SCALE:	AS SHOWN
SHT. NO.	14.25ES OF 14.81ES

REVISION


TETRA TECH CAD FILE PATH: X:\CADD_Pittsburgh\EQT\7157 – MVP\15 – Franklin\E&S\ES Version 5.0.0\7157ES14.25(S10).dwg PLOTTED ON: 3/2/2018 1:34 PM PLOTTED BY: Zeigler, Justin PLOT FILE: ENVIRONMENTAL_COLOR.ctb

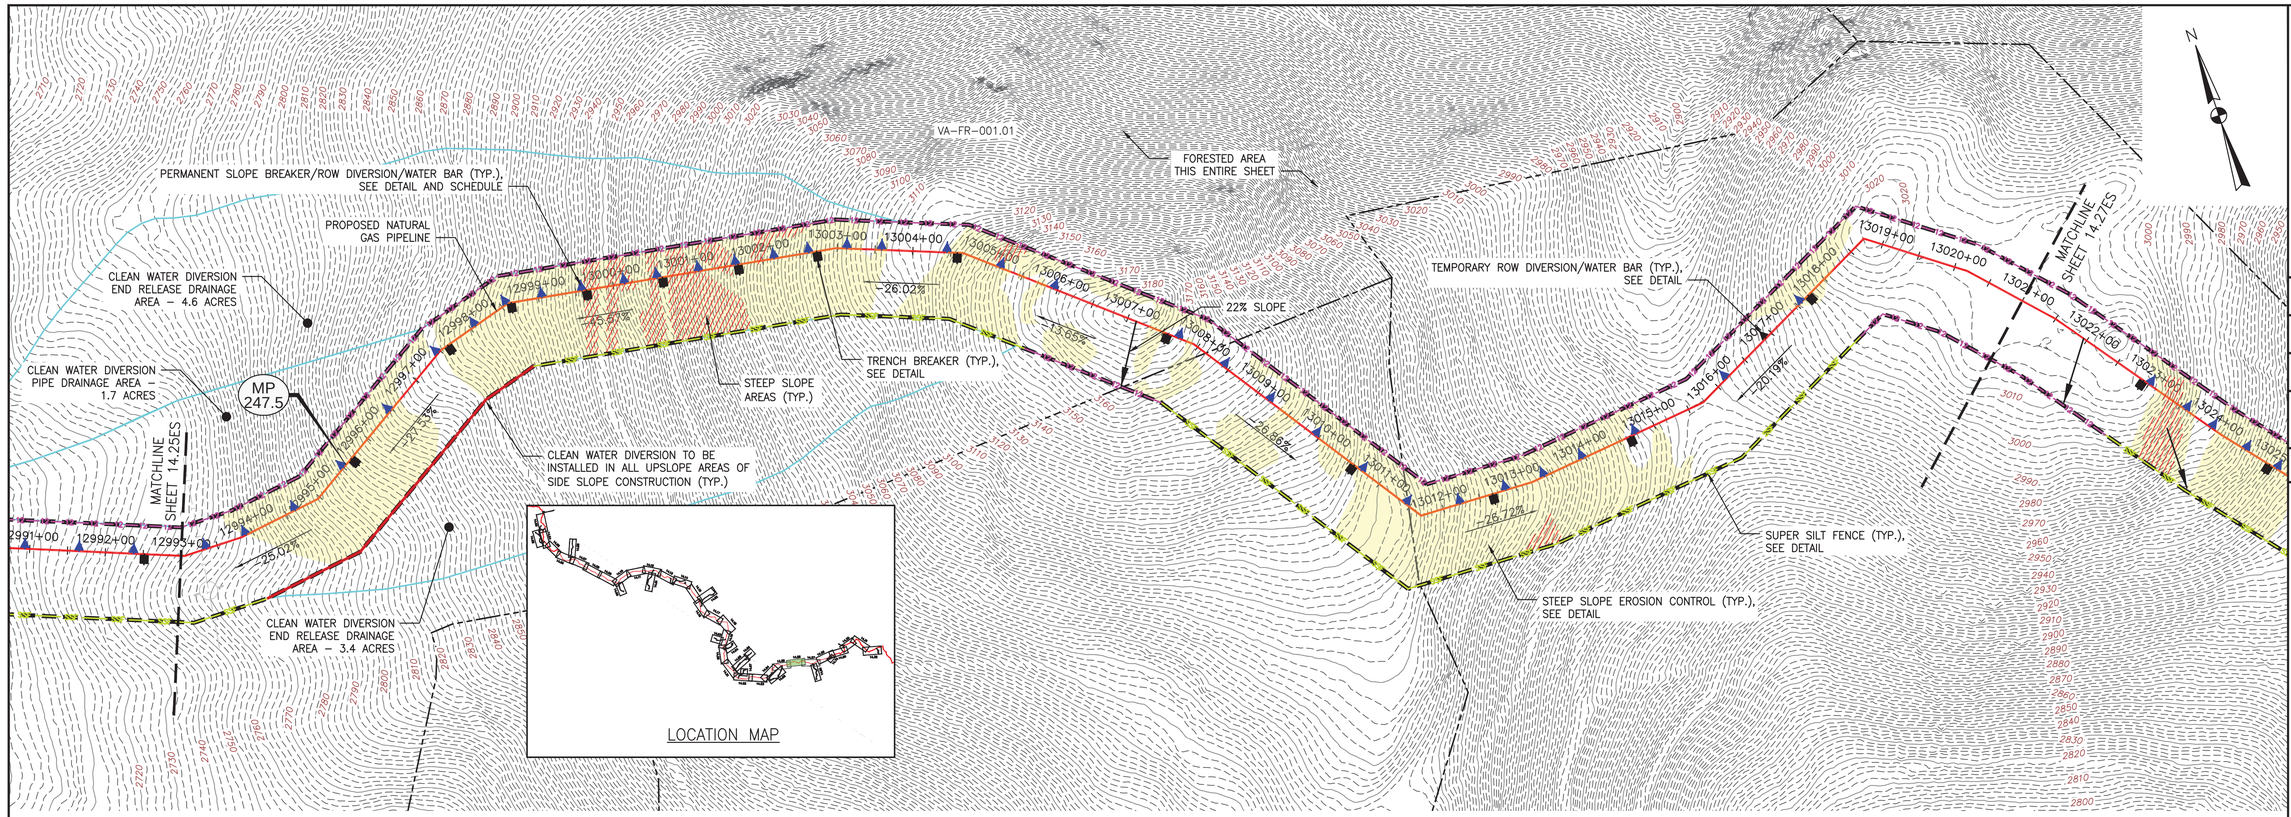

PLAN

SCALE: 1" = 100'

100 0 100 200

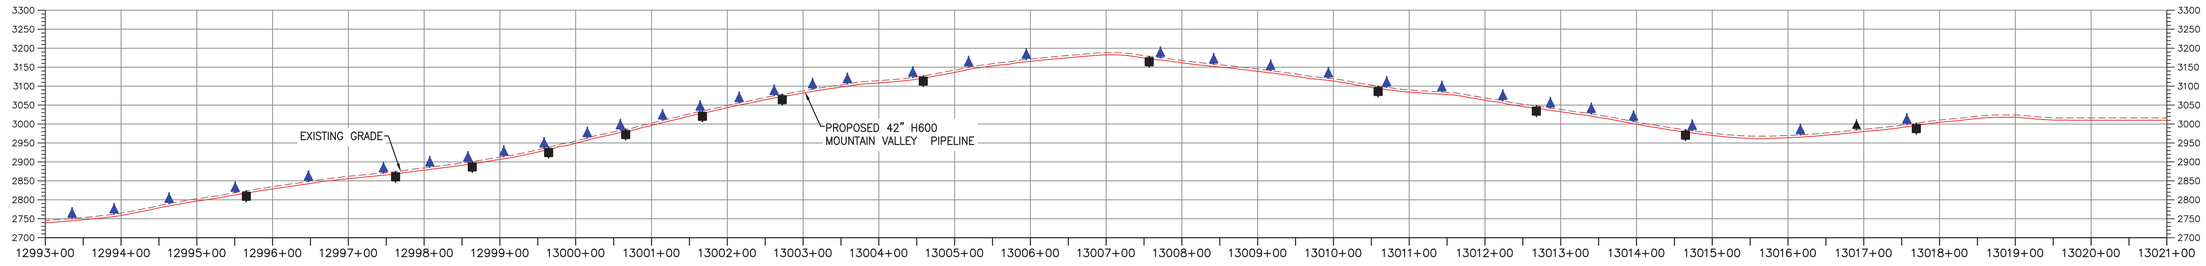

PROFILE

HORIZONTAL SCALE: SCALE: 1" = 100'

VERTICAL SCALE: SCALE: 1" = 200'

100 0 100 200 0 200 400

LEGEND

- PROPOSED LIMIT OF DISTURBANCE
- STREAM
- USDA FOREST SERVICE (NATIONAL FOREST) LANDS
- APPALACHIAN NATIONAL SCENIC TRAIL
- EXISTING ROAD/TRAIL
- EXISTING PROPERTY LINE
- EXISTING STATE LINE
- EXISTING COUNTY LINE
- POND
- WETLAND
- ACID FORMING MATERIAL
- AGRICULTURAL LAND USE BOUNDARY
- PROPOSED ACCESS ROAD CENTERLINE
- PROPOSED PIPELINE
- PROPOSED SILT FENCE (SEE NOTE 5)
- PROPOSED SUPER SILT FENCE (SEE DETAIL MVP-ES9.2)
- PROPOSED REINFORCED FILTRATION DEVICE (SEE DETAILS MVP-ES9, 9.1, 9.2, 9.3)
- ORANGE CONSTRUCTION SAFETY FENCE
- PROPOSED COMPOST FILTER SOCK (SEE DETAILS MVP-ES3, 3.1, 3.2)
- PROPOSED COMPOST FILTER SOCK (SEE DETAILS MVP-ES3, 3.1, 3.2)
- PROPOSED COMPOST FILTER SOCK (SEE DETAILS MVP-ES3, 3.1, 3.2)
- GRASS-LINED CHANNEL (SEE DETAIL MVP-ES39)
- CLEAN WATER DIVERSION PIPE
- CLEAN WATER DIVERSION DIKE (SEE DETAIL MVP-ES50 AND MVP-ES51)
- STREAM FLOW DIRECTION
- FEMA 100 YEAR FLOODPLAIN
- DRAINAGE AREA BOUNDARY
- TIMBER MAT (SEE DETAIL MVP-ES37)
- STEEP SLOPE EROSION CONTROL (SEE NOTE 2)
- STEEP SLOPE AREAS (SEE NOTE 4)
- PROPOSED ROCK CONSTRUCTION ENTRANCE
- PROPOSED TRENCH BREAKER (SEE DETAIL MVP-20)
- TEMPORARY ROW DIVERSION/WATER BAR (VADEQ STD & SPEC 3.11)
- PERMANENT SLOPE BREAKER/ROW DIVERSION/WATER BAR (SEE DETAILS MVP-17, ES38, AND SCHEDULE)

NOTES:

1. TOPSOIL SEGREGATION WILL BE PERFORMED IN ALL IMMEDIATE CONSTRUCTION AREAS OF THE PROJECT IN ACCORDANCE WITH DETAILS MVP-ES46.1 THROUGH MVP-ES46.3.
2. FLEXTERRA, EARTHGUARD OR EQUIVALENT MAY BE USED AS A SUBSTITUTE TO EROSION CONTROL BLANKET AS DIRECTED BY MVP.
3. CONTRACTOR IS RESPONSIBLE TO IDENTIFY ALL UTILITIES. THE UTILITY LINES SHOWN ON THE PLAN ARE FOR INFORMATIONAL PURPOSES ONLY AND DO NOT REPRESENT SURVEYED LINE INFORMATION.
4. SLOPES OF 30% OR GREATER EXIST. CONSTRUCTION FOR STEEP SLOPES TO BE PERFORMED USING STEEP SLOPE TECHNIQUES IDENTIFIED IN THE DETAIL SHEETS. ALSO REFER TO THE SITE-SPECIFIC DESIGN OF STABILIZATION MEASURES IN SELECTED HIGH-HAZARD PORTIONS OF THE ROUTE OF THE PROPOSED MOUNTAIN VALLEY PIPELINE PROJECT.
5. WHERE CONSTRUCTION CONDITIONS PRECLUDE THE USE OF DIVERSION DITCHES DUE TO SITE CONDITIONS THE CONTRACTOR WILL INSTALL SILT FENCE AT THE DIRECTION OF MVP.
6. IMPROVEMENTS TO PERMANENT AND TEMPORARY ACCESS ROADS WILL BE PERFORMED PER THE SITE SPECIFIC ACCESS ROAD DETAILS.
7. TEMPORARY ACCESS ROAD CROSSING OF STREAMS AND WETLANDS WILL UTILIZE TIMBERMATS. ANY PERMANENT ROAD CROSSINGS WILL BE CONDUCTED VIA CULVERTS.
8. ALL NON VMRC STREAM CROSSINGS WILL BE PERFORMED AS DESCRIBED IN THE STREAM CROSSING TABLE INCLUDED IN THIS PACKAGE.

NO.	DATE:	DWN.:	CHKD.:	APPD.:	DESCRIPTION:
5	03/04/18	KAL	RE	DW	ADDRESS VADEQ COMMENTS
4	02/27/18	KAL	RE	DW	ADDRESS VADEQ COMMENTS
3	02/05/18	KAL	RE	DW	ADDRESS VADEQ COMMENTS
2	11/21/17	KAL	RE	DW	ADDRESS VADEQ COMMENTS
1	09/21/17	KAL	RE	DW	PLAN SUBMISSION

REVISIONS:

Mountain Valley PIPELINE

EROSION AND SEDIMENT CONTROL PLANS

MOUNTAIN VALLEY PIPELINE PROJECT – H600 LINE

SPREAD 10 – FRANKLIN COUNTY, VIRGINIA

MOUNTAIN VALLEY PIPELINE, LLC
555 SOUTHPOINTE BOULEVARD, SUITE 200
CANONSBURG, PA 15317

TETRA TECH
complex world | CLEAR SOLUTIONS™
661 ANDERSEN DRIVE
FOSTER PLAZA 7
PITTSBURGH, PA 15220


EROSION AND SEDIMENT CONTROL PLANS


COMMONWEALTH OF VIRGINIA
DAVID J. WALLNER
Lic. No. 0402057593
PROFESSIONAL ENGINEER

DRAWN BY:	KAL
CHECKED BY:	RE
APPROVED BY:	DW
DATE:	03/04/2018
SCALE:	AS SHOWN
SHT. NO.	14.26ES OF 14.81ES

REVISION

TETRA TECH CAD FILE PATH: X:\CADD_Pittsburgh\EQT\7157 – MVP\15 – Franklin\E&S\ES Version 5.0.0\7157ES14.26(S10).dwg PLOTTED ON: 3/2/2018 1:40 PM PLOTTED BY: Zeigler, Justin PLOT FILE: ENVIRONMENTAL_COLOR.ctb

 


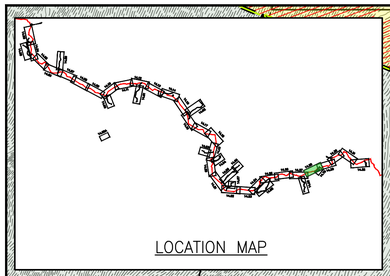

PLAN

SCALE: 1" = 100'

100 0 100 200

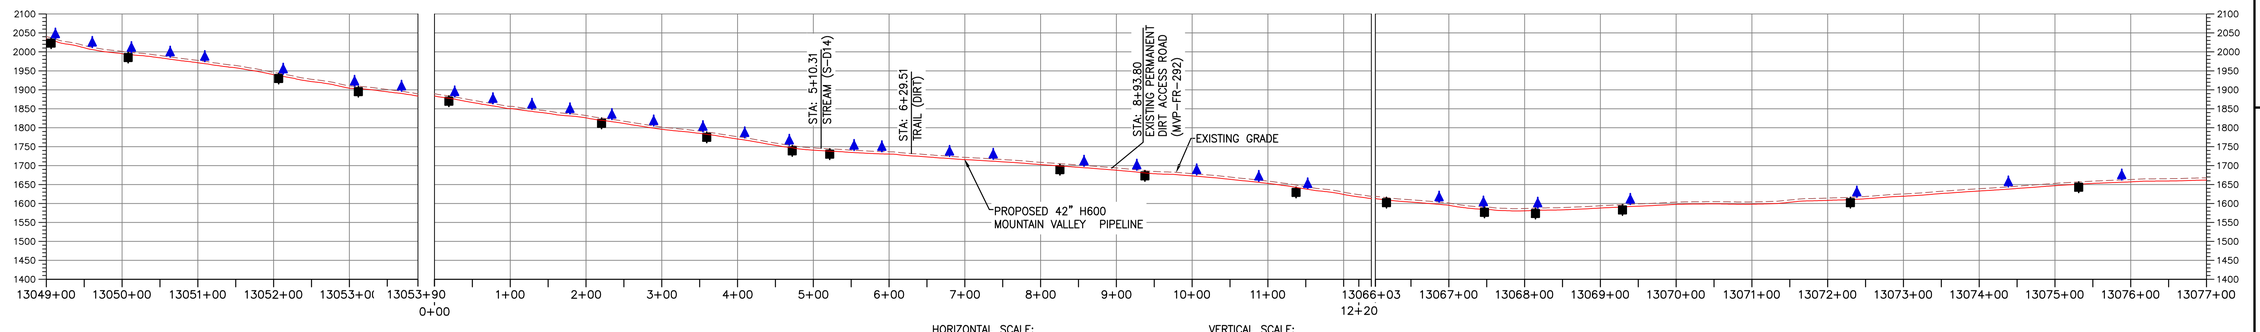

PROFILE

HORIZONTAL SCALE: SCALE: 1" = 100'

VERTICAL SCALE: SCALE: 1" = 200'

100 0 100 200 200 0 200 400

LEGEND

- PROPOSED LIMIT OF DISTURBANCE
- STREAM
- USDA FOREST SERVICE (NATIONAL FOREST) LANDS
- APPALACHIAN NATIONAL SCENIC TRAIL
- EXISTING ROAD/TRAIL
- EXISTING PROPERTY LINE
- EXISTING STATE LINE
- EXISTING COUNTY LINE
- POND
- WETLAND
- ACID FORMING MATERIAL
- EXISTING FOREST
- PROPOSED ACCESS ROAD CENTERLINE
- PROPOSED PIPELINE
- PROPOSED SILT FENCE (SEE NOTE 5)
- PROPOSED SUPER SILT FENCE (SEE DETAIL MVP–ES9.2)
- PROPOSED REINFORCED FILTRATION DEVICE (SEE DETAILS MVP–ES9, 9.1, 9.2, 9.3)
- ORANGE CONSTRUCTION SAFETY FENCE
- PROPOSED COMPOST FILTER SOCK (SEE DETAILS MVP–ES3, 3.1, 3.2)
- PROPOSED COMPOST FILTER SOCK (SEE DETAILS MVP–ES3, 3.1, 3.2)
- PROPOSED COMPOST FILTER SOCK (SEE DETAILS MVP–ES3, 3.1, 3.2)
- GRASS–LINED CHANNEL (SEE DETAIL MVP–ES39)
- CLEAN WATER DIVERSION PIPE
- CLEAN WATER DIVERSION DIKE (SEE DETAIL MVP–ES50 AND MVP–ES51)
- STREAM FLOW DIRECTION
- FEMA 100 YEAR FLOODPLAIN
- DRAINAGE AREA BOUNDARY
- TIMBER MAT (SEE DETAIL MVP–ES37)
- STEEP SLOPE EROSION CONTROL (SEE NOTE 2)
- STEEP SLOPE AREAS (SEE NOTE 4)
- PROPOSED ROCK CONSTRUCTION ENTRANCE
- PROPOSED TRENCH BREAKER (SEE DETAIL MVP–20)
- TEMPORARY ROW DIVERSION/WATER BAR (SEE DETAIL MVP–17)
- PERMANENT SLOPE BREAKER/ROW DIVERSION/WATER BAR (SEE DETAIL MVP–17)

COMMONWEALTH OF VIRGINIA
10/18/23
DANIEL C. WITT
Lic. No. 65093
PROFESSIONAL ENGINEER

THIS SEAL APPLIES ONLY TO REVISIONS DATED 10–16–23

NOTES:

1. TOPSOIL SEGREGATION WILL BE PERFORMED IN ALL IMMEDIATE CONSTRUCTION AREAS OF THE PROJECT IN ACCORDANCE WITH DETAILS MVP–ES46.1 THROUGH MVP–ES46.3.
2. FLEXTERRA, EARTHGUARD OR EQUIVALENT MAY BE USED AS A SUBSTITUTE TO EROSION CONTROL BLANKET AS DIRECTED BY MVP.
3. CONTRACTOR IS RESPONSIBLE TO IDENTIFY ALL UTILITIES. THE UTILITY LINES SHOWN ON THE PLAN ARE FOR INFORMATIONAL PURPOSES ONLY AND DO NOT REPRESENT SURVEYED LINE INFORMATION.
4. SLOPES OF 30' OR GREATER EXIST. CONSTRUCTION FOR STEEP SLOPES TO BE PERFORMED USING STEEP SLOPE TECHNIQUES IDENTIFIED IN THE DETAIL SHEETS. ALSO REFER TO THE SITE–SPECIFIC DESIGN OF STABILIZATION MEASURES IN SELECTED HIGH–HAZARD PORTIONS OF THE ROUTE OF THE PROPOSED MOUNTAIN VALLEY PIPELINE PROJECT.
5. WHERE CONSTRUCTION CONDITIONS PRECLUDE THE USE OF DIVERSION DITCHES DUE TO SITE CONDITIONS THE CONTRACTOR WILL INSTALL SILT FENCE AT THE DIRECTION OF MVP.
6. IMPROVEMENTS TO PERMANENT AND TEMPORARY ACCESS ROADS WILL BE PERFORMED PER THE SITE SPECIFIC ACCESS ROAD DETAILS.
7. TEMPORARY ACCESS ROAD CROSSING OF STREAMS AND WETLANDS WILL UTILIZE TIMBERMATS. ANY PERMANENT ROAD CROSSINGS WILL BE CONDUCTED VIA CULVERTS.
8. ALL NON VMRC STREAM CROSSINGS WILL BE PERFORMED AS DESCRIBED IN THE STREAM CROSSING TABLE INCLUDED IN THIS PACKAGE.

NO.:	DATE:	DWN.:	CHKD.:	APPD.:	DESCRIPTION:
–	04/07/23	JJZ	TD	DCW	ADJUST PIPELINE CENTERLINE
–	02/01/23	JJZ	RE	DW	ADDRESS VARIOUS COMMENTS ON CROSSING METHOD CHANGE
–	05/12/21	JJZ	RE	DW	CROSSING METHOD CHANGE FROM OPEN CUT TO BORE
–	05/05/21	JJZ	RE	DW	STREAM S–D14 REVISED TO MERGE WITH STREAM S–D17 PER USACE FIELD VISIT
8	08/03/18	JJZ	RE	DW	FIELD MODIFICATION
7	06/22/18	JJZ	RE	DW	FIELD MODIFICATION

REVISIONS:

Mountain Valley PIPELINE

EROSION AND SEDIMENT CONTROL PLANS

MOUNTAIN VALLEY PIPELINE PROJECT – H600 LINE

SPREAD 10 – FRANKLIN COUNTY, VIRGINIA

MOUNTAIN VALLEY PIPELINE, LLC
2200 ENERGY DRIVE
CANONSBURG, PA 15317

TETRA TECH
complex world | CLEAR SOLUTIONS™
661 ANDERSEN DRIVE
FOSTER PLAZA 7
PITTSBURGH, PA 15220


EROSION AND SEDIMENT CONTROL PLANS

COMMONWEALTH OF VIRGINIA
David J. Wallner
DAVID J. WALLNER
Lic. No. 57593
10/12/2023
PROFESSIONAL ENGINEER

DRAWN BY:	JJZ
CHECKED BY:	IHH
APPROVED BY:	DCW
DATE:	10/16/2023
SCALE:	AS SHOWN
REVISION	–

SHT. NO. 14.28ES OF 14.81ES


TETRA TECH CAD FILE PATH: X:\CADD_Pittsburgh\EQT\7157 – MVP\15 – Franklin\E&S\ES Version 5.0.0\7157ES14.28(S10).dwg PLOTTED ON: 10/12/2023 12:02 PM PLOTTED BY: Zeigler, Justin PLOT FILE: ENVIRONMENTAL_COLOR.ctb

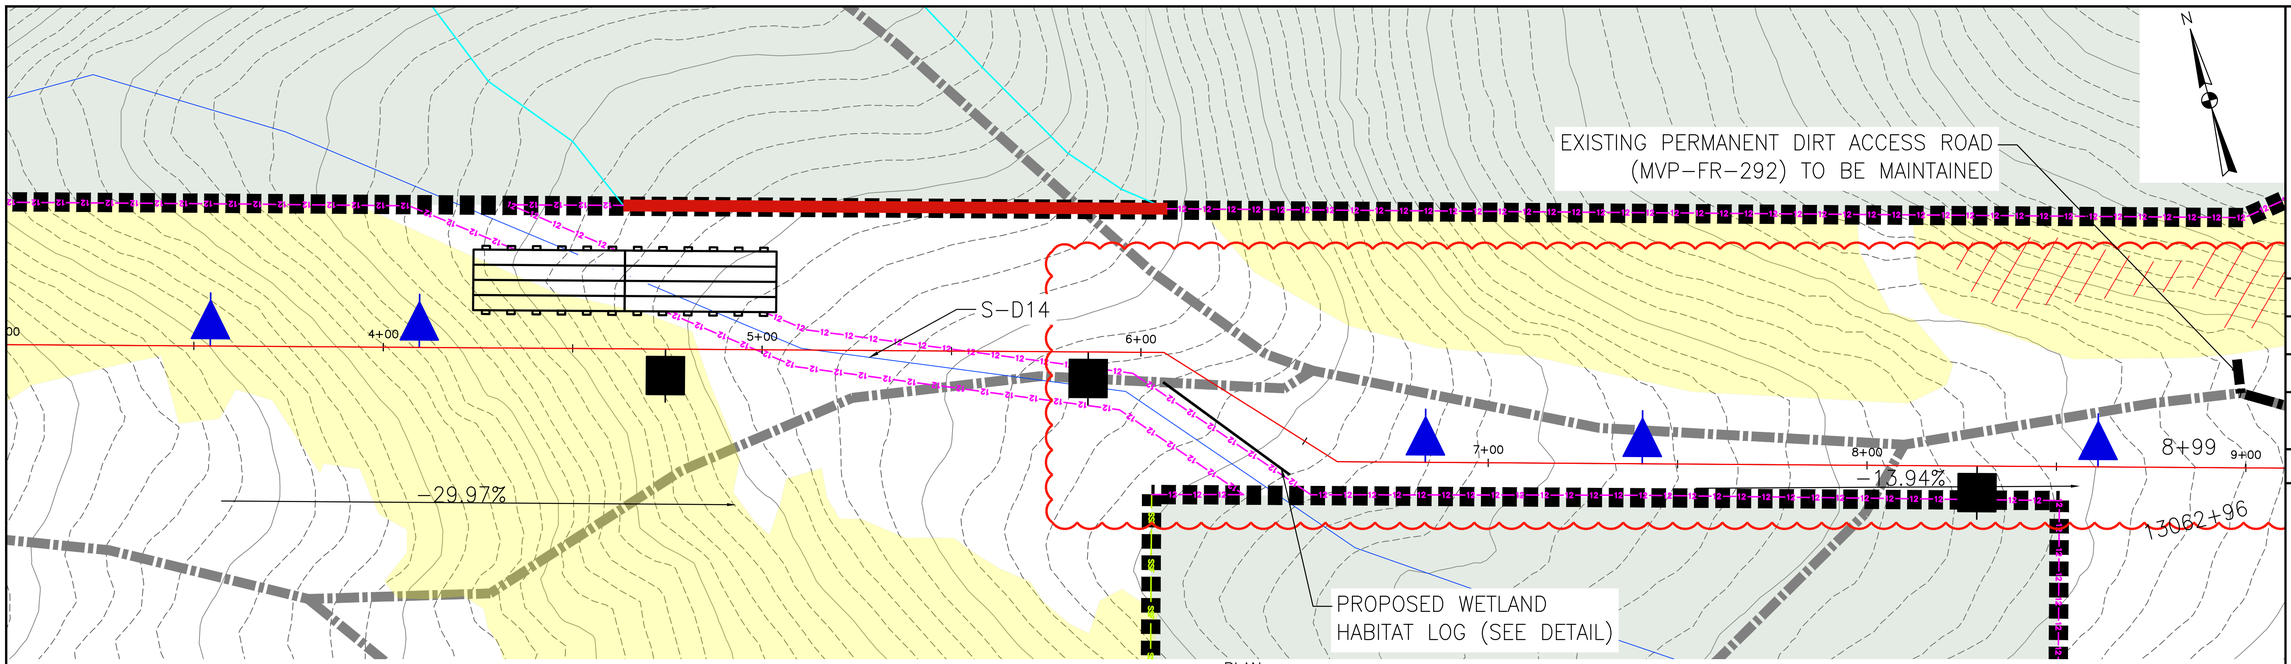

PLAN

SCALE: 1" = 30'

30 0 30 60

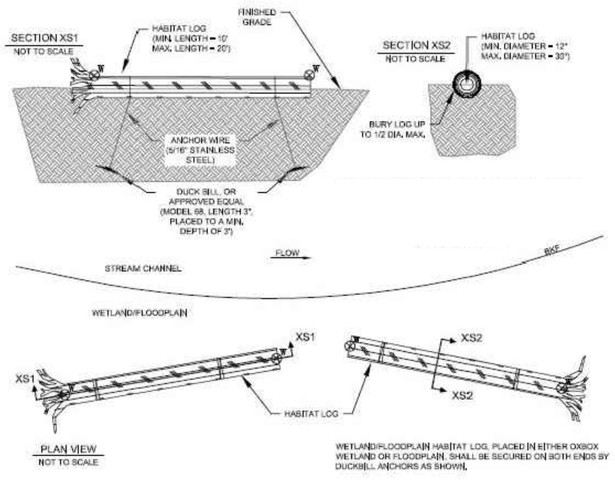

WETLAND/FLOODPLAIN HABITAT LOG

NOT TO SCALE

LEGEND

- PROPOSED LIMIT OF DISTURBANCE
- STREAM
- USDA FOREST SERVICE (NATIONAL FOREST) LANDS
- APPALACHIAN NATIONAL SCENIC TRAIL
- EXISTING ROAD/TRAIL
- EXISTING PROPERTY LINE
- EXISTING STATE LINE
- EXISTING COUNTY LINE
- POND
- WETLAND
- ACID FORMING MATERIAL
- EXISTING FOREST
- PROPOSED ACCESS ROAD CENTERLINE
- PROPOSED PIPELINE
- PROPOSED SILT FENCE (SEE NOTE 5)
- PROPOSED SUPER SILT FENCE (SEE DETAIL MVP-ES9.2)
- PROPOSED REINFORCED FILTRATION DEVICE (SEE DETAILS MVP-ES9, 9.1, 9.2, 9.3)
- ORANGE CONSTRUCTION SAFETY FENCE
- PROPOSED COMPOST FILTER SOCK (SEE DETAILS MVP-ES3, 3.1, 3.2)
- PROPOSED COMPOST FILTER SOCK (SEE DETAILS MVP-ES3, 3.1, 3.2)
- PROPOSED COMPOST FILTER SOCK (SEE DETAILS MVP-ES3, 3.1, 3.2)
- GRASS-LINED CHANNEL (SEE DETAIL MVP-ES39)
- CLEAN WATER DIVERSION PIPE
- CLEAN WATER DIVERSION DIKE (SEE DETAIL MVP-ES50 AND MVP-ES51)
- STREAM FLOW DIRECTION
- FEMA 100 YEAR FLOODPLAIN
- DRAINAGE AREA BOUNDARY
- TIMBER MAT (SEE DETAIL MVP-ES37)
- STEEP SLOPE EROSION CONTROL (SEE NOTE 2)
- STEEP SLOPE AREAS (SEE NOTE 4)
- PROPOSED ROCK CONSTRUCTION ENTRANCE
- PROPOSED TRENCH BREAKER (SEE DETAIL MVP-20)
- TEMPORARY ROW DIVERSION/WATER BAR (SEE DETAIL MVP-17)
- PERMANENT SLOPE BREAKER/ROW DIVERSION/WATER BAR (SEE DETAIL MVP-17)

COMMONWEALTH OF VIRGINIA
10/19/23
DANIEL C. WITT
Lic. No. 65093
PROFESSIONAL ENGINEER

THIS SEAL APPLIES ONLY TO REVISIONS DATED 10-09-23

NOTES:

1. TOPSOIL SEGREGATION WILL BE PERFORMED IN ALL IMMEDIATE CONSTRUCTION AREAS OF THE PROJECT IN ACCORDANCE WITH DETAILS MVP-ES46.1 THROUGH MVP-ES46.3.
2. FLEXTERRA, EARTHGUARD OR EQUIVALENT MAY BE USED AS A SUBSTITUTE TO EROSION CONTROL BLANKET AS DIRECTED BY MVP.
3. CONTRACTOR IS RESPONSIBLE TO IDENTIFY ALL UTILITIES. THE UTILITY LINES SHOWN ON THE PLAN ARE FOR INFORMATIONAL PURPOSES ONLY AND DO NOT REPRESENT SURVEYED LINE INFORMATION.
4. SLOPES OF 30" OR GREATER EXIST. CONSTRUCTION FOR STEEP SLOPES TO BE PERFORMED USING STEEP SLOPE TECHNIQUES IDENTIFIED IN THE DETAIL SHEETS. ALSO REFER TO THE SITE-SPECIFIC DESIGN OF STABILIZATION MEASURES IN SELECTED HIGH-HAZARD PORTIONS OF THE ROUTE OF THE PROPOSED MOUNTAIN VALLEY PIPLELINE PROJECT.
5. WHERE CONSTRUCTION CONDITIONS PRECLUDE THE USE OF DIVERSION DITCHES DUE TO SITE CONDITIONS THE CONTRACTOR WILL INSTALL SILT FENCE AT THE DIRECTION OF MVP.
6. IMPROVEMENTS TO PERMANENT AND TEMPORARY ACCESS ROADS WILL BE PERFORMED PER THE SITE SPECIFIC ACCESS ROAD DETAILS.
7. TEMPORARY ACCESS ROAD CROSSING OF STREAMS AND WETLANDS WILL UTILIZE TIMBERMATS. ANY PERMANENT ROAD CROSSINGS WILL BE CONDUCTED VIA CULVERTS.
8. ALL NON VMRC STREAM CROSSINGS WILL BE PERFORMED AS DESCRIBED IN THE STREAM CROSSING TABLE INCLUDED IN THIS PACKAGE.

REVISIONS:

NO.:	DATE:	DWN.:	CHKD.:	APPD.:	DESCRIPTION:
–	10/09/23	JJZ	IHH	DCW	ADJUST PIPELINE CENTERLINE
–	09/28/22	AJP	DCW	TD	CENTERLINE AND PERMANENT EASEMENT SHIFT
–	05/12/21	JJZ	RE	DW	STREAM S-D14 REVISED TO MORE WITH STREAM S-D17 PER USACE FIELD VISIT

Mountain Valley PIPELINE

EROSION AND SEDIMENT CONTROL PLANS

MOUNTAIN VALLEY PIPELINE PROJECT – H600 LINE

SPREAD 10 – FRANKLIN COUNTY, VIRGINIA

MOUNTAIN VALLEY PIPELINE, LLC
2200 ENERGY DRIVE
CANONSBURG, PA 15317

TETRA TECH
complex world | CLEAR SOLUTIONS™
661 ANDERSEN DRIVE
FOSTER PLAZA 7
PITTSBURGH, PA 15220


EROSION AND SEDIMENT CONTROL PLANS

COMMONWEALTH OF VIRGINIA
DAVID J. WALLNER
Lic. No. 57593
PROFESSIONAL ENGINEER
12/12/2021

DRAWN BY:	JJZ
CHECKED BY:	IHH
APPROVED BY:	DCW
DATE:	10/09/23
SCALE:	AS SHOWN
REVISION	1

SHT. NO. 14.28AES OF 14.81ES

TETRA TECH CAD FILE PATH: X:\CADD_Pittsburgh\EGT\7157 – MVP\15 – Franklin\E&S\ES Version 5.0.0\7157ES14.28AS10).dwg PLOTTED ON: 10/19/2023 3:00 PM PLOTTED BY: Zeigler, Justin PLOT FILE: ENVIRONMENTAL_COLOR.ctb

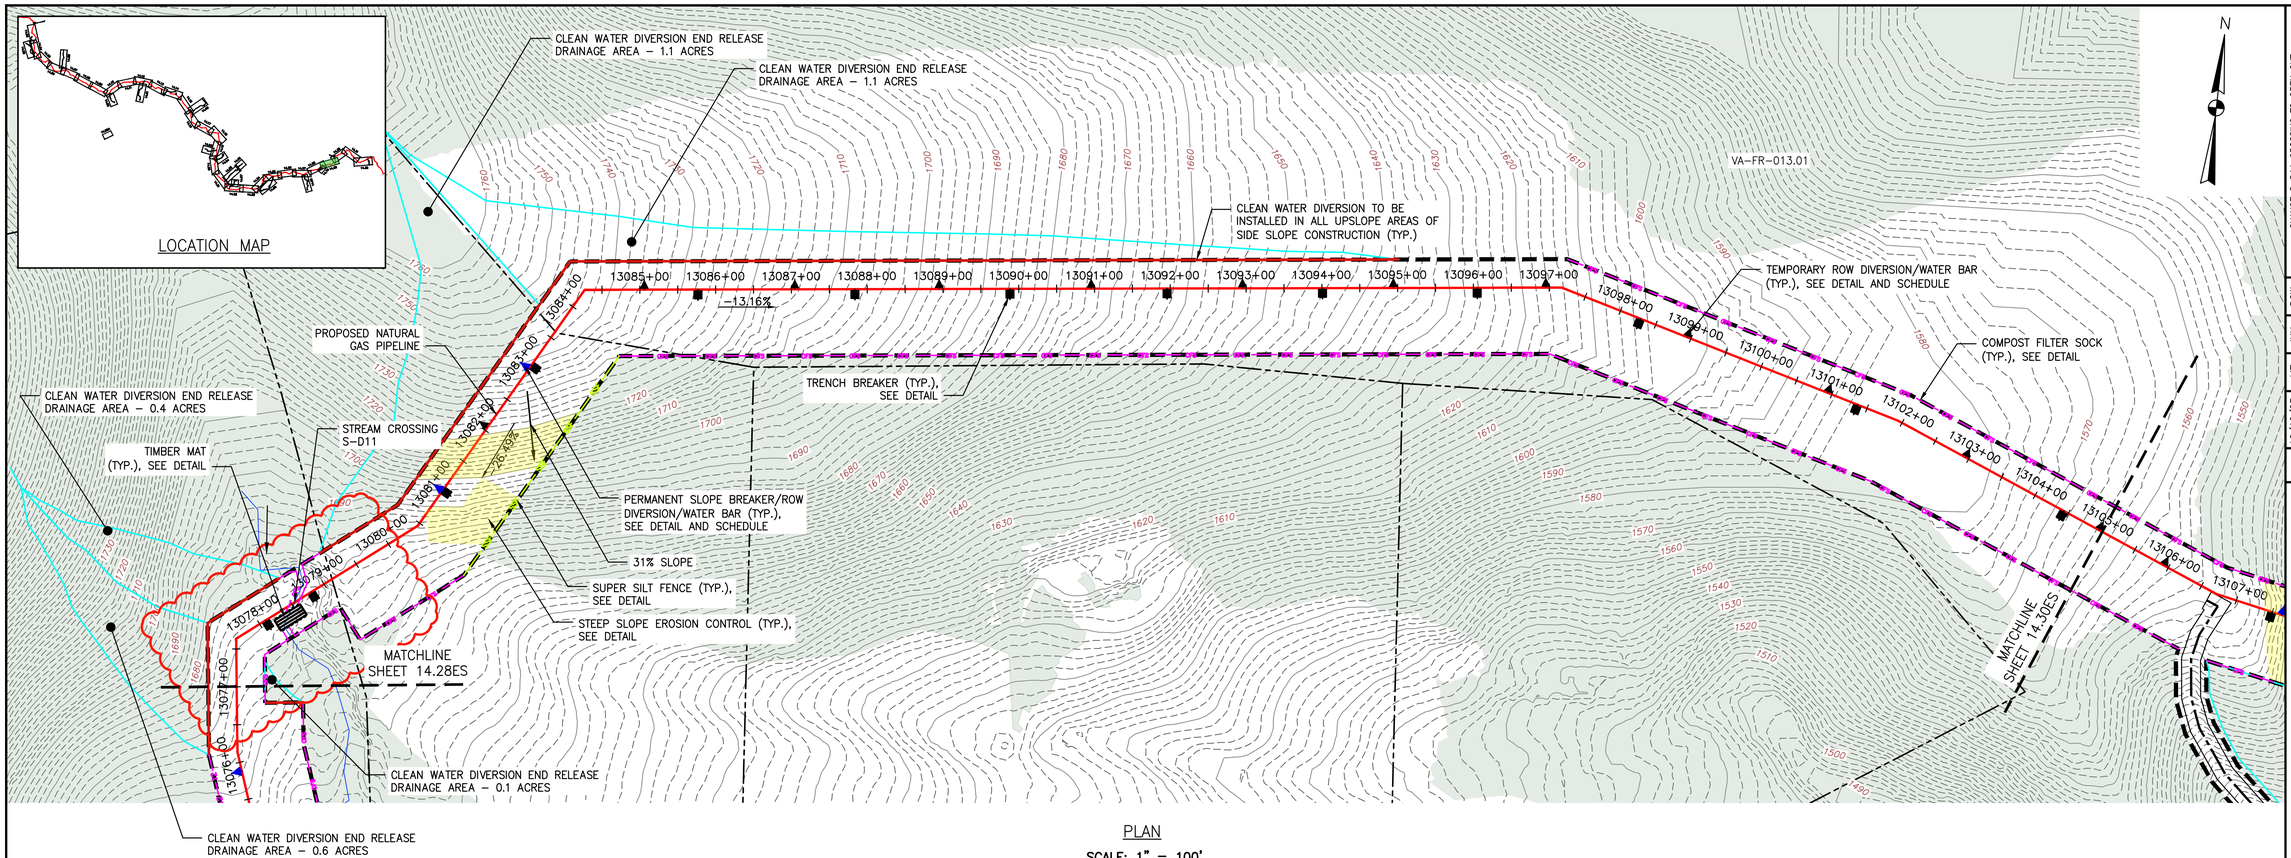

LEGEND

- PROPOSED LIMIT OF DISTURBANCE
- STREAM
- USDA FOREST SERVICE (NATIONAL FOREST) LANDS
- APPALACHIAN NATIONAL SCENIC TRAIL
- EXISTING ROAD/TRAIL
- EXISTING PROPERTY LINE
- EXISTING STATE LINE
- EXISTING COUNTY LINE
- POND
- WETLAND
- ACID FORMING MATERIAL
- EXISTING FOREST
- PROPOSED ACCESS ROAD CENTERLINE
- PROPOSED PIPELINE
- PROPOSED SILT FENCE (SEE NOTE 5)
- PROPOSED SUPER SILT FENCE (SEE DETAIL MVP–ES9.2)
- PROPOSED REINFORCED FILTRATION DEVICE (SEE DETAILS MVP–ES9, 9.1, 9.2, 9.3)
- ORANGE CONSTRUCTION SAFETY FENCE
- PROPOSED COMPOST FILTER SOCK (SEE DETAILS MVP–ES3, 3.1, 3.2)
- PROPOSED COMPOST FILTER SOCK (SEE DETAILS MVP–ES3, 3.1, 3.2)
- PROPOSED COMPOST FILTER SOCK (SEE DETAILS MVP–ES3, 3.1, 3.2)
- GRASS–LINED CHANNEL (SEE DETAIL MVP–ES39)
- CLEAN WATER DIVERSION PIPE
- CLEAN WATER DIVERSION DIKE (SEE DETAIL MVP–ES50 AND MVP–ES51)
- STREAM FLOW DIRECTION
- FEMA 100 YEAR FLOODPLAIN
- DRAINAGE AREA BOUNDARY
- TIMBER MAT (SEE DETAIL MVP–ES37)
- STEEP SLOPE EROSION CONTROL (SEE NOTE 2)
- STEEP SLOPE AREAS (SEE NOTE 4)
- PROPOSED ROCK CONSTRUCTION ENTRANCE
- PROPOSED TRENCH BREAKER (SEE DETAIL MVP–20)
- TEMPORARY ROW DIVERSION/WATER BAR (SEE DETAIL MVP–17)
- PERMANENT SLOPE BREAKER/ROW DIVERSION/WATER BAR (SEE DETAIL MVP–17)

COMMONWEALTH OF VIRGINIA
10/12/23
DANIEL C. WITT
Lic. No. 65093
PROFESSIONAL ENGINEER

THIS SEAL APPLIES ONLY TO REVISIONS DATED 10–12–2023

NOTES:

1. TOPSOIL SEGREGATION WILL BE PERFORMED IN ALL IMMEDIATE CONSTRUCTION AREAS OF THE PROJECT IN ACCORDANCE WITH DETAILS MVP–ES46.1 THROUGH MVP–ES46.3.
2. FLEXTERRA, EARTHGUARD OR EQUIVALENT MAY BE USED AS A SUBSTITUTE TO EROSION CONTROL BLANKET AS DIRECTED BY MVP.
3. CONTRACTOR IS RESPONSIBLE TO IDENTIFY ALL UTILITIES. THE UTILITY LINES SHOWN ON THE PLAN ARE FOR INFORMATIONAL PURPOSES ONLY AND DO NOT REPRESENT SURVEYED LINE INFORMATION.
4. SLOPES OF 30° OR GREATER EXIST. CONSTRUCTION FOR STEEP SLOPES TO BE PERFORMED USING STEEP SLOPE TECHNIQUES IDENTIFIED IN THE DETAIL SHEETS. ALSO REFER TO THE SITE–SPECIFIC DESIGN OF STABILIZATION MEASURES IN SELECTED HIGH–HAZARD PORTIONS OF THE ROUTE OF THE PROPOSED MOUNTAIN VALLEY PIPLELINE PROJECT.
5. WHERE CONSTRUCTION CONDITIONS PRECLUDE THE USE OF DIVERSION DITCHES DUE TO SITE CONDITIONS THE CONTRACTOR WILL INSTALL SILT FENCE AT THE DIRECTION OF MVP.
6. IMPROVEMENTS TO PERMANENT AND TEMPORARY ACCESS ROADS WILL BE PERFORMED PER THE SITE SPECIFIC ACCESS ROAD DETAILS.
7. TEMPORARY ACCESS ROAD CROSSING OF STREAMS AND WETLANDS WILL UTILIZE TIMBERMATS. ANY PERMANENT ROAD CROSSINGS WILL BE CONDUCTED VIA CULVERTS.
8. ALL NON VMRC STREAM CROSSINGS WILL BE PERFORMED AS DESCRIBED IN THE STREAM CROSSING TABLE INCLUDED IN THIS PACKAGE.

TETRA TECH CAD FILE PATH: X:\CADD_Pittsburgh\EQT\7157 – MVP\15 – Franklin\E&S\ES Version 5.0.0\7157ES14.29(S10).dwg PLOTTED ON: 10/9/2023 12:14 PM PLOTTED BY: Zeigler, Justin PLOT FILE: ENVIRONMENTAL_COLOR.ctb

NO.	DATE:	DWN.:	CHKD.:	APPD.:	DESCRIPTION:
–	10/12/23	JJZ	IHH	DCW	CHANGE S–D11 CROSSING TO OPEN CUT
–	04/07/23	JJZ	TD	DCW	ADDRESS DEQ COMMENTS ON CROSSING CHANGE METHOD
–	05/12/21	JJZ	RE	DW	CROSSING METHOD CHANGE FROM OPEN CUT TO BORE
8	11/08/18	JJZ	RE	DW	ADDRESS VADEQ COMMENTS TO FIELD MODIFICATION SUBMITTAL
7	06/22/18	JJZ	RE	DW	FIELD MODIFICATION
6	03/16/18	KAL	RE	DW	ADDRESS VADEQ COMMENTS

REVISIONS:

Mountain Valley PIPELINE

EROSION AND SEDIMENT CONTROL PLANS
MOUNTAIN VALLEY PIPELINE PROJECT – H600 LINE
SPREAD 10 – FRANKLIN COUNTY, VIRGINIA

MOUNTAIN VALLEY PIPELINE, LLC
2200 ENERGY DRIVE
CANONSBURG, PA 15317


TETRA TECH
complex world | CLEAR SOLUTIONS™
661 ANDERSEN DRIVE
FOSTER PLAZA 7
PITTSBURGH, PA 15220

EROSION AND SEDIMENT CONTROL PLANS

COMMONWEALTH OF VIRGINIA
DAVID J. WALLNER
Lic. No. 57593
10/12/2023
PROFESSIONAL ENGINEER

DRAWN BY:	JJZ
CHECKED BY:	IHH
APPROVED BY:	DCW
DATE:	10/12/2023
SCALE:	AS SHOWN
	– REVISION


SHT. NO. 14.29ES OF 14.81ES

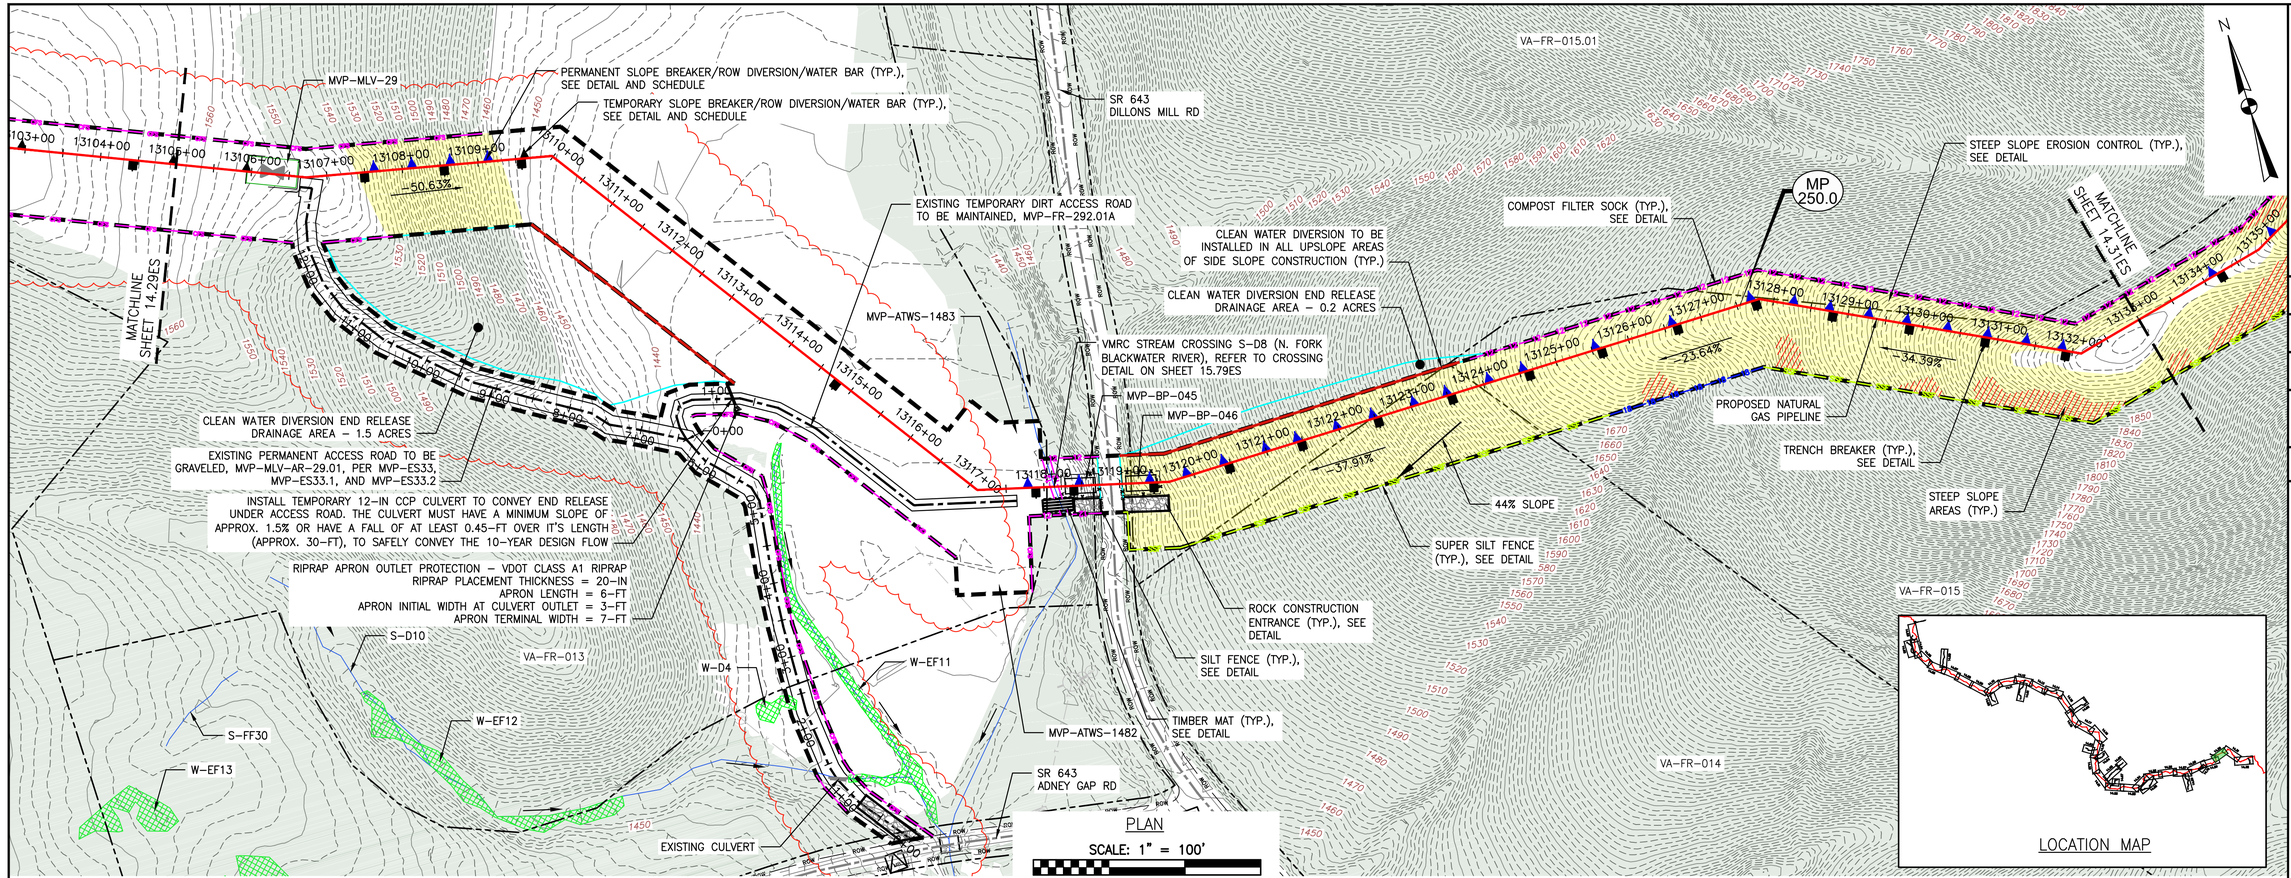

PLAN

SCALE: 1" = 100'

100 0 100 200

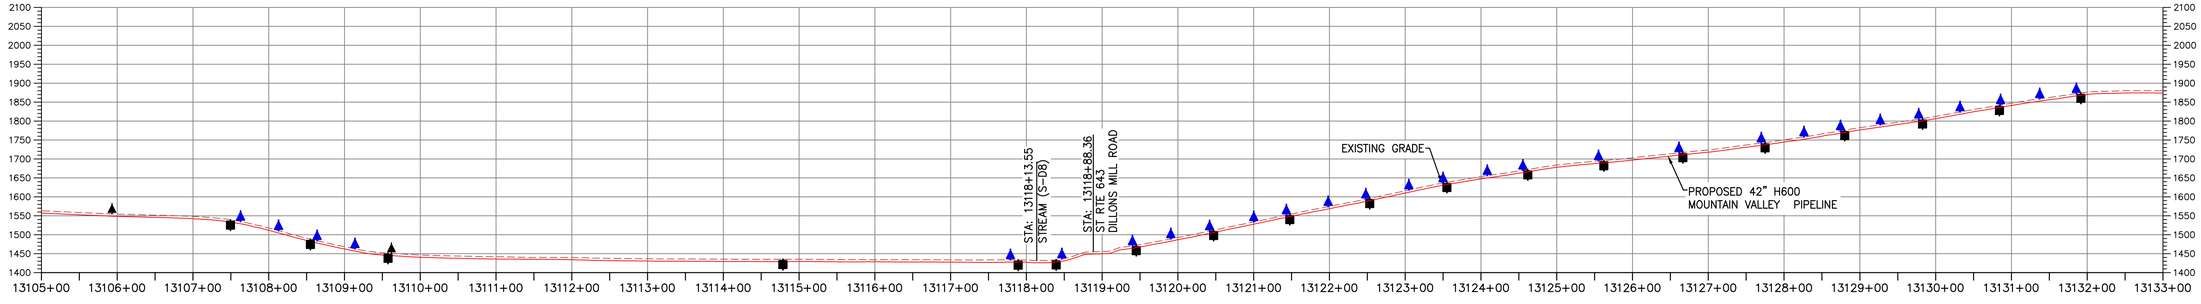

PROFILE

HORIZONTAL SCALE: SCALE: 1" = 100'

100 0 100 200

VERTICAL SCALE: SCALE: 1" = 200'

200 0 200 400

LEGEND

- PROPOSED LIMIT OF DISTURBANCE
- STREAM
- USDA FOREST SERVICE (NATIONAL FOREST) LANDS
- ANST — ANST — APPALACHIAN NATIONAL SCENIC TRAIL
- EXISTING ROAD/TRAIL
- EXISTING PROPERTY LINE
- EXISTING STATE LINE
- EXISTING COUNTY LINE
- POND
- WETLAND
- AFM — AFM — ACID FORMING MATERIAL
- EXISTING FOREST
- PROPOSED ACCESS ROAD CENTERLINE
- PROPOSED PIPELINE
- SF — SF — PROPOSED SILT FENCE (SEE NOTE 5)
- SSF — SSF — PROPOSED SUPER SILT FENCE (SEE DETAIL MVP-ES9.2)
- RFD — RFD — PROPOSED REINFORCED FILTRATION DEVICE (SEE DETAILS MVP-ES9, 9.1, 9.2, 9.3)
- OCSF — ORANGE CONSTRUCTION SAFETY FENCE
- 12 — 12 — 12 — 12 — PROPOSED COMPOST FILTER SOCK (SEE DETAILS MVP-ES3, 3.1, 3.2)
- 18 — 18 — 18 — 18 — PROPOSED COMPOST FILTER SOCK (SEE DETAILS MVP-ES3, 3.1, 3.2)
- 24 — 24 — 24 — 24 — PROPOSED COMPOST FILTER SOCK (SEE DETAILS MVP-ES3, 3.1, 3.2)
- GRASS-LINED CHANNEL (SEE DETAIL MVP-ES39)
- CLEAN WATER DIVERSION PIPE
- CLEAN WATER DIVERSION DIKE (SEE DETAIL MVP-ES50 AND MVP-ES51)
- STREAM FLOW DIRECTION
- FEMA 100 YEAR FLOODPLAIN
- DRAINAGE AREA BOUNDARY
- TIMBER MAT (SEE DETAIL MVP-ES37)
- STEEP SLOPE EROSION CONTROL (SEE NOTE 2)
- STEEP SLOPE AREAS (SEE NOTE 4)
- PROPOSED ROCK CONSTRUCTION ENTRANCE
- PROPOSED TRENCH BREAKER (SEE DETAIL MVP-20)
- TEMPORARY ROW DIVERSION/WATER BAR (SEE DETAIL MVP-17)
- PERMANENT SLOPE BREAKER/ROW DIVERSION/WATER BAR (SEE DETAIL MVP-17)

NOTES:

1. TOPSOIL SEGREGATION WILL BE PERFORMED IN ALL IMMEDIATE CONSTRUCTION AREAS OF THE PROJECT IN ACCORDANCE WITH DETAILS MVP-ES46.1 THROUGH MVP-ES46.3.
2. FLEXTERRA, EARTHGUARD OR EQUIVALENT MAY BE USED AS A SUBSTITUTE TO EROSION CONTROL BLANKET AS DIRECTED BY MVP.
3. CONTRACTOR IS RESPONSIBLE TO IDENTIFY ALL UTILITIES. THE UTILITY LINES SHOWN ON THE PLAN ARE FOR INFORMATIONAL PURPOSES ONLY AND DO NOT REPRESENT SURVEYED LINE INFORMATION.
4. SLOPES OF 30' OR GREATER EXIST. CONSTRUCTION FOR STEEP SLOPES TO BE PERFORMED USING STEEP SLOPE TECHNIQUES IDENTIFIED IN THE DETAIL SHEETS. ALSO REFER TO THE SITE-SPECIFIC DESIGN OF STABILIZATION MEASURES IN SELECTED HIGH-HAZARD PORTIONS OF THE ROUTE OF THE PROPOSED MOUNTAIN VALLEY PIPELINE PROJECT.
5. WHERE CONSTRUCTION CONDITIONS PRECLUDE THE USE OF DIVERSION DITCHES DUE TO SITE CONDITIONS THE CONTRACTOR WILL INSTALL SILT FENCE AT THE DIRECTION OF MVP.
6. IMPROVEMENTS TO PERMANENT AND TEMPORARY ACCESS ROADS WILL BE PERFORMED PER THE SITE SPECIFIC ACCESS ROAD DETAILS.
7. TEMPORARY ACCESS ROAD CROSSING OF STREAMS AND WETLANDS WILL UTILIZE TIMBERMATS. ANY PERMANENT ROAD CROSSINGS WILL BE CONDUCTED VIA CULVERTS.
8. ALL NON VMRC STREAM CROSSINGS WILL BE PERFORMED AS DESCRIBED IN THE STREAM CROSSING TABLE INCLUDED IN THIS PACKAGE.

NO.	DATE:	DWN.:	CHKD.:	APPD.:	DESCRIPTION:
8	08/03/18	JJZ	RE	DW	FIELD MODIFICATION
7	06/22/18	KAL	RE	DW	FIELD MODIFICATION
6	03/16/18	KAL	RE	DW	ADDRESS VA/DEQ COMMENTS
5	03/04/18	KAL	RE	DW	ADDRESS VA/DEQ COMMENTS
4	02/27/18	KAL	RE	DW	ADDRESS VA/DEQ COMMENTS
3	02/05/18	KAL	RE	DW	ADDRESS VA/DEQ COMMENTS

REVISIONS:

Mountain Valley PIPELINE

EROSION AND SEDIMENT CONTROL PLANS

MOUNTAIN VALLEY PIPELINE PROJECT – H600 LINE

SPREAD 10 – FRANKLIN COUNTY, VIRGINIA


MOUNTAIN VALLEY PIPELINE, LLC
2200 ENERGY DRIVE
CANONSBURG, PA 15317

TETRA TECH
complex world | CLEAR SOLUTIONS™
661 ANDERSEN DRIVE
FOSTER PLAZA 7
PITTSBURGH, PA 15220

EROSION AND SEDIMENT CONTROL PLANS

COMMONWEALTH OF VIRGINIA
DAVID J. WALLNER
Lic. No. 0402057593
PROFESSIONAL ENGINEER


DRAWN BY:	JJZ
CHECKED BY:	RE
APPROVED BY:	DW
DATE:	08/03/2018
SCALE:	AS SHOWN
REVISION	8
SHT. NO.	14.30ES OF 14.81ES

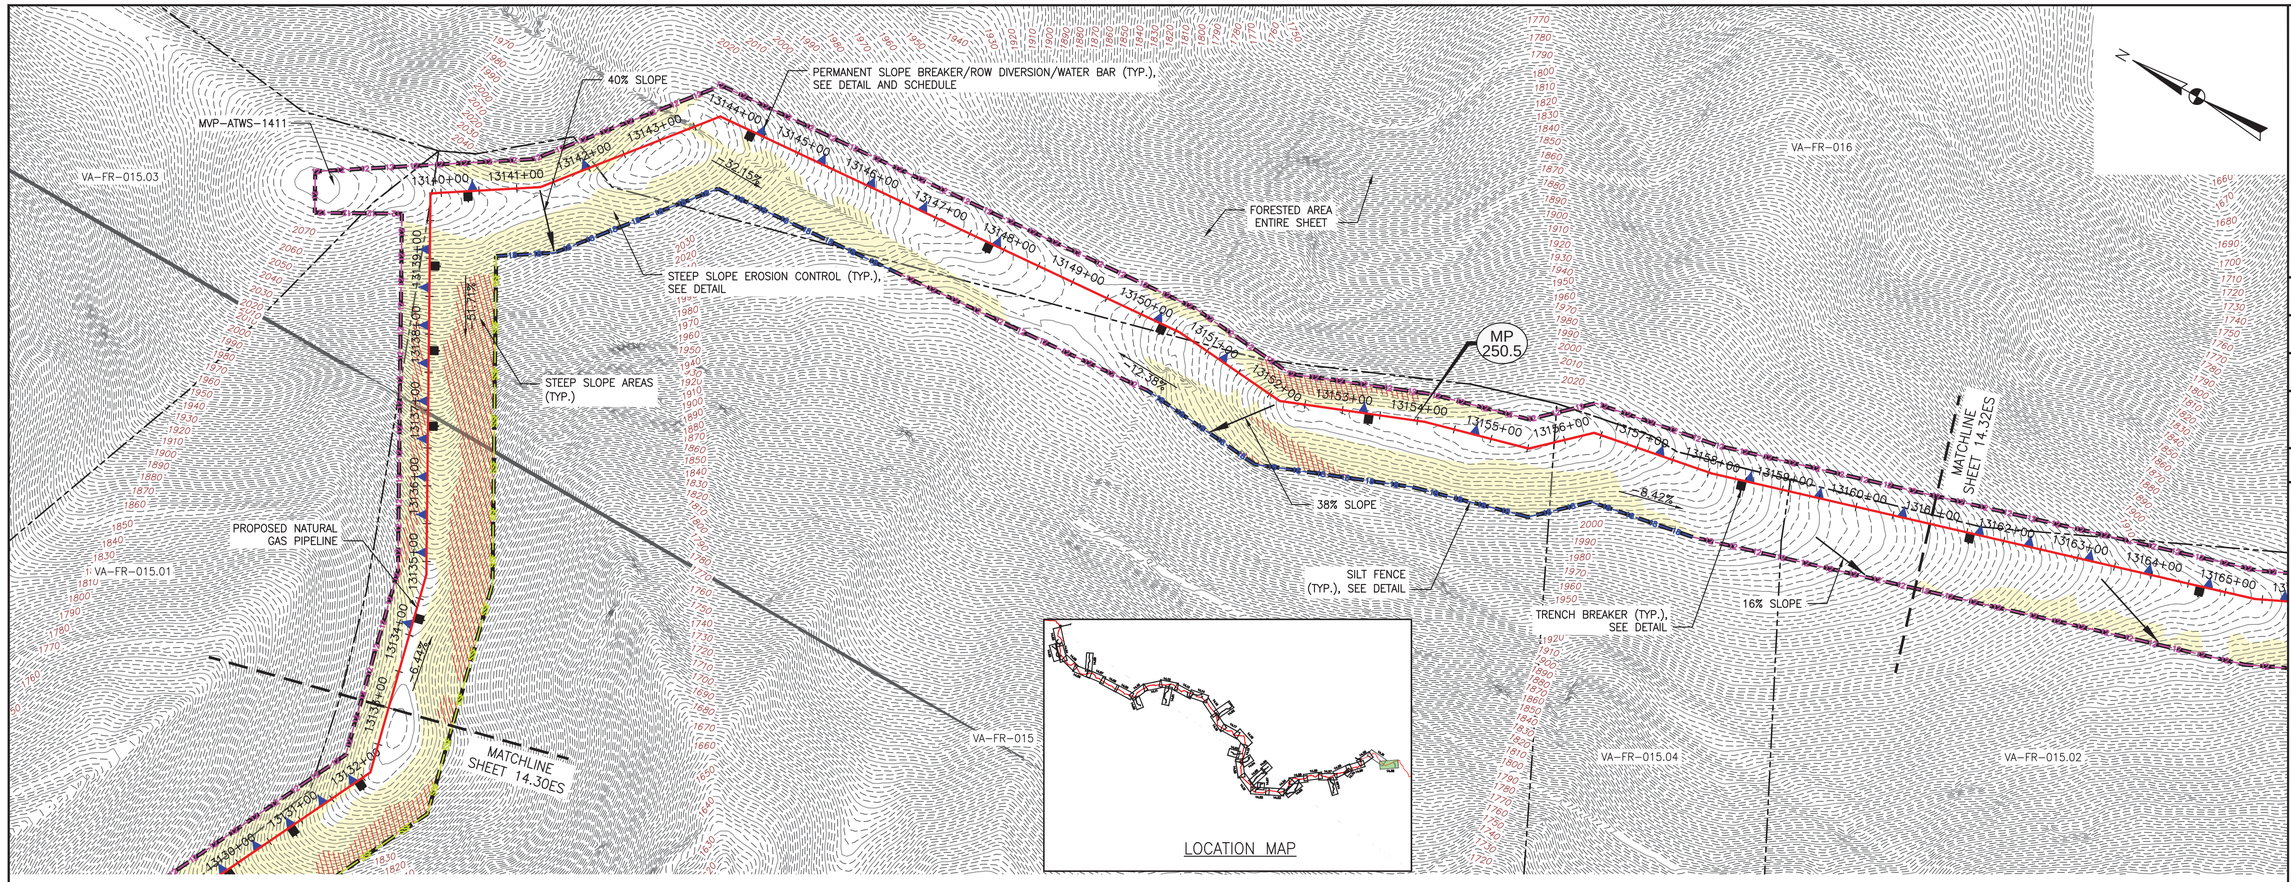

PLAN

SCALE: 1" = 100'

100 0 100 200

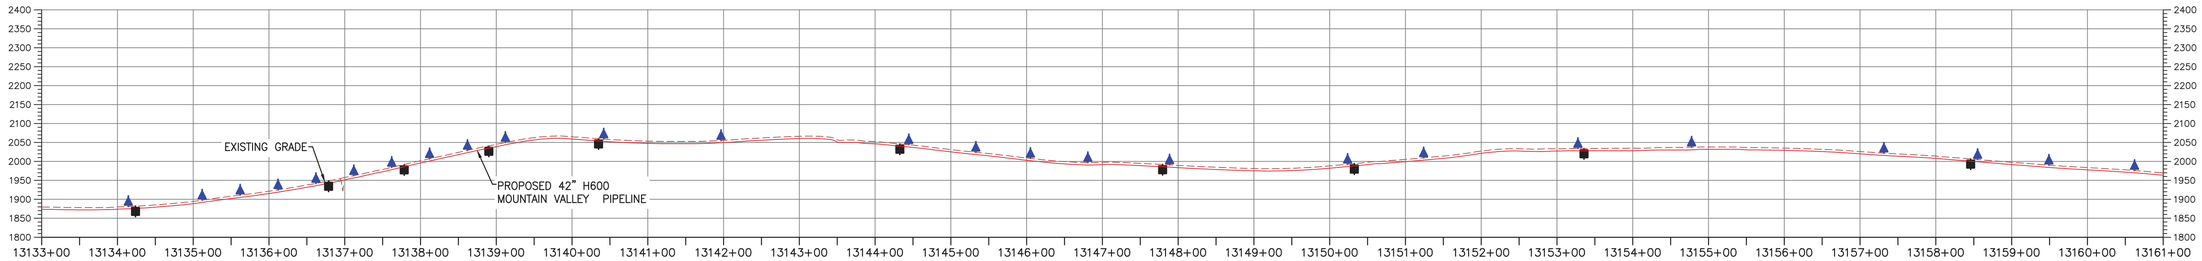

PROFILE

HORIZONTAL SCALE: SCALE: 1" = 100'

VERTICAL SCALE: SCALE: 1" = 200'

100 0 100 200 0 200 400

LEGEND

- PROPOSED LIMIT OF DISTURBANCE
- STREAM
- USDA FOREST SERVICE (NATIONAL FOREST) LANDS
- ANST — ANST — APPALACHIAN NATIONAL SCENIC TRAIL
- EXISTING ROAD/TRAIL
- EXISTING PROPERTY LINE
- EXISTING STATE LINE
- EXISTING COUNTY LINE
- POND
- WETLAND
- AFM — AFM — ACID FORMING MATERIAL
- AGRI — AGRI — AGRICULTURAL LAND USE BOUNDARY
- PROPOSED ACCESS ROAD CENTERLINE
- PROPOSED PIPELINE
- SF — SF — PROPOSED SILT FENCE (SEE NOTE 5)
- SSF — SSF — PROPOSED SUPER SILT FENCE (SEE DETAIL MVP-ES9.2)
- RFD — RFD — PROPOSED REINFORCED FILTRATION DEVICE (SEE DETAILS MVP-ES9, 9.1, 9.2, 9.3)
- OCSF — ORANGE CONSTRUCTION SAFETY FENCE
- 12 — 12 — 12 — 12 — PROPOSED COMPOST FILTER SOCK (SEE DETAILS MVP-ES3, 3.1, 3.2)
- 18 — 18 — 18 — 18 — PROPOSED COMPOST FILTER SOCK (SEE DETAILS MVP-ES3, 3.1, 3.2)
- 24 — 24 — 24 — 24 — PROPOSED COMPOST FILTER SOCK (SEE DETAILS MVP-ES3, 3.1, 3.2)
- GRASS-LINED CHANNEL (SEE DETAIL MVP-ES39)
- CLEAN WATER DIVERSION PIPE
- CLEAN WATER DIVERSION DIKE (SEE DETAIL MVP-ES50 AND MVP-ES51)
- FEMA 100 YEAR FLOODPLAIN
- DRAINAGE AREA BOUNDARY
- TIMBER MAT (SEE DETAIL MVP-ES37)
- STEEP SLOPE EROSION CONTROL (SEE NOTE 2)
- STEEP SLOPE AREAS (SEE NOTE 4)
- PROPOSED ROCK CONSTRUCTION ENTRANCE
- PROPOSED TRENCH BREAKER (SEE DETAIL MVP-20)
- TEMPORARY ROW DIVERSION/WATER BAR (VADEQ STD & SPEC 3.11)
- PERMANENT SLOPE BREAKER/ROW DIVERSION/WATER BAR (SEE DETAILS MVP-17, ES38, AND SCHEDULE)

NOTES:

1. TOPSOIL SEGREGATION WILL BE PERFORMED IN ALL IMMEDIATE CONSTRUCTION AREAS OF THE PROJECT IN ACCORDANCE WITH DETAILS MVP-ES46.1 THROUGH MVP-ES46.3.
2. FLEXTERRA, EARTHGUARD OR EQUIVALENT MAY BE USED AS A SUBSTITUTE TO EROSION CONTROL BLANKET AS DIRECTED BY MVP.
3. CONTRACTOR IS RESPONSIBLE TO IDENTIFY ALL UTILITIES. THE UTILITY LINES SHOWN ON THE PLAN ARE FOR INFORMATIONAL PURPOSES ONLY AND DO NOT REPRESENT SURVEYED LINE INFORMATION.
4. SLOPES OF 30° OR GREATER EXIST. CONSTRUCTION FOR STEEP SLOPES TO BE PERFORMED USING STEEP SLOPE TECHNIQUES IDENTIFIED IN THE DETAIL SHEETS. ALSO REFER TO THE SITE-SPECIFIC DESIGN OF STABILIZATION MEASURES IN SELECTED HIGH-HAZARD PORTIONS OF THE ROUTE OF THE PROPOSED MOUNTAIN VALLEY PIPLELINE PROJECT.
5. WHERE CONSTRUCTION CONDITIONS PRECLUDE THE USE OF DIVERSION DITCHES DUE TO SITE CONDITIONS THE CONTRACTOR WILL INSTALL SILT FENCE AT THE DIRECTION OF MVP.
6. IMPROVEMENTS TO PERMANENT AND TEMPORARY ACCESS ROADS WILL BE PERFORMED PER THE SITE SPECIFIC ACCESS ROAD DETAILS.
7. TEMPORARY ACCESS ROAD CROSSING OF STREAMS AND WETLANDS WILL UTILIZE TIMBERMATS. ANY PERMANENT ROAD CROSSINGS WILL BE CONDUCTED VIA CULVERTS.
8. ALL NON VMRC STREAM CROSSINGS WILL BE PERFORMED AS DESCRIBED IN THE STREAM CROSSING TABLE INCLUDED IN THIS PACKAGE.

NO.	DATE	DWN.	CHKD.	APPD.	DESCRIPTION
5	03/04/18	KAL	RE	DW	ADDRESS VADEQ COMMENTS
4	02/27/18	KAL	RE	DW	ADDRESS VADEQ COMMENTS
3	02/05/18	KAL	RE	DW	ADDRESS VADEQ COMMENTS
2	11/21/17	KAL	RE	DW	ADDRESS VADEQ COMMENTS
1	09/21/17	KAL	RE	DW	PLAN SUBMISSION

REVISIONS:

Mountain Valley PIPELINE

EROSION AND SEDIMENT CONTROL PLANS

MOUNTAIN VALLEY PIPELINE PROJECT – H600 LINE

SPREAD 10 – FRANKLIN COUNTY, VIRGINIA

MOUNTAIN VALLEY PIPELINE, LLC

555 SOUTHPOINTE BOULEVARD, SUITE 200

CANONSBURG, PA 15317

TETRA TECH

complex world | CLEAR SOLUTIONS™

661 ANDERSEN DRIVE
FOSTER PLAZA 7
PITTSBURGH, PA 15220

EROSION AND SEDIMENT CONTROL PLANS

COMMONWEALTH OF VIRGINIA
DAVID J. WALLNER
Lic. No. 0402057593
PROFESSIONAL ENGINEER

DRAWN BY:	KAL
CHECKED BY:	RE
APPROVED BY:	DW
DATE:	03/04/2018
SCALE:	AS SHOWN
SHT. NO.	14.31ES OF 14.81ES

REVISION

TETRA TECH CAD FILE PATH: X:\CADD_Pittsburgh\EQT\7157 – MVP\15 – Franklin\E&S\ES Version 5.0.0\7157ES14.31(S10).dwg PLOTTED ON: 3/2/2018 2:10 PM PLOTTED BY: Zeigler, Justin PLOT FILE: ENVIRONMENTAL_COLOR.ctb

MATCHLINE SHEET 14.31ES

MATCHLINE SHEET 14.33ES

VA-FR-016

VA-FR-017

VA-FR-017.01

BV-FR-4

FORESTED AREA ENTIRE SHEET

COUNTY ROUTE 741 FLANDERS ROAD

W-II5

EXISTING CULVERT

W-II4

TIMBER MAT (TYP.), SEE DETAIL

STREAM CROSSING S-II4

CLEAN WATER DIVERSION TO BE INSTALLED IN ALL UPSLOPE AREAS OF SIDE SLOPE CONSTRUCTION (TYP.)

CLEAN WATER DIVERSION END RELEASE DRAINAGE AREA – 0.2 ACRES

CLEAN WATER DIVERSION END RELEASE DRAINAGE AREA – 0.3 ACRES

CLEAN WATER DIVERSION END RELEASE DRAINAGE AREA – 1.5 ACRES

CLEAN WATER DIVERSION END RELEASE DRAINAGE AREA – 4.7 ACRES

PROPOSED NATURAL GAS PIPELINE

COMPOST FILTER SOCK (TYP.), SEE DETAIL

PERMANENT SLOPE BREAKER/ROW DIVERSION/WATER BAR (TYP.), SEE DETAIL AND SCHEDULE

ROCK CONSTRUCTION ENTRANCE (TYP.), SEE DETAIL

EXISTING PERMANENT ACCESS ROAD MVP-FR-239.01 TO BE MAINTAINED

MP 251.0

ORANGE CONSTRUCTION SAFETY FENCE (TYP.), SEE DETAIL

SILT FENCE (TYP.), SEE DETAIL

MVP-ATWS-1055

S-MM27

W-MM16

W-MM16

24% SLOPE

20% SLOPE

39% SLOPE

TRENCH BREAKER (TYP.), SEE DETAIL

STEEP SLOPE EROSION CONTROL (TYP.), SEE DETAIL

STEEP SLOPE AREAS (TYP.)

SUPER SILT FENCE (TYP.), SEE DETAIL


SUPER SILT FENCE (TYP.), SEE DETAIL

LOCATION MAP

PLAN

SCALE: 1" = 100'

100 0 100 200

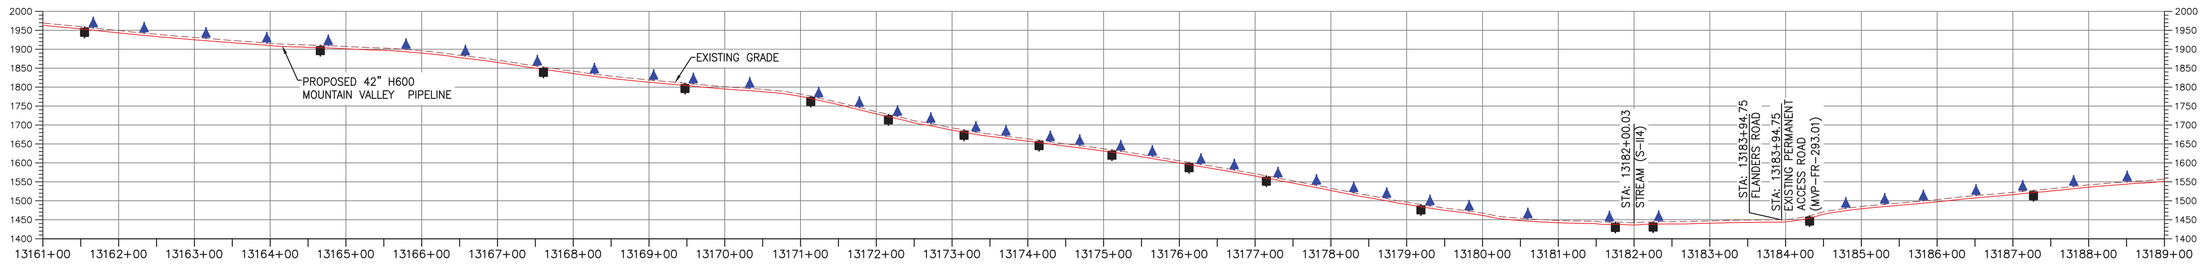

PROFILE

HORIZONTAL SCALE: SCALE: 1" = 100'

100 0 100 200

VERTICAL SCALE: SCALE: 1" = 200'

200 0 200 400

LEGEND

- PROPOSED LIMIT OF DISTURBANCE
- STREAM
- USDA FOREST SERVICE (NATIONAL FOREST) LANDS
- APPALACHIAN NATIONAL SCENIC TRAIL
- EXISTING ROAD/TRAIL
- EXISTING PROPERTY LINE
- EXISTING STATE LINE
- EXISTING COUNTY LINE
- POND
- WETLAND
- ACID FORMING MATERIAL
- AGRICULTURAL LAND USE BOUNDARY
- PROPOSED ACCESS ROAD CENTERLINE
- PROPOSED PIPELINE
- PROPOSED SILT FENCE (SEE NOTE 5)
- PROPOSED SUPER SILT FENCE (SEE DETAIL MVP-ES9.2)
- PROPOSED REINFORCED FILTRATION DEVICE (SEE DETAILS MVP-ES9, 9.1, 9.2, 9.3)
- ORANGE CONSTRUCTION SAFETY FENCE
- PROPOSED COMPOST FILTER SOCK (SEE DETAILS MVP-ES3, 3.1, 3.2)
- PROPOSED COMPOST FILTER SOCK (SEE DETAILS MVP-ES3, 3.1, 3.2)
- PROPOSED COMPOST FILTER SOCK (SEE DETAILS MVP-ES3, 3.1, 3.2)
- GRASS-LINED CHANNEL (SEE DETAIL MVP-ES39)
- CLEAN WATER DIVERSION PIPE
- CLEAN WATER DIVERSION DIKE (SEE DETAIL MVP-ES50 AND MVP-ES51)
- STREAM FLOW DIRECTION
- FEMA 100 YEAR FLOODPLAIN
- DRAINAGE AREA BOUNDARY
- TIMBER MAT (SEE DETAIL MVP-ES37)
- STEEP SLOPE EROSION CONTROL (SEE NOTE 2)
- STEEP SLOPE AREAS (SEE NOTE 4)
- PROPOSED ROCK CONSTRUCTION ENTRANCE
- PROPOSED TRENCH BREAKER (SEE DETAIL MVP-20)
- TEMPORARY ROW DIVERSION/WATER BAR (VADEQ STD & SPEC 3.11)
- PERMANENT SLOPE BREAKER/ROW DIVERSION/WATER BAR (SEE DETAILS MVP-17, ES38, AND SCHEDULE)

NOTES:

1. TOPSOIL SEGREGATION WILL BE PERFORMED IN ALL IMMEDIATE CONSTRUCTION AREAS OF THE PROJECT IN ACCORDANCE WITH DETAILS MVP-ES46.1 THROUGH MVP-ES46.3.
2. FLEXTERRA, EARTHGUARD OR EQUIVALENT MAY BE USED AS A SUBSTITUTE TO EROSION CONTROL BLANKET AS DIRECTED BY MVP.
3. CONTRACTOR IS RESPONSIBLE TO IDENTIFY ALL UTILITIES. THE UTILITY LINES SHOWN ON THE PLAN ARE FOR INFORMATIONAL PURPOSES ONLY AND DO NOT REPRESENT SURVEYED LINE INFORMATION.
4. SLOPES OF 30' OR GREATER EXIST. CONSTRUCTION FOR STEEP SLOPES TO BE PERFORMED USING STEEP SLOPE TECHNIQUES IDENTIFIED IN THE DETAIL SHEETS. ALSO REFER TO THE SITE-SPECIFIC DESIGN OF STABILIZATION MEASURES IN SELECTED HIGH-HAZARD PORTIONS OF THE ROUTE OF THE PROPOSED MOUNTAIN VALLEY PIPELINE PROJECT.
5. WHERE CONSTRUCTION CONDITIONS PRECLUDE THE USE OF DIVERSION DITCHES DUE TO SITE CONDITIONS THE CONTRACTOR WILL INSTALL SILT FENCE AT THE DIRECTION OF MVP.
6. IMPROVEMENTS TO PERMANENT AND TEMPORARY ACCESS ROADS WILL BE PERFORMED PER THE SITE SPECIFIC ACCESS ROAD DETAILS.
7. TEMPORARY ACCESS ROAD CROSSING OF STREAMS AND WETLANDS WILL UTILIZE TIMBERMATS. ANY PERMANENT ROAD CROSSINGS WILL BE CONDUCTED VIA CULVERTS.
8. ALL NON VMRC STREAM CROSSINGS WILL BE PERFORMED AS DESCRIBED IN THE STREAM CROSSING TABLE INCLUDED IN THIS PACKAGE.

NO.	DATE:	DWN.:	CHKD.:	APPD.:	DESCRIPTION:
5	03/04/18	KAL	RE	DW	ADDRESS VADEQ COMMENTS
4	02/27/18	KAL	RE	DW	ADDRESS VADEQ COMMENTS
3	02/05/18	KAL	RE	DW	ADDRESS VADEQ COMMENTS
2	11/21/17	KAL	RE	DW	ADDRESS VADEQ COMMENTS
1	09/21/17	KAL	RE	DW	PLAN SUBMISSION

REVISIONS:

Mountain Valley PIPELINE

EROSION AND SEDIMENT CONTROL PLANS

MOUNTAIN VALLEY PIPELINE PROJECT – H600 LINE

SPREAD 10 – FRANKLIN COUNTY, VIRGINIA

MOUNTAIN VALLEY PIPELINE, LLC
555 SOUTHPOINTE BOULEVARD, SUITE 200
CANONSBURG, PA 15317


TETRA TECH
complex world | CLEAR SOLUTIONS™
661 ANDERSEN DRIVE
FOSTER PLAZA 7
PITTSBURGH, PA 15220

EROSION AND SEDIMENT CONTROL PLANS

DAVID J. WALLNER
Lic. No. 0402057593
PROFESSIONAL ENGINEER

DRAWN BY:	KAL
CHECKED BY:	RE
APPROVED BY:	DW
DATE:	03/04/2018
SCALE:	AS SHOWN
REVISION	5
SHT. NO.	14.32ES OF 14.81ES


TETRA TECH CAD FILE PATH: X:\CADD_Pittsburgh\EQT\7157 – MVP\15 – Franklin\E&S\ES Version 5.0.0\7157ES14.32(S10).dwg PLOTTED ON: 3/2/2018 2:16 PM PLOTTED BY: Zeigler, Justin PLOT FILE: ENVIRONMENTAL_COLOR.ctb

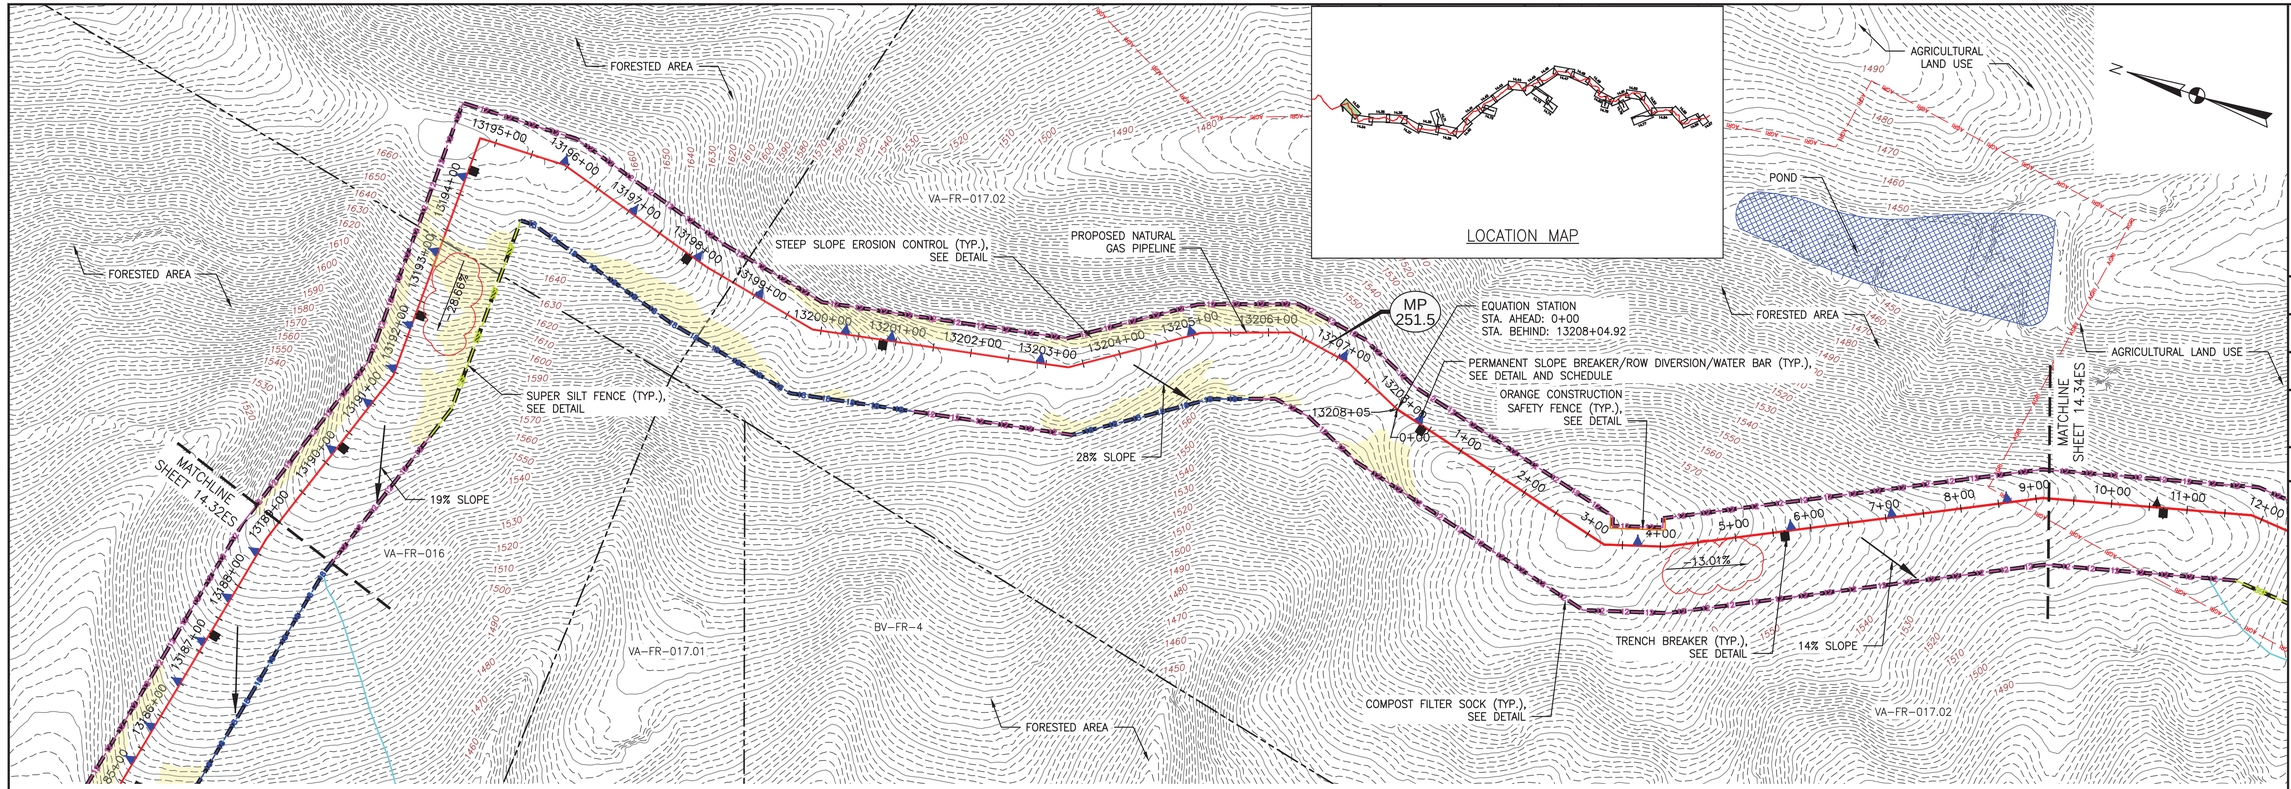

LOCATION MAP

PLAN

SCALE: 1" = 100'

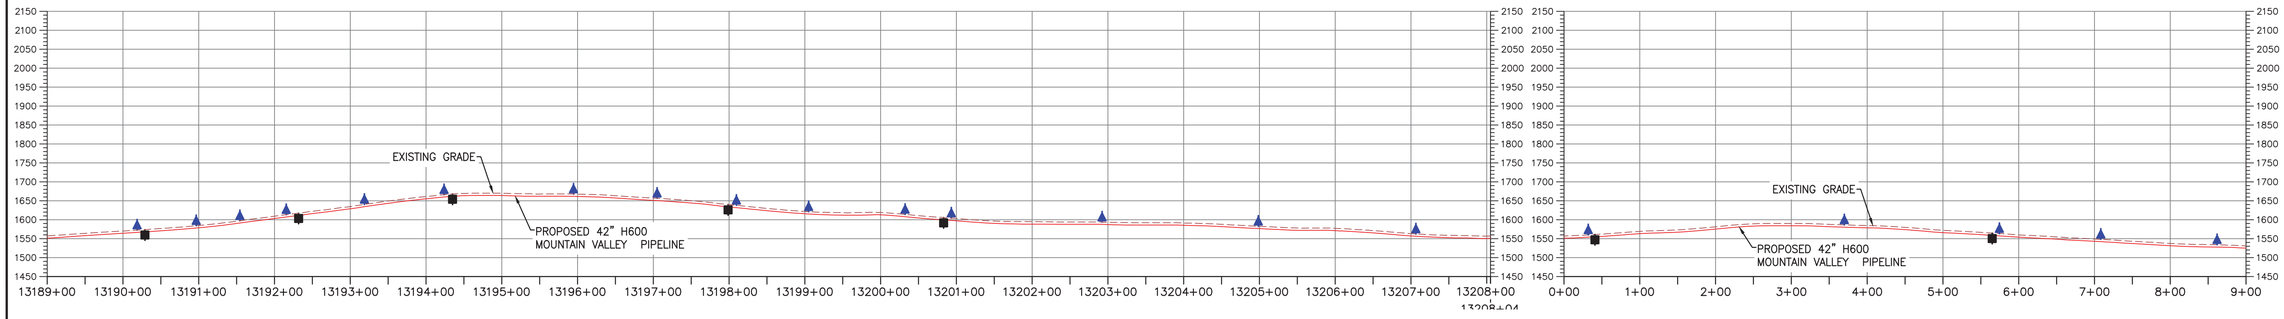

PROFILE

HORIZONTAL SCALE: SCALE: 1" = 100'

VERTICAL SCALE: SCALE: 1" = 200'

LEGEND

- PROPOSED LIMIT OF DISTURBANCE
- STREAM
- USDA FOREST SERVICE (NATIONAL FOREST) LANDS
- APPALACHIAN NATIONAL SCENIC TRAIL
- EXISTING ROAD/TRAIL
- EXISTING PROPERTY LINE
- EXISTING STATE LINE
- EXISTING COUNTY LINE
- POND
- WETLAND
- ACID FORMING MATERIAL
- AGRICULTURAL LAND USE BOUNDARY
- PROPOSED ACCESS ROAD CENTERLINE
- PROPOSED PIPELINE
- PROPOSED SILT FENCE (SEE NOTE 5)
- PROPOSED SUPER SILT FENCE (SEE DETAIL MVP-ES9.2)
- PROPOSED REINFORCED FILTRATION DEVICE (SEE DETAILS MVP-ES9, 9.1, 9.2, 9.3)
- ORANGE CONSTRUCTION SAFETY FENCE
- PROPOSED COMPOST FILTER SOCK (SEE DETAILS MVP-ES3, 3.1, 3.2)
- PROPOSED COMPOST FILTER SOCK (SEE DETAILS MVP-ES3, 3.1, 3.2)
- PROPOSED COMPOST FILTER SOCK (SEE DETAILS MVP-ES3, 3.1, 3.2)
- GRASS-LINED CHANNEL (SEE DETAIL MVP-ES39)
- CLEAN WATER DIVERSION PIPE
- CLEAN WATER DIVERSION DIKE (SEE DETAIL MVP-ES50 AND MVP-ES51)
- STREAM FLOW DIRECTION
- FEMA 100 YEAR FLOODPLAIN
- DRAINAGE AREA BOUNDARY
- TIMBER MAT (SEE DETAIL MVP-ES37)
- STEEP SLOPE EROSION CONTROL (SEE NOTE 2)
- STEEP SLOPE AREAS (SEE NOTE 4)
- PROPOSED ROCK CONSTRUCTION ENTRANCE
- PROPOSED TRENCH BREAKER (SEE DETAIL MVP-20)
- TEMPORARY ROW DIVERSION/WATER BAR (VADEQ STD & SPEC 3.11)
- PERMANENT SLOPE BREAKER/ROW DIVERSION/WATER BAR (SEE DETAILS MVP-17, ES38, AND SCHEDULE)

NOTES:

1. TOPSOIL SEGREGATION WILL BE PERFORMED IN ALL IMMEDIATE CONSTRUCTION AREAS OF THE PROJECT IN ACCORDANCE WITH DETAILS MVP-ES46.1 THROUGH MVP-ES46.3.
2. FLEXTERRA, EARTHGUARD OR EQUIVALENT MAY BE USED AS A SUBSTITUTE TO EROSION CONTROL BLANKET AS DIRECTED BY MVP.
3. CONTRACTOR IS RESPONSIBLE TO IDENTIFY ALL UTILITIES. THE UTILITY LINES SHOWN ON THE PLAN ARE FOR INFORMATIONAL PURPOSES ONLY AND DO NOT REPRESENT SURVEYED LINE INFORMATION.
4. SLOPES OF 30° OR GREATER EXIST. CONSTRUCTION FOR STEEP SLOPES TO BE PERFORMED USING STEEP SLOPE TECHNIQUES IDENTIFIED IN THE DETAIL SHEETS. ALSO REFER TO THE SITE-SPECIFIC DESIGN OF STABILIZATION MEASURES IN SELECTED HIGH-HAZARD PORTIONS OF THE ROUTE OF THE PROPOSED MOUNTAIN VALLEY PIPELINE PROJECT.
5. WHERE CONSTRUCTION CONDITIONS PRECLUDE THE USE OF DIVERSION DITCHES DUE TO SITE CONDITIONS THE CONTRACTOR WILL INSTALL SILT FENCE AT THE DIRECTION OF MVP.
6. IMPROVEMENTS TO PERMANENT AND TEMPORARY ACCESS ROADS WILL BE PERFORMED PER THE SITE SPECIFIC ACCESS ROAD DETAILS.
7. TEMPORARY ACCESS ROAD CROSSING OF STREAMS AND WETLANDS WILL UTILIZE TIMBERMATS. ANY PERMANENT ROAD CROSSINGS WILL BE CONDUCTED VIA CULVERTS.
8. ALL NON VMRC STREAM CROSSINGS WILL BE PERFORMED AS DESCRIBED IN THE STREAM CROSSING TABLE INCLUDED IN THIS PACKAGE.

NO.	DATE:	DWN.:	CHKD.:	APPD.:	DESCRIPTION:
5	03/04/18	KAL	RE	DW	ADDRESS VADEQ COMMENTS
4	02/27/18	KAL	RE	DW	ADDRESS VADEQ COMMENTS
3	02/05/18	KAL	RE	DW	ADDRESS VADEQ COMMENTS
2	11/21/17	KAL	RE	DW	ADDRESS VADEQ COMMENTS
1	09/21/17	KAL	RE	DW	PLAN SUBMISSION

REVISIONS:

Mountain Valley PIPELINE

EROSION AND SEDIMENT CONTROL PLANS

MOUNTAIN VALLEY PIPELINE PROJECT – H600 LINE

SPREAD 10 – FRANKLIN COUNTY, VIRGINIA

MOUNTAIN VALLEY PIPELINE, LLC
555 SOUTHPOINTE BOULEVARD, SUITE 200
CANONSBURG, PA 15317


TETRA TECH
complex world | CLEAR SOLUTIONS™
661 ANDERSEN DRIVE
FOSTER PLAZA 7
PITTSBURGH, PA 15220

EROSION AND SEDIMENT CONTROL PLANS

COMMONWEALTH OF VIRGINIA
DAVID J. WALLNER
Lic. No. 0402057593
PROFESSIONAL ENGINEER

DRAWN BY:	KAL
CHECKED BY:	RE
APPROVED BY:	DW
DATE:	03/04/2018
SCALE:	AS SHOWN
REVISION	5
SHT. NO.	14.33ES OF 14.81ES


TETRA TECH CAD FILE PATH: X:\CADD_Pittsburgh\EQT\7157 – MVP\15 – Franklin\E&S\ES Version 5.0.0\7157ES14.33(S10).dwg PLOTTED ON: 3/2/2018 2:21 PM PLOTTED BY: Zeigler, Justin PLOT FILE: ENVIRONMENTAL_COLOR.ctb

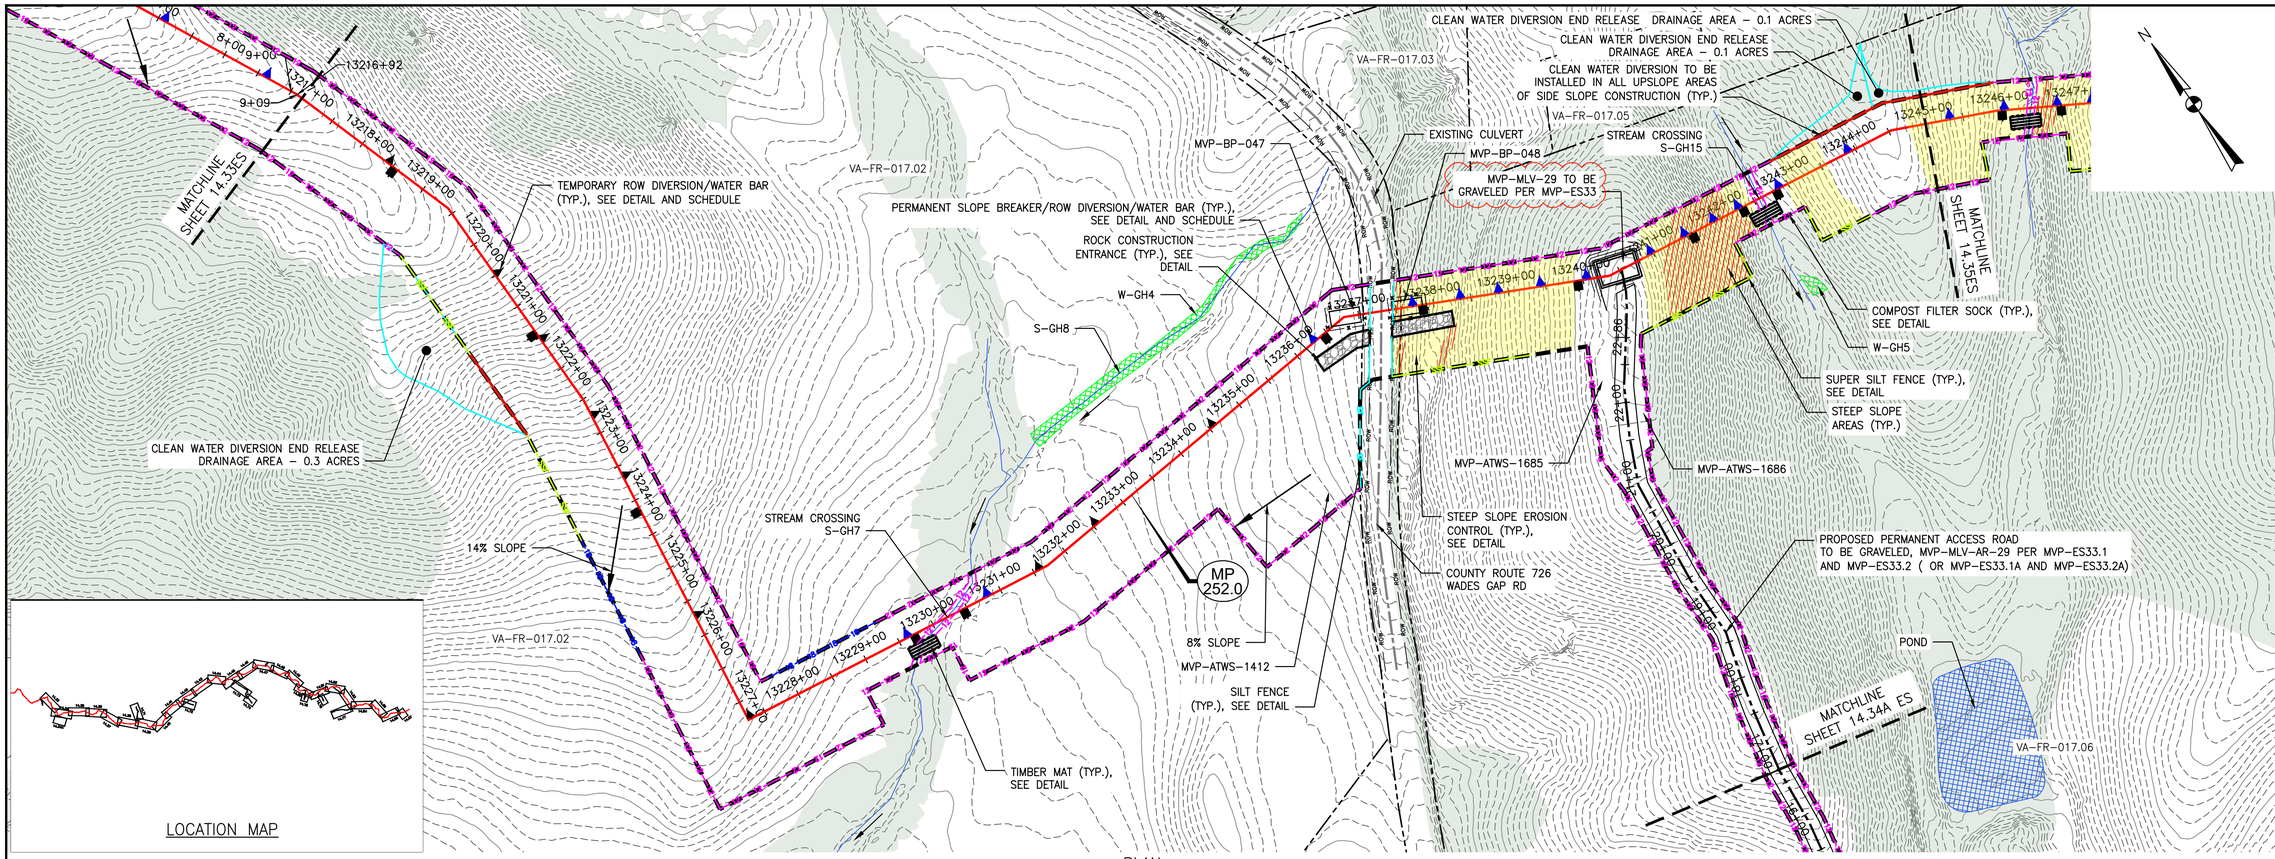

PLAN

SCALE: 1" = 100'

100 0 100 200

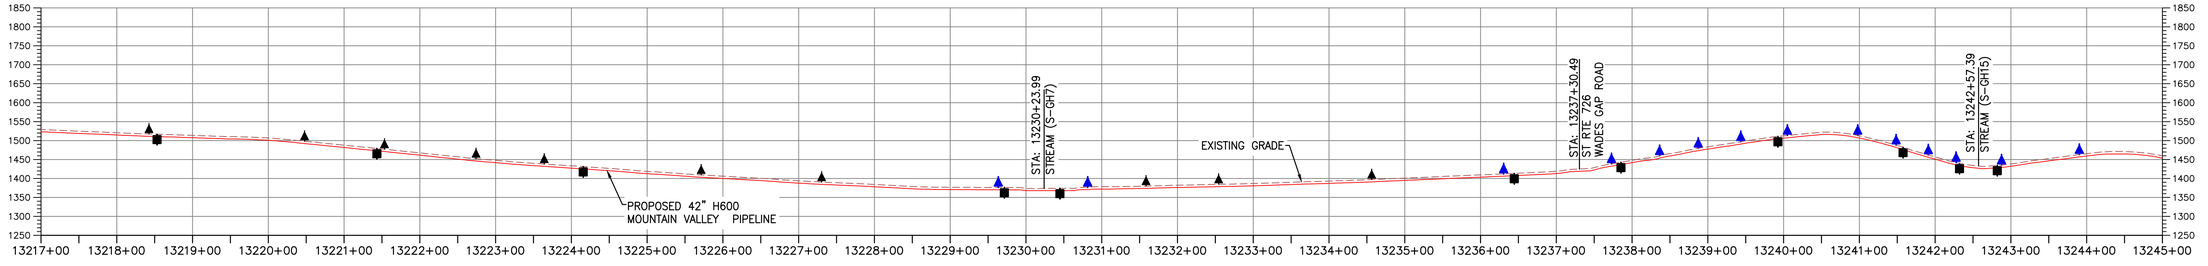

PROFILE

HORIZONTAL SCALE: SCALE: 1" = 100'

100 0 100 200

VERTICAL SCALE: SCALE: 1" = 200'

200 0 200 400

LEGEND

- PROPOSED LIMIT OF DISTURBANCE
- STREAM
- USDA FOREST SERVICE (NATIONAL FOREST) LANDS
- APPALACHIAN NATIONAL SCENIC TRAIL
- EXISTING ROAD/TRAIL
- EXISTING PROPERTY LINE
- EXISTING STATE LINE
- EXISTING COUNTY LINE
- POND
- WETLAND
- ACID FORMING MATERIAL
- EXISTING FOREST
- PROPOSED ACCESS ROAD CENTERLINE
- PROPOSED PIPELINE
- PROPOSED SILT FENCE (SEE NOTE 5)
- PROPOSED SUPER SILT FENCE (SEE DETAIL MVP-ES9.2)
- PROPOSED REINFORCED FILTRATION DEVICE (SEE DETAILS MVP-ES9, 9.1, 9.2, 9.3)
- ORANGE CONSTRUCTION SAFETY FENCE
- PROPOSED COMPOST FILTER SOCK (SEE DETAILS MVP-ES3, 3.1, 3.2)
- PROPOSED COMPOST FILTER SOCK (SEE DETAILS MVP-ES3, 3.1, 3.2)
- PROPOSED COMPOST FILTER SOCK (SEE DETAILS MVP-ES3, 3.1, 3.2)
- GRASS-LINED CHANNEL (SEE DETAIL MVP-ES39)
- CLEAN WATER DIVERSION PIPE
- CLEAN WATER DIVERSION DIKE (SEE DETAIL MVP-ES50 AND MVP-ES51)
- STREAM FLOW DIRECTION
- FEMA 100 YEAR FLOODPLAIN
- DRAINAGE AREA BOUNDARY
- TIMBER MAT (SEE DETAIL MVP-ES37)
- STEEP SLOPE EROSION CONTROL (SEE NOTE 2)
- STEEP SLOPE AREAS (SEE NOTE 4)
- PROPOSED ROCK CONSTRUCTION ENTRANCE
- PROPOSED TRENCH BREAKER (SEE DETAIL MVP-20)
- TEMPORARY ROW DIVERSION/WATER BAR (SEE DETAIL MVP-17)
- PERMANENT SLOPE BREAKER/ROW DIVERSION/WATER BAR (SEE DETAIL MVP-17)

COMMONWEALTH OF VIRGINIA
TIMOTHY N. DUNAWAY
No. 040064
PROFESSIONAL ENGINEER
3/30/22

THIS SEAL APPLIES ONLY TO REVISIONS DATED 03-30-22

NOTES:

1. TOPSOIL SEGREGATION WILL BE PERFORMED IN ALL IMMEDIATE CONSTRUCTION AREAS OF THE PROJECT IN ACCORDANCE WITH DETAILS MVP-ES46.1 THROUGH MVP-ES46.3.
2. FLEXTERRA, EARTHGUARD OR EQUIVALENT MAY BE USED AS A SUBSTITUTE TO EROSION CONTROL BLANKET AS DIRECTED BY MVP.
3. CONTRACTOR IS RESPONSIBLE TO IDENTIFY ALL UTILITIES. THE UTILITY LINES SHOWN ON THE PLAN ARE FOR INFORMATIONAL PURPOSES ONLY AND DO NOT REPRESENT SURVEYED LINE INFORMATION.
4. SLOPES OF 30" OR GREATER EXIST. CONSTRUCTION FOR STEEP SLOPES TO BE PERFORMED USING STEEP SLOPE TECHNIQUES IDENTIFIED IN THE DETAIL SHEETS. ALSO REFER TO THE SITE-SPECIFIC DESIGN OF STABILIZATION MEASURES IN SELECTED HIGH-HAZARD PORTIONS OF THE ROUTE OF THE PROPOSED MOUNTAIN VALLEY PIPELINE PROJECT.
5. WHERE CONSTRUCTION CONDITIONS PRECLUDE THE USE OF DIVERSION DITCHES DUE TO SITE CONDITIONS THE CONTRACTOR WILL INSTALL SILT FENCE AT THE DIRECTION OF MVP.
6. IMPROVEMENTS TO PERMANENT AND TEMPORARY ACCESS ROADS WILL BE PERFORMED PER THE SITE SPECIFIC ACCESS ROAD DETAILS.
7. TEMPORARY ACCESS ROAD CROSSING OF STREAMS AND WETLANDS WILL UTILIZE TIMBERMATS. ANY PERMANENT ROAD CROSSINGS WILL BE CONDUCTED VIA CULVERTS.
8. ALL NON VMRC STREAM CROSSINGS WILL BE PERFORMED AS DESCRIBED IN THE STREAM CROSSING TABLE INCLUDED IN THIS PACKAGE.

NO.:	DATE:	DWN.:	CHKD.:	APPD.:	DESCRIPTION:
–	03/30/22	JJZ	RE	TD	ADDRESS VADEQ COMMENTS TO FIELD MODIFICATION SUBMITTAL
–	06/04/21	JJZ	RE	DW	FIELD MODIFICATION – MLV-29 RELOCATED TO APPROX. MP 252.1
5	03/04/18	KAL	RE	DW	ADDRESS VADEQ COMMENTS
4	02/27/18	KAL	RE	DW	ADDRESS VADEQ COMMENTS
3	02/05/18	KAL	RE	DW	ADDRESS VADEQ COMMENTS
2	11/21/17	KAL	RE	DW	ADDRESS VADEQ COMMENTS

REVISIONS:

Mountain Valley PIPELINE

EROSION AND SEDIMENT CONTROL PLANS

MOUNTAIN VALLEY PIPELINE PROJECT – H600 LINE

SPREAD 10 – FRANKLIN COUNTY, VIRGINIA

MOUNTAIN VALLEY PIPELINE, LLC
2200 ENERGY DRIVE
CANONSBURG, PA 15317

TETRA TECH
complex world | CLEAR SOLUTIONS™
661 ANDERSEN DRIVE
FOSTER PLAZA 7
PITTSBURGH, PA 15220


EROSION AND SEDIMENT CONTROL PLANS

COMMONWEALTH OF VIRGINIA
DAVID J. WALLNER
Lic. No. 57593
PROFESSIONAL ENGINEER
6/4/2021

DRAWN BY:	JJZ
CHECKED BY:	RE
APPROVED BY:	TD
DATE:	03/30/2022
SCALE:	AS SHOWN
SHT. NO.	14.34ES OF 14.81ES

– REVISION


TETRA TECH CAD FILE PATH: X:\CADD_Pittsburgh\EQT\7157 – MVP\15 – Franklin\E&S\ES Version 5.0.0\7157ES14.34(S10).dwg PLOTTED ON: 6/23/2022 10:16 AM PLOTTED BY: Zeigler, Justin PLOT FILE: ENVIRONMENTAL_COLOR.ctb

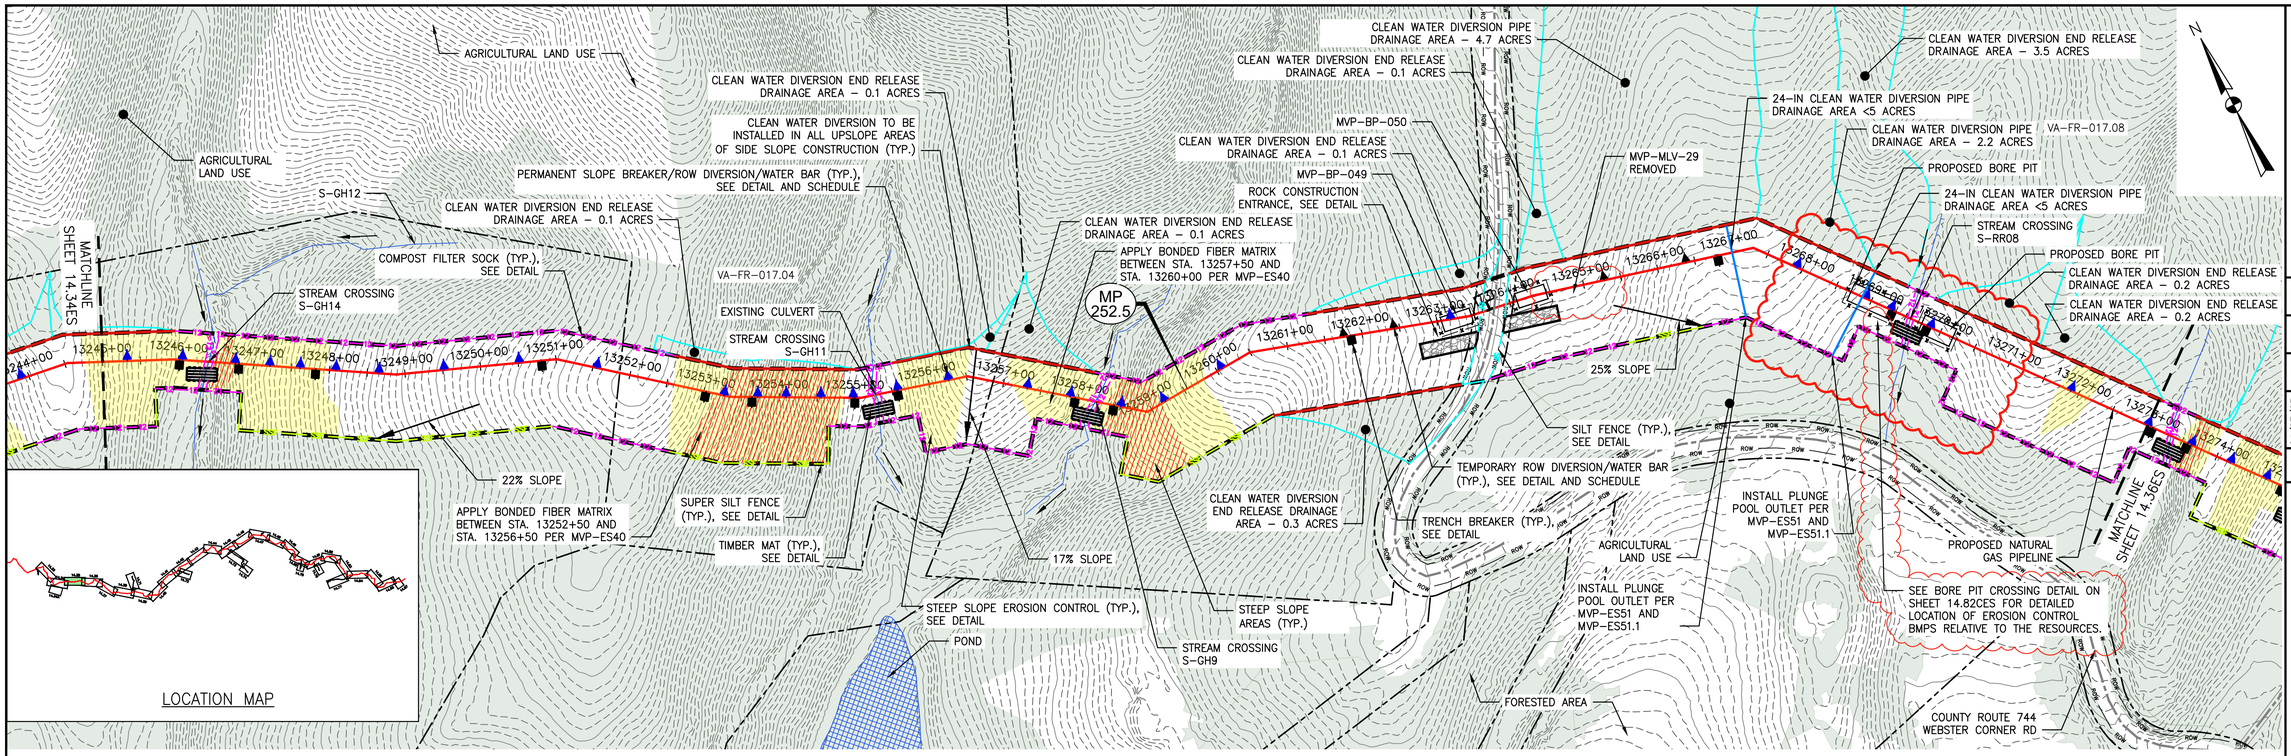

PLAN

SCALE: 1" = 100'

100 0 100 200

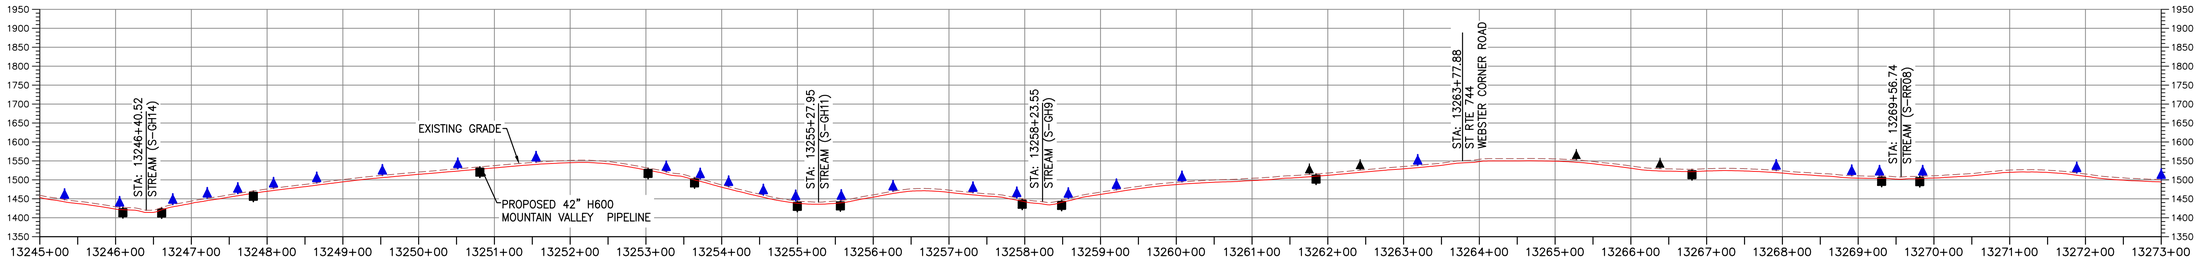

PROFILE

HORIZONTAL SCALE:

SCALE: 1" = 100'

100 0 100 200

VERTICAL SCALE:

SCALE: 1" = 200'

200 0 200 400

LEGEND

- PROPOSED LIMIT OF DISTURBANCE
- STREAM
- USDA FOREST SERVICE (NATIONAL FOREST) LANDS
- APPALACHIAN NATIONAL SCENIC TRAIL
- EXISTING ROAD/TRAIL
- EXISTING PROPERTY LINE
- EXISTING STATE LINE
- EXISTING COUNTY LINE
- POND
- WETLAND
- ACID FORMING MATERIAL
- EXISTING FOREST
- PROPOSED ACCESS ROAD CENTERLINE
- PROPOSED PIPELINE
- PROPOSED SILT FENCE (SEE NOTE 5)
- PROPOSED SUPER SILT FENCE (SEE DETAIL MVP-ES9.2)
- PROPOSED REINFORCED FILTRATION DEVICE (SEE DETAILS MVP-ES9, 9.1, 9.2, 9.3)
- ORANGE CONSTRUCTION SAFETY FENCE
- PROPOSED COMPOST FILTER SOCK (SEE DETAILS MVP-ES3, 3.1, 3.2)
- PROPOSED COMPOST FILTER SOCK (SEE DETAILS MVP-ES3, 3.1, 3.2)
- PROPOSED COMPOST FILTER SOCK (SEE DETAILS MVP-ES3, 3.1, 3.2)
- GRASS-LINED CHANNEL (SEE DETAIL MVP-ES39)
- CLEAN WATER DIVERSION PIPE
- CLEAN WATER DIVERSION DIKE (SEE DETAIL MVP-ES50 AND MVP-ES51)
- STREAM FLOW DIRECTION
- FEMA 100 YEAR FLOODPLAIN
- DRAINAGE AREA BOUNDARY
- TIMBER MAT (SEE DETAIL MVP-ES37)
- STEEP SLOPE EROSION CONTROL (SEE NOTE 2)
- STEEP SLOPE AREAS (SEE NOTE 4)
- PROPOSED ROCK CONSTRUCTION ENTRANCE
- PROPOSED TRENCH BREAKER (SEE DETAIL MVP-20)
- TEMPORARY ROW DIVERSION/WATER BAR (SEE DETAIL MVP-17)
- PERMANENT SLOPE BREAKER/ROW DIVERSION/WATER BAR (SEE DETAIL MVP-17)

COMMONWEALTH OF VIRGINIA
4/7/23
DANIEL C. WITT
Lic. No. 65093
PROFESSIONAL ENGINEER

THIS SEAL APPLIES ONLY TO REVISIONS DATED 04-07-2023

NOTES:

1. TOPSOIL SEGREGATION WILL BE PERFORMED IN ALL IMMEDIATE CONSTRUCTION AREAS OF THE PROJECT IN ACCORDANCE WITH DETAILS MVP-ES46.1 THROUGH MVP-ES46.3.
2. FLEXTERRA, EARTHGUARD OR EQUIVALENT MAY BE USED AS A SUBSTITUTE TO EROSION CONTROL BLANKET AS DIRECTED BY MVP.
3. CONTRACTOR IS RESPONSIBLE TO IDENTIFY ALL UTILITIES. THE UTILITY LINES SHOWN ON THE PLAN ARE FOR INFORMATIONAL PURPOSES ONLY AND DO NOT REPRESENT SURVEYED LINE INFORMATION.
4. SLOPES OF 30° OR GREATER EXIST. CONSTRUCTION FOR STEEP SLOPES TO BE PERFORMED USING STEEP SLOPE TECHNIQUES IDENTIFIED IN THE DETAIL SHEETS. ALSO REFER TO THE SITE-SPECIFIC DESIGN OF STABILIZATION MEASURES IN SELECTED HIGH-HAZARD PORTIONS OF THE ROUTE OF THE PROPOSED MOUNTAIN VALLEY PIPLELINE PROJECT.
5. WHERE CONSTRUCTION CONDITIONS PRECLUDE THE USE OF DIVERSION DITCHES DUE TO SITE CONDITIONS THE CONTRACTOR WILL INSTALL SILT FENCE AT THE DIRECTION OF MVP.
6. IMPROVEMENTS TO PERMANENT AND TEMPORARY ACCESS ROADS WILL BE PERFORMED PER THE SITE SPECIFIC ACCESS ROAD DETAILS.
7. TEMPORARY ACCESS ROAD CROSSING OF STREAMS AND WETLANDS WILL UTILIZE TIMBERMATS. ANY PERMANENT ROAD CROSSINGS WILL BE CONDUCTED VIA CULVERTS.
8. ALL NON VMRC STREAM CROSSINGS WILL BE PERFORMED AS DESCRIBED IN THE STREAM CROSSING TABLE INCLUDED IN THIS PACKAGE.

TETRA TECH CAD FILE PATH: X:\CADD_Pittsburgh\EQT\7157 – MVP\15 – Franklin\E&S\ES Version 5.0.0\7157ES14.35(S10).dwg PLOTTED ON: 3/31/2023 3:34 PM PLOTTED BY: Zeigler, Justin PLOT FILE: ENVIRONMENTAL_COLOR.ctb

NO.:	DATE:	DWN.:	CHKD.:	APPD.:	DESCRIPTION:
–	04/07/23	JJZ	TD	DCW	ADDRESS DEQ COMMENTS ON CROSSING CHANGE METHOD
–	06/04/21	JJZ	RE	DW	CROSSING METHOD CHANGE FROM OPEN CUT TO BORE
5	03/04/18	KAL	RE	DW	ADDRESS VADEQ COMMENTS
4	02/27/18	KAL	RE	DW	ADDRESS VADEQ COMMENTS
3	02/05/18	KAL	RE	DW	ADDRESS VADEQ COMMENTS
2	11/21/17	KAL	RE	DW	ADDRESS VADEQ COMMENTS

REVISIONS:

Mountain Valley PIPELINE

EROSION AND SEDIMENT CONTROL PLANS

MOUNTAIN VALLEY PIPELINE PROJECT – H600 LINE

SPREAD 10 – FRANKLIN COUNTY, VIRGINIA

MOUNTAIN VALLEY PIPELINE, LLC
2200 ENERGY DRIVE
CANONSBURG, PA 15317

TETRA TECH
complex world | CLEAR SOLUTIONS™
661 ANDERSEN DRIVE
FOSTER PLAZA 7
PITTSBURGH, PA 15220

EROSION AND SEDIMENT CONTROL PLANS

COMMONWEALTH OF VIRGINIA
DAVID J. WALLNER
Lic. No. 57593
PROFESSIONAL ENGINEER
5/12/2023

DRAWN BY:	JZ
CHECKED BY:	TD
APPROVED BY:	DCW
DATE:	04/07/2023
SCALE:	AS SHOWN

– REVISION

SHT. NO. 14.35ES OF 14.81ES


LOCATION MAP



PLAN

SCALE: 1" = 100'

100 0 100 200

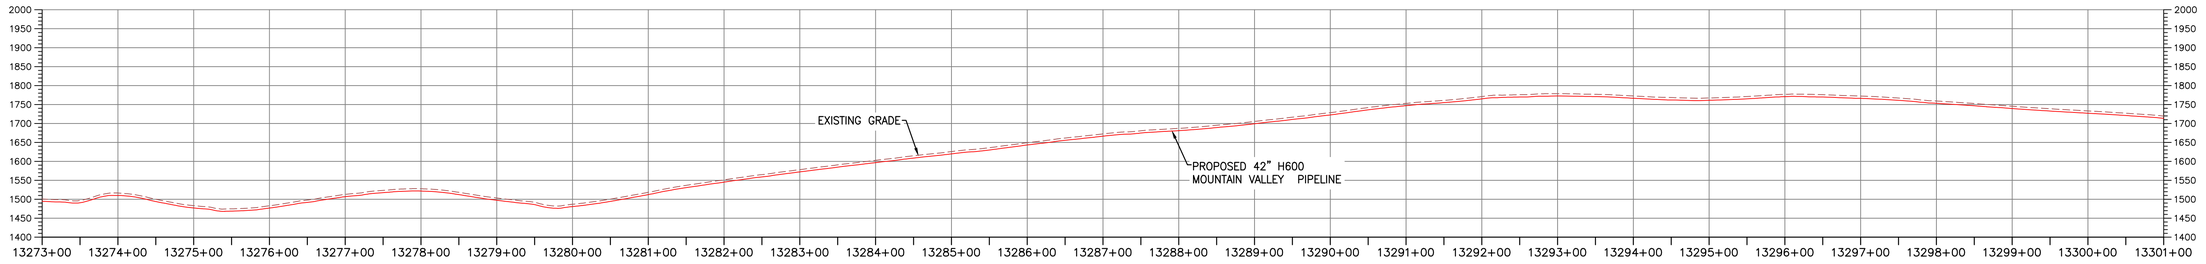

PROFILE

HORIZONTAL SCALE: SCALE: 1" = 100'

100 0 100 200

VERTICAL SCALE: SCALE: 1" = 200'

200 0 200 400

LEGEND

- PROPOSED LIMIT OF DISTURBANCE
- STREAM
- USDA FOREST SERVICE (NATIONAL FOREST) LANDS
- APPALACHIAN NATIONAL SCENIC TRAIL
- EXISTING ROAD/TRAIL
- EXISTING PROPERTY LINE
- EXISTING STATE LINE
- EXISTING COUNTY LINE
- POND
- WETLAND
- ACID FORMING MATERIAL
- EXISTING FOREST
- PROPOSED ACCESS ROAD CENTERLINE
- PROPOSED PIPELINE
- PROPOSED SILT FENCE (SEE NOTE 5)
- PROPOSED SUPER SILT FENCE (SEE DETAIL MVP–ES9.2)
- PROPOSED REINFORCED FILTRATION DEVICE (SEE DETAILS MVP–ES9, 9.1, 9.2, 9.3)
- ORANGE CONSTRUCTION SAFETY FENCE
- PROPOSED COMPOST FILTER SOCK (SEE DETAILS MVP–ES3, 3.1, 3.2)
- PROPOSED COMPOST FILTER SOCK (SEE DETAILS MVP–ES3, 3.1, 3.2)
- PROPOSED COMPOST FILTER SOCK (SEE DETAILS MVP–ES3, 3.1, 3.2)
- GRASS–LINED CHANNEL (SEE DETAIL MVP–ES39)
- CLEAN WATER DIVERSION PIPE
- CLEAN WATER DIVERSION DIKE (SEE DETAIL MVP–ES50 AND MVP–ES51)
- STREAM FLOW DIRECTION
- FEMA 100 YEAR FLOODPLAIN
- DRAINAGE AREA BOUNDARY
- TIMBER MAT (SEE DETAIL MVP–ES37)
- STEEP SLOPE EROSION CONTROL (SEE NOTE 2)
- STEEP SLOPE AREAS (SEE NOTE 4)
- PROPOSED ROCK CONSTRUCTION ENTRANCE
- PROPOSED TRENCH BREAKER (SEE DETAIL MVP–20)
- TEMPORARY ROW DIVERSION/WATER BAR (SEE DETAIL MVP–17)
- PERMANENT SLOPE BREAKER/ROW DIVERSION/WATER BAR (SEE DETAIL MVP–17)

COMMONWEALTH OF VIRGINIA
DANIEL C. WITT
Lic. No. 65093
2/1/2023
PROFESSIONAL ENGINEER

THIS SEAL APPLIES ONLY TO REVISIONS DATED 02-01-23

NOTES:

1. TOPSOIL SEGREGATION WILL BE PERFORMED IN ALL IMMEDIATE CONSTRUCTION AREAS OF THE PROJECT IN ACCORDANCE WITH DETAILS MVP–ES46.1 THROUGH MVP–ES46.3.
2. FLEXTERRA, EARTHGUARD OR EQUIVALENT MAY BE USED AS A SUBSTITUTE TO EROSION CONTROL BLANKET AS DIRECTED BY MVP.
3. CONTRACTOR IS RESPONSIBLE TO IDENTIFY ALL UTILITIES. THE UTILITY LINES SHOWN ON THE PLAN ARE FOR INFORMATIONAL PURPOSES ONLY AND DO NOT REPRESENT SURVEYED LINE INFORMATION.
4. SLOPES OF 30" OR GREATER EXIST. CONSTRUCTION FOR STEEP SLOPES TO BE PERFORMED USING STEEP SLOPE TECHNIQUES IDENTIFIED IN THE DETAIL SHEETS. ALSO REFER TO THE SITE–SPECIFIC DESIGN OF STABILIZATION MEASURES IN SELECTED HIGH–HAZARD PORTIONS OF THE ROUTE OF THE PROPOSED MOUNTAIN VALLEY PIPELINE PROJECT.
5. WHERE CONSTRUCTION CONDITIONS PRECLUDE THE USE OF DIVERSION DITCHES DUE TO SITE CONDITIONS THE CONTRACTOR WILL INSTALL SILT FENCE AT THE DIRECTION OF MVP.
6. IMPROVEMENTS TO PERMANENT AND TEMPORARY ACCESS ROADS WILL BE PERFORMED PER THE SITE SPECIFIC ACCESS ROAD DETAILS.
7. TEMPORARY ACCESS ROAD CROSSING OF STREAMS AND WETLANDS WILL UTILIZE TIMBERMATS. ANY PERMANENT ROAD CROSSINGS WILL BE CONDUCTED VIA CULVERTS.
8. ALL NON VMRC STREAM CROSSINGS WILL BE PERFORMED AS DESCRIBED IN THE STREAM CROSSING TABLE INCLUDED IN THIS PACKAGE.

NO.:	DATE:	DWN.:	CHKD.:	APPD.:	DESCRIPTION:
–	02/01/23	GAR	TD	DW	ADDRESS VADEQ COMMENTS ON CROSSING METHOD CHANGE
–	05/12/21	JJZ	RE	DW	CROSSING METHOD CHANGE FROM OPEN CUT TO BORE
5	03/04/18	KAL	RE	DW	ADDRESS VADEQ COMMENTS
4	02/27/18	KAL	RE	DW	ADDRESS VADEQ COMMENTS

REVISIONS:

Mountain Valley PIPELINE

EROSION AND SEDIMENT CONTROL PLANS

MOUNTAIN VALLEY PIPELINE PROJECT – H600 LINE

SPREAD 10 – FRANKLIN COUNTY, VIRGINIA

MOUNTAIN VALLEY PIPELINE, LLC
2200 ENERGY DRIVE
CANONSBURG, PA 15317

TETRA TECH
complex world | CLEAR SOLUTIONS™
661 ANDERSEN DRIVE
FOSTER PLAZA 7
PITTSBURGH, PA 15220


EROSION AND SEDIMENT CONTROL PLANS

COMMONWEALTH OF VIRGINIA
DAVID J. WALLNER
Lic. No. 57593
5/12/2023
PROFESSIONAL ENGINEER

DRAWN BY:	JJZ
CHECKED BY:	RE
APPROVED BY:	DW
DATE:	02/01/2023
SCALE:	AS SHOWN
SHT. NO.	14.36ES OF 14.81ES

REVISION –

TETRA TECH CAD FILE PATH: X:\CADD_Pittsburgh\EQT\7157 – MVP\15 – Franklin\E&S\ES Version 5.0.0\7157ES14.36(S10).dwg PLOTTED ON: 9/16/2022 8:34 AM PLOTTED BY: Zeigler, Justin PLOT FILE: ENVIRONMENTAL_COLOR.ctb

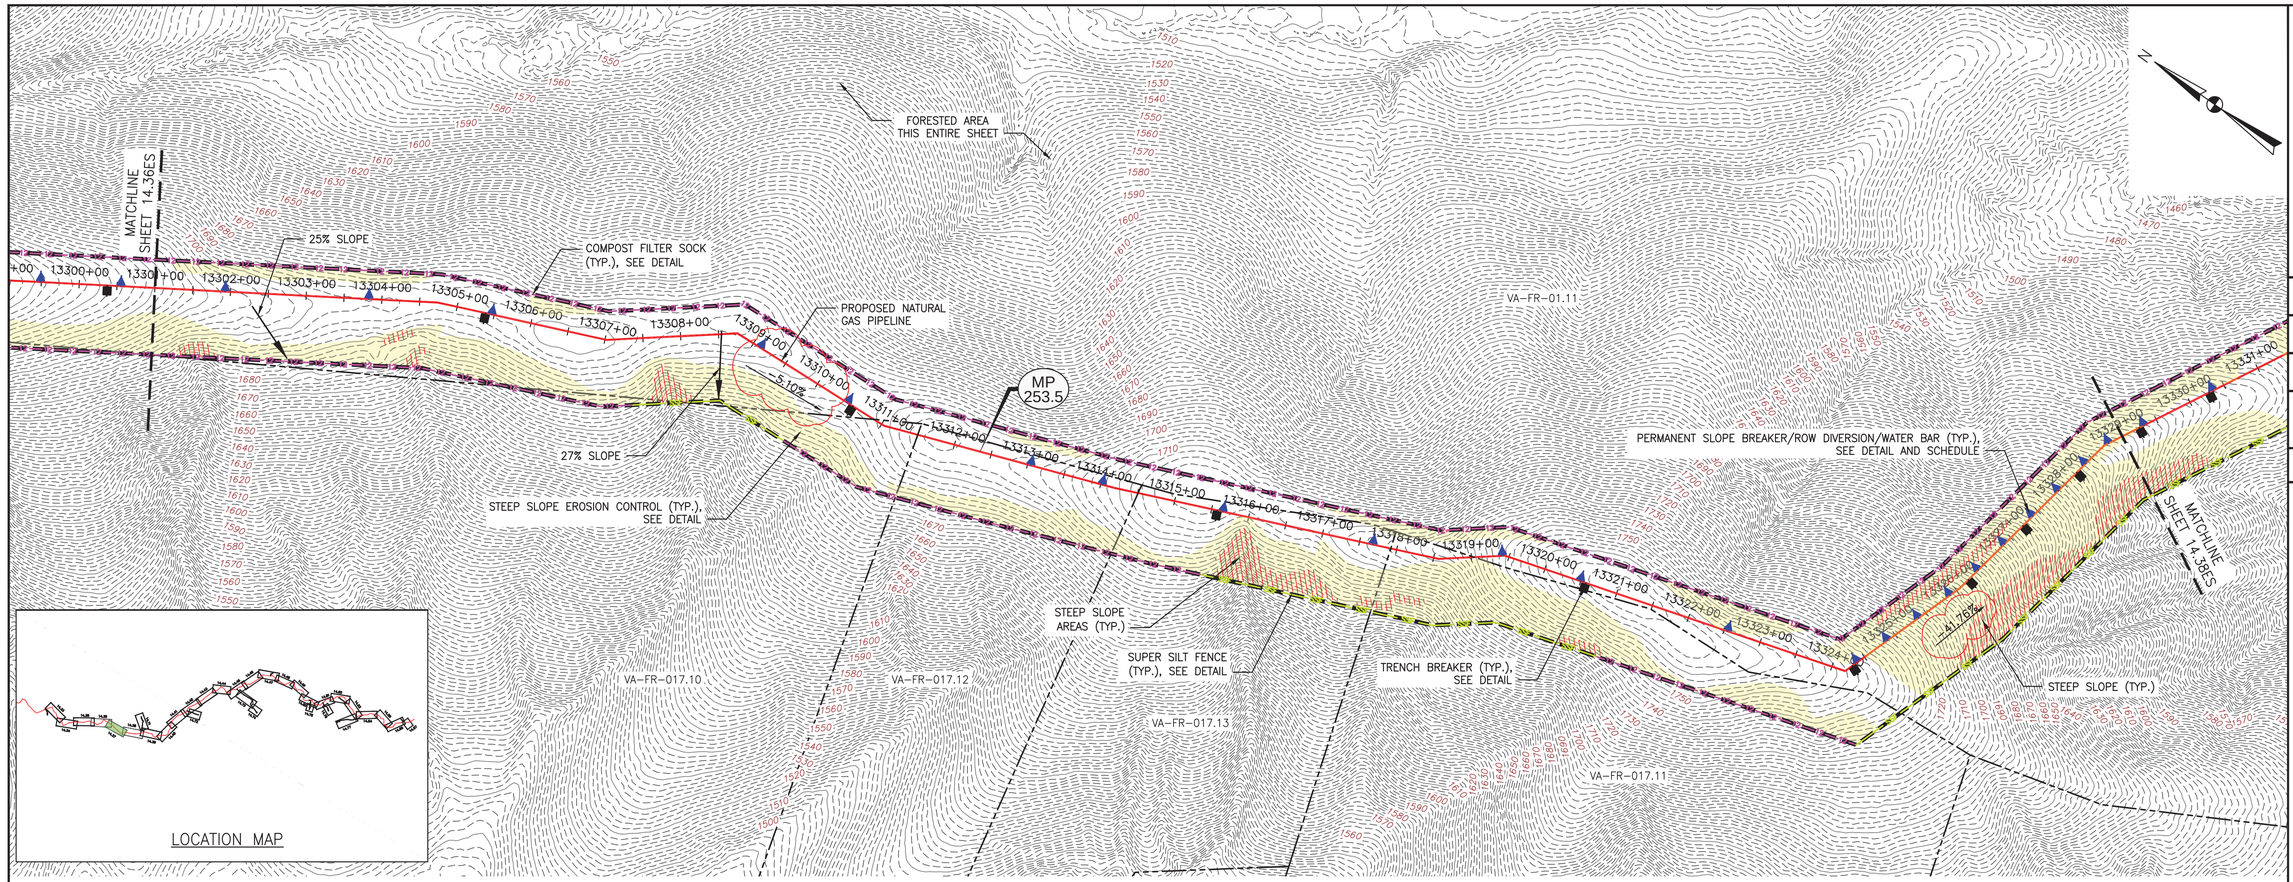


LOCATION MAP

PLAN

SCALE: 1" = 100'

100 0 100 200

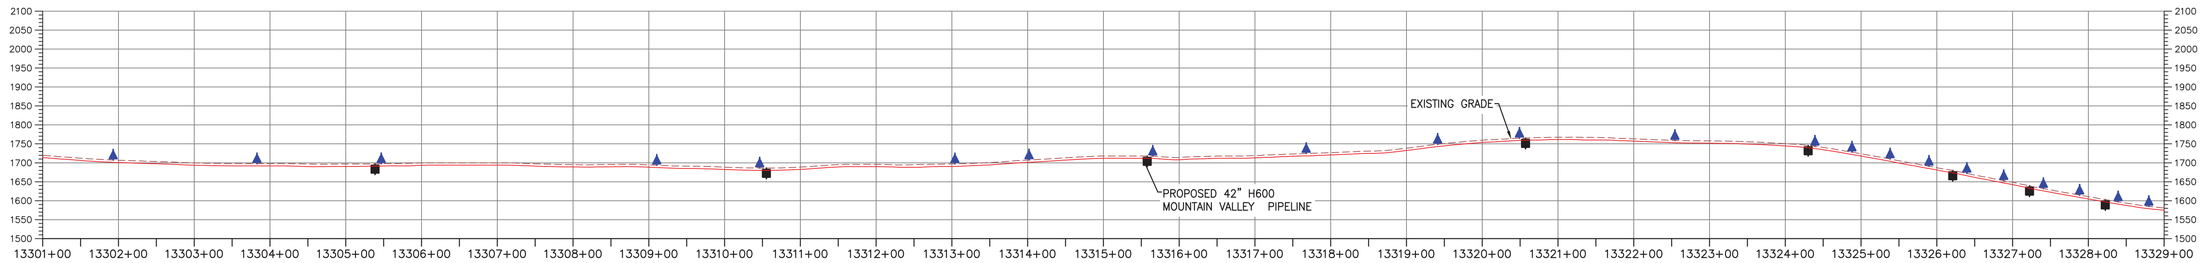

PROFILE

HORIZONTAL SCALE: SCALE: 1" = 100'

VERTICAL SCALE: SCALE: 1" = 50'

100 0 100 200 0 50 100

LEGEND

- PROPOSED LIMIT OF DISTURBANCE
- STREAM
- USDA FOREST SERVICE (NATIONAL FOREST) LANDS
- ANST — ANST — APPALACHIAN NATIONAL SCENIC TRAIL
- EXISTING ROAD/TRAIL
- EXISTING PROPERTY LINE
- EXISTING STATE LINE
- EXISTING COUNTY LINE
- POND
- WETLAND
- AFM — AFM — ACID FORMING MATERIAL
- AGRI — AGRI — AGRICULTURAL LAND USE BOUNDARY
- PROPOSED ACCESS ROAD CENTERLINE
- PROPOSED PIPELINE
- SF — SF — PROPOSED SILT FENCE (SEE NOTE 5)
- SSF — SSF — PROPOSED SUPER SILT FENCE (SEE DETAIL MVP-ES9.2)
- RFD — RFD — PROPOSED REINFORCED FILTRATION DEVICE (SEE DETAILS MVP-ES9, 9.1, 9.2, 9.3)
- OCSF — ORANGE CONSTRUCTION SAFETY FENCE
- 12 — 12 — 12 — 12 — PROPOSED COMPOST FILTER SOCK (SEE DETAILS MVP-ES3, 3.1, 3.2)
- 18 — 18 — 18 — 18 — PROPOSED COMPOST FILTER SOCK (SEE DETAILS MVP-ES3, 3.1, 3.2)
- 24 — 24 — 24 — 24 — PROPOSED COMPOST FILTER SOCK (SEE DETAILS MVP-ES3, 3.1, 3.2)
- GRASS-LINED CHANNEL (SEE DETAIL MVP-ES39)
- CLEAN WATER DIVERSION PIPE
- CLEAN WATER DIVERSION DIKE (SEE DETAIL MVP-ES50 AND MVP-ES51)
- STREAM FLOW DIRECTION
- FEMA 100 YEAR FLOODPLAIN
- DRAINAGE AREA BOUNDARY
- TIMBER MAT (SEE DETAIL MVP-ES37)
- STEEP SLOPE EROSION CONTROL (SEE NOTE 2)
- STEEP SLOPE AREAS (SEE NOTE 4)
- PROPOSED ROCK CONSTRUCTION ENTRANCE
- PROPOSED TRENCH BREAKER (SEE DETAIL MVP-20)
- TEMPORARY ROW DIVERSION/WATER BAR (VADEQ STD & SPEC 3.11)
- PERMANENT SLOPE BREAKER/ROW DIVERSION/WATER BAR (SEE DETAILS MVP-17, ES38, AND SCHEDULE)

NOTES:

1. TOPSOIL SEGREGATION WILL BE PERFORMED IN ALL IMMEDIATE CONSTRUCTION AREAS OF THE PROJECT IN ACCORDANCE WITH DETAILS MVP-ES46.1 THROUGH MVP-ES46.3.
2. FLEXTERRA, EARTHGUARD OR EQUIVALENT MAY BE USED AS A SUBSTITUTE TO EROSION CONTROL BLANKET AS DIRECTED BY MVP.
3. CONTRACTOR IS RESPONSIBLE TO IDENTIFY ALL UTILITIES. THE UTILITY LINES SHOWN ON THE PLAN ARE FOR INFORMATIONAL PURPOSES ONLY AND DO NOT REPRESENT SURVEYED LINE INFORMATION.
4. SLOPES OF 30° OR GREATER EXIST. CONSTRUCTION FOR STEEP SLOPES TO BE PERFORMED USING STEEP SLOPE TECHNIQUES IDENTIFIED IN THE DETAIL SHEETS. ALSO REFER TO THE SITE-SPECIFIC DESIGN OF STABILIZATION MEASURES IN SELECTED HIGH-HAZARD PORTIONS OF THE ROUTE OF THE PROPOSED MOUNTAIN VALLEY PIPELINE PROJECT.
5. WHERE CONSTRUCTION CONDITIONS PRECLUDE THE USE OF DIVERSION DITCHES DUE TO SITE CONDITIONS THE CONTRACTOR WILL INSTALL SILT FENCE AT THE DIRECTION OF MVP.
6. IMPROVEMENTS TO PERMANENT AND TEMPORARY ACCESS ROADS WILL BE PERFORMED PER THE SITE SPECIFIC ACCESS ROAD DETAILS.
7. TEMPORARY ACCESS ROAD CROSSING OF STREAMS AND WETLANDS WILL UTILIZE TIMBERMATS. ANY PERMANENT ROAD CROSSINGS WILL BE CONDUCTED VIA CULVERTS.
8. ALL NON VMRC STREAM CROSSINGS WILL BE PERFORMED AS DESCRIBED IN THE STREAM CROSSING TABLE INCLUDED IN THIS PACKAGE.

NO.	DATE:	DWN.:	CHKD.:	APPD.:	DESCRIPTION:
5	03/04/18	KAL	RE	DW	ADDRESS VADEQ COMMENTS
4	02/27/18	KAL	RE	DW	ADDRESS VADEQ COMMENTS
3	02/05/18	KAL	RE	DW	ADDRESS VADEQ COMMENTS
2	11/21/17	KAL	RE	DW	ADDRESS VADEQ COMMENTS
1	09/21/17	KAL	RE	DW	PLAN SUBMISSION

REVISIONS:

Mountain Valley PIPELINE

EROSION AND SEDIMENT CONTROL PLANS

MOUNTAIN VALLEY PIPELINE PROJECT – H600 LINE

SPREAD 10 – FRANKLIN COUNTY, VIRGINIA

MOUNTAIN VALLEY PIPELINE, LLC
535 SOUTHPOINTE BOULEVARD, SUITE 200
CANONSBURG, PA 15317

TETRA TECH
complex world | CLEAR SOLUTIONS™
661 ANDERSEN DRIVE
FOSTER PLAZA 7
PITTSBURGH, PA 15220


EROSION AND SEDIMENT CONTROL PLANS

COMMONWEALTH OF VIRGINIA
DAVID J. WALLNER
Lic. No. 0402057593
PROFESSIONAL ENGINEER

DRAWN BY:	KAL
CHECKED BY:	RE
APPROVED BY:	DW
DATE:	03/04/2018
SCALE:	AS SHOWN
SHT. NO.	14.37ES OF 14.81ES

REVISION


LOCATION MAP

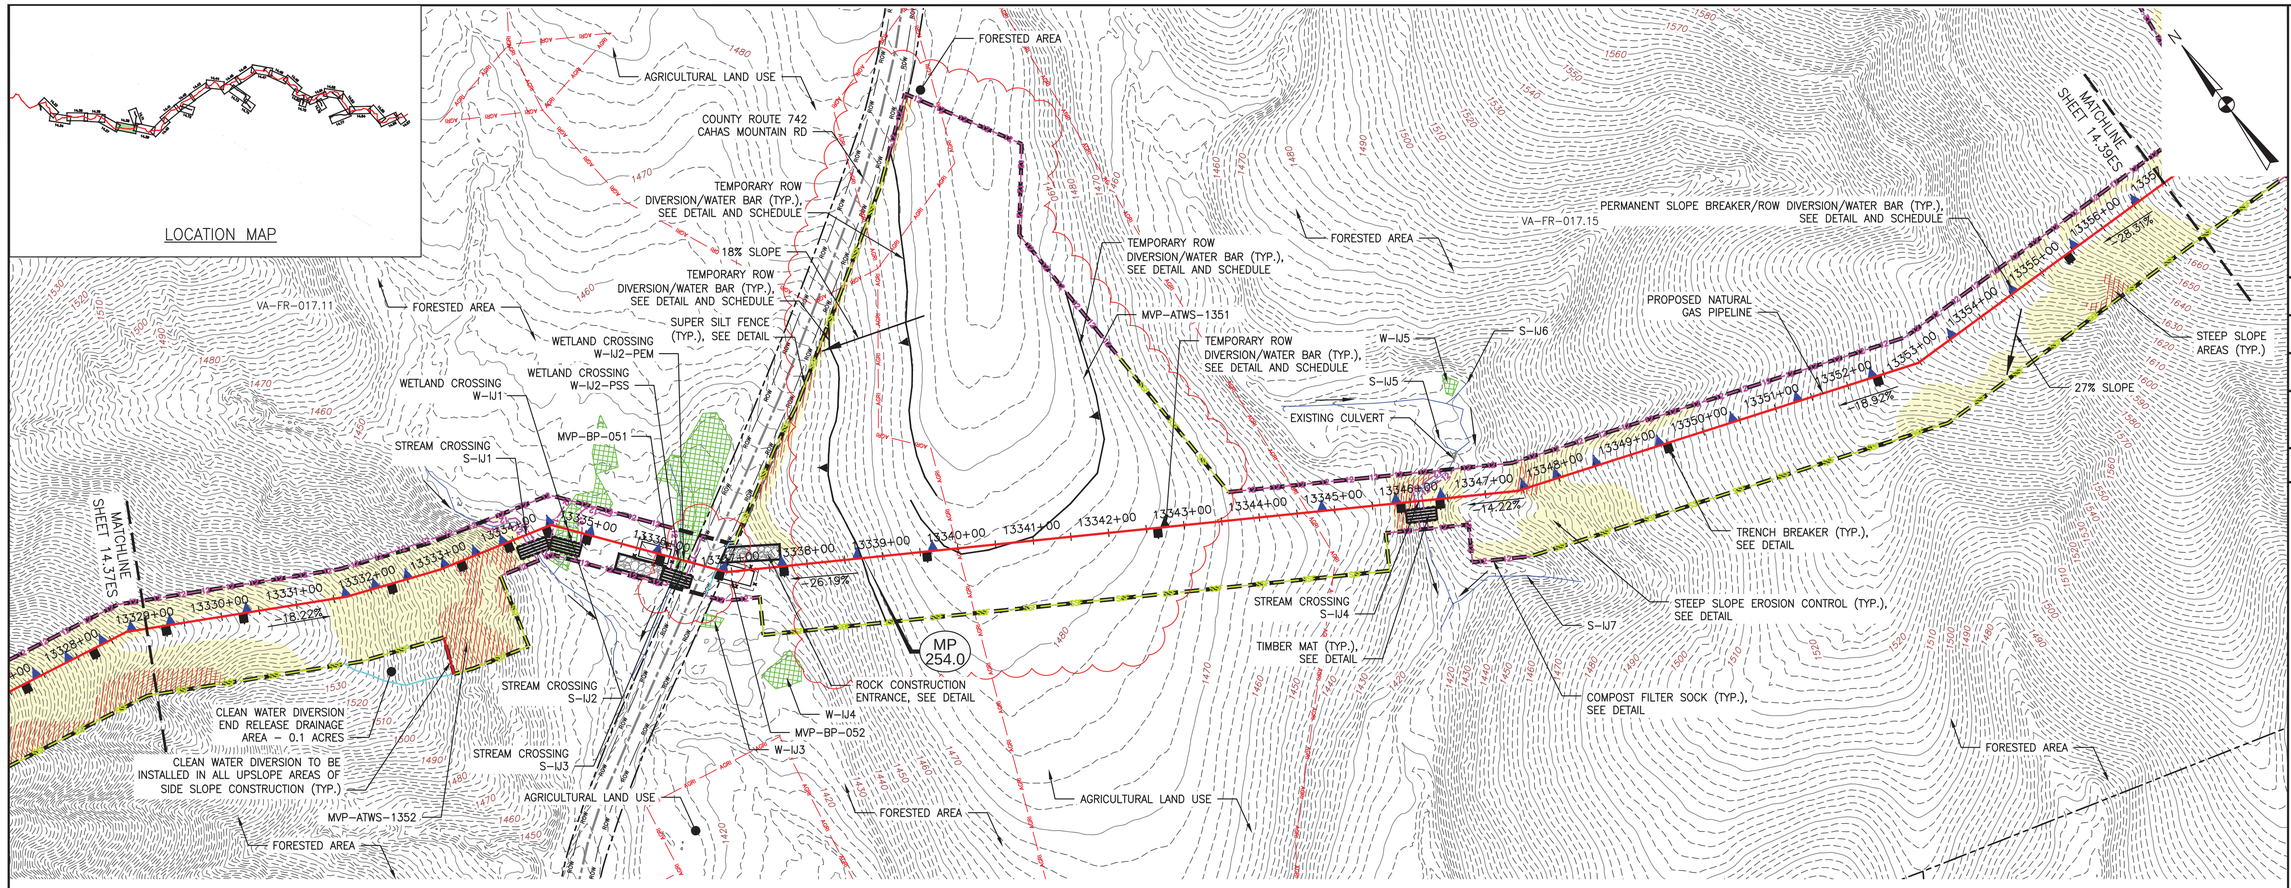

PLAN

SCALE: 1" = 100'

100 0 100 200

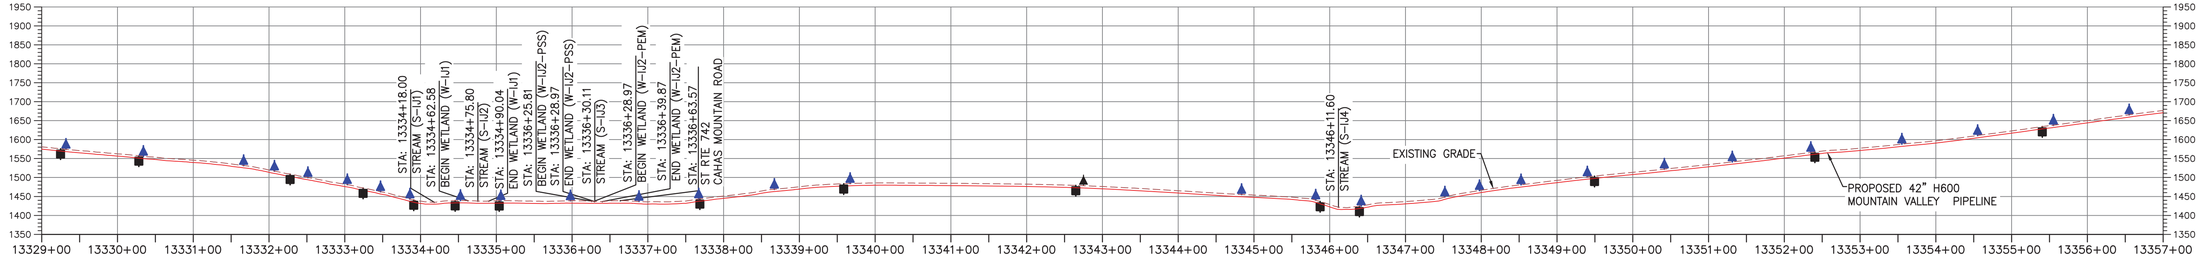

PROFILE

HORIZONTAL SCALE:

SCALE: 1" = 100'

100 0 100 200

VERTICAL SCALE:

SCALE: 1" = 50'

50 0 50 100

LEGEND

- PROPOSED LIMIT OF DISTURBANCE
- STREAM
- USDA FOREST SERVICE (NATIONAL FOREST) LANDS
- APPALACHIAN NATIONAL SCENIC TRAIL
- EXISTING ROAD/TRAIL
- EXISTING PROPERTY LINE
- EXISTING STATE LINE
- EXISTING COUNTY LINE
- POND
- WETLAND
- ACID FORMING MATERIAL
- AGRICULTURAL LAND USE BOUNDARY
- PROPOSED ACCESS ROAD CENTERLINE
- PROPOSED PIPELINE
- PROPOSED SILT FENCE (SEE NOTE 5)
- PROPOSED SUPER SILT FENCE (SEE DETAIL MVP-ES9.2)
- PROPOSED REINFORCED FILTRATION DEVICE (SEE DETAILS MVP-ES9, 9.1, 9.2, 9.3)
- ORANGE CONSTRUCTION SAFETY FENCE
- PROPOSED COMPOST FILTER SOCK (SEE DETAILS MVP-ES3, 3.1, 3.2)
- PROPOSED COMPOST FILTER SOCK (SEE DETAILS MVP-ES3, 3.1, 3.2)
- PROPOSED COMPOST FILTER SOCK (SEE DETAILS MVP-ES3, 3.1, 3.2)
- GRASS-LINED CHANNEL (SEE DETAIL MVP-ES39)
- CLEAN WATER DIVERSION PIPE
- CLEAN WATER DIVERSION DIKE (SEE DETAIL MVP-ES50 AND MVP-ES51)
- STREAM FLOW DIRECTION
- FEMA 100 YEAR FLOODPLAIN
- DRAINAGE AREA BOUNDARY
- TIMBER MAT (SEE DETAIL MVP-ES37)
- STEEP SLOPE EROSION CONTROL (SEE NOTE 2)
- STEEP SLOPE AREAS (SEE NOTE 4)
- PROPOSED ROCK CONSTRUCTION ENTRANCE
- PROPOSED TRENCH BREAKER (SEE DETAIL MVP-20)
- TEMPORARY ROW DIVERSION/WATER BAR (VADEQ STD & SPEC 3.11)
- PERMANENT SLOPE BREAKER/ROW DIVERSION/WATER BAR (SEE DETAILS MVP-17, ES38, AND SCHEDULE)

NOTES:

1. TOPSOIL SEGREGATION WILL BE PERFORMED IN ALL IMMEDIATE CONSTRUCTION AREAS OF THE PROJECT IN ACCORDANCE WITH DETAILS MVP-ES46.1 THROUGH MVP-ES46.3.
2. FLEXTERRA, EARTHGUARD OR EQUIVALENT MAY BE USED AS A SUBSTITUTE TO EROSION CONTROL BLANKET AS DIRECTED BY MVP.
3. CONTRACTOR IS RESPONSIBLE TO IDENTIFY ALL UTILITIES. THE UTILITY LINES SHOWN ON THE PLAN ARE FOR INFORMATIONAL PURPOSES ONLY AND DO NOT REPRESENT SURVEYED LINE INFORMATION.
4. SLOPES OF 30° OR GREATER EXIST. CONSTRUCTION FOR STEEP SLOPES TO BE PERFORMED USING STEEP SLOPE TECHNIQUES IDENTIFIED IN THE DETAIL SHEETS. ALSO REFER TO THE SITE-SPECIFIC DESIGN OF STABILIZATION MEASURES IN SELECTED HIGH-HAZARD PORTIONS OF THE ROUTE OF THE PROPOSED MOUNTAIN VALLEY PIPELINE PROJECT.
5. WHERE CONSTRUCTION CONDITIONS PRECLUDE THE USE OF DIVERSION DITCHES DUE TO SITE CONDITIONS THE CONTRACTOR WILL INSTALL SILT FENCE AT THE DIRECTION OF MVP.
6. IMPROVEMENTS TO PERMANENT AND TEMPORARY ACCESS ROADS WILL BE PERFORMED PER THE SITE SPECIFIC ACCESS ROAD DETAILS.
7. TEMPORARY ACCESS ROAD CROSSING OF STREAMS AND WETLANDS WILL UTILIZE TIMBERMATS. ANY PERMANENT ROAD CROSSINGS WILL BE CONDUCTED VIA CULVERTS.
8. ALL NON VMRC STREAM CROSSINGS WILL BE PERFORMED AS DESCRIBED IN THE STREAM CROSSING TABLE INCLUDED IN THIS PACKAGE.

TETRA TECH CAD FILE PATH: X:\CADD_Pittsburgh\EQT\7157 - MVP\15 - Franklin\E&S\ES Version 5.0.0\7157ES14.38(S10).dwg PLOTTED ON: 3/2/2018 2:48 PM PLOTTED BY: Zeigler, Justin PLOT FILE: ENVIRONMENTAL_COLOR.ctb

NO.	DATE:	DWN.:	CHKD.:	APPD.:	DESCRIPTION:
5	03/04/18	KAL	RE	DW	ADDRESS VADEQ COMMENTS
4	02/27/18	KAL	RE	DW	ADDRESS VADEQ COMMENTS
3	02/05/18	KAL	RE	DW	ADDRESS VADEQ COMMENTS
2	11/21/17	KAL	RE	DW	ADDRESS VADEQ COMMENTS
1	09/21/17	KAL	RE	DW	PLAN SUBMISSION

REVISIONS:

Mountain Valley PIPELINE

EROSION AND SEDIMENT CONTROL PLANS

MOUNTAIN VALLEY PIPELINE PROJECT – H600 LINE

SPREAD 10 – FRANKLIN COUNTY, VIRGINIA

MOUNTAIN VALLEY PIPELINE, LLC
555 SOUTHPOINTE BOULEVARD, SUITE 200
CANONSBURG, PA 15317


TETRA TECH
complex world | CLEAR SOLUTIONS™
661 ANDERSEN DRIVE
FOSTER PLAZA 7
PITTSBURGH, PA 15220

EROSION AND SEDIMENT CONTROL PLANS

COMMONWEALTH OF VIRGINIA
DAVID J. WALLNER
Lic. No. 0402057593
PROFESSIONAL ENGINEER

DRAWN BY:	KAL
CHECKED BY:	RE
APPROVED BY:	DW
DATE:	03/04/2018
SCALE:	AS SHOWN
REVISION	5


SHT. NO. 14.38ES OF 14.81ES

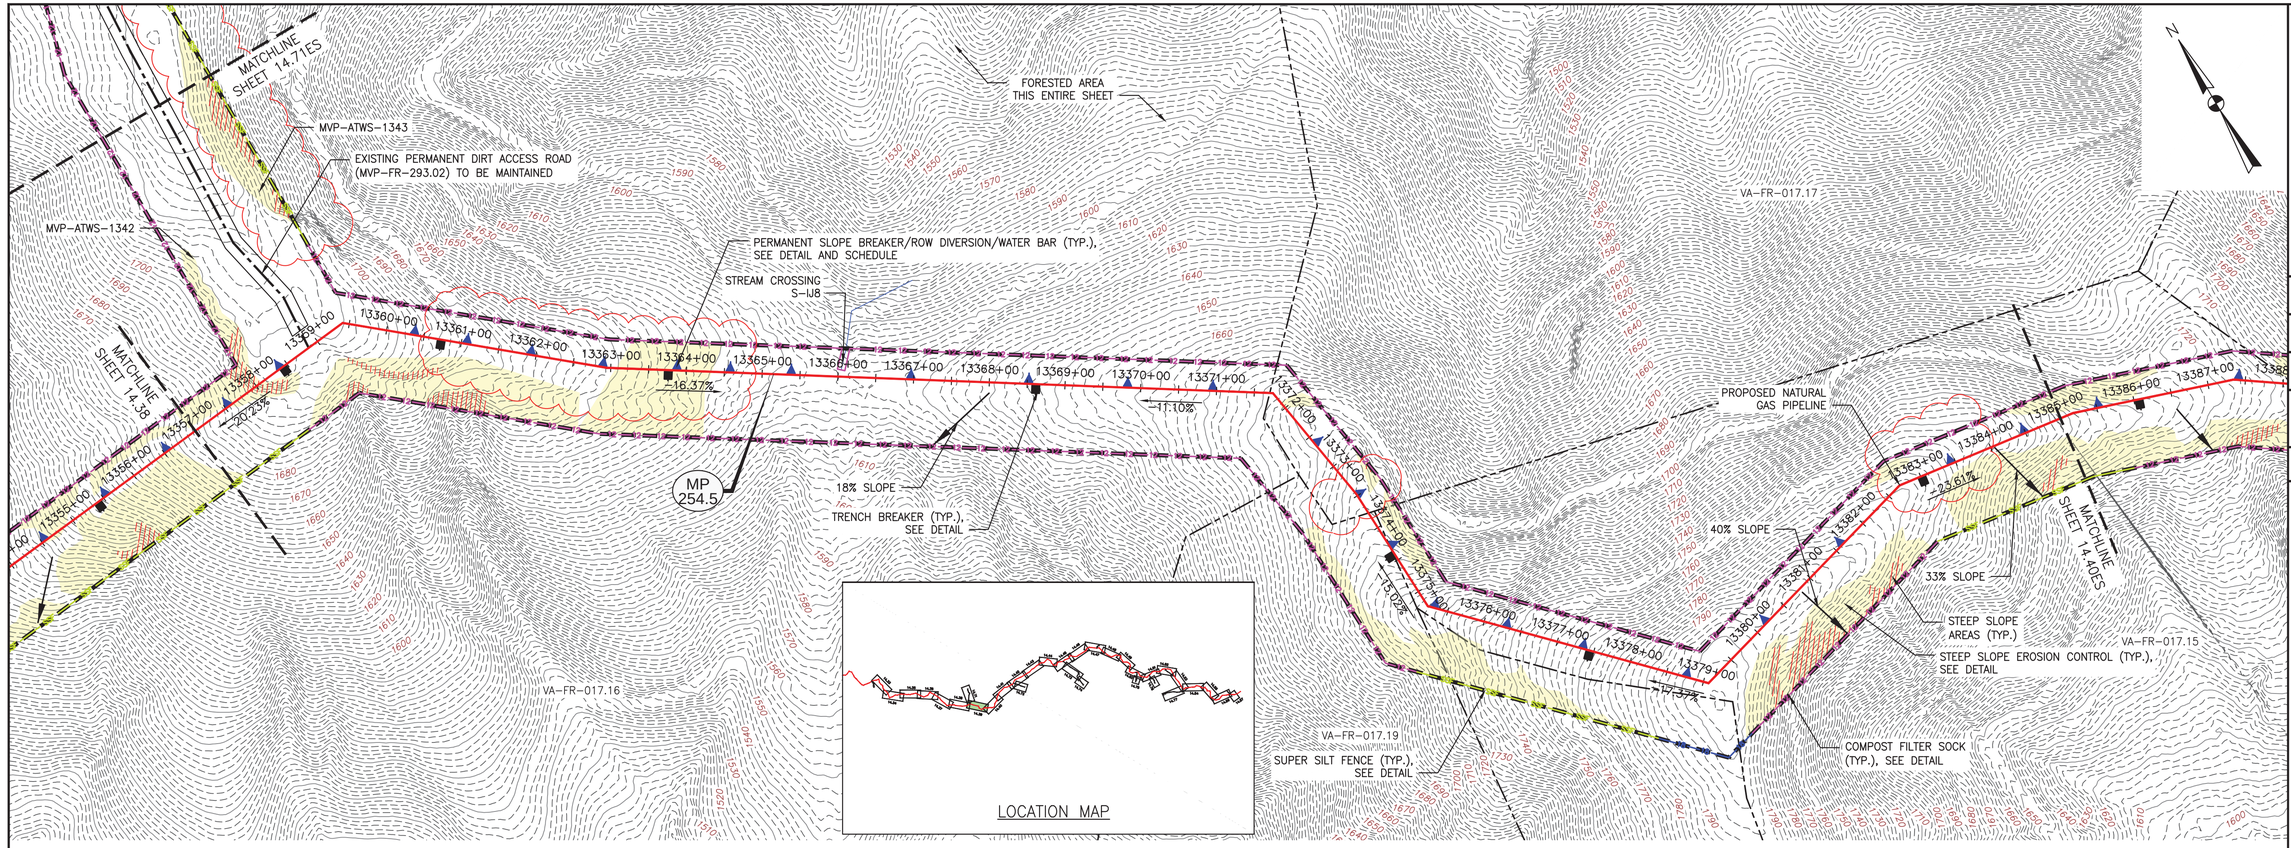

PLAN

SCALE: 1" = 100'

100 0 100 200

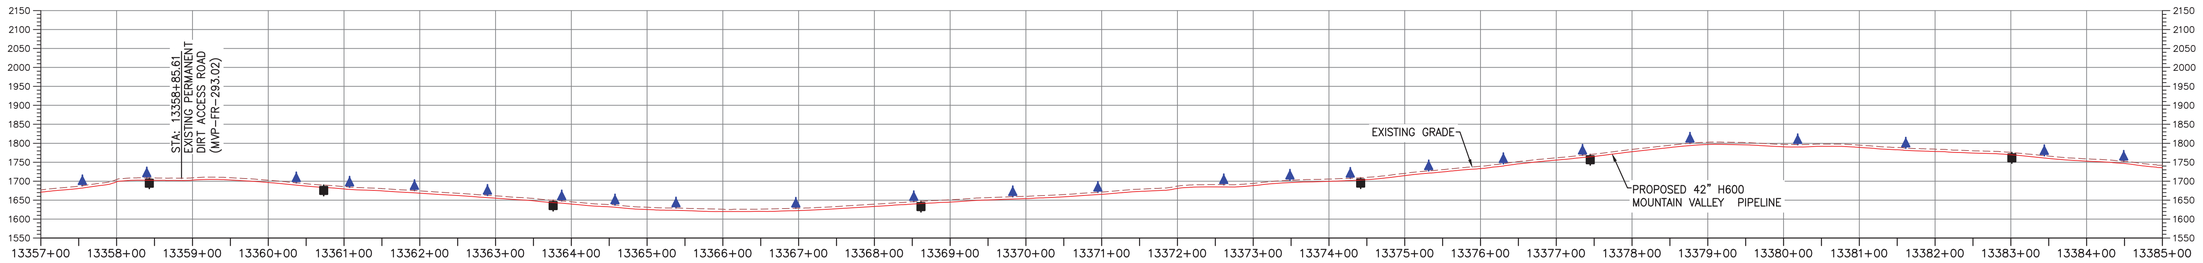

PROFILE

HORIZONTAL SCALE: SCALE: 1" = 100'

VERTICAL SCALE: SCALE: 1" = 200'

LEGEND

- PROPOSED LIMIT OF DISTURBANCE
- STREAM
- USDA FOREST SERVICE (NATIONAL FOREST) LANDS
- APPALACHIAN NATIONAL SCENIC TRAIL
- EXISTING ROAD/TRAIL
- EXISTING PROPERTY LINE
- EXISTING STATE LINE
- EXISTING COUNTY LINE
- POND
- WETLAND
- ACID FORMING MATERIAL
- AGRICULTURAL LAND USE BOUNDARY
- PROPOSED ACCESS ROAD CENTERLINE
- PROPOSED PIPELINE
- PROPOSED SILT FENCE (SEE NOTE 5)
- PROPOSED SUPER SILT FENCE (SEE DETAIL MVP-ES9.2)
- PROPOSED REINFORCED FILTRATION DEVICE (SEE DETAILS MVP-ES9, 9.1, 9.2, 9.3)
- ORANGE CONSTRUCTION SAFETY FENCE
- PROPOSED COMPOST FILTER SOCK (SEE DETAILS MVP-ES3, 3.1, 3.2)
- PROPOSED COMPOST FILTER SOCK (SEE DETAILS MVP-ES3, 3.1, 3.2)
- PROPOSED COMPOST FILTER SOCK (SEE DETAILS MVP-ES3, 3.1, 3.2)
- GRASS-LINED CHANNEL (SEE DETAIL MVP-ES39)
- CLEAN WATER DIVERSION PIPE
- CLEAN WATER DIVERSION DIKE (SEE DETAIL MVP-ES50 AND MVP-ES51)
- STREAM FLOW DIRECTION
- FEMA 100 YEAR FLOODPLAIN
- DRAINAGE AREA BOUNDARY
- TIMBER MAT (SEE DETAIL MVP-ES37)
- STEEP SLOPE EROSION CONTROL (SEE NOTE 2)
- STEEP SLOPE AREAS (SEE NOTE 4)
- PROPOSED ROCK CONSTRUCTION ENTRANCE
- PROPOSED TRENCH BREAKER (SEE DETAIL MVP-20)
- TEMPORARY ROW DIVERSION/WATER BAR (VADEQ STD & SPEC 3.11)
- PERMANENT SLOPE BREAKER/ROW DIVERSION/WATER BAR (SEE DETAILS MVP-17, ES38, AND SCHEDULE)

NOTES:

1. TOPSOIL SEGREGATION WILL BE PERFORMED IN ALL IMMEDIATE CONSTRUCTION AREAS OF THE PROJECT IN ACCORDANCE WITH DETAILS MVP-ES46.1 THROUGH MVP-ES46.3.
2. FLEXTERRA, EARTHGUARD OR EQUIVALENT MAY BE USED AS A SUBSTITUTE TO EROSION CONTROL BLANKET AS DIRECTED BY MVP.
3. CONTRACTOR IS RESPONSIBLE TO IDENTIFY ALL UTILITIES. THE UTILITY LINES SHOWN ON THE PLAN ARE FOR INFORMATIONAL PURPOSES ONLY AND DO NOT REPRESENT SURVEYED LINE INFORMATION.
4. SLOPES OF 30' OR GREATER EXIST. CONSTRUCTION FOR STEEP SLOPES TO BE PERFORMED USING STEEP SLOPE TECHNIQUES IDENTIFIED IN THE DETAIL SHEETS. ALSO REFER TO THE SITE-SPECIFIC DESIGN OF STABILIZATION MEASURES IN SELECTED HIGH-HAZARD PORTIONS OF THE ROUTE OF THE PROPOSED MOUNTAIN VALLEY PIPLELINE PROJECT.
5. WHERE CONSTRUCTION CONDITIONS PRECLUDE THE USE OF DIVERSION DITCHES DUE TO SITE CONDITIONS THE CONTRACTOR WILL INSTALL SILT FENCE AT THE DIRECTION OF MVP.
6. IMPROVEMENTS TO PERMANENT AND TEMPORARY ACCESS ROADS WILL BE PERFORMED PER THE SITE SPECIFIC ACCESS ROAD DETAILS.
7. TEMPORARY ACCESS ROAD CROSSING OF STREAMS AND WETLANDS WILL UTILIZE TIMBERMATS. ANY PERMANENT ROAD CROSSINGS WILL BE CONDUCTED VIA CULVERTS.
8. ALL NON VMRC STREAM CROSSINGS WILL BE PERFORMED AS DESCRIBED IN THE STREAM CROSSING TABLE INCLUDED IN THIS PACKAGE.

NO.	DATE:	DWN.:	CHKD.:	APPD.:	DESCRIPTION:
5	03/04/18	KAL	RE	DW	ADDRESS VADEQ COMMENTS
4	02/27/18	KAL	RE	DW	ADDRESS VADEQ COMMENTS
3	02/05/18	KAL	RE	DW	ADDRESS VADEQ COMMENTS
2	11/21/17	KAL	RE	DW	ADDRESS VADEQ COMMENTS
1	09/21/17	KAL	RE	DW	PLAN SUBMISSION

REVISIONS:

Mountain Valley PIPELINE

EROSION AND SEDIMENT CONTROL PLANS

MOUNTAIN VALLEY PIPELINE PROJECT – H600 LINE

SPREAD 10 – FRANKLIN COUNTY, VIRGINIA


MOUNTAIN VALLEY PIPELINE, LLC
555 SOUTHPOINTE BOULEVARD, SUITE 200
CANONSBURG, PA 15317

TETRA TECH
complex world | CLEAR SOLUTIONS™
661 ANDERSEN DRIVE
FOSTER PLAZA 7
PITTSBURGH, PA 15220

EROSION AND SEDIMENT CONTROL PLANS

COMMONWEALTH OF VIRGINIA
DAVID J. WALLNER
Lic. No. 0402057593
PROFESSIONAL ENGINEER


DRAWN BY:	KAL
CHECKED BY:	RE
APPROVED BY:	DW
DATE:	03/04/2018
SCALE:	AS SHOWN
REVISION	
SHT. NO.	14.39ES OF 14.81ES

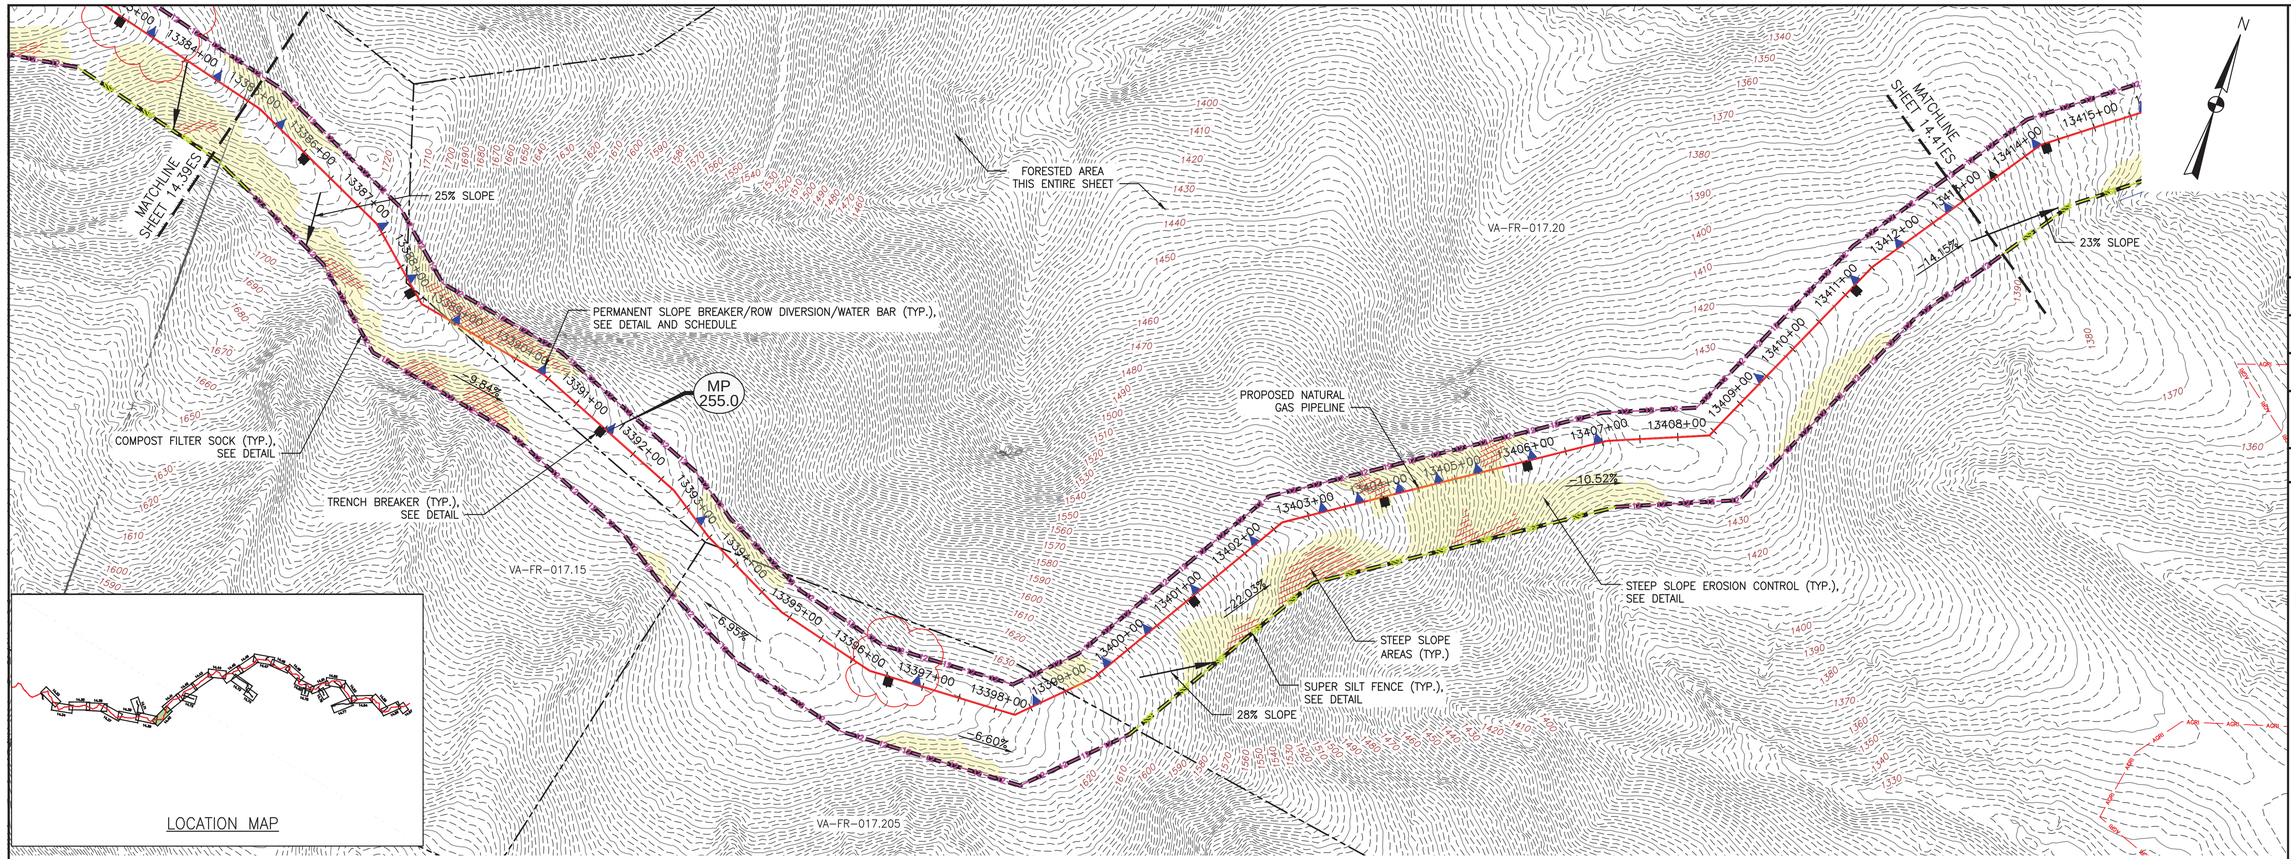

LOCATION MAP

PLAN

SCALE: 1" = 100'

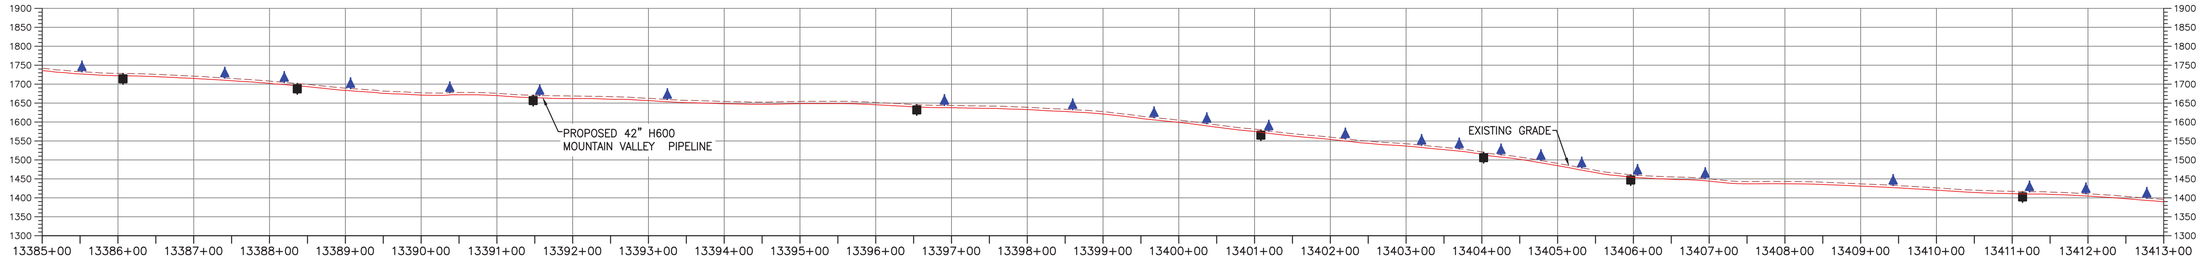

PROFILE

HORIZONTAL SCALE: SCALE: 1" = 100'

VERTICAL SCALE: SCALE: 1" = 200'

LEGEND

- PROPOSED LIMIT OF DISTURBANCE
- STREAM
- USDA FOREST SERVICE (NATIONAL FOREST) LANDS
- APPALACHIAN NATIONAL SCENIC TRAIL
- EXISTING ROAD/TRAIL
- EXISTING PROPERTY LINE
- EXISTING STATE LINE
- EXISTING COUNTY LINE
- POND
- WETLAND
- ACID FORMING MATERIAL
- AGRICULTURAL LAND USE BOUNDARY
- PROPOSED ACCESS ROAD CENTERLINE
- PROPOSED PIPELINE
- PROPOSED SILT FENCE (SEE NOTE 5)
- PROPOSED SUPER SILT FENCE (SEE DETAIL MVP-ES9.2)
- PROPOSED REINFORCED FILTRATION DEVICE (SEE DETAILS MVP-ES9, 9.1, 9.2, 9.3)
- ORANGE CONSTRUCTION SAFETY FENCE
- PROPOSED COMPOST FILTER SOCK (SEE DETAILS MVP-ES3, 3.1, 3.2)
- PROPOSED COMPOST FILTER SOCK (SEE DETAILS MVP-ES3, 3.1, 3.2)
- PROPOSED COMPOST FILTER SOCK (SEE DETAILS MVP-ES3, 3.1, 3.2)
- GRASS-LINED CHANNEL (SEE DETAIL MVP-ES39)
- CLEAN WATER DIVERSION PIPE
- CLEAN WATER DIVERSION DIKE (SEE DETAIL MVP-ES50 AND MVP-ES51)
- STREAM FLOW DIRECTION
- FEMA 100 YEAR FLOODPLAIN
- DRAINAGE AREA BOUNDARY
- TIMBER MAT (SEE DETAIL MVP-ES37)
- STEEP SLOPE EROSION CONTROL (SEE NOTE 2)
- STEEP SLOPE AREAS (SEE NOTE 4)
- PROPOSED ROCK CONSTRUCTION ENTRANCE
- PROPOSED TRENCH BREAKER (SEE DETAIL MVP-20)
- TEMPORARY ROW DIVERSION/WATER BAR (VADEQ STD & SPEC 3.11)
- PERMANENT SLOPE BREAKER/ROW DIVERSION/WATER BAR (SEE DETAILS MVP-17, ES38, AND SCHEDULE)

NOTES:

1. TOPSOIL SEGREGATION WILL BE PERFORMED IN ALL IMMEDIATE CONSTRUCTION AREAS OF THE PROJECT IN ACCORDANCE WITH DETAILS MVP-ES46.1 THROUGH MVP-ES46.3.
2. FLEXTERRA, EARTHGUARD OR EQUIVALENT MAY BE USED AS A SUBSTITUTE TO EROSION CONTROL BLANKET AS DIRECTED BY MVP.
3. CONTRACTOR IS RESPONSIBLE TO IDENTIFY ALL UTILITIES. THE UTILITY LINES SHOWN ON THE PLAN ARE FOR INFORMATIONAL PURPOSES ONLY AND DO NOT REPRESENT SURVEYED LINE INFORMATION.
4. SLOPES OF 30" OR GREATER EXIST. CONSTRUCTION FOR STEEP SLOPES TO BE PERFORMED USING STEEP SLOPE TECHNIQUES IDENTIFIED IN THE DETAIL SHEETS. ALSO REFER TO THE SITE-SPECIFIC DESIGN OF STABILIZATION MEASURES IN SELECTED HIGH-HAZARD PORTIONS OF THE ROUTE OF THE PROPOSED MOUNTAIN VALLEY PIPELINE PROJECT.
5. WHERE CONSTRUCTION CONDITIONS PRECLUDE THE USE OF DIVERSION DITCHES DUE TO SITE CONDITIONS THE CONTRACTOR WILL INSTALL SILT FENCE AT THE DIRECTION OF MVP.
6. IMPROVEMENTS TO PERMANENT AND TEMPORARY ACCESS ROADS WILL BE PERFORMED PER THE SITE SPECIFIC ACCESS ROAD DETAILS.
7. TEMPORARY ACCESS ROAD CROSSING OF STREAMS AND WETLANDS WILL UTILIZE TIMBERMATS. ANY PERMANENT ROAD CROSSINGS WILL BE CONDUCTED VIA CULVERTS.
8. ALL NON VMRC STREAM CROSSINGS WILL BE PERFORMED AS DESCRIBED IN THE STREAM CROSSING TABLE INCLUDED IN THIS PACKAGE.

NO.	DATE:	DWN.:	CHKD.:	APPD.:	DESCRIPTION:
5	03/04/18	KAL	RE	DW	ADDRESS VADEQ COMMENTS
4	02/27/18	KAL	RE	DW	ADDRESS VADEQ COMMENTS
3	02/05/18	KAL	RE	DW	ADDRESS VADEQ COMMENTS
2	11/21/17	KAL	RE	DW	ADDRESS VADEQ COMMENTS
1	09/21/17	KAL	RE	DW	PLAN SUBMISSION

REVISIONS:

Mountain Valley PIPELINE

EROSION AND SEDIMENT CONTROL PLANS

MOUNTAIN VALLEY PIPELINE PROJECT – H600 LINE

SPREAD 10 – FRANKLIN COUNTY, VIRGINIA

MOUNTAIN VALLEY PIPELINE, LLC
555 SOUTHPOINTE BOULEVARD, SUITE 200
CANONSBURG, PA 15317

TETRA TECH
complex world | CLEAR SOLUTIONS™
661 ANDERSEN DRIVE
FOSTER PLAZA 7
PITTSBURGH, PA 15220


EROSION AND SEDIMENT CONTROL PLANS

COMMONWEALTH OF VIRGINIA
DAVID J. WALLNER
No. 0402057593
PROFESSIONAL ENGINEER

DRAWN BY:	KAL
CHECKED BY:	RE
APPROVED BY:	DW
DATE:	03/04/2018
SCALE:	AS SHOWN
SHT. NO.	14.40 OF 14.81ES

REVISION


TETRA TECH CAD FILE PATH: X:\CADD_Pittsburgh\EQT\7157 – MVP\15 – Franklin\E&S\ES Version 5.0.0\7157ES14.40(S10).dwg PLOTTED ON: 3/2/2018 3:01 PM PLOTTED BY: Zeigler, Justin PLOT FILE: ENVIRONMENTAL_COLOR.ctb

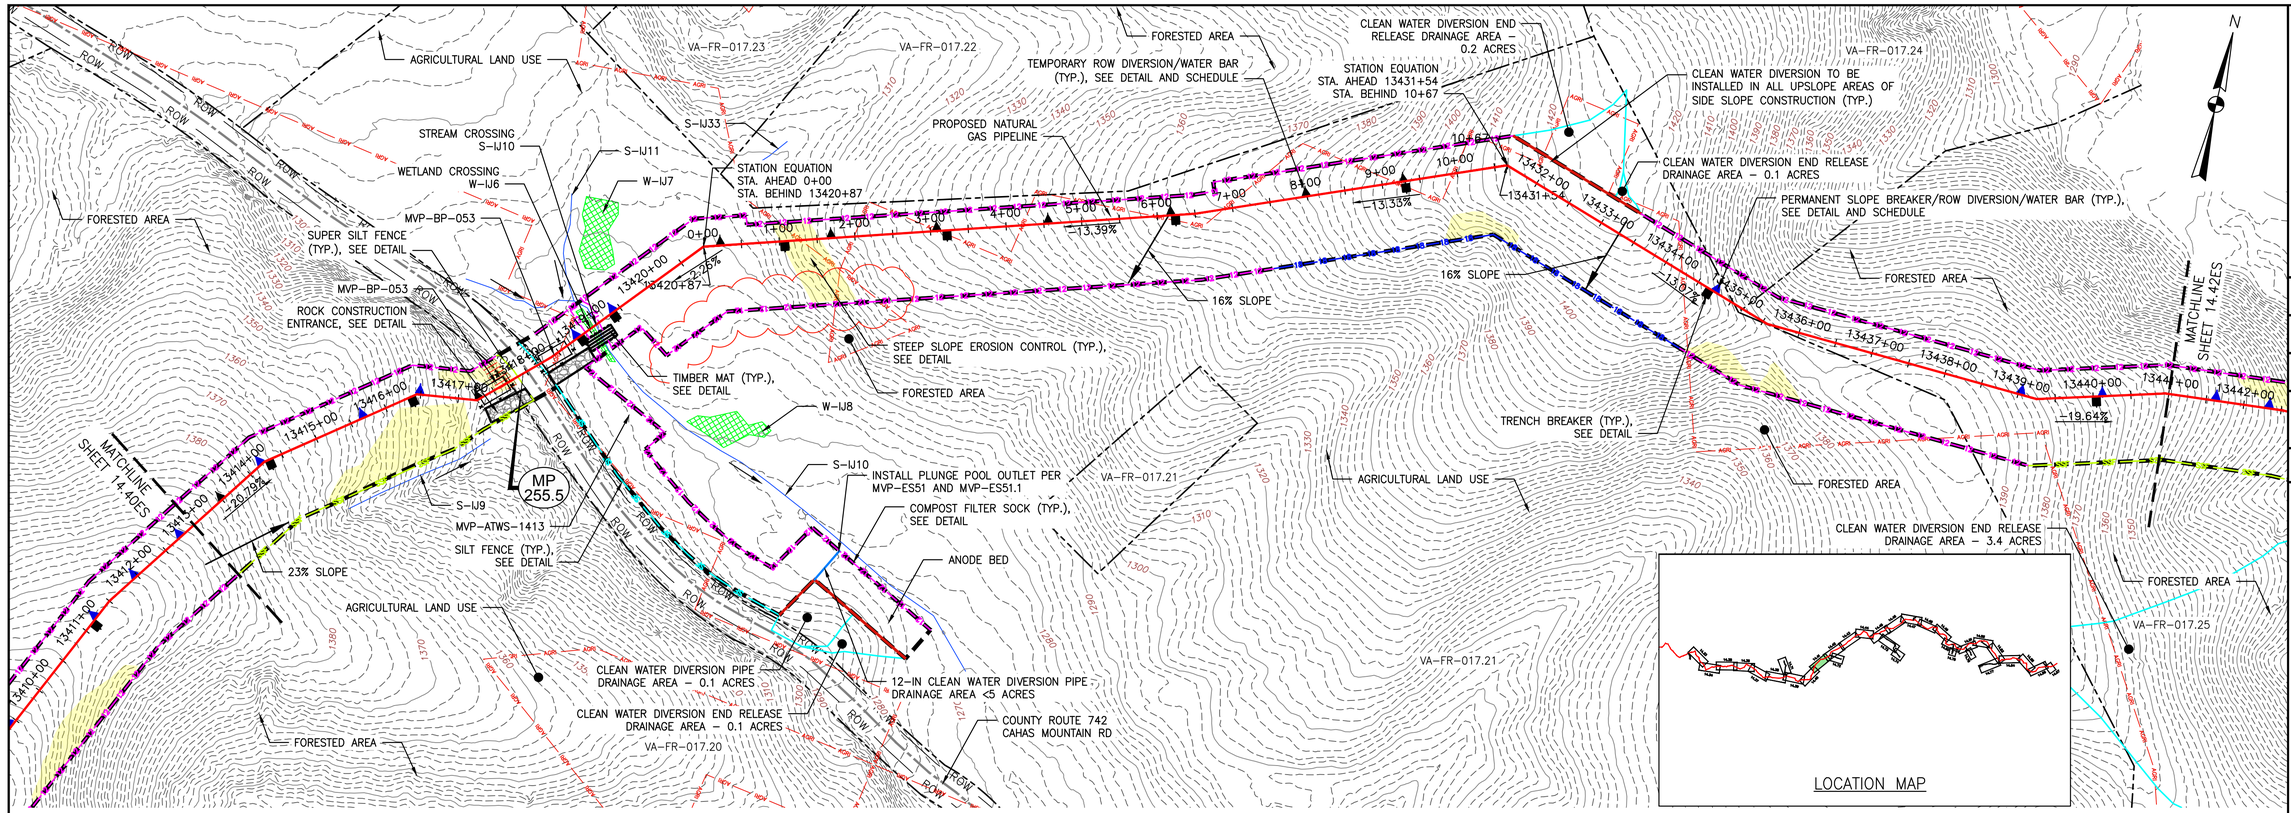

PLAN

SCALE: 1" = 100'

100 0 100 200

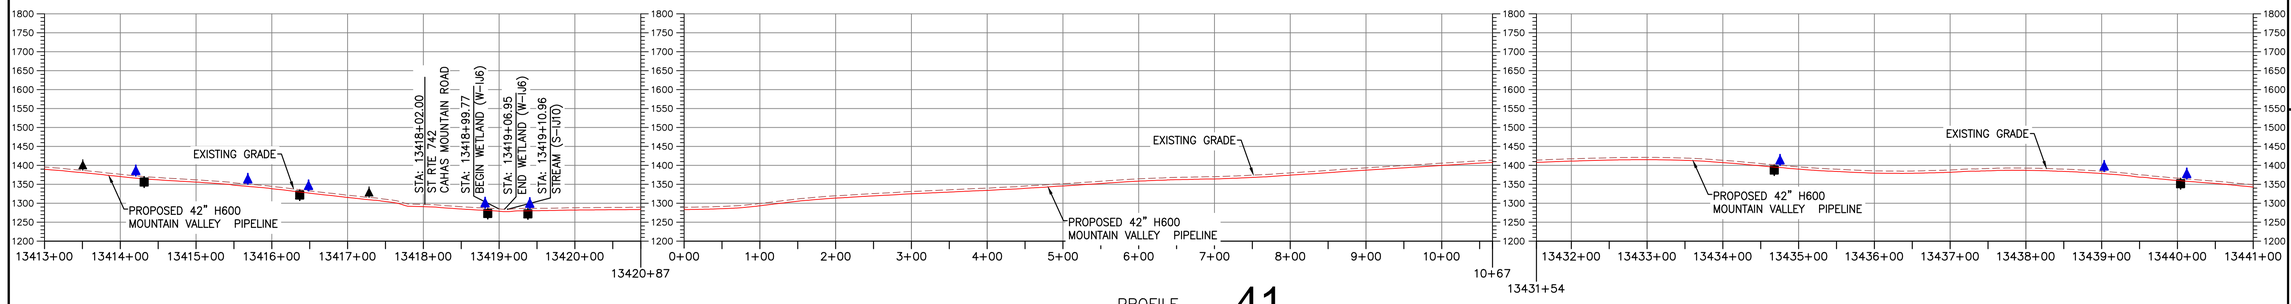

PROFILE 41

HORIZONTAL SCALE: SCALE: 1" = 100'

100 0 100 200

VERTICAL SCALE: SCALE: 1" = 200'

200 0 200 400

LEGEND

- PROPOSED LIMIT OF DISTURBANCE
- STREAM
- USDA FOREST SERVICE (NATIONAL FOREST) LANDS
- APPALACHIAN NATIONAL SCENIC TRAIL
- EXISTING ROAD/TRAIL
- EXISTING PROPERTY LINE
- EXISTING STATE LINE
- EXISTING COUNTY LINE
- POND
- WETLAND
- ACID FORMING MATERIAL
- AGRICULTURAL LAND USE BOUNDARY
- PROPOSED ACCESS ROAD CENTERLINE
- PROPOSED PIPELINE
- PROPOSED SILT FENCE (SEE NOTE 5)
- PROPOSED SUPER SILT FENCE (SEE DETAIL MVP-ES9.2)
- PROPOSED REINFORCED FILTRATION DEVICE (SEE DETAILS MVP-ES9, 9.1, 9.2, 9.3)
- ORANGE CONSTRUCTION SAFETY FENCE
- PROPOSED COMPOST FILTER SOCK (SEE DETAILS MVP-ES3, 3.1, 3.2)
- PROPOSED COMPOST FILTER SOCK (SEE DETAILS MVP-ES3, 3.1, 3.2)
- PROPOSED COMPOST FILTER SOCK (SEE DETAILS MVP-ES3, 3.1, 3.2)
- GRASS-LINED CHANNEL (SEE DETAIL MVP-ES39)
- CLEAN WATER DIVERSION PIPE
- CLEAN WATER DIVERSION DIKE (SEE DETAIL MVP-ES50 AND MVP-ES51)
- STREAM FLOW DIRECTION
- FEMA 100 YEAR FLOODPLAIN
- DRAINAGE AREA BOUNDARY
- TIMBER MAT (SEE DETAIL MVP-ES37)
- STEEP SLOPE EROSION CONTROL (SEE NOTE 2)
- STEEP SLOPE AREAS (SEE NOTE 4)
- PROPOSED ROCK CONSTRUCTION ENTRANCE
- PROPOSED TRENCH BREAKER (SEE DETAIL MVP-20)
- TEMPORARY ROW DIVERSION/WATER BAR (VADEQ STD & SPEC 3.11)
- PERMANENT SLOPE BREAKER/ROW DIVERSION/WATER BAR (SEE DETAILS MVP-17, ES38, AND SCHEDULE)

NOTES:

1. TOPSOIL SEGREGATION WILL BE PERFORMED IN ALL IMMEDIATE CONSTRUCTION AREAS OF THE PROJECT IN ACCORDANCE WITH DETAILS MVP-ES46.1 THROUGH MVP-ES46.3.
2. FLEXTERRA, EARTHGUARD OR EQUIVALENT MAY BE USED AS A SUBSTITUTE TO EROSION CONTROL BLANKET AS DIRECTED BY MVP.
3. CONTRACTOR IS RESPONSIBLE TO IDENTIFY ALL UTILITIES. THE UTILITY LINES SHOWN ON THE PLAN ARE FOR INFORMATIONAL PURPOSES ONLY AND DO NOT REPRESENT SURVEYED LINE INFORMATION.
4. SLOPES OF 30" OR GREATER EXIST. CONSTRUCTION FOR STEEP SLOPES TO BE PERFORMED USING STEEP SLOPE TECHNIQUES IDENTIFIED IN THE DETAIL SHEETS. ALSO REFER TO THE SITE-SPECIFIC DESIGN OF STABILIZATION MEASURES IN SELECTED HIGH-HAZARD PORTIONS OF THE ROUTE OF THE PROPOSED MOUNTAIN VALLEY PIPELINE PROJECT.
5. WHERE CONSTRUCTION CONDITIONS PRECLUDE THE USE OF DIVERSION DITCHES DUE TO SITE CONDITIONS THE CONTRACTOR WILL INSTALL SILT FENCE AT THE DIRECTION OF MVP.
6. IMPROVEMENTS TO PERMANENT AND TEMPORARY ACCESS ROADS WILL BE PERFORMED PER THE SITE SPECIFIC ACCESS ROAD DETAILS.
7. TEMPORARY ACCESS ROAD CROSSING OF STREAMS AND WETLANDS WILL UTILIZE TIMBERMATS. ANY PERMANENT ROAD CROSSINGS WILL BE CONDUCTED VIA CULVERTS.
8. ALL NON VMRC STREAM CROSSINGS WILL BE PERFORMED AS DESCRIBED IN THE STREAM CROSSING TABLE INCLUDED IN THIS PACKAGE.

NO.	DATE:	DWN.:	CHKD.:	APPD.:	DESCRIPTION:
5	03/04/18	KAL	RE	DW	ADDRESS VADEQ COMMENTS
4	02/27/18	KAL	RE	DW	ADDRESS VADEQ COMMENTS
3	02/05/18	KAL	RE	DW	ADDRESS VADEQ COMMENTS
2	11/21/17	KAL	RE	DW	ADDRESS VADEQ COMMENTS
1	09/21/17	KAL	RE	DW	PLAN SUBMISSION

REVISIONS:

Mountain Valley PIPELINE

EROSION AND SEDIMENT CONTROL PLANS

MOUNTAIN VALLEY PIPELINE PROJECT – H600 LINE

SPREAD 10 – FRANKLIN COUNTY, VIRGINIA

MOUNTAIN VALLEY PIPELINE, LLC
555 SOUTHPOINTE BOULEVARD, SUITE 200
CANONSBURG, PA 15317

TETRA TECH
complex world | CLEAR SOLUTIONS™
661 ANDERSEN DRIVE
FOSTER PLAZA 7
PITTSBURGH, PA 15220


EROSION AND SEDIMENT CONTROL PLANS

COMMONWEALTH OF VIRGINIA
DAVID J. WALLNER
No. 0402057593
PROFESSIONAL ENGINEER

DRAWN BY:	KAL
CHECKED BY:	RE
APPROVED BY:	DW
DATE:	03/04/2018
SCALE:	AS SHOWN
REVISION	5

SHT. NO. 14.41ES OF 14.81ES


TETRA TECH CAD FILE PATH: X:\CADD_Pittsburgh\EQT\7157 – MVP\15 – Franklin\E&S\ES Version 5.0.0\7157ES14.41(S10).dwg PLOTTED ON: 3/13/2018 4:01 PM PLOTTED BY: Rickabaugh, Greg PLOT FILE: ENVIRONMENTAL_COLOR.ctb

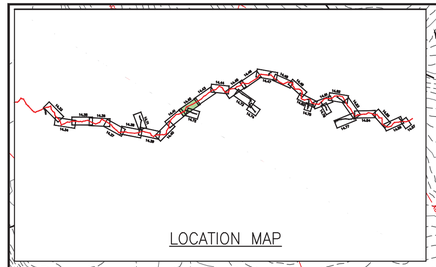

PLAN

SCALE: 1" = 100'

100 0 100 200

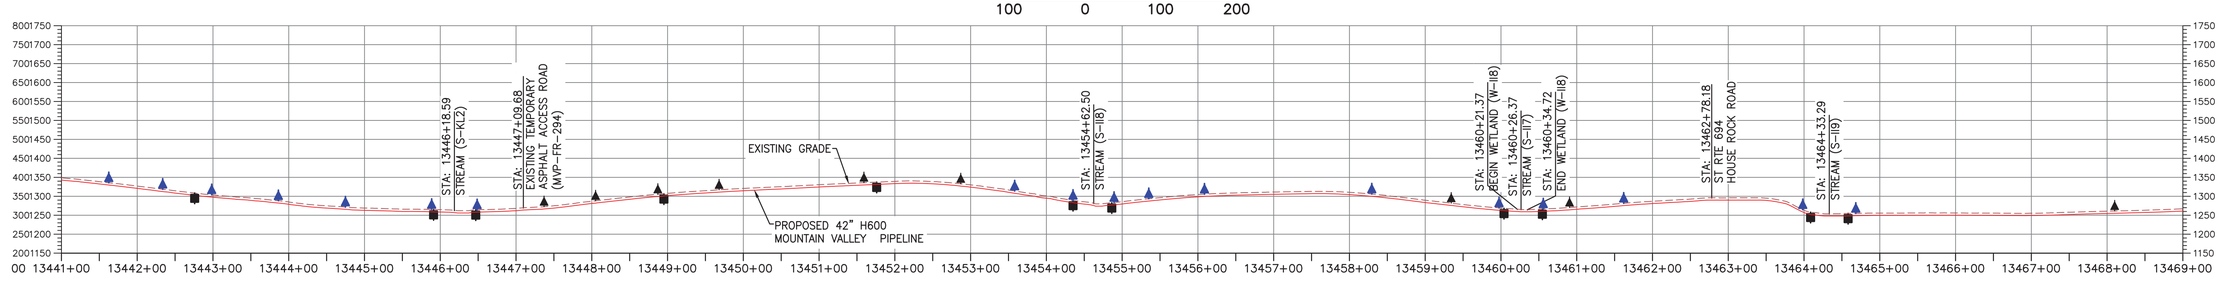

PROFILE

HORIZONTAL SCALE: SCALE: 1" = 100'

100 0 100 200

VERTICAL SCALE: SCALE: 1" = 200'

200 0 200 400

LEGEND

- PROPOSED LIMIT OF DISTURBANCE
- STREAM
- USDA FOREST SERVICE (NATIONAL FOREST) LANDS
- APPALACHIAN NATIONAL SCENIC TRAIL
- EXISTING ROAD/TRAIL
- EXISTING PROPERTY LINE
- EXISTING STATE LINE
- EXISTING COUNTY LINE
- POND
- WETLAND
- ACID FORMING MATERIAL
- AGRICULTURAL LAND USE BOUNDARY
- PROPOSED ACCESS ROAD CENTERLINE
- PROPOSED PIPELINE
- PROPOSED SILT FENCE (SEE NOTE 5)
- PROPOSED SUPER SILT FENCE (SEE DETAIL MVP-ES9.2)
- PROPOSED REINFORCED FILTRATION DEVICE (SEE DETAILS MVP-ES9, 9.1, 9.2, 9.3)
- ORANGE CONSTRUCTION SAFETY FENCE
- PROPOSED COMPOST FILTER SOCK (SEE DETAILS MVP-ES3, 3.1, 3.2)
- PROPOSED COMPOST FILTER SOCK (SEE DETAILS MVP-ES3, 3.1, 3.2)
- PROPOSED COMPOST FILTER SOCK (SEE DETAILS MVP-ES3, 3.1, 3.2)
- GRASS-LINED CHANNEL (SEE DETAIL MVP-ES39)
- CLEAN WATER DIVERSION PIPE
- CLEAN WATER DIVERSION DIKE (SEE DETAIL MVP-ES50 AND MVP-ES51)
- STREAM FLOW DIRECTION
- FEMA 100 YEAR FLOODPLAIN
- DRAINAGE AREA BOUNDARY
- TIMBER MAT (SEE DETAIL MVP-ES37)
- STEEP SLOPE EROSION CONTROL (SEE NOTE 2)
- STEEP SLOPE AREAS (SEE NOTE 4)
- PROPOSED ROCK CONSTRUCTION ENTRANCE
- PROPOSED TRENCH BREAKER (SEE DETAIL MVP-20)
- TEMPORARY ROW DIVERSION/WATER BAR (VADEQ STD & SPEC 3.11)
- PERMANENT SLOPE BREAKER/ROW DIVERSION/WATER BAR (SEE DETAILS MVP-17, ES38, AND SCHEDULE)

NOTES:

1. TOPSOIL SEGREGATION WILL BE PERFORMED IN ALL IMMEDIATE CONSTRUCTION AREAS OF THE PROJECT IN ACCORDANCE WITH DETAILS MVP-ES46.1 THROUGH MVP-ES46.3.
2. FLEXTERRA, EARTHGUARD OR EQUIVALENT MAY BE USED AS A SUBSTITUTE TO EROSION CONTROL BLANKET AS DIRECTED BY MVP.
3. CONTRACTOR IS RESPONSIBLE TO IDENTIFY ALL UTILITIES. THE UTILITY LINES SHOWN ON THE PLAN ARE FOR INFORMATIONAL PURPOSES ONLY AND DO NOT REPRESENT SURVEYED LINE INFORMATION.
4. SLOPES OF 30% OR GREATER EXIST. CONSTRUCTION FOR STEEP SLOPES TO BE PERFORMED USING STEEP SLOPE TECHNIQUES IDENTIFIED IN THE DETAIL SHEETS. ALSO REFER TO THE SITE-SPECIFIC DESIGN OF STABILIZATION MEASURES IN SELECTED HIGH-HAZARD PORTIONS OF THE ROUTE OF THE PROPOSED MOUNTAIN VALLEY PIPELINE PROJECT.
5. WHERE CONSTRUCTION CONDITIONS PRECLUDE THE USE OF DIVERSION DITCHES DUE TO SITE CONDITIONS THE CONTRACTOR WILL INSTALL SILT FENCE AT THE DIRECTION OF MVP.
6. IMPROVEMENTS TO PERMANENT AND TEMPORARY ACCESS ROADS WILL BE PERFORMED PER THE SITE SPECIFIC ACCESS ROAD DETAILS.
7. TEMPORARY ACCESS ROAD CROSSING OF STREAMS AND WETLANDS WILL UTILIZE TIMBERMATS. ANY PERMANENT ROAD CROSSINGS WILL BE CONDUCTED VIA CULVERTS.
8. ALL NON VMRC STREAM CROSSINGS WILL BE PERFORMED AS DESCRIBED IN THE STREAM CROSSING TABLE INCLUDED IN THIS PACKAGE.

REVISIONS:

NO.:	DATE:	DWN.:	CHKD.:	APPD.:	DESCRIPTION:
5	03/04/18	KAL	RE	DW	ADDRESS VADEQ COMMENTS
4	02/27/18	KAL	RE	DW	ADDRESS VADEQ COMMENTS
3	02/05/18	KAL	RE	DW	ADDRESS VADEQ COMMENTS
2	11/21/17	KAL	RE	DW	ADDRESS VADEQ COMMENTS
1	09/21/17	KAL	RE	DW	PLAN SUBMISSION

EROSION AND SEDIMENT CONTROL PLANS
MOUNTAIN VALLEY PIPELINE PROJECT - H600 LINE
SPREAD 10 - FRANKLIN COUNTY, VIRGINIA

Mountain Valley PIPELINE

MOUNTAIN VALLEY PIPELINE, LLC
555 SOUTHPOINTE BOULEVARD, SUITE 200
CANONSBURG, PA 15317

TETRA TECH
complex world | CLEAR SOLUTIONS™
661 ANDERSEN DRIVE
FOSTER PLAZA 7
PITTSBURGH, PA 15220

EROSION AND SEDIMENT CONTROL PLANS


COMMONWEALTH OF VIRGINIA
DAVID J. WALLNER
Lic. No. 0402057593
PROFESSIONAL ENGINEER

DRAWN BY:	KAL
CHECKED BY:	RE
APPROVED BY:	DW
DATE:	03/04/2018
SCALE:	AS SHOWN

REVISION 5

SHT. NO. 14.42ES OF 14.81ES


TETRA TECH CAD FILE PATH: X:\CADD_Pittsburgh\EQT\7157 - MVP\15 - Franklin\E&S\ES Version 5.0.0\7157ES14.42(S10).dwg PLOTTED ON: 3/2/2018 3:12 PM PLOTTED BY: Zeigler, Justin PLOT FILE: ENVIRONMENTAL_COLOR.ctb

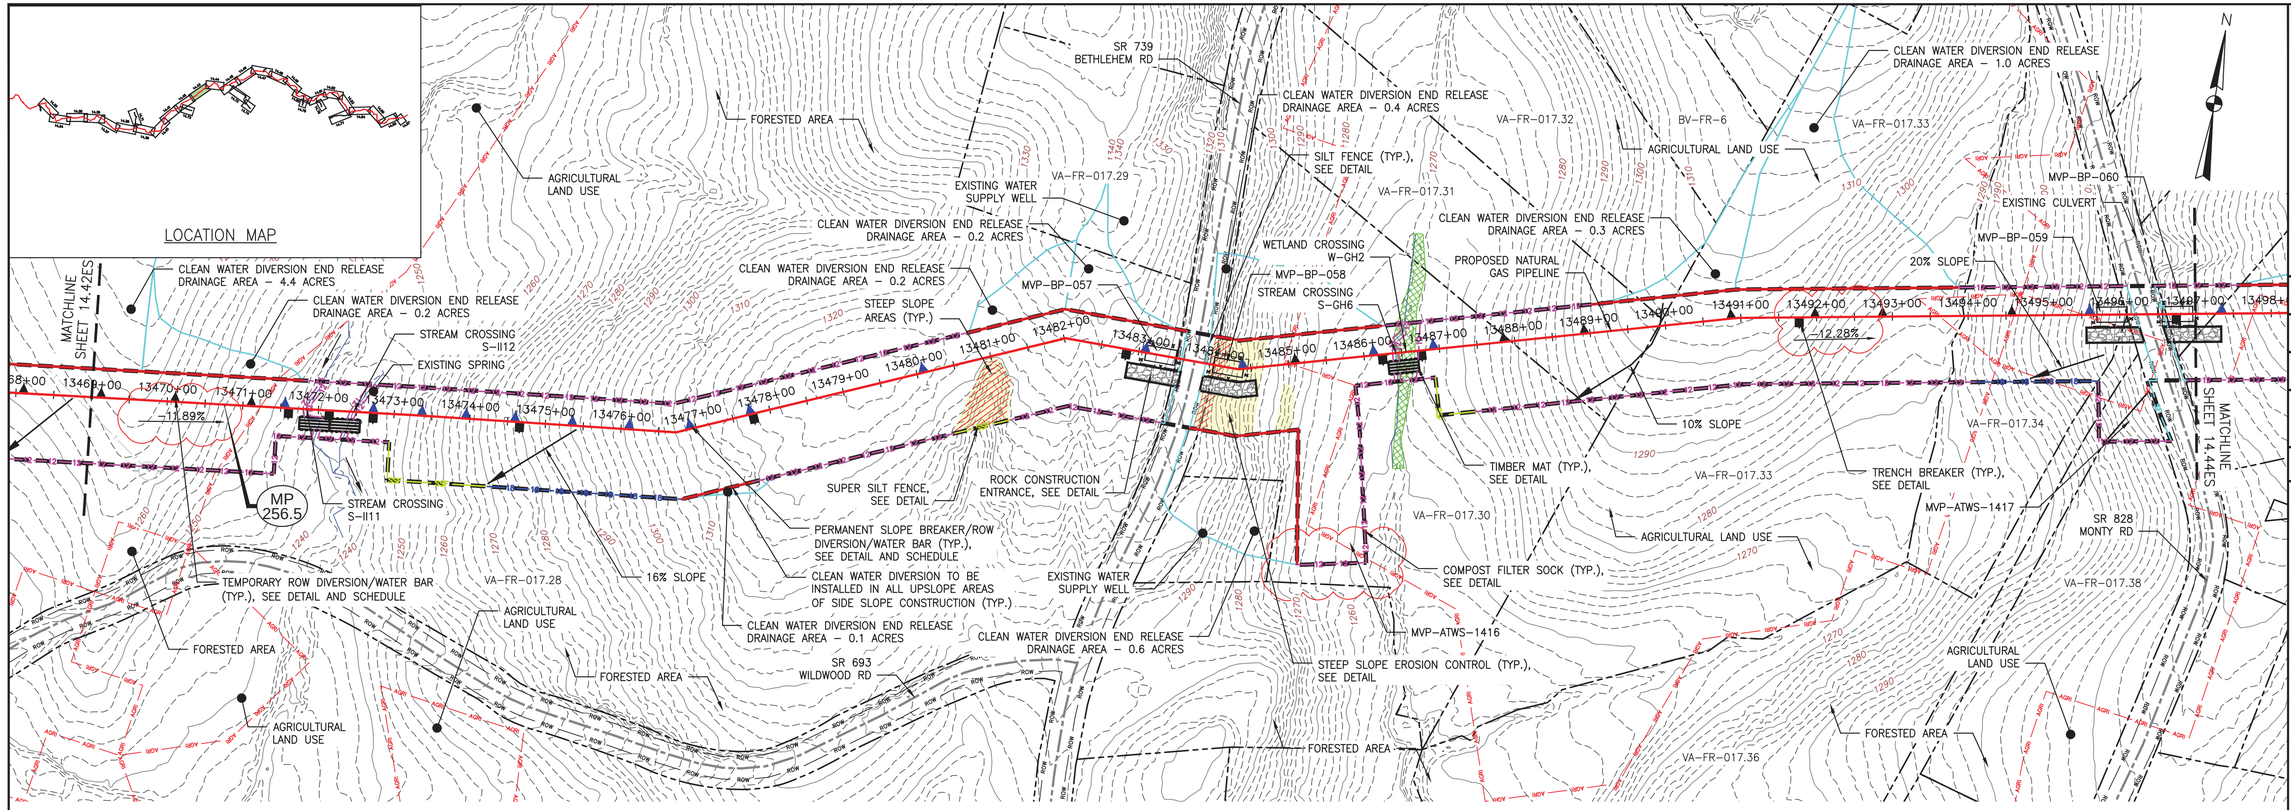

PLAN

SCALE: 1" = 100'

100 0 100 200

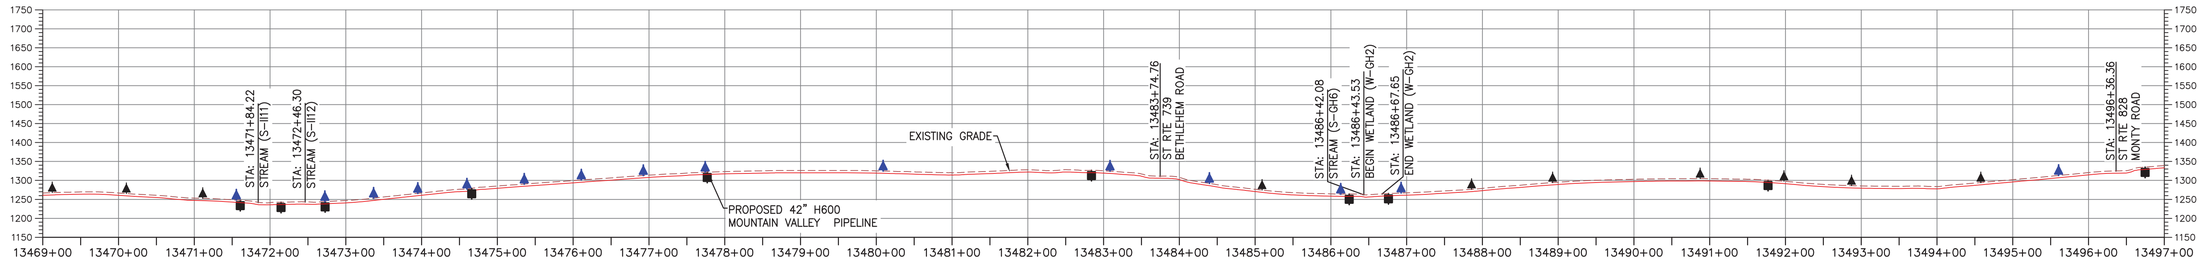

PROFILE

HORIZONTAL SCALE:

SCALE: 1" = 100'

100 0 100 200

VERTICAL SCALE:

SCALE: 1" = 200'

200 0 200 400

LEGEND

- PROPOSED LIMIT OF DISTURBANCE
- STREAM
- USDA FOREST SERVICE (NATIONAL FOREST) LANDS
- APPALACHIAN NATIONAL SCENIC TRAIL
- EXISTING ROAD/TRAIL
- EXISTING PROPERTY LINE
- EXISTING STATE LINE
- EXISTING COUNTY LINE
- POND
- WETLAND
- ACID FORMING MATERIAL
- AGRICULTURAL LAND USE BOUNDARY
- PROPOSED ACCESS ROAD CENTERLINE
- PROPOSED PIPELINE
- PROPOSED SILT FENCE (SEE NOTE 5)
- PROPOSED SUPER SILT FENCE (SEE DETAIL MVP–ES9.2)
- PROPOSED REINFORCED FILTRATION DEVICE (SEE DETAILS MVP–ES9, 9.1, 9.2, 9.3)
- ORANGE CONSTRUCTION SAFETY FENCE
- PROPOSED COMPOST FILTER SOCK (SEE DETAILS MVP–ES3, 3.1, 3.2)
- PROPOSED COMPOST FILTER SOCK (SEE DETAILS MVP–ES3, 3.1, 3.2)
- PROPOSED COMPOST FILTER SOCK (SEE DETAILS MVP–ES3, 3.1, 3.2)
- GRASS–LINED CHANNEL (SEE DETAIL MVP–ES39)
- CLEAN WATER DIVERSION PIPE
- CLEAN WATER DIVERSION DIKE (SEE DETAIL MVP–ES50 AND MVP–ES51)
- STREAM FLOW DIRECTION
- FEMA 100 YEAR FLOODPLAIN
- DRAINAGE AREA BOUNDARY
- TIMBER MAT (SEE DETAIL MVP–ES37)
- STEEP SLOPE EROSION CONTROL (SEE NOTE 2)
- STEEP SLOPE AREAS (SEE NOTE 4)
- PROPOSED ROCK CONSTRUCTION ENTRANCE
- PROPOSED TRENCH BREAKER (SEE DETAIL MVP–20)
- TEMPORARY ROW DIVERSION/WATER BAR (VADEQ STD & SPEC 3.11)
- PERMANENT SLOPE BREAKER/ROW DIVERSION/WATER BAR (SEE DETAILS MVP–17, ES38, AND SCHEDULE)

NOTES:

1. TOPSOIL SEGREGATION WILL BE PERFORMED IN ALL IMMEDIATE CONSTRUCTION AREAS OF THE PROJECT IN ACCORDANCE WITH DETAILS MVP–ES46.1 THROUGH MVP–ES46.3.
2. FLEXTERRA, EARTHGUARD OR EQUIVALENT MAY BE USED AS A SUBSTITUTE TO EROSION CONTROL BLANKET AS DIRECTED BY MVP.
3. CONTRACTOR IS RESPONSIBLE TO IDENTIFY ALL UTILITIES. THE UTILITY LINES SHOWN ON THE PLAN ARE FOR INFORMATIONAL PURPOSES ONLY AND DO NOT REPRESENT SURVEYED LINE INFORMATION.
4. SLOPES OF 30" OR GREATER EXIST. CONSTRUCTION FOR STEEP SLOPES TO BE PERFORMED USING STEEP SLOPE TECHNIQUES IDENTIFIED IN THE DETAIL SHEETS. ALSO REFER TO THE SITE–SPECIFIC DESIGN OF STABILIZATION MEASURES IN SELECTED HIGH–HAZARD PORTIONS OF THE ROUTE OF THE PROPOSED MOUNTAIN VALLEY PIPELINE PROJECT.
5. WHERE CONSTRUCTION CONDITIONS PRECLUDE THE USE OF DIVERSION DITCHES DUE TO SITE CONDITIONS THE CONTRACTOR WILL INSTALL SILT FENCE AT THE DIRECTION OF MVP.
6. IMPROVEMENTS TO PERMANENT AND TEMPORARY ACCESS ROADS WILL BE PERFORMED PER THE SITE SPECIFIC ACCESS ROAD DETAILS.
7. TEMPORARY ACCESS ROAD CROSSING OF STREAMS AND WETLANDS WILL UTILIZE TIMBERMATS. ANY PERMANENT ROAD CROSSINGS WILL BE CONDUCTED VIA CULVERTS.
8. ALL NON VMRC STREAM CROSSINGS WILL BE PERFORMED AS DESCRIBED IN THE STREAM CROSSING TABLE INCLUDED IN THIS PACKAGE.

NO.	DATE:	DWN.:	CHKD.:	APPD.:	DESCRIPTION:
5	03/04/18	KAL	RE	DW	ADDRESS VADEQ COMMENTS
4	02/27/18	KAL	RE	DW	ADDRESS VADEQ COMMENTS
3	02/05/18	KAL	RE	DW	ADDRESS VADEQ COMMENTS
2	11/21/17	KAL	RE	DW	ADDRESS VADEQ COMMENTS
1	09/21/17	KAL	RE	DW	PLAN SUBMISSION

REVISIONS:

Mountain Valley PIPELINE

EROSION AND SEDIMENT CONTROL PLANS

MOUNTAIN VALLEY PIPELINE PROJECT – H600 LINE

SPREAD 10 – FRANKLIN COUNTY, VIRGINIA

TETRA TECH

complex world | CLEAR SOLUTIONS™

661 ANDERSEN DRIVE
FOSTER PLAZA 7
PITTSBURGH, PA 15220

EROSION AND SEDIMENT CONTROL PLANS

COMMONWEALTH OF VIRGINIA
DAVID J. WALLNER
No. 0402057593
PROFESSIONAL ENGINEER


DRAWN BY:	KAL
CHECKED BY:	RE
APPROVED BY:	DW
DATE:	03/04/2018
SCALE:	AS SHOWN
REVISION	5

SHT. NO. 14.43ES OF 14.81ES

MOUNTAIN VALLEY PIPELINE, LLC
555 SOUTHPOINTE BOULEVARD, SUITE 200
CANONSBURG, PA 15317

TETRA TECH CAD FILE PATH: X:\CADD_Pittsburgh\EQT\7157 – MVP\15 – Franklin\E&S\ES Version 5.0.0\7157ES14.43(S10).dwg PLOTTED ON: 3/2/2018 3:17 PM PLOTTED BY: Zeigler, Justin PLOT FILE: ENVIRONMENTAL_COLOR.ctb


LOCATION MAP

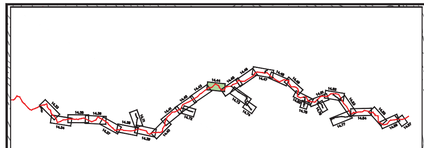

PLAN

SCALE: 1" = 100'

100 0 100 200

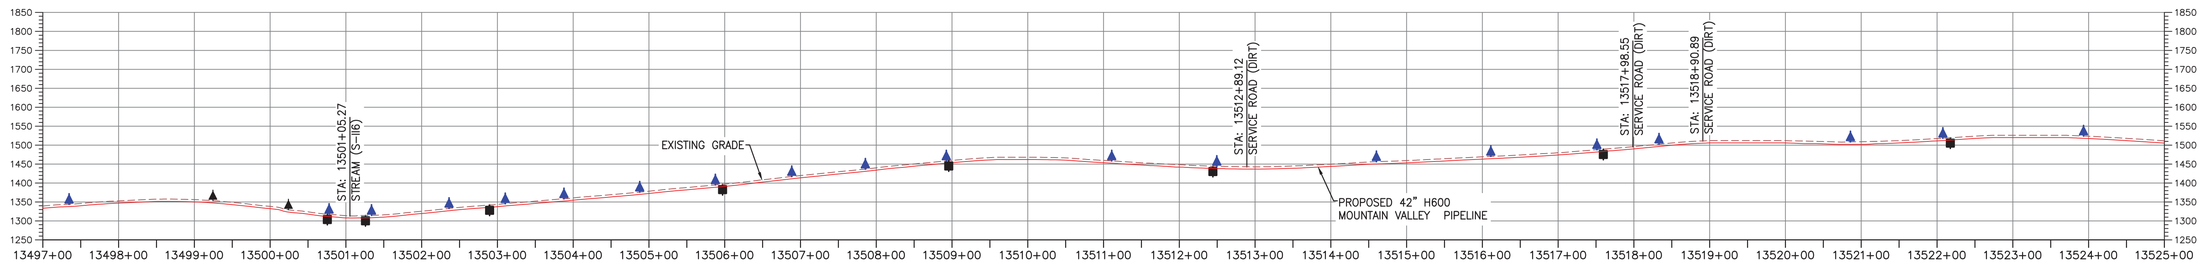

PROFILE

HORIZONTAL SCALE: SCALE: 1" = 100'

100 0 100 200

VERTICAL SCALE: SCALE: 1" = 200'

200 0 200 400

LEGEND

- PROPOSED LIMIT OF DISTURBANCE
- STREAM
- USDA FOREST SERVICE (NATIONAL FOREST) LANDS
- APPALACHIAN NATIONAL SCENIC TRAIL
- EXISTING ROAD/TRAIL
- EXISTING PROPERTY LINE
- EXISTING STATE LINE
- EXISTING COUNTY LINE
- POND
- WETLAND
- ACID FORMING MATERIAL
- AGRICULTURAL LAND USE BOUNDARY
- PROPOSED ACCESS ROAD CENTERLINE
- PROPOSED PIPELINE
- PROPOSED SILT FENCE (SEE NOTE 5)
- PROPOSED SUPER SILT FENCE (SEE DETAIL MVP-ES9.2)
- PROPOSED REINFORCED FILTRATION DEVICE (SEE DETAILS MVP-ES9, 9.1, 9.2, 9.3)
- ORANGE CONSTRUCTION SAFETY FENCE
- PROPOSED COMPOST FILTER SOCK (SEE DETAILS MVP-ES3, 3.1, 3.2)
- PROPOSED COMPOST FILTER SOCK (SEE DETAILS MVP-ES3, 3.1, 3.2)
- PROPOSED COMPOST FILTER SOCK (SEE DETAILS MVP-ES3, 3.1, 3.2)
- GRASS-LINED CHANNEL (SEE DETAIL MVP-ES39)
- CLEAN WATER DIVERSION PIPE
- CLEAN WATER DIVERSION DIKE (SEE DETAIL MVP-ES50 AND MVP-ES51)
- STREAM FLOW DIRECTION
- FEMA 100 YEAR FLOODPLAIN
- DRAINAGE AREA BOUNDARY
- TIMBER MAT (SEE DETAIL MVP-ES37)
- STEEP SLOPE EROSION CONTROL (SEE NOTE 2)
- STEEP SLOPE AREAS (SEE NOTE 4)
- PROPOSED ROCK CONSTRUCTION ENTRANCE
- PROPOSED TRENCH BREAKER (SEE DETAIL MVP-20)
- TEMPORARY ROW DIVERSION/WATER BAR (VADEQ STD & SPEC 3.11)
- PERMANENT SLOPE BREAKER/ROW DIVERSION/WATER BAR (SEE DETAILS MVP-17, ES38, AND SCHEDULE)

NOTES:

1. TOPSOIL SEGREGATION WILL BE PERFORMED IN ALL IMMEDIATE CONSTRUCTION AREAS OF THE PROJECT IN ACCORDANCE WITH DETAILS MVP-ES46.1 THROUGH MVP-ES46.3.
2. FLEXTERRA, EARTHGUARD OR EQUIVALENT MAY BE USED AS A SUBSTITUTE TO EROSION CONTROL BLANKET AS DIRECTED BY MVP.
3. CONTRACTOR IS RESPONSIBLE TO IDENTIFY ALL UTILITIES. THE UTILITY LINES SHOWN ON THE PLAN ARE FOR INFORMATIONAL PURPOSES ONLY AND DO NOT REPRESENT SURVEYED LINE INFORMATION.
4. SLOPES OF 30° OR GREATER EXIST. CONSTRUCTION FOR STEEP SLOPES TO BE PERFORMED USING STEEP SLOPE TECHNIQUES IDENTIFIED IN THE DETAIL SHEETS. ALSO REFER TO THE SITE-SPECIFIC DESIGN OF STABILIZATION MEASURES IN SELECTED HIGH-HAZARD PORTIONS OF THE ROUTE OF THE PROPOSED MOUNTAIN VALLEY PIPELINE PROJECT.
5. WHERE CONSTRUCTION CONDITIONS PRECLUDE THE USE OF DIVERSION DITCHES DUE TO SITE CONDITIONS THE CONTRACTOR WILL INSTALL SILT FENCE AT THE DIRECTION OF MVP.
6. IMPROVEMENTS TO PERMANENT AND TEMPORARY ACCESS ROADS WILL BE PERFORMED PER THE SITE SPECIFIC ACCESS ROAD DETAILS.
7. TEMPORARY ACCESS ROAD CROSSING OF STREAMS AND WETLANDS WILL UTILIZE TIMBERMATS. ANY PERMANENT ROAD CROSSINGS WILL BE CONDUCTED VIA CULVERTS.
8. ALL NON VMRC STREAM CROSSINGS WILL BE PERFORMED AS DESCRIBED IN THE STREAM CROSSING TABLE INCLUDED IN THIS PACKAGE.

NO.	DATE	DWN.	CHKD.	APPD.	DESCRIPTION
5	03/04/18	KAL	RE	DW	ADDRESS VADEQ COMMENTS
4	02/27/18	KAL	RE	DW	ADDRESS VADEQ COMMENTS
3	02/05/18	KAL	RE	DW	ADDRESS VADEQ COMMENTS
2	11/21/17	KAL	RE	DW	ADDRESS VADEQ COMMENTS
1	09/21/17	KAL	RE	DW	PLAN SUBMISSION

REVISIONS:

Mountain Valley PIPELINE

EROSION AND SEDIMENT CONTROL PLANS

MOUNTAIN VALLEY PIPELINE PROJECT – H600 LINE

SPREAD 10 – FRANKLIN COUNTY, VIRGINIA

MOUNTAIN VALLEY PIPELINE, LLC
555 SOUTHPOINTE BOULEVARD, SUITE 200
CANONSBURG, PA 15317


TETRA TECH
complex world | CLEAR SOLUTIONS™
661 ANDERSEN DRIVE
FOSTER PLAZA 7
PITTSBURGH, PA 15220

EROSION AND SEDIMENT CONTROL PLANS

COMMONWEALTH OF VIRGINIA
DAVID J. WALLNER
Lic. No. 0402057593
PROFESSIONAL ENGINEER

DRAWN BY:	KAL
CHECKED BY:	RE
APPROVED BY:	DW
DATE:	03/04/2018
SCALE:	AS SHOWN
REVISION	5
SHT. NO.	14.44ES OF 14.81ES

TETRA TECH CAD FILE PATH: X:\CADD_Pittsburgh\EQT\7157 – MVP\15 – Franklin\E&S\ES Version 5.0.0\7157ES14.44(S10).dwg PLOTTED ON: 3/2/2018 3:22 PM PLOTTED BY: Zeigler, Justin PLOT FILE: ENVIRONMENTAL_COLOR.ctb

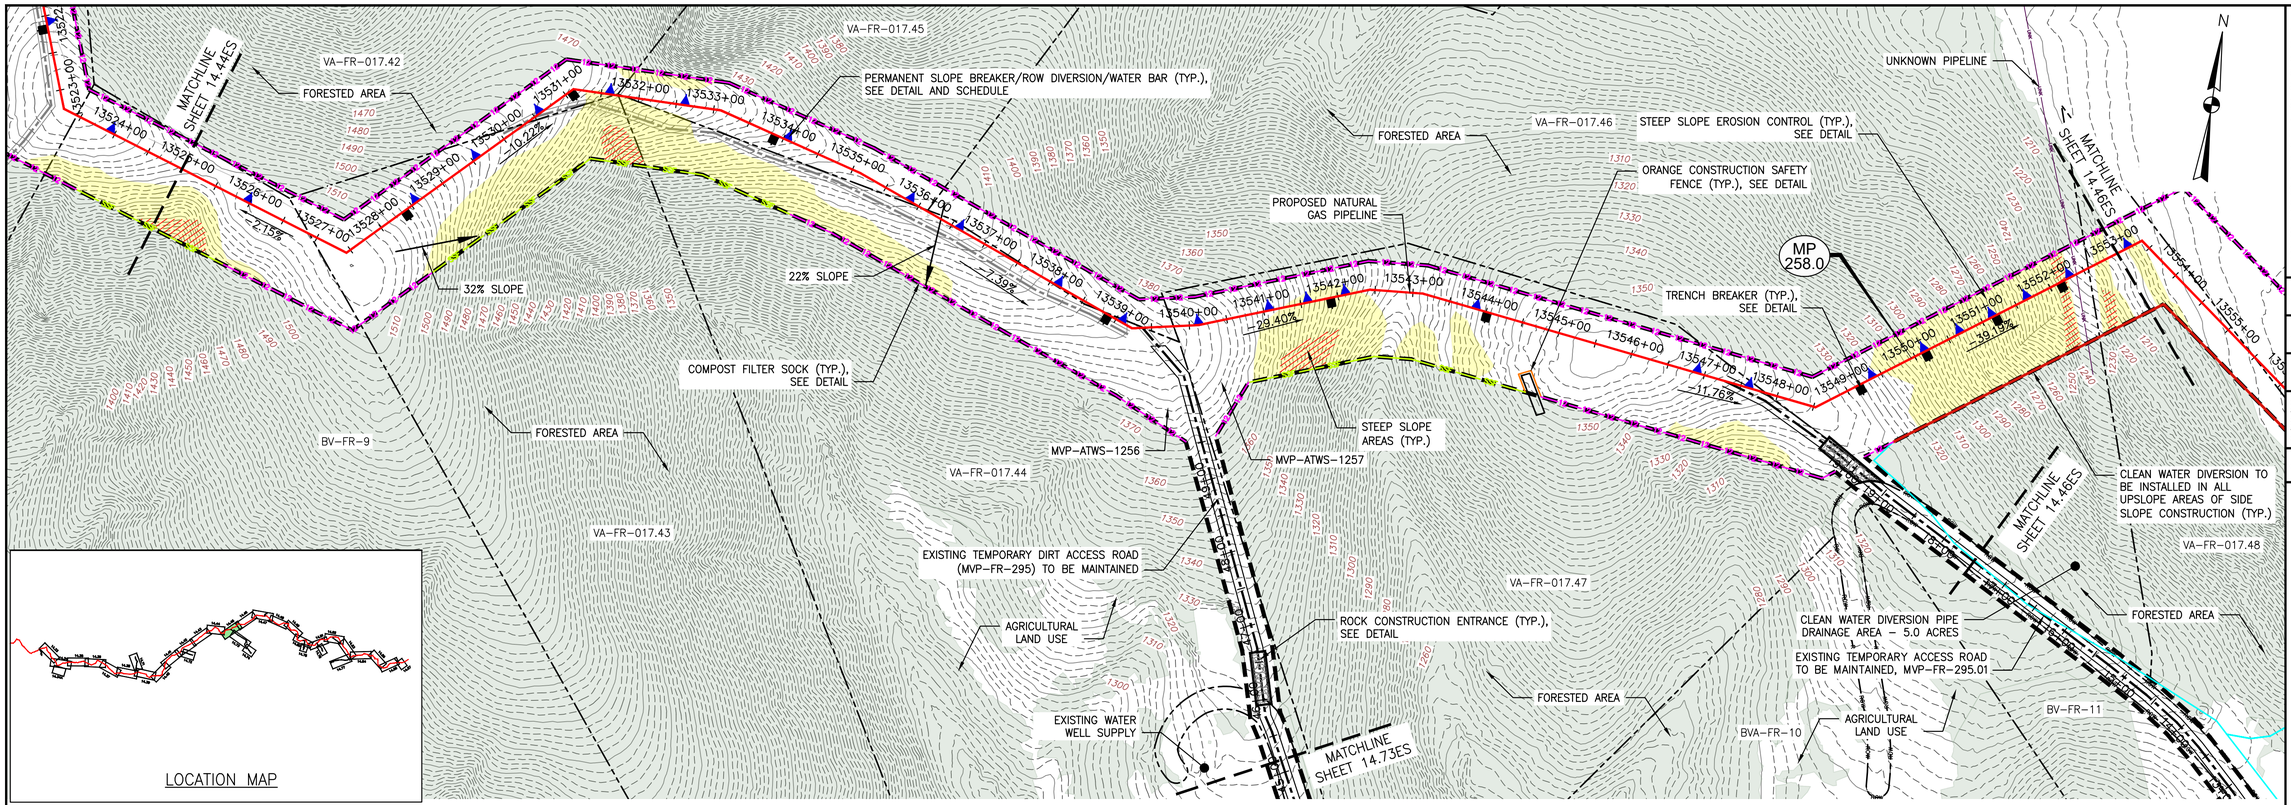


LOCATION MAP

PLAN

SCALE: 1" = 100'

100 0 100 200

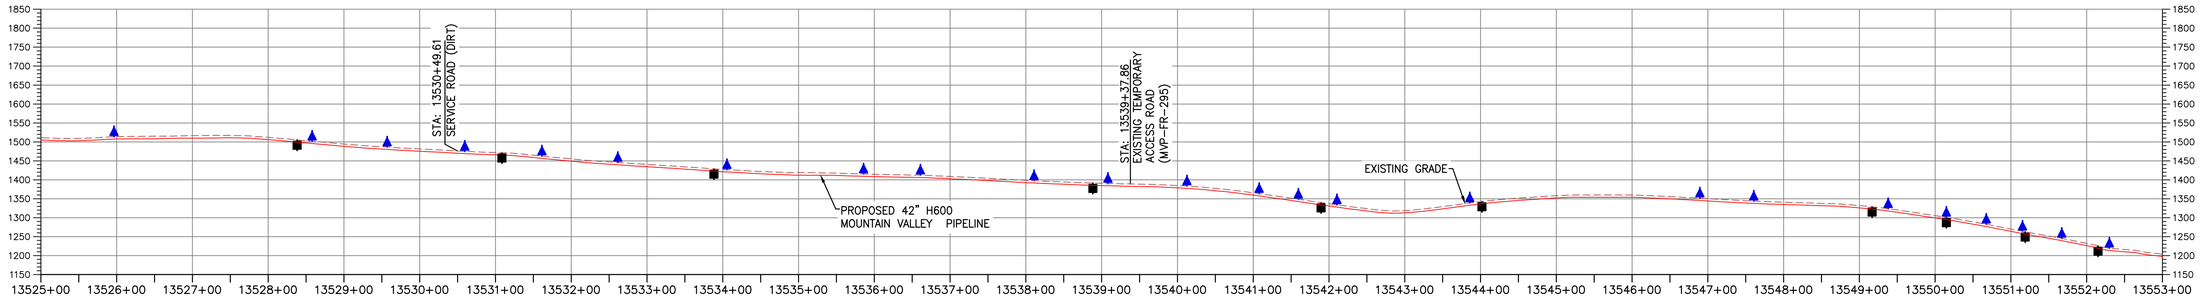

HORIZONTAL SCALE: SCALE: 1" = 100'

100 0 100 200

PROFILE

VERTICAL SCALE: SCALE: 1" = 200'

200 0 200 400

LEGEND

- PROPOSED LIMIT OF DISTURBANCE
- STREAM
- USDA FOREST SERVICE (NATIONAL FOREST) LANDS
- APPALACHIAN NATIONAL SCENIC TRAIL
- EXISTING ROAD/TRAIL
- EXISTING PROPERTY LINE
- EXISTING STATE LINE
- EXISTING COUNTY LINE
- POND
- WETLAND
- ACID FORMING MATERIAL
- EXISTING FOREST
- PROPOSED ACCESS ROAD CENTERLINE
- PROPOSED PIPELINE
- PROPOSED SILT FENCE (SEE NOTE 5)
- PROPOSED SUPER SILT FENCE (SEE DETAIL MVP-ES9.2)
- PROPOSED REINFORCED FILTRATION DEVICE (SEE DETAILS MVP-ES9, 9.1, 9.2, 9.3)
- ORANGE CONSTRUCTION SAFETY FENCE
- PROPOSED COMPOST FILTER SOCK (SEE DETAILS MVP-ES3, 3.1, 3.2)
- PROPOSED COMPOST FILTER SOCK (SEE DETAILS MVP-ES3, 3.1, 3.2)
- PROPOSED COMPOST FILTER SOCK (SEE DETAILS MVP-ES3, 3.1, 3.2)
- GRASS-LINED CHANNEL (SEE DETAIL MVP-ES39)
- CLEAN WATER DIVERSION PIPE
- CLEAN WATER DIVERSION DIKE (SEE DETAIL MVP-ES50 AND MVP-ES51)
- STREAM FLOW DIRECTION
- FEMA 100 YEAR FLOODPLAIN
- DRAINAGE AREA BOUNDARY
- TIMBER MAT (SEE DETAIL MVP-ES37)
- STEEP SLOPE EROSION CONTROL (SEE NOTE 2)
- STEEP SLOPE AREAS (SEE NOTE 4)
- PROPOSED ROCK CONSTRUCTION ENTRANCE
- PROPOSED TRENCH BREAKER (SEE DETAIL MVP-20)
- TEMPORARY ROW DIVERSION/WATER BAR (SEE DETAIL MVP-17)
- PERMANENT SLOPE BREAKER/ROW DIVERSION/WATER BAR (SEE DETAIL MVP-17)

NOTES:

1. TOPSOIL SEGREGATION WILL BE PERFORMED IN ALL IMMEDIATE CONSTRUCTION AREAS OF THE PROJECT IN ACCORDANCE WITH DETAILS MVP-ES46.1 THROUGH MVP-ES46.3.
2. FLEXTERRA, EARTHGUARD OR EQUIVALENT MAY BE USED AS A SUBSTITUTE TO EROSION CONTROL BLANKET AS DIRECTED BY MVP.
3. CONTRACTOR IS RESPONSIBLE TO IDENTIFY ALL UTILITIES. THE UTILITY LINES SHOWN ON THE PLAN ARE FOR INFORMATIONAL PURPOSES ONLY AND DO NOT REPRESENT SURVEYED LINE INFORMATION.
4. SLOPES OF 30° OR GREATER EXIST. CONSTRUCTION FOR STEEP SLOPES TO BE PERFORMED USING STEEP SLOPE TECHNIQUES IDENTIFIED IN THE DETAIL SHEETS. ALSO REFER TO THE SITE-SPECIFIC DESIGN OF STABILIZATION MEASURES IN SELECTED HIGH-HAZARD PORTIONS OF THE ROUTE OF THE PROPOSED MOUNTAIN VALLEY PIPELINE PROJECT.
5. WHERE CONSTRUCTION CONDITIONS PRECLUDE THE USE OF DIVERSION DITCHES DUE TO SITE CONDITIONS THE CONTRACTOR WILL INSTALL SILT FENCE AT THE DIRECTION OF MVP.
6. IMPROVEMENTS TO PERMANENT AND TEMPORARY ACCESS ROADS WILL BE PERFORMED PER THE SITE SPECIFIC ACCESS ROAD DETAILS.
7. TEMPORARY ACCESS ROAD CROSSING OF STREAMS AND WETLANDS WILL UTILIZE TIMBERMATS. ANY PERMANENT ROAD CROSSINGS WILL BE CONDUCTED VIA CULVERTS.
8. ALL NON VMRC STREAM CROSSINGS WILL BE PERFORMED AS DESCRIBED IN THE STREAM CROSSING TABLE INCLUDED IN THIS PACKAGE.

NO.	DATE:	DWN.:	CHKD.:	APPD.:	DESCRIPTION:
8	12/06/18	JJZ	RE	DW	ADDRESS VADEQ COMMENTS TO FIELD MODIFICATION SUBMITTAL
7	06/22/18	JJZ	RE	DW	FIELD MODIFICATION
6	03/16/18	KAL	RE	DW	ADDRESS VADEQ COMMENTS
5	03/04/18	KAL	RE	DW	ADDRESS VADEQ COMMENTS
4	02/27/18	KAL	RE	DW	ADDRESS VADEQ COMMENTS
3	02/05/18	KAL	RE	DW	ADDRESS VADEQ COMMENTS

REVISIONS:

Mountain Valley PIPELINE

EROSION AND SEDIMENT CONTROL PLANS

MOUNTAIN VALLEY PIPELINE PROJECT – H600 LINE

SPREAD 10 – FRANKLIN COUNTY, VIRGINIA

MOUNTAIN VALLEY PIPELINE, LLC
2200 ENERGY DRIVE
CANONSBURG, PA 15317


TETRA TECH
complex world | CLEAR SOLUTIONS™
661 ANDERSEN DRIVE
FOSTER PLAZA 7
PITTSBURGH, PA 15220

EROSION AND SEDIMENT CONTROL PLANS

COMMONWEALTH OF VIRGINIA
DAVID J. WALLNER
Lic. No. 57593
12/6/2018
PROFESSIONAL ENGINEER

DRAWN BY:	JJZ
CHECKED BY:	RE
APPROVED BY:	DW
DATE:	12/06/2018
SCALE:	AS SHOWN
REVISION	8
SHT. NO.	14.45ES OF 14.81ES


TETRA TECH CAD FILE PATH: X:\CADD_Pittsburgh\EQT\7157 – MVP\15 – Franklin\E&S\ES Version 5.0.0\Mod Revision\7157ES14.45(S10).dwg PLOTTED ON: 11/10/2021 9:37 AM PLOTTED BY: Zeigler, Justin PLOT FILE: ENVIRONMENTAL_COLOR.ctb

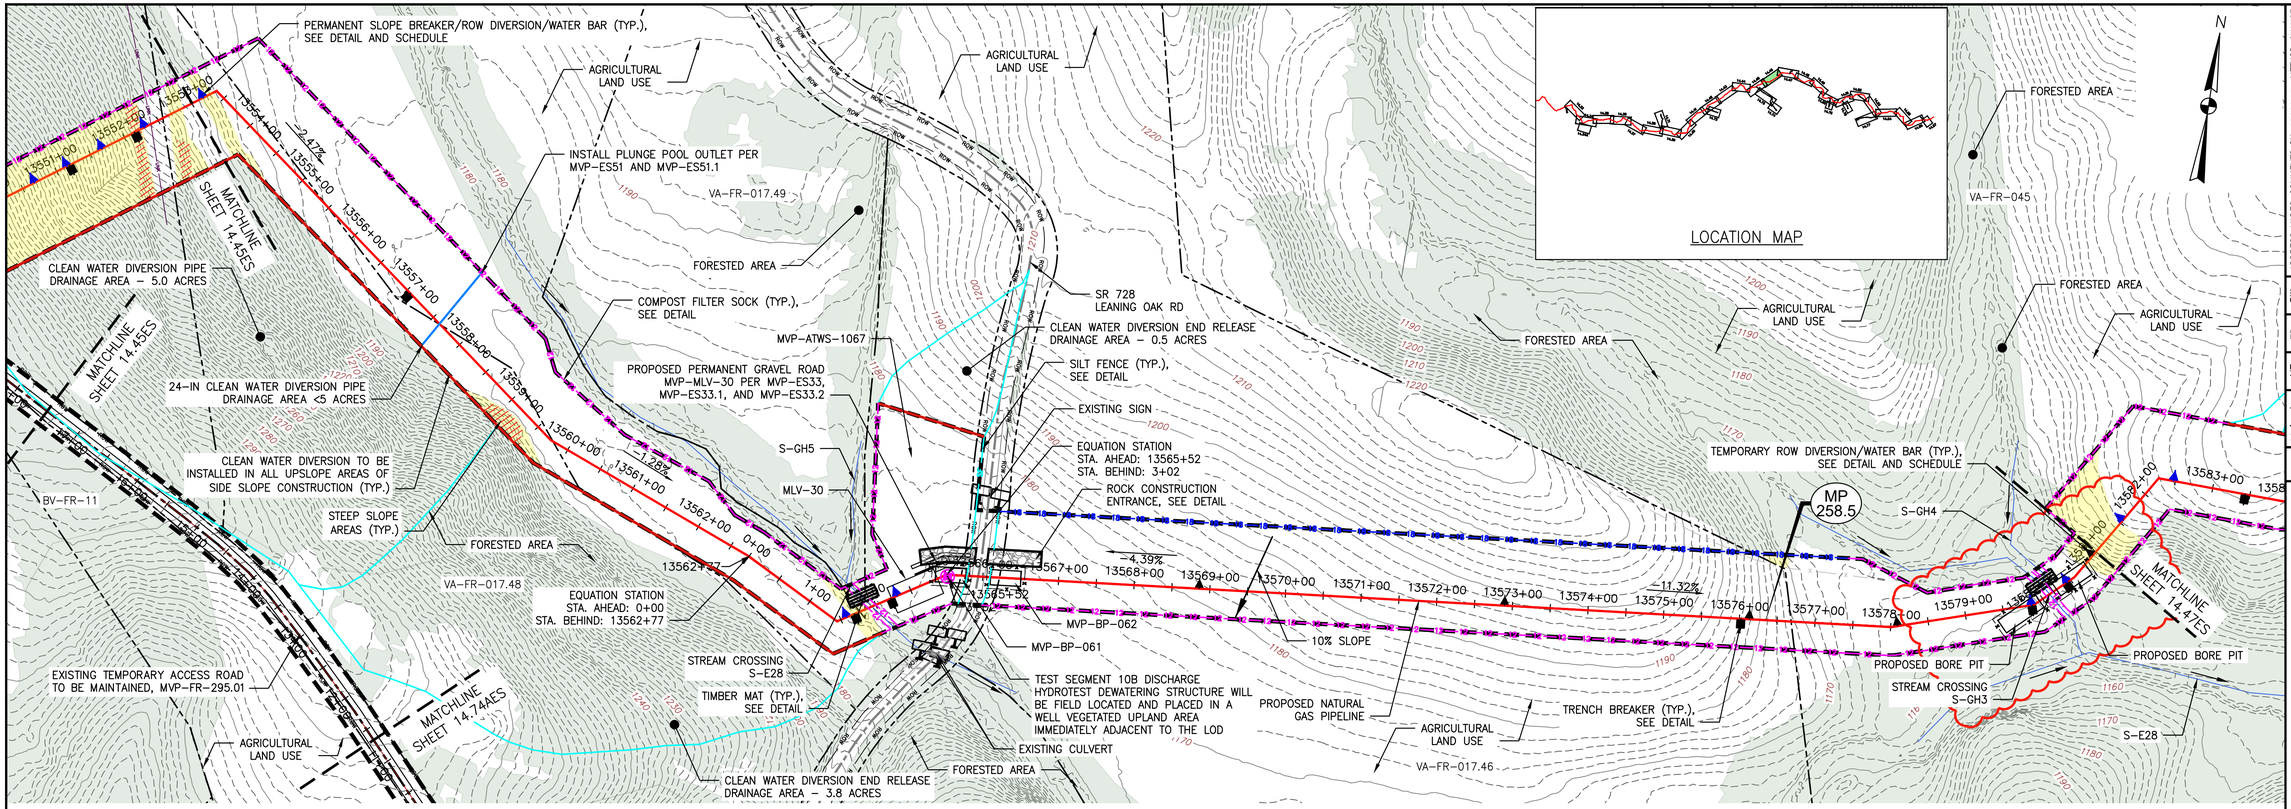

PLAN

SCALE: 1" = 100'

100 0 100 200

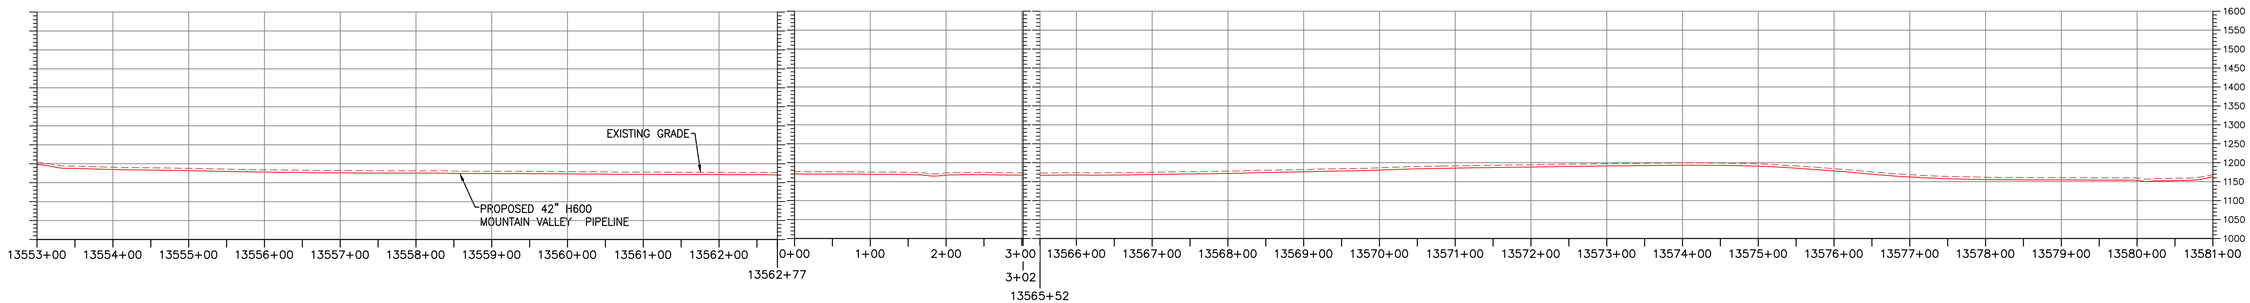

PROFILE

HORIZONTAL SCALE: SCALE: 1" = 100'

100 0 100 200

VERTICAL SCALE: SCALE: 1" = 200'

200 0 200 400

LEGEND

- PROPOSED LIMIT OF DISTURBANCE
- STREAM
- USDA FOREST SERVICE (NATIONAL FOREST) LANDS
- APPALACHIAN NATIONAL SCENIC TRAIL
- EXISTING ROAD/TRAIL
- EXISTING PROPERTY LINE
- EXISTING STATE LINE
- EXISTING COUNTY LINE
- POND
- WETLAND
- ACID FORMING MATERIAL
- EXISTING FOREST
- PROPOSED ACCESS ROAD CENTERLINE
- PROPOSED PIPELINE
- PROPOSED SILT FENCE (SEE NOTE 5)
- PROPOSED SUPER SILT FENCE (SEE DETAIL MVP-ES9.2)
- PROPOSED REINFORCED FILTRATION DEVICE (SEE DETAILS MVP-ES9, 9.1, 9.2, 9.3)
- ORANGE CONSTRUCTION SAFETY FENCE
- PROPOSED COMPOST FILTER SOCK (SEE DETAILS MVP-ES3, 3.1, 3.2)
- PROPOSED COMPOST FILTER SOCK (SEE DETAILS MVP-ES3, 3.1, 3.2)
- PROPOSED COMPOST FILTER SOCK (SEE DETAILS MVP-ES3, 3.1, 3.2)
- GRASS-LINED CHANNEL (SEE DETAIL MVP-ES39)
- CLEAN WATER DIVERSION PIPE
- CLEAN WATER DIVERSION DIKE (SEE DETAIL MVP-ES50 AND MVP-ES51)
- STREAM FLOW DIRECTION
- FEMA 100 YEAR FLOODPLAIN
- DRAINAGE AREA BOUNDARY
- TIMBER MAT (SEE DETAIL MVP-ES37)
- STEEP SLOPE EROSION CONTROL (SEE NOTE 2)
- STEEP SLOPE AREAS (SEE NOTE 4)
- PROPOSED ROCK CONSTRUCTION ENTRANCE
- PROPOSED TRENCH BREAKER (SEE DETAIL MVP-20)
- TEMPORARY ROW DIVERSION/WATER BAR (SEE DETAIL MVP-17)
- PERMANENT SLOPE BREAKER/ROW DIVERSION/WATER BAR (SEE DETAIL MVP-17)

COMMONWEALTH OF VIRGINIA
DANIEL C. WITT
Lic. No. 65093
PROFESSIONAL ENGINEER
2/1/2023

THIS SEAL APPLIES ONLY TO REVISIONS DATED 02-01-23

NOTES:

1. TOPSOIL SEGREGATION WILL BE PERFORMED IN ALL IMMEDIATE CONSTRUCTION AREAS OF THE PROJECT IN ACCORDANCE WITH DETAILS MVP-ES46.1 THROUGH MVP-ES46.3.
2. FLEXTERRA, EARTHGUARD OR EQUIVALENT MAY BE USED AS A SUBSTITUTE TO EROSION CONTROL BLANKET AS DIRECTED BY MVP.
3. CONTRACTOR IS RESPONSIBLE TO IDENTIFY ALL UTILITIES. THE UTILITY LINES SHOWN ON THE PLAN ARE FOR INFORMATIONAL PURPOSES ONLY AND DO NOT REPRESENT SURVEYED LINE INFORMATION.
4. SLOPES OF 30° OR GREATER EXIST. CONSTRUCTION FOR STEEP SLOPES TO BE PERFORMED USING STEEP SLOPE TECHNIQUES IDENTIFIED IN THE DETAIL SHEETS. ALSO REFER TO THE SITE-SPECIFIC DESIGN OF STABILIZATION MEASURES IN SELECTED HIGH-HAZARD PORTIONS OF THE ROUTE OF THE PROPOSED MOUNTAIN VALLEY PIPLELINE PROJECT.
5. WHERE CONSTRUCTION CONDITIONS PRECLUDE THE USE OF DIVERSION DITCHES DUE TO SITE CONDITIONS THE CONTRACTOR WILL INSTALL SILT FENCE AT THE DIRECTION OF MVP.
6. IMPROVEMENTS TO PERMANENT AND TEMPORARY ACCESS ROADS WILL BE PERFORMED PER THE SITE SPECIFIC ACCESS ROAD DETAILS.
7. TEMPORARY ACCESS ROAD CROSSING OF STREAMS AND WETLANDS WILL UTILIZE TIMBERMATS. ANY PERMANENT ROAD CROSSINGS WILL BE CONDUCTED VIA CULVERTS.
8. ALL NON VMRC STREAM CROSSINGS WILL BE PERFORMED AS DESCRIBED IN THE STREAM CROSSING TABLE INCLUDED IN THIS PACKAGE.

NO.	DATE:	DWN.:	CHKD.:	APPD.:	DESCRIPTION:
–	02/01/23	JJZ	RE	DW	ADDRESS VADEQ COMMENTS ON CROSSING METHOD CHANGE
–	05/12/21	JJZ	RE	DW	CROSSING METHOD CHANGE FROM OPEN CUT TO BORE
8	11/08/18	JJZ	RE	DW	ADDRESS VADEQ COMMENTS TO FIELD MODIFICATION SUBMITTAL
7	06/22/18	JJZ	RE	DW	FIELD MODIFICATION
6	03/16/18	KAL	RE	DW	ADDRESS VADEQ COMMENTS
5	03/04/18	KAL	RE	DW	ADDRESS VADEQ COMMENTS

REVISIONS:

Mountain Valley PIPELINE

EROSION AND SEDIMENT CONTROL PLANS

MOUNTAIN VALLEY PIPELINE PROJECT – H600 LINE

SPREAD 10 – FRANKLIN COUNTY, VIRGINIA

MOUNTAIN VALLEY PIPELINE, LLC
2200 ENERGY DRIVE
CANONSBURG, PA 15317


TETRA TECH
complex world | CLEAR SOLUTIONS™
661 ANDERSEN DRIVE
FOSTER PLAZA 7
PITTSBURGH, PA 15220

EROSION AND SEDIMENT CONTROL PLANS

COMMONWEALTH OF VIRGINIA
DAVID J. WALLNER
Lic. No. 57593
PROFESSIONAL ENGINEER
5/12/2023

DRAWN BY:	JJZ
CHECKED BY:	RE
APPROVED BY:	DW
DATE:	02/01/2023
SCALE:	AS SHOWN
REVISION	–

SHT. NO. 14.46ES OF 14.81ES

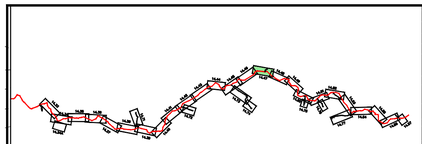


LOCATION MAP

PLAN

SCALE: 1" = 100'

100 0 100 200

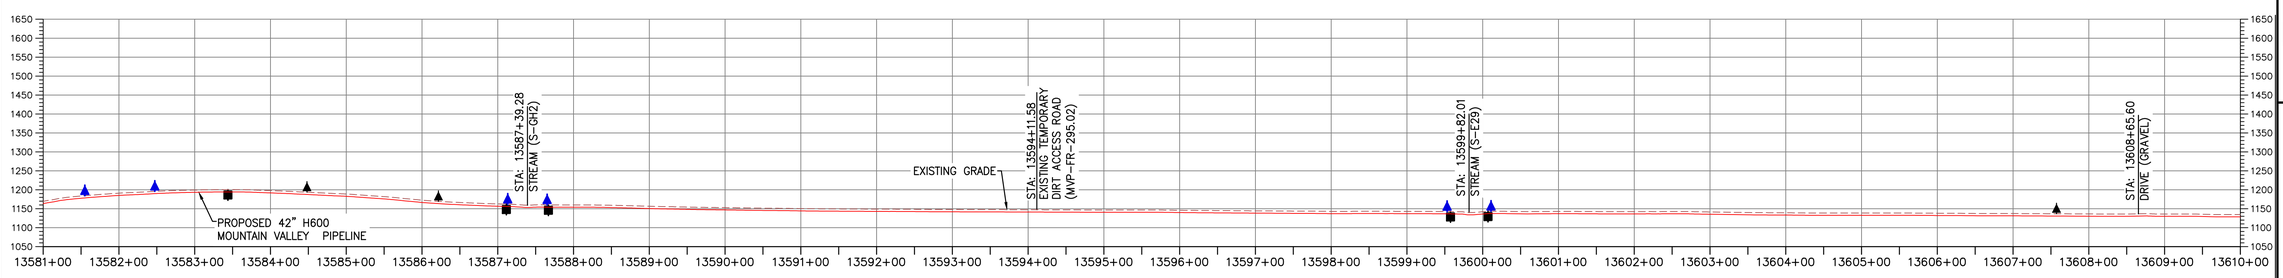

PROFILE

HORIZONTAL SCALE: SCALE: 1" = 100'

VERTICAL SCALE: SCALE: 1" = 200'

100 0 100 200 200 0 200 400

LEGEND

- PROPOSED LIMIT OF DISTURBANCE
- STREAM
- USDA FOREST SERVICE (NATIONAL FOREST) LANDS
- APPALACHIAN NATIONAL SCENIC TRAIL
- EXISTING ROAD/TRAIL
- EXISTING PROPERTY LINE
- EXISTING STATE LINE
- EXISTING COUNTY LINE
- POND
- WETLAND
- ACID FORMING MATERIAL
- EXISTING FOREST
- PROPOSED ACCESS ROAD CENTERLINE
- PROPOSED PIPELINE
- PROPOSED SILT FENCE (SEE NOTE 5)
- PROPOSED SUPER SILT FENCE (SEE DETAIL MVP–ES9.2)
- PROPOSED REINFORCED FILTRATION DEVICE (SEE DETAILS MVP–ES9, 9.1, 9.2, 9.3)
- ORANGE CONSTRUCTION SAFETY FENCE
- PROPOSED COMPOST FILTER SOCK (SEE DETAILS MVP–ES3, 3.1, 3.2)
- PROPOSED COMPOST FILTER SOCK (SEE DETAILS MVP–ES3, 3.1, 3.2)
- PROPOSED COMPOST FILTER SOCK (SEE DETAILS MVP–ES3, 3.1, 3.2)
- GRASS–LINED CHANNEL (SEE DETAIL MVP–ES39)
- CLEAN WATER DIVERSION PIPE
- CLEAN WATER DIVERSION DIKE (SEE DETAIL MVP–ES50 AND MVP–ES51)
- STREAM FLOW DIRECTION
- FEMA 100 YEAR FLOODPLAIN
- DRAINAGE AREA BOUNDARY
- TIMBER MAT (SEE DETAIL MVP–ES37)
- STEEP SLOPE EROSION CONTROL (SEE NOTE 2)
- STEEP SLOPE AREAS (SEE NOTE 4)
- PROPOSED ROCK CONSTRUCTION ENTRANCE
- PROPOSED TRENCH BREAKER (SEE DETAIL MVP–20)
- TEMPORARY ROW DIVERSION/WATER BAR (SEE DETAIL MVP–17)
- PERMANENT SLOPE BREAKER/ROW DIVERSION/WATER BAR (SEE DETAIL MVP–17)

COMMONWEALTH OF VIRGINIA
DANIEL C. WITT
Lic. No. 65093
2/1/2023
PROFESSIONAL ENGINEER

THIS SEAL APPLIES ONLY TO REVISIONS DATED 02–01–23

NOTES:

1. TOPSOIL SEGREGATION WILL BE PERFORMED IN ALL IMMEDIATE CONSTRUCTION AREAS OF THE PROJECT IN ACCORDANCE WITH DETAILS MVP–ES46.1 THROUGH MVP–ES46.3.
2. FLEXTERRA, EARTHGUARD OR EQUIVALENT MAY BE USED AS A SUBSTITUTE TO EROSION CONTROL BLANKET AS DIRECTED BY MVP.
3. CONTRACTOR IS RESPONSIBLE TO IDENTIFY ALL UTILITIES. THE UTILITY LINES SHOWN ON THE PLAN ARE FOR INFORMATIONAL PURPOSES ONLY AND DO NOT REPRESENT SURVEYED LINE INFORMATION.
4. SLOPES OF 30" OR GREATER EXIST. CONSTRUCTION FOR STEEP SLOPES TO BE PERFORMED USING STEEP SLOPE TECHNIQUES IDENTIFIED IN THE DETAIL SHEETS. ALSO REFER TO THE SITE–SPECIFIC DESIGN OF STABILIZATION MEASURES IN SELECTED HIGH–HAZARD PORTIONS OF THE ROUTE OF THE PROPOSED MOUNTAIN VALLEY PIPLELINE PROJECT.
5. WHERE CONSTRUCTION CONDITIONS PRECLUDE THE USE OF DIVERSION DITCHES DUE TO SITE CONDITIONS THE CONTRACTOR WILL INSTALL SILT FENCE AT THE DIRECTION OF MVP.
6. IMPROVEMENTS TO PERMANENT AND TEMPORARY ACCESS ROADS WILL BE PERFORMED PER THE SITE SPECIFIC ACCESS ROAD DETAILS.
7. TEMPORARY ACCESS ROAD CROSSING OF STREAMS AND WETLANDS WILL UTILIZE TIMBERMATS. ANY PERMANENT ROAD CROSSINGS WILL BE CONDUCTED VIA CULVERTS.
8. ALL NON VMRC STREAM CROSSINGS WILL BE PERFORMED AS DESCRIBED IN THE STREAM CROSSING TABLE INCLUDED IN THIS PACKAGE.

REVISIONS:

NO.:	DATE:	DWN.:	CHKD.:	APPD.:	DESCRIPTION:
–	02/01/23	JJZ	TD	DCW	ADDRESS DEQ COMMENTS ON CROSSING CHANGE METHOD
–	05/12/21	JJZ	RE	DW	CROSSING METHOD CHANGE FROM OPEN CUT TO BORE
6	03/16/18	KAL	RE	DW	ADDRESS VADEQ COMMENTS
5	03/04/18	KAL	RE	DW	ADDRESS VADEQ COMMENTS
4	02/27/18	KAL	RE	DW	ADDRESS VADEQ COMMENTS

Mountain Valley PIPELINE

EROSION AND SEDIMENT CONTROL PLANS

MOUNTAIN VALLEY PIPELINE PROJECT – H600 LINE

SPREAD 10 – FRANKLIN COUNTY, VIRGINIA

MOUNTAIN VALLEY PIPELINE, LLC
2200 ENERGY DRIVE
CANONSBURG, PA 15317

TETRA TECH
complex world | CLEAR SOLUTIONS™
661 ANDERSEN DRIVE
FOSTER PLAZA 7
PITTSBURGH, PA 15220


EROSION AND SEDIMENT CONTROL PLANS

COMMONWEALTH OF VIRGINIA
DAVID J. WALLNER
Lic. No. 57593
5/12/2021
PROFESSIONAL ENGINEER

DRAWN BY:	JJZ
CHECKED BY:	TD
APPROVED BY:	DCW
DATE:	02/01/2023
SCALE:	AS SHOWN
SHT. NO.	14.47ES OF 14.81ES


REVISION

TETRA TECH CAD FILE PATH: X:\CADD_Pittsburgh\EQT\7157 – MVP\15 – Franklin\E&S\ES Version 5.0.0\7157ES14.47(S10) (BORE PIT REV).dwg PLOTTED ON: 1/30/2023 10:20 AM PLOTTED BY: Zeigler, Justin PLOT FILE: ENVIRONMENTAL_COLOR.ctb

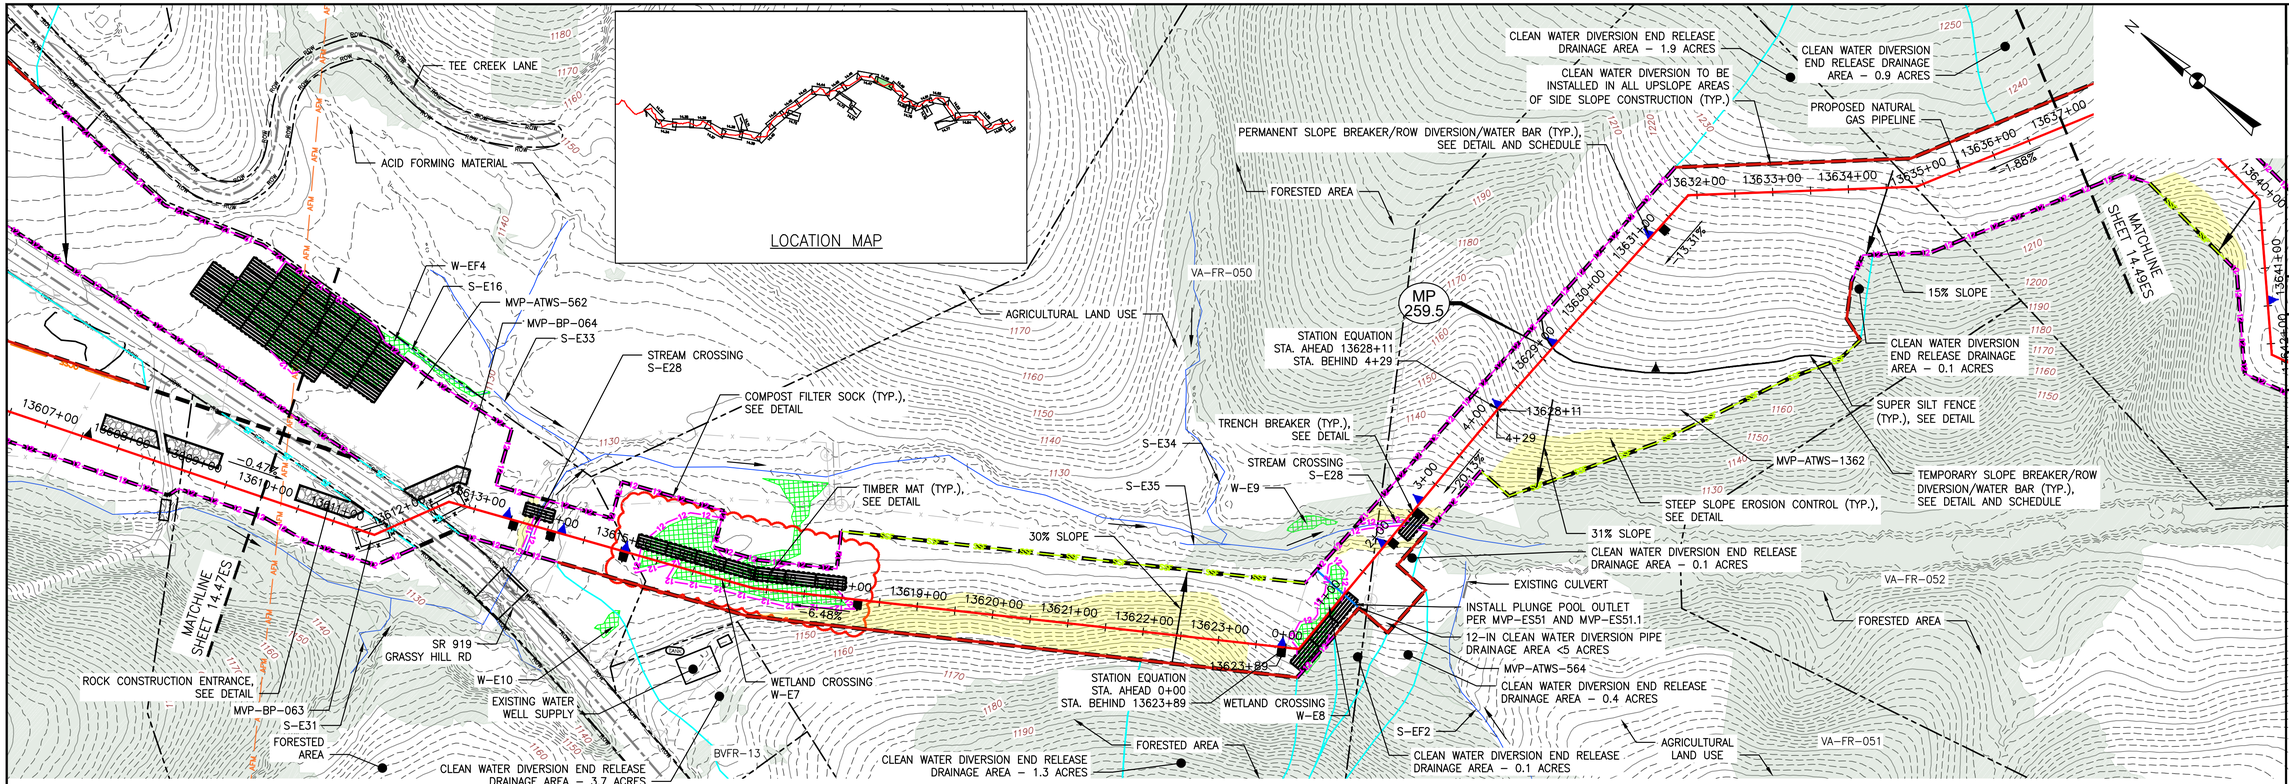

PLAN

SCALE: 1" = 100'

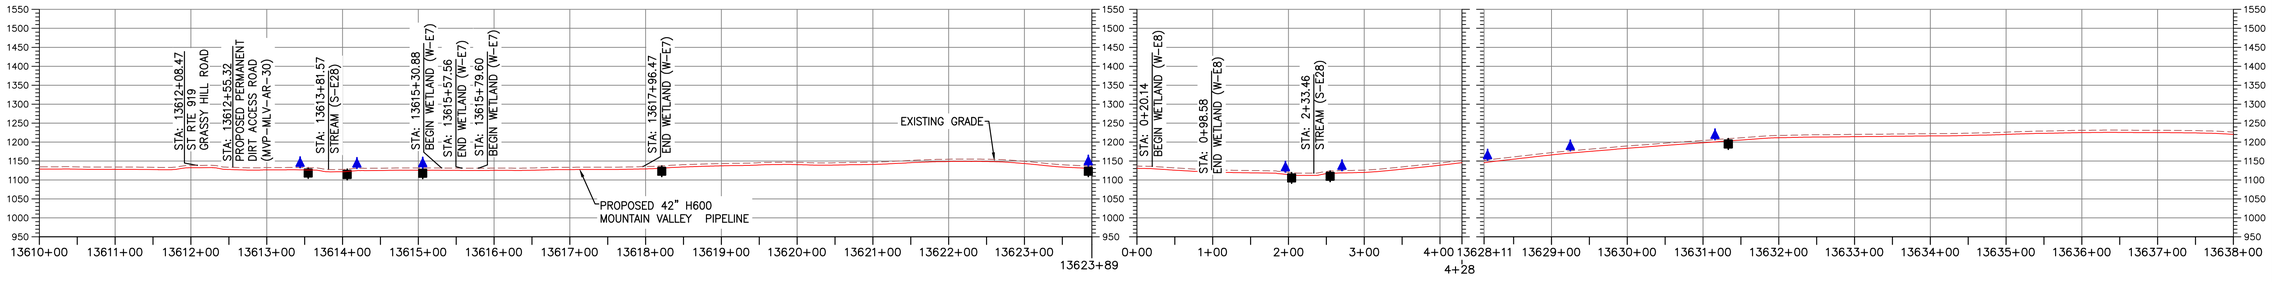

PROFILE

HORIZONTAL SCALE: SCALE: 1" = 100'

VERTICAL SCALE: SCALE: 1" = 200'

LEGEND

- PROPOSED LIMIT OF DISTURBANCE
- STREAM
- USDA FOREST SERVICE (NATIONAL FOREST) LANDS
- APPALACHIAN NATIONAL SCENIC TRAIL
- EXISTING ROAD/TRAIL
- EXISTING PROPERTY LINE
- EXISTING STATE LINE
- EXISTING COUNTY LINE
- POND
- WETLAND
- ACID FORMING MATERIAL
- EXISTING FOREST
- PROPOSED ACCESS ROAD CENTERLINE
- PROPOSED PIPELINE
- PROPOSED SILT FENCE (SEE NOTE 5)
- PROPOSED SUPER SILT FENCE (SEE DETAIL MVP-ES9.2)
- PROPOSED REINFORCED FILTRATION DEVICE (SEE DETAILS MVP-ES9, 9.1, 9.2, 9.3)
- ORANGE CONSTRUCTION SAFETY FENCE
- PROPOSED COMPOST FILTER SOCK (SEE DETAILS MVP-ES3, 3.1, 3.2)
- PROPOSED COMPOST FILTER SOCK (SEE DETAILS MVP-ES3, 3.1, 3.2)
- PROPOSED COMPOST FILTER SOCK (SEE DETAILS MVP-ES3, 3.1, 3.2)
- GRASS-LINED CHANNEL (SEE DETAIL MVP-ES39)
- CLEAN WATER DIVERSION PIPE
- CLEAN WATER DIVERSION DIKE (SEE DETAIL MVP-ES50 AND MVP-ES51)
- STREAM FLOW DIRECTION
- FEMA 100 YEAR FLOODPLAIN
- DRAINAGE AREA BOUNDARY
- TIMBER MAT (SEE DETAIL MVP-ES37)
- STEEP SLOPE EROSION CONTROL (SEE NOTE 2)
- STEEP SLOPE AREAS (SEE NOTE 4)
- PROPOSED ROCK CONSTRUCTION ENTRANCE
- PROPOSED TRENCH BREAKER (SEE DETAIL MVP-20)
- TEMPORARY ROW DIVERSION/WATER BAR (SEE DETAIL MVP-17)
- PERMANENT SLOPE BREAKER/ROW DIVERSION/WATER BAR (SEE DETAIL MVP-17)

NOTES:

1. TOPSOIL SEGREGATION WILL BE PERFORMED IN ALL IMMEDIATE CONSTRUCTION AREAS OF THE PROJECT IN ACCORDANCE WITH DETAILS MVP-ES46.1 THROUGH MVP-ES46.3.
2. FLEXTERRA, EARTHGUARD OR EQUIVALENT MAY BE USED AS A SUBSTITUTE TO EROSION CONTROL BLANKET AS DIRECTED BY MVP.
3. CONTRACTOR IS RESPONSIBLE TO IDENTIFY ALL UTILITIES. THE UTILITY LINES SHOWN ON THE PLAN ARE FOR INFORMATIONAL PURPOSES ONLY AND DO NOT REPRESENT SURVEYED LINE INFORMATION.
4. SLOPES OF 30' OR GREATER EXIST. CONSTRUCTION FOR STEEP SLOPES TO BE PERFORMED USING STEEP SLOPE TECHNIQUES IDENTIFIED IN THE DETAIL SHEETS. ALSO REFER TO THE SITE-SPECIFIC DESIGN OF STABILIZATION MEASURES IN SELECTED HIGH-HAZARD PORTIONS OF THE ROUTE OF THE PROPOSED MOUNTAIN VALLEY PIPELINE PROJECT.
5. WHERE CONSTRUCTION CONDITIONS PRECLUDE THE USE OF DIVERSION DITCHES DUE TO SITE CONDITIONS THE CONTRACTOR WILL INSTALL SILT FENCE AT THE DIRECTION OF MVP.
6. IMPROVEMENTS TO PERMANENT AND TEMPORARY ACCESS ROADS WILL BE PERFORMED PER THE SITE SPECIFIC ACCESS ROAD DETAILS.
7. TEMPORARY ACCESS ROAD CROSSING OF STREAMS AND WETLANDS WILL UTILIZE TIMBERMATS. ANY PERMANENT ROAD CROSSINGS WILL BE CONDUCTED VIA CULVERTS.
8. ALL NON VMRC STREAM CROSSINGS WILL BE PERFORMED AS DESCRIBED IN THE STREAM CROSSING TABLE INCLUDED IN THIS PACKAGE.

NO.	DATE:	DWN.:	CHKD.:	APPD.:	DESCRIPTION:
–	06/24/20	JK	RE	DW	CHANGES TO AQUATIC RESOURCES DELINEATIONS
5	03/04/18	KAL	RE	DW	ADDRESS VADEQ COMMENTS
4	02/27/18	KAL	RE	DW	ADDRESS VADEQ COMMENTS
3	02/05/18	KAL	RE	DW	ADDRESS VADEQ COMMENTS
2	11/21/17	KAL	RE	DW	ADDRESS VADEQ COMMENTS
1	09/21/17	KAL	RE	DW	PLAN SUBMISSION

REVISIONS:

Mountain Valley PIPELINE

EROSION AND SEDIMENT CONTROL PLANS

MOUNTAIN VALLEY PIPELINE PROJECT – H600 LINE

SPREAD 10 – FRANKLIN COUNTY, VIRGINIA


MOUNTAIN VALLEY PIPELINE, LLC
2200 ENERGY DRIVE
CANONSBURG, PA 15317

TETRA TECH
complex world | CLEAR SOLUTIONS™
661 ANDERSEN DRIVE
FOSTER PLAZA 7
PITTSBURGH, PA 15220

EROSION AND SEDIMENT CONTROL PLANS

COMMONWEALTH OF VIRGINIA
DAVID J. WALLNER
Lic. No. 0402057593
PROFESSIONAL ENGINEER


DRAWN BY:	JK
CHECKED BY:	RE
APPROVED BY:	DW
DATE:	06/24/2020
SCALE:	AS SHOWN
REVISION	–
SHT. NO.	14.48ES OF 14.81ES

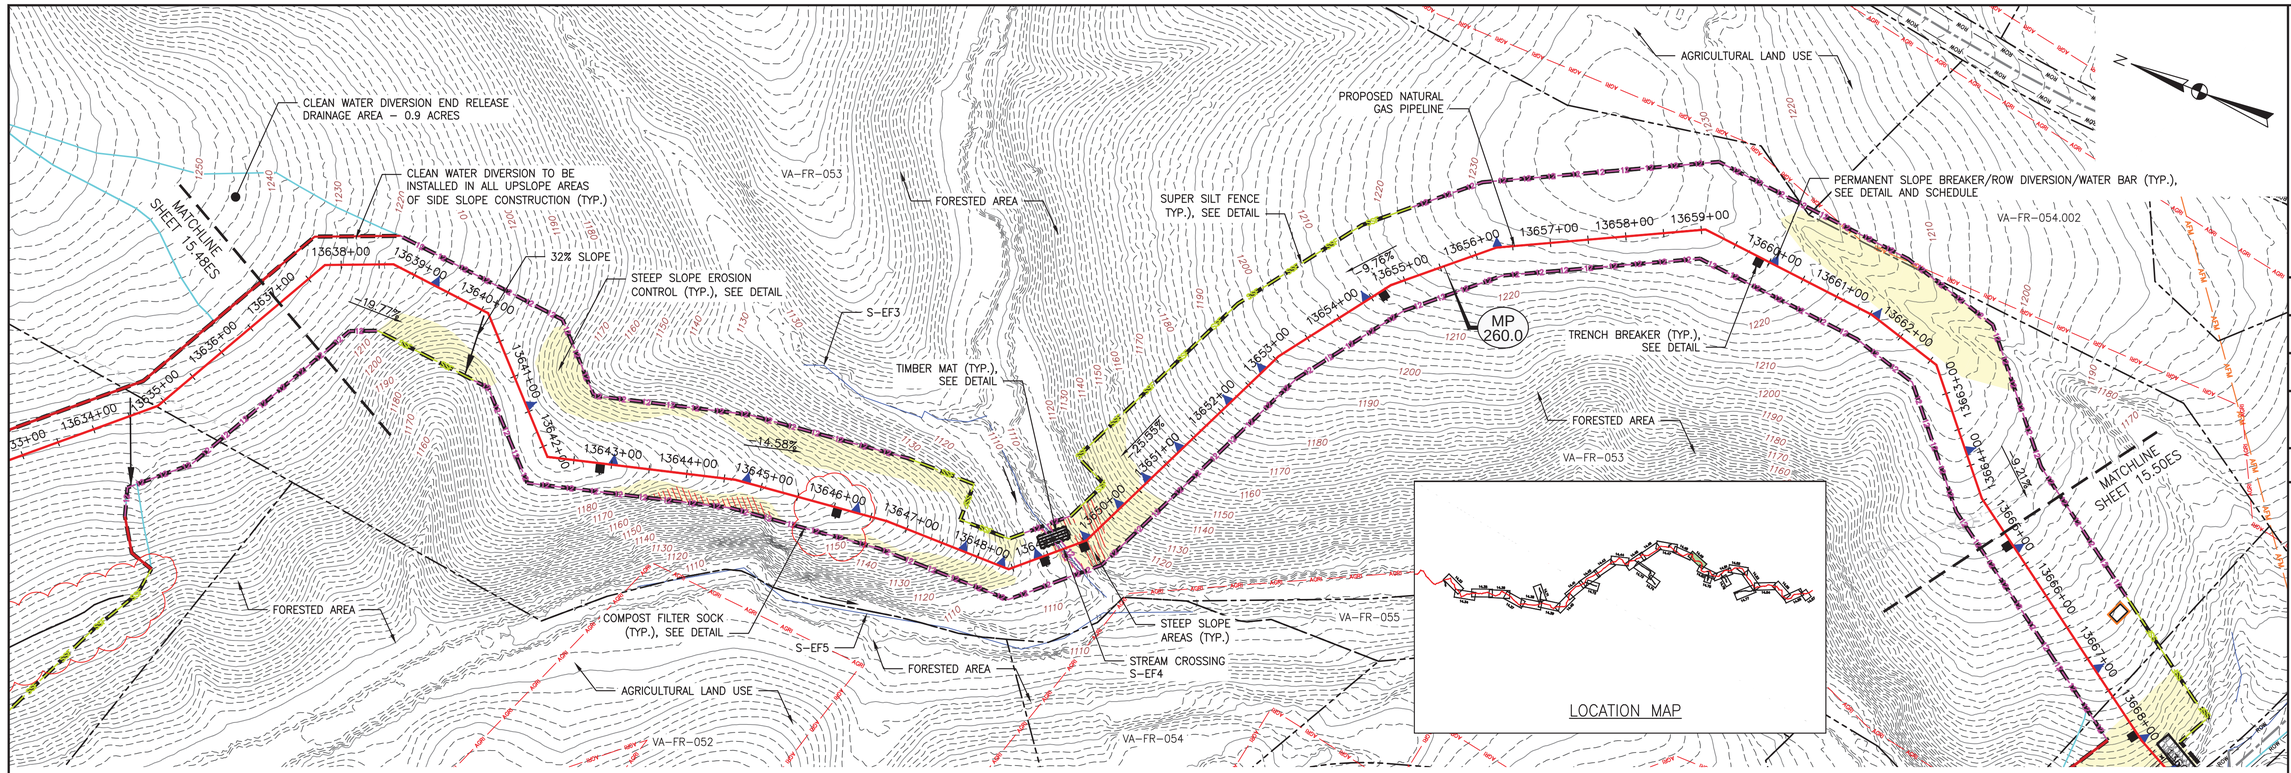

PLAN

SCALE: 1" = 100'

100 0 100 200

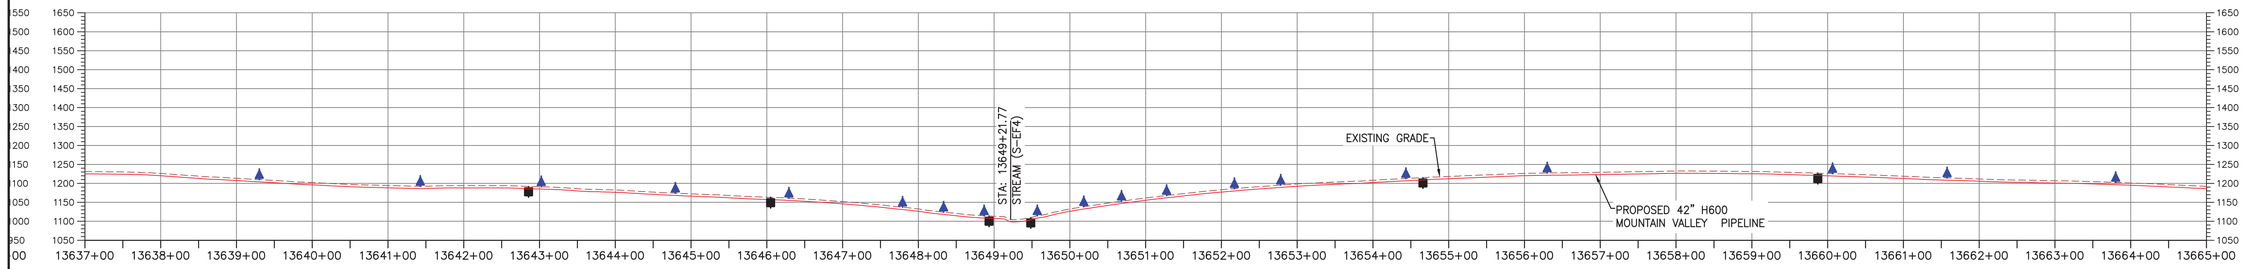

PROFILE

HORIZONTAL SCALE:

SCALE: 1" = 100'

100 0 100 200

VERTICAL SCALE:

SCALE: 1" = 200'

200 0 200 400

LEGEND

- PROPOSED LIMIT OF DISTURBANCE
- STREAM
- USDA FOREST SERVICE (NATIONAL FOREST) LANDS
- APPALACHIAN NATIONAL SCENIC TRAIL
- EXISTING ROAD/TRAIL
- EXISTING PROPERTY LINE
- EXISTING STATE LINE
- EXISTING COUNTY LINE
- POND
- WETLAND
- ACID FORMING MATERIAL
- AGRICULTURAL LAND USE BOUNDARY
- PROPOSED ACCESS ROAD CENTERLINE
- PROPOSED PIPELINE
- PROPOSED SILT FENCE (SEE NOTE 5)
- PROPOSED SUPER SILT FENCE (SEE DETAIL MVP–ES9.2)
- PROPOSED REINFORCED FILTRATION DEVICE (SEE DETAILS MVP–ES9, 9.1, 9.2, 9.3)
- ORANGE CONSTRUCTION SAFETY FENCE
- PROPOSED COMPOST FILTER SOCK (SEE DETAILS MVP–ES3, 3.1, 3.2)
- PROPOSED COMPOST FILTER SOCK (SEE DETAILS MVP–ES3, 3.1, 3.2)
- PROPOSED COMPOST FILTER SOCK (SEE DETAILS MVP–ES3, 3.1, 3.2)
- GRASS–LINED CHANNEL (SEE DETAIL MVP–ES39)
- CLEAN WATER DIVERSION PIPE
- CLEAN WATER DIVERSION DIKE (SEE DETAIL MVP–ES50 AND MVP–ES51)
- STREAM FLOW DIRECTION
- FEMA 100 YEAR FLOODPLAIN
- DRAINAGE AREA BOUNDARY
- TIMBER MAT (SEE DETAIL MVP–ES37)
- STEEP SLOPE EROSION CONTROL (SEE NOTE 2)
- STEEP SLOPE AREAS (SEE NOTE 4)
- PROPOSED ROCK CONSTRUCTION ENTRANCE
- PROPOSED TRENCH BREAKER (SEE DETAIL MVP–20)
- TEMPORARY ROW DIVERSION/WATER BAR (VADEQ STD & SPEC 3.11)
- PERMANENT SLOPE BREAKER/ROW DIVERSION/WATER BAR (SEE DETAILS MVP–17, ES38, AND SCHEDULE)

NOTES:

1. TOPSOIL SEGREGATION WILL BE PERFORMED IN ALL IMMEDIATE CONSTRUCTION AREAS OF THE PROJECT IN ACCORDANCE WITH DETAILS MVP–ES46.1 THROUGH MVP–ES46.3.
2. FLEXTERRA, EARTHGUARD OR EQUIVALENT MAY BE USED AS A SUBSTITUTE TO EROSION CONTROL BLANKET AS DIRECTED BY MVP.
3. CONTRACTOR IS RESPONSIBLE TO IDENTIFY ALL UTILITIES. THE UTILITY LINES SHOWN ON THE PLAN ARE FOR INFORMATIONAL PURPOSES ONLY AND DO NOT REPRESENT SURVEYED LINE INFORMATION.
4. SLOPES OF 30' OR GREATER EXIST. CONSTRUCTION FOR STEEP SLOPES TO BE PERFORMED USING STEEP SLOPE TECHNIQUES IDENTIFIED IN THE DETAIL SHEETS. ALSO REFER TO THE SITE–SPECIFIC DESIGN OF STABILIZATION MEASURES IN SELECTED HIGH–HAZARD PORTIONS OF THE ROUTE OF THE PROPOSED MOUNTAIN VALLEY PIPELINE PROJECT.
5. WHERE CONSTRUCTION CONDITIONS PRECLUDE THE USE OF DIVERSION DITCHES DUE TO SITE CONDITIONS THE CONTRACTOR WILL INSTALL SILT FENCE AT THE DIRECTION OF MVP.
6. IMPROVEMENTS TO PERMANENT AND TEMPORARY ACCESS ROADS WILL BE PERFORMED PER THE SITE SPECIFIC ACCESS ROAD DETAILS.
7. TEMPORARY ACCESS ROAD CROSSING OF STREAMS AND WETLANDS WILL UTILIZE TIMBERMATS. ANY PERMANENT ROAD CROSSINGS WILL BE CONDUCTED VIA CULVERTS.
8. ALL NON VMRC STREAM CROSSINGS WILL BE PERFORMED AS DESCRIBED IN THE STREAM CROSSING TABLE INCLUDED IN THIS PACKAGE.

NO.	DATE:	DWN.:	CHKD.:	APPD.:	DESCRIPTION:
5	03/04/18	KAL	RE	DW	ADDRESS VADEQ COMMENTS
4	02/27/18	KAL	RE	DW	ADDRESS VADEQ COMMENTS
3	02/05/18	KAL	RE	DW	ADDRESS VADEQ COMMENTS
2	11/21/17	KAL	RE	DW	ADDRESS VADEQ COMMENTS
1	09/21/17	KAL	RE	DW	PLAN SUBMISSION

REVISIONS:

Mountain Valley PIPELINE

EROSION AND SEDIMENT CONTROL PLANS

MOUNTAIN VALLEY PIPELINE PROJECT – H600 LINE

SPREAD 10 – FRANKLIN COUNTY, VIRGINIA

MOUNTAIN VALLEY PIPELINE, LLC
555 SOUTHPOINTE BOULEVARD, SUITE 200
CANONSBURG, PA 15317


TETRA TECH
complex world | CLEAR SOLUTIONS™
661 ANDERSEN DRIVE
FOSTER PLAZA 7
PITTSBURGH, PA 15220

EROSION AND SEDIMENT CONTROL PLANS

COMMONWEALTH OF VIRGINIA
DAVID J. WALLNER
Lic. No. 0402057593
PROFESSIONAL ENGINEER

DRAWN BY:	KAL
CHECKED BY:	RE
APPROVED BY:	DW
DATE:	03/04/2018
SCALE:	AS SHOWN
REVISION	
SHT. NO.	14.49ES OF 14.81ES


TETRA TECH CAD FILE PATH: X:\CADD_Pittsburgh\EQT\7157 – MVP\15 – Franklin\E&S\ES Version 5.0.0\7157ES14.49(S10).dwg PLOTTED ON: 3/2/2018 3:49 PM PLOTTED BY: Zeigler, Justin PLOT FILE: ENVIRONMENTAL_COLOR.ctb

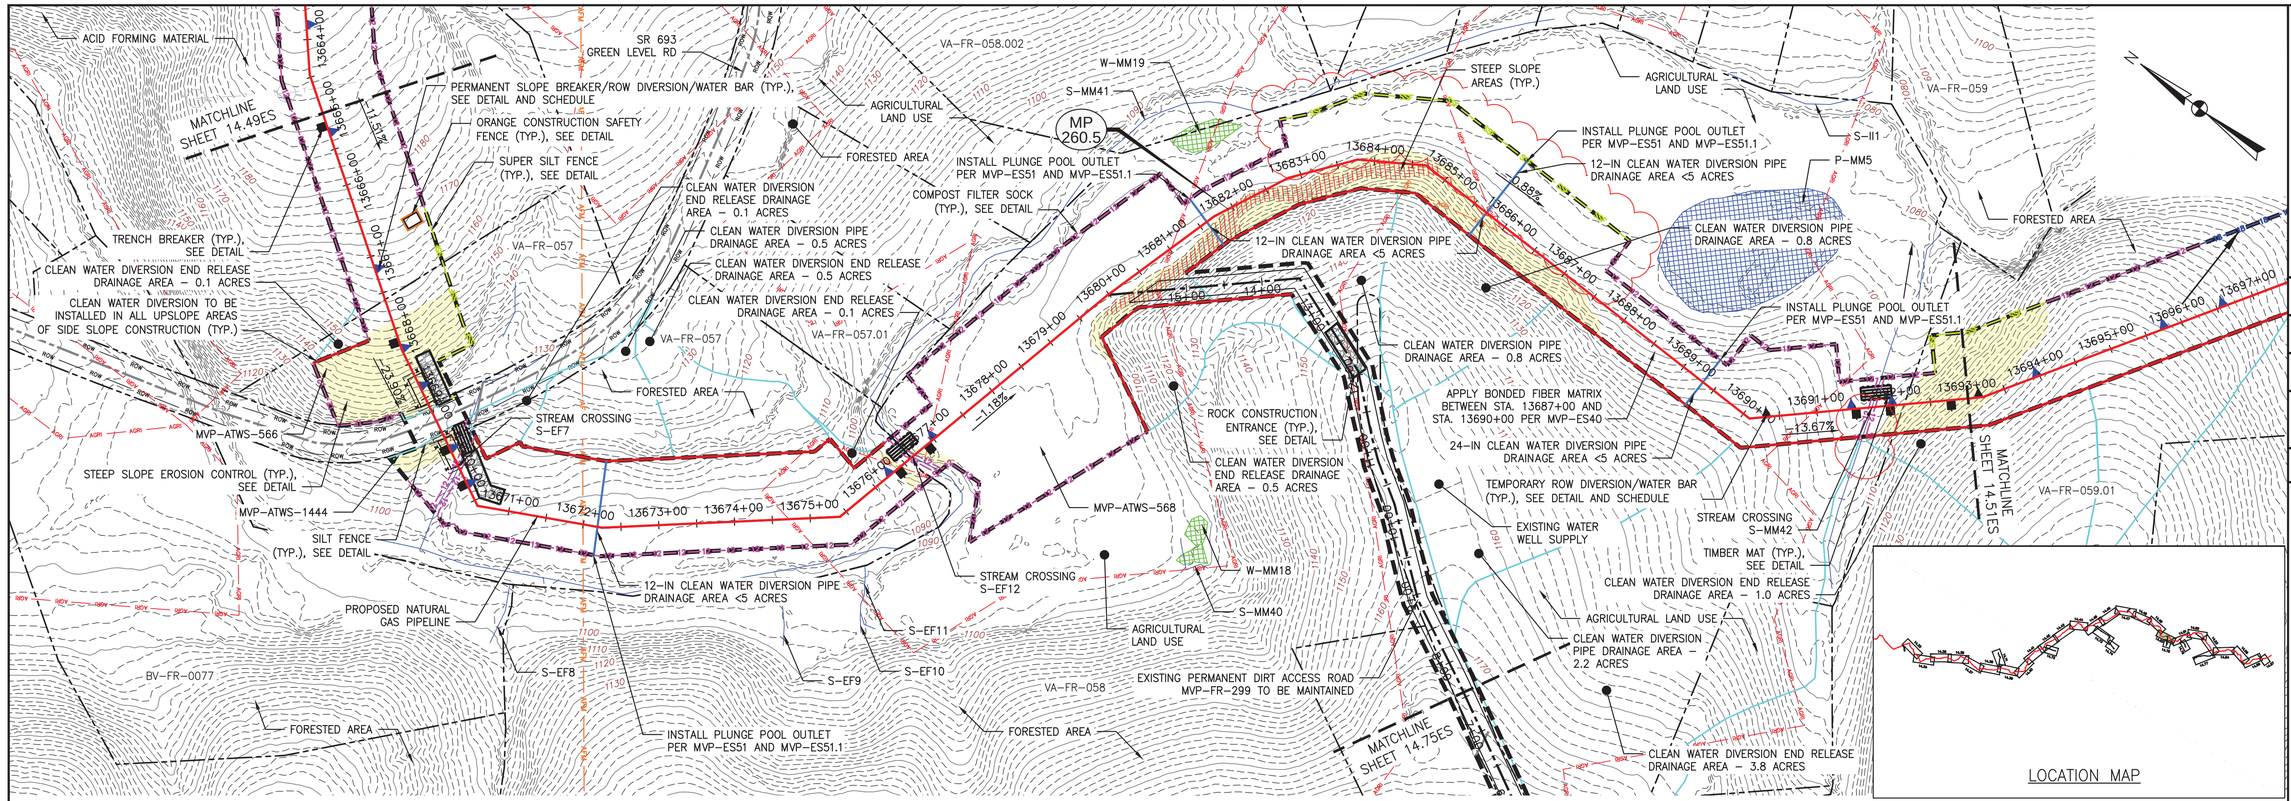

PLAN

SCALE: 1" = 100'

100 0 100 200

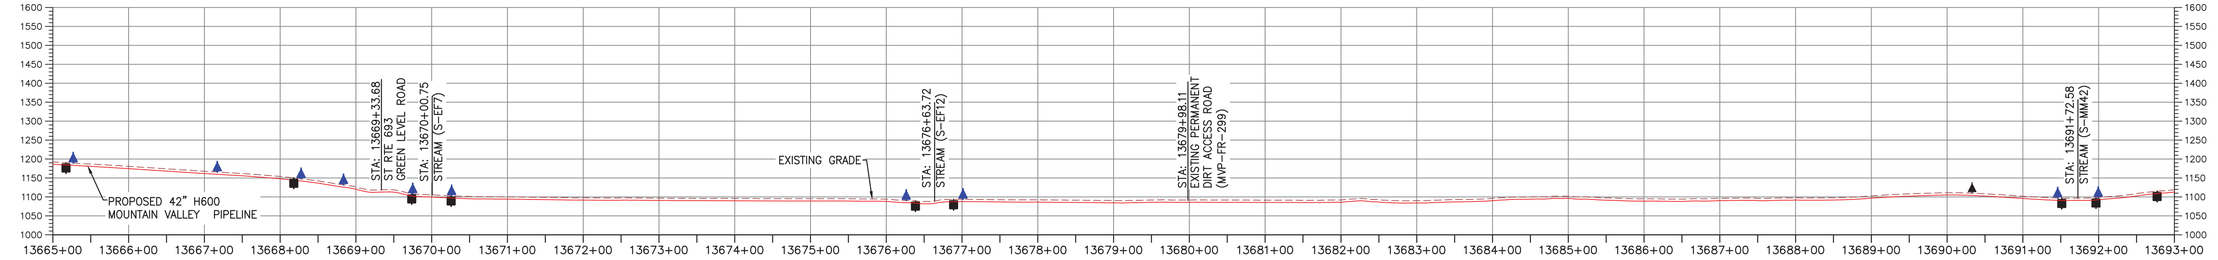

PROFILE

HORIZONTAL SCALE: SCALE: 1" = 100'

100 0 100 200

VERTICAL SCALE: SCALE: 1" = 200'

200 0 200 400

LEGEND

- PROPOSED LIMIT OF DISTURBANCE
- STREAM
- USDA FOREST SERVICE (NATIONAL FOREST) LANDS
- APPALACHIAN NATIONAL SCENIC TRAIL
- EXISTING ROAD/TRAIL
- EXISTING PROPERTY LINE
- EXISTING STATE LINE
- EXISTING COUNTY LINE
- POND
- WETLAND
- ACID FORMING MATERIAL
- AGRICULTURAL LAND USE BOUNDARY
- PROPOSED ACCESS ROAD CENTERLINE
- PROPOSED PIPELINE
- PROPOSED SILT FENCE (SEE NOTE 5)
- PROPOSED SUPER SILT FENCE (SEE DETAIL MVP-ES9.2)
- PROPOSED REINFORCED FILTRATION DEVICE (SEE DETAILS MVP-ES9, 9.1, 9.2, 9.3)
- ORANGE CONSTRUCTION SAFETY FENCE
- PROPOSED COMPOST FILTER SOCK (SEE DETAILS MVP-ES3, 3.1, 3.2)
- PROPOSED COMPOST FILTER SOCK (SEE DETAILS MVP-ES3, 3.1, 3.2)
- PROPOSED COMPOST FILTER SOCK (SEE DETAILS MVP-ES3, 3.1, 3.2)
- GRASS-LINED CHANNEL (SEE DETAIL MVP-ES39)
- CLEAN WATER DIVERSION PIPE
- CLEAN WATER DIVERSION DIKE (SEE DETAIL MVP-ES50 AND MVP-ES51)
- STREAM FLOW DIRECTION
- FEMA 100 YEAR FLOODPLAIN
- DRAINAGE AREA BOUNDARY
- TIMBER MAT (SEE DETAIL MVP-ES37)
- STEEP SLOPE EROSION CONTROL (SEE NOTE 2)
- STEEP SLOPE AREAS (SEE NOTE 4)
- PROPOSED ROCK CONSTRUCTION ENTRANCE
- PROPOSED TRENCH BREAKER (SEE DETAIL MVP-20)
- TEMPORARY ROW DIVERSION/WATER BAR (VADEQ STD & SPEC 3.11)
- PERMANENT SLOPE BREAKER/ROW DIVERSION/WATER BAR (SEE DETAILS MVP-17, ES38, AND SCHEDULE)

NOTES:

1. TOPSOIL SEGREGATION WILL BE PERFORMED IN ALL IMMEDIATE CONSTRUCTION AREAS OF THE PROJECT IN ACCORDANCE WITH DETAILS MVP-ES46.1 THROUGH MVP-ES46.3.
2. FLEXTERRA, EARTHGUARD OR EQUIVALENT MAY BE USED AS A SUBSTITUTE TO EROSION CONTROL BLANKET AS DIRECTED BY MVP.
3. CONTRACTOR IS RESPONSIBLE TO IDENTIFY ALL UTILITIES. THE UTILITY LINES SHOWN ON THE PLAN ARE FOR INFORMATIONAL PURPOSES ONLY AND DO NOT REPRESENT SURVEYED LINE INFORMATION.
4. SLOPES OF 30" OR GREATER EXIST. CONSTRUCTION FOR STEEP SLOPES TO BE PERFORMED USING STEEP SLOPE TECHNIQUES IDENTIFIED IN THE DETAIL SHEETS. ALSO REFER TO THE SITE-SPECIFIC DESIGN OF STABILIZATION MEASURES IN SELECTED HIGH-HAZARD PORTIONS OF THE ROUTE OF THE PROPOSED MOUNTAIN VALLEY PIPELINE PROJECT.
5. WHERE CONSTRUCTION CONDITIONS PRECLUDE THE USE OF DIVERSION DITCHES DUE TO SITE CONDITIONS THE CONTRACTOR WILL INSTALL SILT FENCE AT THE DIRECTION OF MVP.
6. IMPROVEMENTS TO PERMANENT AND TEMPORARY ACCESS ROADS WILL BE PERFORMED PER THE SITE SPECIFIC ACCESS ROAD DETAILS.
7. TEMPORARY ACCESS ROAD CROSSING OF STREAMS AND WETLANDS WILL UTILIZE TIMBERMATS. ANY PERMANENT ROAD CROSSINGS WILL BE CONDUCTED VIA CULVERTS.
8. ALL NON VMRC STREAM CROSSINGS WILL BE PERFORMED AS DESCRIBED IN THE STREAM CROSSING TABLE INCLUDED IN THIS PACKAGE.

NO.	DATE:	DWN.:	CHKD.:	APPD.:	DESCRIPTION:
5	03/04/18	KAL	RE	DW	ADDRESS VADEQ COMMENTS
4	02/27/18	KAL	RE	DW	ADDRESS VADEQ COMMENTS
3	02/05/18	KAL	RE	DW	ADDRESS VADEQ COMMENTS
2	11/21/17	KAL	RE	DW	ADDRESS VADEQ COMMENTS
1	09/21/17	KAL	RE	DW	PLAN SUBMISSION

REVISIONS:

Mountain Valley PIPELINE

EROSION AND SEDIMENT CONTROL PLANS

MOUNTAIN VALLEY PIPELINE PROJECT – H600 LINE

SPREAD 10 – FRANKLIN COUNTY, VIRGINIA

MOUNTAIN VALLEY PIPELINE, LLC
555 SOUTHPOINTE BOULEVARD, SUITE 200
CANONSBURG, PA 15317


TETRA TECH
complex world | CLEAR SOLUTIONS™
661 ANDERSEN DRIVE
FOSTER PLAZA 7
PITTSBURGH, PA 15220

EROSION AND SEDIMENT CONTROL PLANS

COMMONWEALTH OF VIRGINIA
DAVID J. WALLNER
Lic. No. 0402057593
PROFESSIONAL ENGINEER

DRAWN BY:	KAL
CHECKED BY:	RE
APPROVED BY:	DW
DATE:	03/04/2018
SCALE:	AS SHOWN
REVISION	5
SHT. NO.	14.50ES OF 14.81ES


TETRA TECH CAD FILE PATH: X:\CADD_Pittsburgh\EQT\7157 – MVP\15 – Franklin\E&S\ES Version 5.0.0\7157ES14.50(S10).dwg PLOTTED ON: 3/2/2018 3:53 PM PLOTTED BY: Zeigler, Justin PLOT FILE: ENVIRONMENTAL_COLOR.ctb

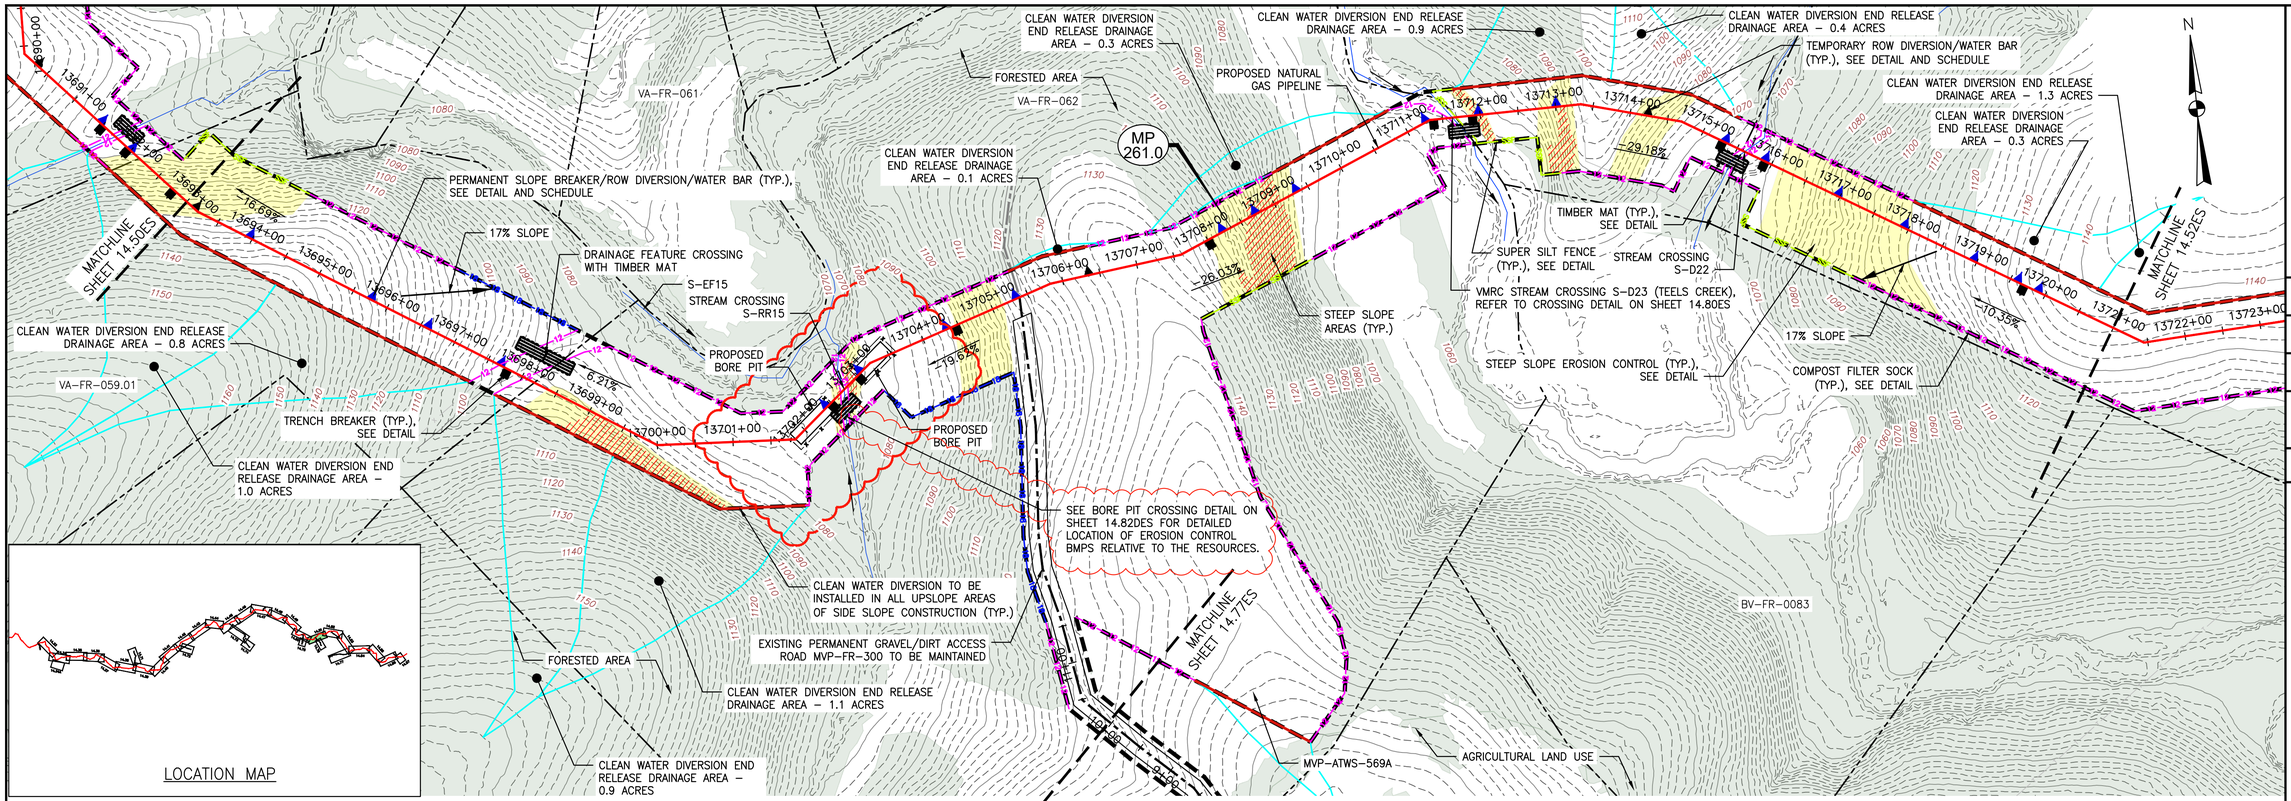

PLAN

SCALE: 1" = 100'

100 0 100 200

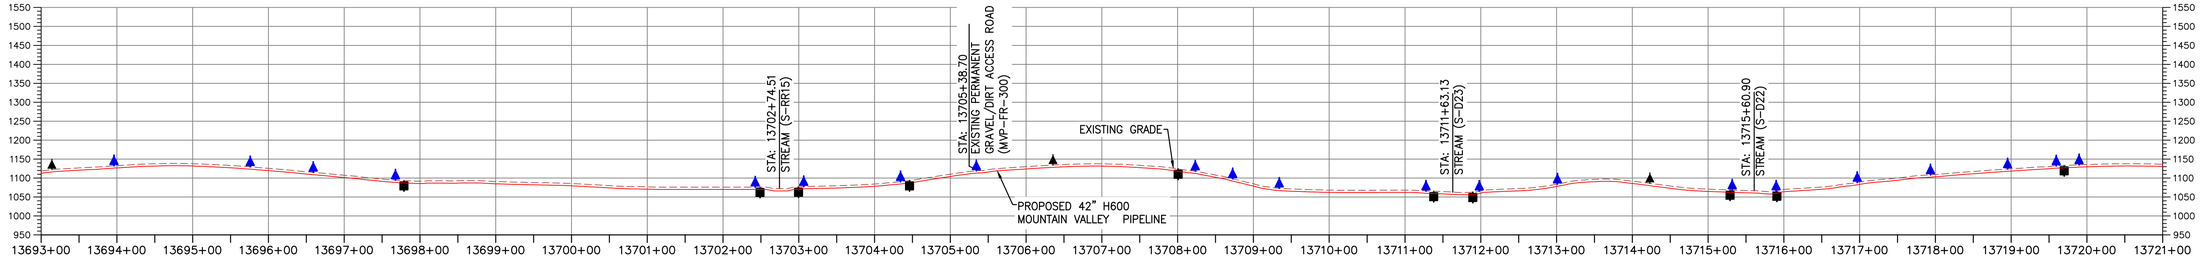

PROFILE

HORIZONTAL SCALE: SCALE: 1" = 100'

100 0 100 200

VERTICAL SCALE: SCALE: 1" = 200'

200 0 200 400

LEGEND

- PROPOSED LIMIT OF DISTURBANCE
- STREAM
- USDA FOREST SERVICE (NATIONAL FOREST) LANDS
- APPALACHIAN NATIONAL SCENIC TRAIL
- EXISTING ROAD/TRAIL
- EXISTING PROPERTY LINE
- EXISTING STATE LINE
- EXISTING COUNTY LINE
- POND
- WETLAND
- ACID FORMING MATERIAL
- EXISTING FOREST
- PROPOSED ACCESS ROAD CENTERLINE
- PROPOSED PIPELINE
- PROPOSED SILT FENCE (SEE NOTE 5)
- PROPOSED SUPER SILT FENCE (SEE DETAIL MVP–ES9.2)
- PROPOSED REINFORCED FILTRATION DEVICE (SEE DETAILS MVP–ES9, 9.1, 9.2, 9.3)
- ORANGE CONSTRUCTION SAFETY FENCE
- PROPOSED COMPOST FILTER SOCK (SEE DETAILS MVP–ES3, 3.1, 3.2)
- PROPOSED COMPOST FILTER SOCK (SEE DETAILS MVP–ES3, 3.1, 3.2)
- PROPOSED COMPOST FILTER SOCK (SEE DETAILS MVP–ES3, 3.1, 3.2)
- GRASS–LINED CHANNEL (SEE DETAIL MVP–ES39)
- CLEAN WATER DIVERSION PIPE
- CLEAN WATER DIVERSION DIKE (SEE DETAIL MVP–ES50 AND MVP–ES51)
- STREAM FLOW DIRECTION
- FEMA 100 YEAR FLOODPLAIN
- DRAINAGE AREA BOUNDARY
- TIMBER MAT (SEE DETAIL MVP–ES37)
- STEEP SLOPE EROSION CONTROL (SEE NOTE 2)
- STEEP SLOPE AREAS (SEE NOTE 4)
- PROPOSED ROCK CONSTRUCTION ENTRANCE
- PROPOSED TRENCH BREAKER (SEE DETAIL MVP–20)
- TEMPORARY ROW DIVERSION/WATER BAR (SEE DETAIL MVP–17)
- PERMANENT SLOPE BREAKER/ROW DIVERSION/WATER BAR (SEE DETAIL MVP–17)

COMMONWEALTH OF VIRGINIA
4/7/23
DANIEL C. WITT
Lic. No. 65093
PROFESSIONAL ENGINEER

THIS SEAL APPIIES ONLY TO REVISIONS DATED 04–07–2023

NOTES:

1. TOPSOIL SEGREGATION WILL BE PERFORMED IN ALL IMMEDIATE CONSTRUCTION AREAS OF THE PROJECT IN ACCORDANCE WITH DETAILS MVP–ES46.1 THROUGH MVP–ES46.3.
2. FLEXTERRA, EARTHGUARD OR EQUIVALENT MAY BE USED AS A SUBSTITUTE TO EROSION CONTROL BLANKET AS DIRECTED BY MVP.
3. CONTRACTOR IS RESPONSIBLE TO IDENTIFY ALL UTILITIES. THE UTILITY LINES SHOWN ON THE PLAN ARE FOR INFORMATIONAL PURPOSES ONLY AND DO NOT REPRESENT SURVEYED LINE INFORMATION.
4. SLOPES OF 30" OR GREATER EXIST. CONSTRUCTION FOR STEEP SLOPES TO BE PERFORMED USING STEEP SLOPE TECHNIQUES IDENTIFIED IN THE DETAIL SHEETS. ALSO REFER TO THE SITE–SPECIFIC DESIGN OF STABILIZATION MEASURES IN SELECTED HIGH–HAZARD PORTIONS OF THE ROUTE OF THE PROPOSED MOUNTAIN VALLEY PIPELINE PROJECT.
5. WHERE CONSTRUCTION CONDITIONS PRECLUDE THE USE OF DIVERSION DITCHES DUE TO SITE CONDITIONS THE CONTRACTOR WILL INSTALL SILT FENCE AT THE DIRECTION OF MVP.
6. IMPROVEMENTS TO PERMANENT AND TEMPORARY ACCESS ROADS WILL BE PERFORMED PER THE SITE SPECIFIC ACCESS ROAD DETAILS.
7. TEMPORARY ACCESS ROAD CROSSING OF STREAMS AND WETLANDS WILL UTILIZE TIMBERMATS. ANY PERMANENT ROAD CROSSINGS WILL BE CONDUCTED VIA CULVERTS.
8. ALL NON VMRC STREAM CROSSINGS WILL BE PERFORMED AS DESCRIBED IN THE STREAM CROSSING TABLE INCLUDED IN THIS PACKAGE.

NO.:	DATE:	DWN.:	CHKD.:	APPD.:	DESCRIPTION:
–	04/07/23	JJZ	TD	DCW	ADDRESS DEQ COMMENTS ON CROSSING CHANGE METHOD
–	05/12/21	JJZ	RE	DW	CROSSING METHOD CHANGE FROM OPEN CUT TO BORE
6	03/16/18	KAL	RE	DW	ADDRESS VADEQ COMMENTS
5	03/04/18	KAL	RE	DW	ADDRESS VADEQ COMMENTS
4	02/27/18	KAL	RE	DW	ADDRESS VADEQ COMMENTS

REVISIONS:

Mountain Valley PIPELINE

EROSION AND SEDIMENT CONTROL PLANS

MOUNTAIN VALLEY PIPELINE PROJECT – H600 LINE

SPREAD 10 – FRANKLIN COUNTY, VIRGINIA

MOUNTAIN VALLEY PIPELINE, LLC
2200 ENERGY DRIVE
CANONSBURG, PA 15317


TETRA TECH
complex world | CLEAR SOLUTIONS™
661 ANDERSEN DRIVE
FOSTER PLAZA 7
PITTSBURGH, PA 15220

EROSION AND SEDIMENT CONTROL PLANS

COMMONWEALTH OF VIRGINIA
5/12/2023
DAVID J. WALLNER
Lic. No. 57593
PROFESSIONAL ENGINEER

DRAWN BY:	JJZ
CHECKED BY:	TD
APPROVED BY:	DCW
DATE:	04/07/2023
SCALE:	AS SHOWN
REVISION	–
SHT. NO.	14.51ES OF 14.81ES


TETRA TECH CAD FILE PATH: X:\CADD_Pittsburgh\EQT\7157 – MVP\15 – Franklin\E&S\ES Version 5.0.0\7157ES14.51(S10).dwg PLOTTED ON: 3/31/2023 3:43 PM PLOTTED BY: Zeigler, Justin PLOT FILE: ENVIRONMENTAL_COLOR.ctb

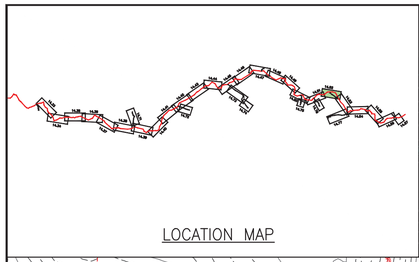

PLAN

SCALE: 1" = 100'

100 0 100 200

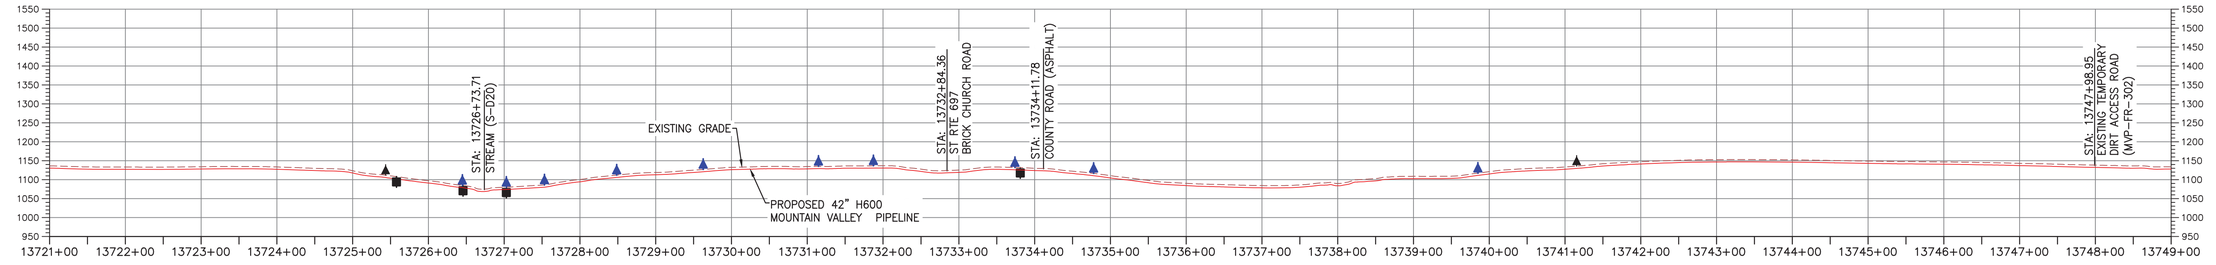

PROFILE

HORIZONTAL SCALE: SCALE: 1" = 100'

100 0 100 200

VERTICAL SCALE: SCALE: 1" = 200'

200 0 200 400

LEGEND

- PROPOSED LIMIT OF DISTURBANCE
- STREAM
- USDA FOREST SERVICE (NATIONAL FOREST) LANDS
- APPALACHIAN NATIONAL SCENIC TRAIL
- EXISTING ROAD/TRAIL
- EXISTING PROPERTY LINE
- EXISTING STATE LINE
- EXISTING COUNTY LINE
- POND
- WETLAND
- ACID FORMING MATERIAL
- AGRICULTURAL LAND USE BOUNDARY
- PROPOSED ACCESS ROAD CENTERLINE
- PROPOSED PIPELINE
- PROPOSED SILT FENCE (SEE NOTE 5)
- PROPOSED SUPER SILT FENCE (SEE DETAIL MVP–ES9.2)
- PROPOSED REINFORCED FILTRATION DEVICE (SEE DETAILS MVP–ES9, 9.1, 9.2, 9.3)
- ORANGE CONSTRUCTION SAFETY FENCE
- PROPOSED COMPOST FILTER SOCK (SEE DETAILS MVP–ES3, 3.1, 3.2)
- PROPOSED COMPOST FILTER SOCK (SEE DETAILS MVP–ES3, 3.1, 3.2)
- PROPOSED COMPOST FILTER SOCK (SEE DETAILS MVP–ES3, 3.1, 3.2)
- GRASS–LINED CHANNEL (SEE DETAIL MVP–ES39)
- CLEAN WATER DIVERSION PIPE
- CLEAN WATER DIVERSION DIKE (SEE DETAIL MVP–ES50 AND MVP–ES51)
- STREAM FLOW DIRECTION
- FEMA 100 YEAR FLOODPLAIN
- DRAINAGE AREA BOUNDARY
- TIMBER MAT (SEE DETAIL MVP–ES37)
- STEEP SLOPE EROSION CONTROL (SEE NOTE 2)
- STEEP SLOPE AREAS (SEE NOTE 4)
- PROPOSED ROCK CONSTRUCTION ENTRANCE
- PROPOSED TRENCH BREAKER (SEE DETAIL MVP–20)
- TEMPORARY ROW DIVERSION/WATER BAR (VADEQ STD & SPEC 3.11)
- PERMANENT SLOPE BREAKER/ROW DIVERSION/WATER BAR (SEE DETAILS MVP–17, ES38, AND SCHEDULE)

NOTES:

1. TOPSOIL SEGREGATION WILL BE PERFORMED IN ALL IMMEDIATE CONSTRUCTION AREAS OF THE PROJECT IN ACCORDANCE WITH DETAILS MVP–ES46.1 THROUGH MVP–ES46.3.
2. FLEXTERRA, EARTHGUARD OR EQUIVALENT MAY BE USED AS A SUBSTITUTE TO EROSION CONTROL BLANKET AS DIRECTED BY MVP.
3. CONTRACTOR IS RESPONSIBLE TO IDENTIFY ALL UTILITIES. THE UTILITY LINES SHOWN ON THE PLAN ARE FOR INFORMATIONAL PURPOSES ONLY AND DO NOT REPRESENT SURVEYED LINE INFORMATION.
4. SLOPES OF 30° OR GREATER EXIST. CONSTRUCTION FOR STEEP SLOPES TO BE PERFORMED USING STEEP SLOPE TECHNIQUES IDENTIFIED IN THE DETAIL SHEETS. ALSO REFER TO THE SITE–SPECIFIC DESIGN OF STABILIZATION MEASURES IN SELECTED HIGH–HAZARD PORTIONS OF THE ROUTE OF THE PROPOSED MOUNTAIN VALLEY PIPELINE PROJECT.
5. WHERE CONSTRUCTION CONDITIONS PRECLUDE THE USE OF DIVERSION DITCHES DUE TO SITE CONDITIONS THE CONTRACTOR WILL INSTALL SILT FENCE AT THE DIRECTION OF MVP.
6. IMPROVEMENTS TO PERMANENT AND TEMPORARY ACCESS ROADS WILL BE PERFORMED PER THE SITE SPECIFIC ACCESS ROAD DETAILS.
7. TEMPORARY ACCESS ROAD CROSSING OF STREAMS AND WETLANDS WILL UTILIZE TIMBERMATS. ANY PERMANENT ROAD CROSSINGS WILL BE CONDUCTED VIA CULVERTS.
8. ALL NON VMRC STREAM CROSSINGS WILL BE PERFORMED AS DESCRIBED IN THE STREAM CROSSING TABLE INCLUDED IN THIS PACKAGE.

NO.	DATE:	DWN.:	CHKD.:	APPD.:	DESCRIPTION:
5	03/04/18	KAL	RE	DW	ADDRESS VADEQ COMMENTS
4	02/27/18	KAL	RE	DW	ADDRESS VADEQ COMMENTS
3	02/05/18	KAL	RE	DW	ADDRESS VADEQ COMMENTS
2	11/21/17	KAL	RE	DW	ADDRESS VADEQ COMMENTS
1	09/21/17	KAL	RE	DW	PLAN SUBMISSION

REVISIONS:

Mountain Valley PIPELINE

EROSION AND SEDIMENT CONTROL PLANS

MOUNTAIN VALLEY PIPELINE PROJECT – H600 LINE

SPREAD 10 – FRANKLIN COUNTY, VIRGINIA

MOUNTAIN VALLEY PIPELINE, LLC
555 SOUTHPOINTE BOULEVARD, SUITE 200
CANONSBURG, PA 15317


TETRA TECH
complex world | CLEAR SOLUTIONS™
661 ANDERSEN DRIVE
FOSTER PLAZA 7
PITTSBURGH, PA 15220

EROSION AND SEDIMENT CONTROL PLANS

COMMONWEALTH OF VIRGINIA
DAVID J. WALLNER
No. 0402057593
PROFESSIONAL ENGINEER

DRAWN BY:	KAL
CHECKED BY:	RE
APPROVED BY:	DW
DATE:	03/04/2018
SCALE:	AS SHOWN
REVISION	5
SHT. NO.	14.52ES OF 14.81ES


TETRA TECH CAD FILE PATH: X:\CADD_Pittsburgh\EQT\7157 – MVP\15 – Franklin\E&S\ES Version 5.0.0\7157ES14.52(S10).dwg PLOTTED ON: 3/2/2018 4:02 PM PLOTTED BY: Zeigler, Justin PLOT FILE: ENVIRONMENTAL_COLOR.ctb

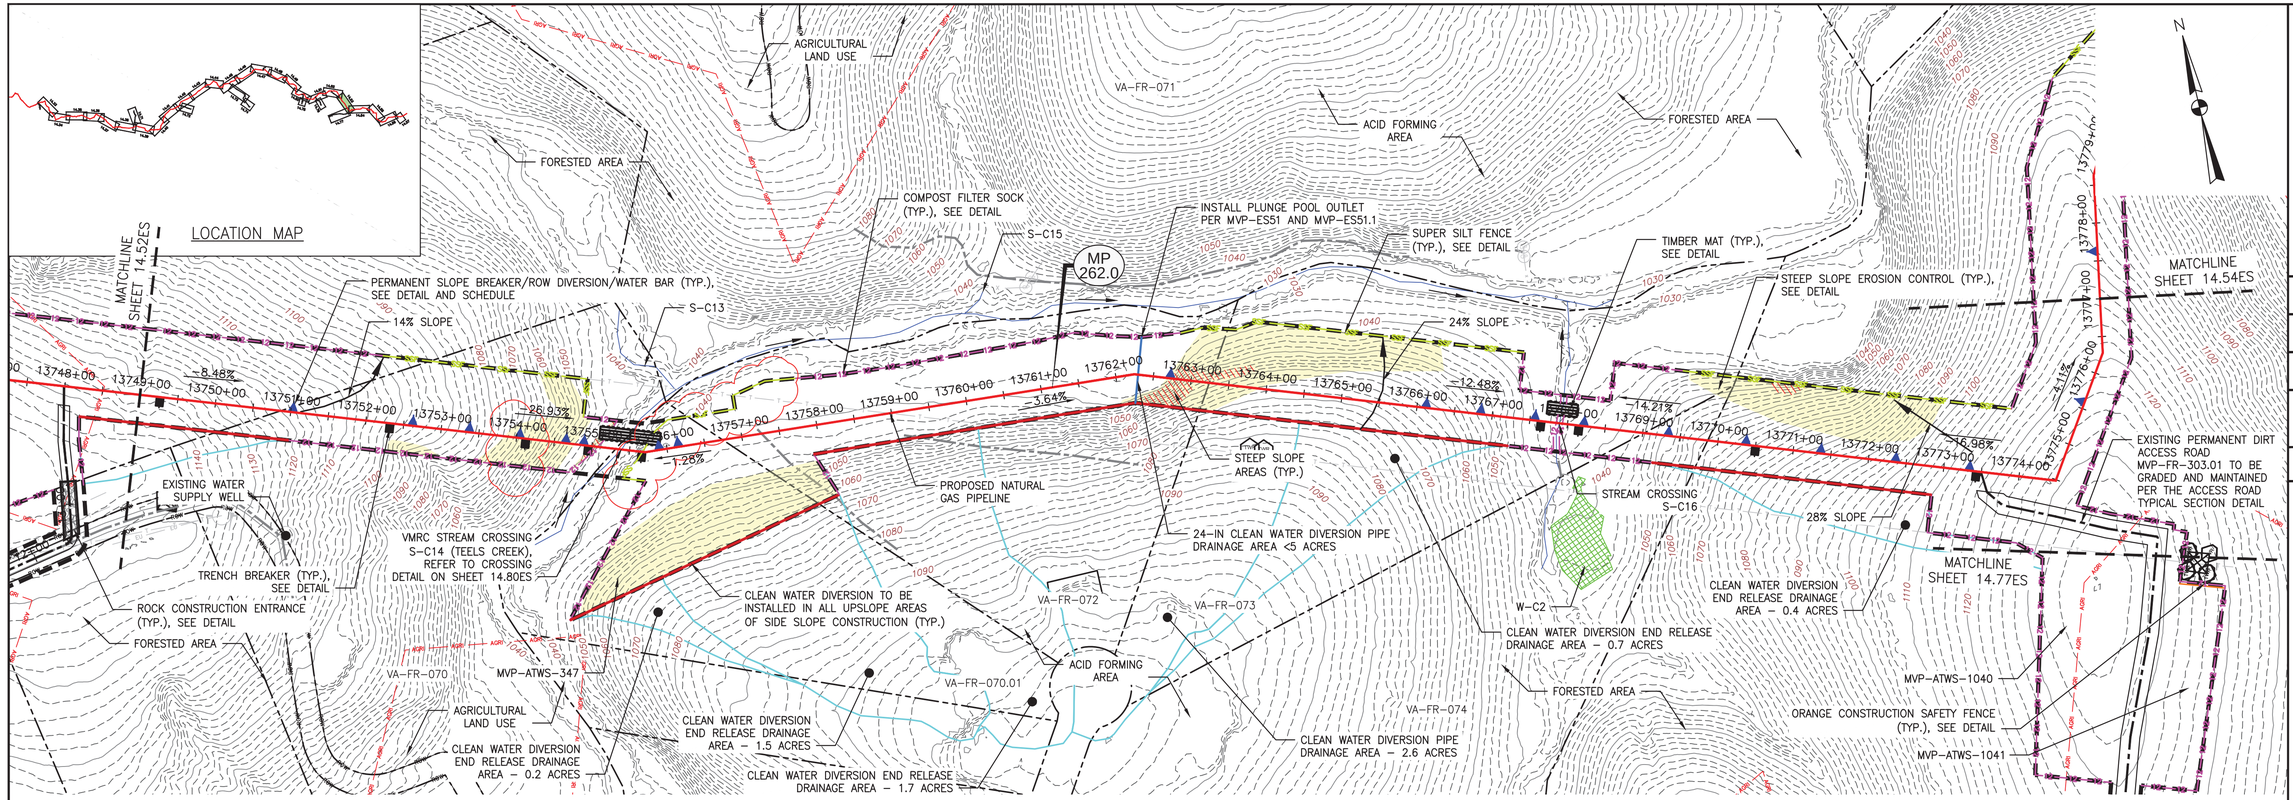

PLAN

SCALE: 1" = 100'

100 0 100 200

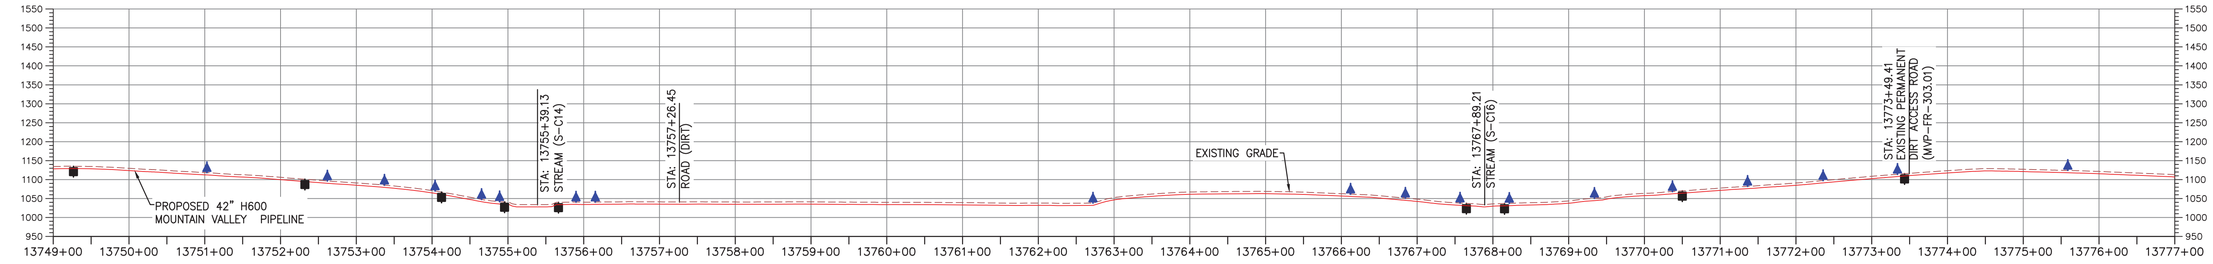

PROFILE

HORIZONTAL SCALE: SCALE: 1" = 100'

100 0 100 200

VERTICAL SCALE: SCALE: 1" = 200'

200 0 200 400

LEGEND

- PROPOSED LIMIT OF DISTURBANCE
- STREAM
- USDA FOREST SERVICE (NATIONAL FOREST) LANDS
- APPALACHIAN NATIONAL SCENIC TRAIL
- EXISTING ROAD/TRAIL
- EXISTING PROPERTY LINE
- EXISTING STATE LINE
- EXISTING COUNTY LINE
- POND
- WETLAND
- ACID FORMING MATERIAL
- AGRICULTURAL LAND USE BOUNDARY
- PROPOSED ACCESS ROAD CENTERLINE
- PROPOSED PIPELINE
- PROPOSED SILT FENCE (SEE NOTE 5)
- PROPOSED SUPER SILT FENCE (SEE DETAIL MVP-ES9.2)
- PROPOSED REINFORCED FILTRATION DEVICE (SEE DETAILS MVP-ES9, 9.1, 9.2, 9.3)
- ORANGE CONSTRUCTION SAFETY FENCE
- PROPOSED COMPOST FILTER SOCK (SEE DETAILS MVP-ES3, 3.1, 3.2)
- PROPOSED COMPOST FILTER SOCK (SEE DETAILS MVP-ES3, 3.1, 3.2)
- PROPOSED COMPOST FILTER SOCK (SEE DETAILS MVP-ES3, 3.1, 3.2)
- GRASS-LINED CHANNEL (SEE DETAIL MVP-ES39)
- CLEAN WATER DIVERSION PIPE
- CLEAN WATER DIVERSION DIKE (SEE DETAIL MVP-ES50 AND MVP-ES51)
- STREAM FLOW DIRECTION
- FEMA 100 YEAR FLOODPLAIN
- DRAINAGE AREA BOUNDARY
- TIMBER MAT (SEE DETAIL MVP-ES37)
- STEEP SLOPE EROSION CONTROL (SEE NOTE 2)
- STEEP SLOPE AREAS (SEE NOTE 4)
- PROPOSED ROCK CONSTRUCTION ENTRANCE
- PROPOSED TRENCH BREAKER (SEE DETAIL MVP-20)
- TEMPORARY ROW DIVERSION/WATER BAR (VADEQ STD & SPEC 3.11)
- PERMANENT SLOPE BREAKER/ROW DIVERSION/WATER BAR (SEE DETAILS MVP-17, ES38, AND SCHEDULE)

NOTES:

1. TOPSOIL SEGREGATION WILL BE PERFORMED IN ALL IMMEDIATE CONSTRUCTION AREAS OF THE PROJECT IN ACCORDANCE WITH DETAILS MVP-ES46.1 THROUGH MVP-ES46.3.
2. FLEXTERRA, EARTHGUARD OR EQUIVALENT MAY BE USED AS A SUBSTITUTE TO EROSION CONTROL BLANKET AS DIRECTED BY MVP.
3. CONTRACTOR IS RESPONSIBLE TO IDENTIFY ALL UTILITIES. THE UTILITY LINES SHOWN ON THE PLAN ARE FOR INFORMATIONAL PURPOSES ONLY AND DO NOT REPRESENT SURVEYED LINE INFORMATION.
4. SLOPES OF 30% OR GREATER EXIST. CONSTRUCTION FOR STEEP SLOPES TO BE PERFORMED USING STEEP SLOPE TECHNIQUES IDENTIFIED IN THE DETAIL SHEETS. ALSO REFER TO THE SITE-SPECIFIC DESIGN OF STABILIZATION MEASURES IN SELECTED HIGH-HAZARD PORTIONS OF THE ROUTE OF THE PROPOSED MOUNTAIN VALLEY PIPELINE PROJECT.
5. WHERE CONSTRUCTION CONDITIONS PRECLUDE THE USE OF DIVERSION DITCHES DUE TO SITE CONDITIONS THE CONTRACTOR WILL INSTALL SILT FENCE AT THE DIRECTION OF MVP.
6. IMPROVEMENTS TO PERMANENT AND TEMPORARY ACCESS ROADS WILL BE PERFORMED PER THE SITE SPECIFIC ACCESS ROAD DETAILS.
7. TEMPORARY ACCESS ROAD CROSSING OF STREAMS AND WETLANDS WILL UTILIZE TIMBERMATS. ANY PERMANENT ROAD CROSSINGS WILL BE CONDUCTED VIA CULVERTS.
8. ALL NON VMRC STREAM CROSSINGS WILL BE PERFORMED AS DESCRIBED IN THE STREAM CROSSING TABLE INCLUDED IN THIS PACKAGE.

NO.	DATE:	DWN.:	CHKD.:	APPD.:	DESCRIPTION:
5	03/04/18	KAL	RE	DW	ADDRESS VADEQ COMMENTS
4	02/27/18	KAL	RE	DW	ADDRESS VADEQ COMMENTS
3	02/05/18	KAL	RE	DW	ADDRESS VADEQ COMMENTS
2	11/21/17	KAL	RE	DW	ADDRESS VADEQ COMMENTS
1	09/21/17	KAL	RE	DW	PLAN SUBMISSION

REVISIONS:

Mountain Valley PIPELINE

EROSION AND SEDIMENT CONTROL PLANS

MOUNTAIN VALLEY PIPELINE PROJECT – H600 LINE

SPREAD 10 – FRANKLIN COUNTY, VIRGINIA

MOUNTAIN VALLEY PIPELINE, LLC
555 SOUTHPOINTE BOULEVARD, SUITE 200
CANONSBURG, PA 15317


TETRA TECH
complex world | CLEAR SOLUTIONS™
661 ANDERSEN DRIVE
FOSTER PLAZA 7
PITTSBURGH, PA 15220

EROSION AND SEDIMENT CONTROL PLANS

COMMONWEALTH OF VIRGINIA
DAVID J. WALLNER
No. 0402057593
PROFESSIONAL ENGINEER

DRAWN BY:	KAL
CHECKED BY:	RE
APPROVED BY:	DW
DATE:	03/04/2018
SCALE:	AS SHOWN
REVISION	5


SHT. NO. 14.53ES OF 14.81ES

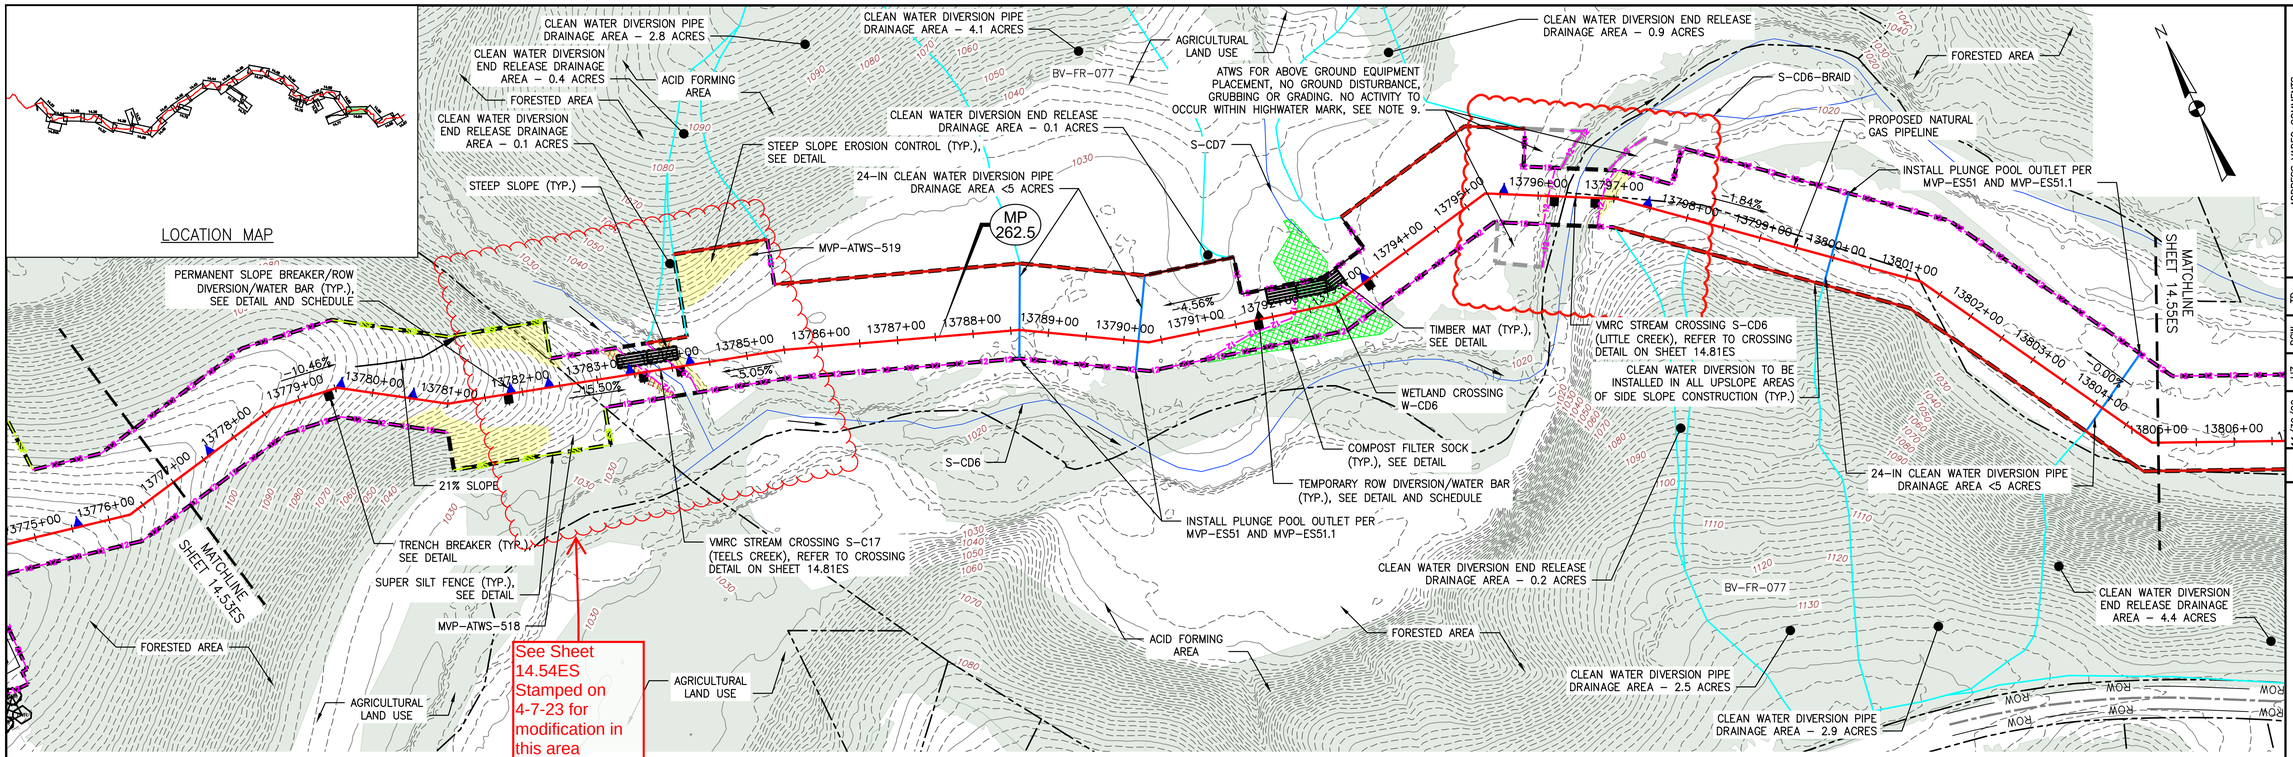

PLAN

SCALE: 1" = 100'

100 0 100 200

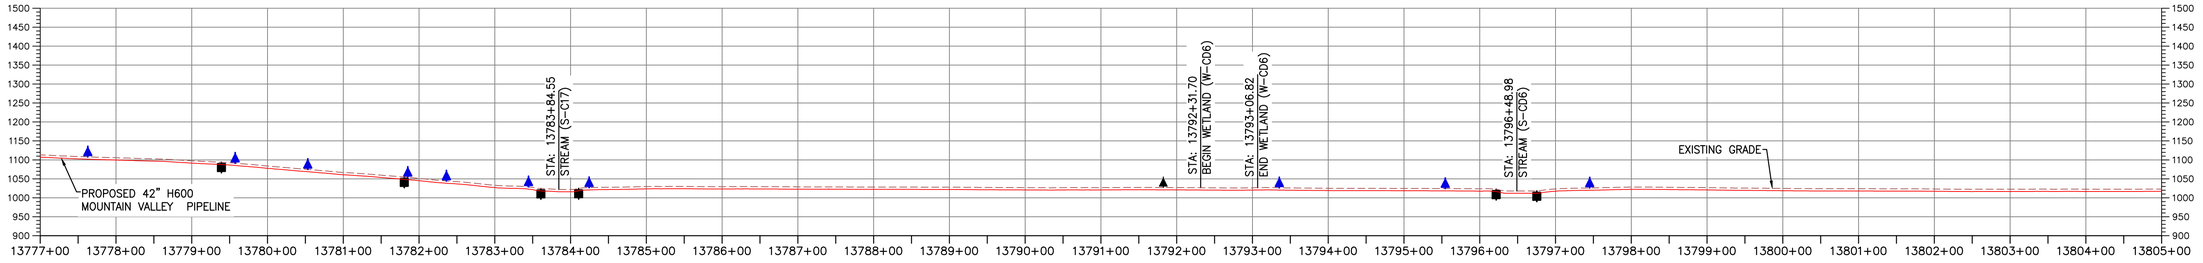

PROFILE

HORIZONTAL SCALE: SCALE: 1" = 100'

100 0 100 200

VERTICAL SCALE: SCALE: 1" = 200'

200 0 200 400

LEGEND

- PROPOSED LIMIT OF DISTURBANCE
- STREAM
- USDA FOREST SERVICE (NATIONAL FOREST) LANDS
- APPALACHIAN NATIONAL SCENIC TRAIL (ANST)
- EXISTING ROAD/TRAIL
- EXISTING PROPERTY LINE
- EXISTING STATE LINE
- EXISTING COUNTY LINE
- POND
- WETLAND
- ACID FORMING MATERIAL (AFM)
- EXISTING FOREST
- PROPOSED LIMIT OF DISTURBANCE
- PROPOSED ACCESS ROAD CENTERLINE
- PROPOSED PIPELINE
- PROPOSED SILT FENCE (SEE NOTE 5) (SF)
- PROPOSED SUPER SILT FENCE (SEE DETAIL MVP-ES9.2) (SSF)
- PROPOSED REINFORCED FILTRATION DEVICE (SEE DETAILS MVP-ES9, 9.1, 9.2, 9.3) (RFD)
- ORANGE CONSTRUCTION SAFETY FENCE (OCSF)
- PROPOSED COMPOST FILTER SOCK (SEE DETAILS MVP-ES3, 3.1, 3.2) (12)
- PROPOSED COMPOST FILTER SOCK (SEE DETAILS MVP-ES3, 3.1, 3.2) (18)
- PROPOSED COMPOST FILTER SOCK (SEE DETAILS MVP-ES3, 3.1, 3.2) (24)
- GRASS-LINED CHANNEL (SEE DETAIL MVP-ES39)
- CLEAN WATER DIVERSION PIPE
- CLEAN WATER DIVERSION DIKE (SEE DETAIL MVP-ES50 AND MVP-ES51)
- STREAM FLOW DIRECTION
- FEMA 100 YEAR FLOODPLAIN
- DRAINAGE AREA BOUNDARY
- TIMBER MAT (SEE DETAIL MVP-ES37)
- STEEP SLOPE EROSION CONTROL (SEE NOTE 2)
- STEEP SLOPE AREAS (SEE NOTE 4)
- PROPOSED ROCK CONSTRUCTION ENTRANCE
- PROPOSED TRENCH BREAKER (SEE DETAIL MVP-20)
- TEMPORARY ROW DIVERSION/WATER BAR (SEE DETAIL MVP-17)
- PERMANENT SLOPE BREAKER/ROW DIVERSION/WATER BAR (SEE DETAIL MVP-17)

COMMONWEALTH OF VIRGINIA
DANIEL C. WITT
Lic. No. 65098
PROFESSIONAL ENGINEER
11/30/22

THIS SEAL APPLIES ONLY TO REVISIONS DATED 11-30-22

NOTES:

1. TOPSOIL SEGREGATION TO BE CONDUCTED THROUGHOUT THE JEFFERSON NATIONAL FOREST.
2. FLEXTERRA, EARTHGUARD OR EQUIVALENT MAY BE USED AS A SUBSTITUTE TO EROSION CONTROL BLANKET AS DIRECTED BY MVP.
3. CONTRACTOR IS RESPONSIBLE TO IDENTIFY ALL UTILITIES. THE UTILITY LINES SHOWN ON THE PLAN ARE FOR INFORMATIONAL PURPOSES ONLY AND DO NOT REPRESENT SURVEYED LINE INFORMATION.
4. SLOPES OF 30" OR GREATER EXIST. CONSTRUCTION FOR STEEP SLOPES TO BE PERFORMED USING STEEP SLOPE TECHNIQUES IDENTIFIED IN THE DETAIL SHEETS. ALSO REFER TO THE SITE-SPECIFIC DESIGN OF STABILIZATION MEASURES IN SELECTED HIGH-HAZARD PORTIONS OF THE ROUTE OF THE PROPOSED MOUNTAIN VALLEY PIPLELINE PROJECT.
5. WHERE CONSTRUCTION CONDITIONS PRECLUDE THE USE OF DIVERSION DITCHES DUE TO SITE CONDITIONS THE CONTRACTOR WILL INSTALL SILT FENCE AT THE DIRECTION OF MVP.
6. DRAINAGE FEATURE CROSSINGS TO BE PERFORMED PER DETAIL MVP-ES49.
7. TEMPORARY ACCESS ROAD CROSSING OF STREAMS AND WETLANDS WILL UTILIZE TIMBERMATS. ANY PERMANENT ROAD CROSSINGS WILL BE CONDUCTED VIA CULVERTS. NO UNPERMITTED IMPACT TO STREAMS WILL OCCUR AS A RESULT OF ROAD OR PIPELINE CROSSINGS AND ALL ESC BMP'S WILL BE INSTALLED TO CONTINUE THE STREAM FLOW.
8. ALL NON VMRC STREAM CROSSINGS WILL BE PERFORMED AS DESCRIBED IN THE STREAM CROSSING TABLE INCLUDED IN THIS PACKAGE AND PER DETAIL MVP-ES49.
9. NO GROUND DISTURBANCE TO OCCUR WITHIN ATWS FOR ABOVE GROUND EQUIPMENT PLACEMENT. THE ACTUAL LOCATION OF THE WATERWARD EDGE OF THE ATWS WILL BE BASED ON FIELD CONDITIONS AND WILL BE LOCATED OUTSIDE THE RESOURCE ABOVE THE ORDINARY HIGH WATER MARKS, HOWEVER, THE CONTROLS WILL NOT BE LOCATED CLOSER TO THE RESOURCE THAN WHAT IS SHOWN ON THESE DESIGNS.

NO.:	DATE:	DWN.:	CHKD.:	APPD.:	DESCRIPTION:
–	11/30/22	JJZ	DCW	TD	ADDRESS VADEQ COMMENTS
–	01/31/22	JJZ	RE	TD	FIELD MODIFICATION – ADDITIONAL WORKSPACES FOR OPEN CUT CROSSINGS
5	03/04/18	KAL	RE	DW	ADDRESS VADEQ COMMENTS
4	02/27/18	KAL	RE	DW	ADDRESS VADEQ COMMENTS
3	02/05/18	KAL	RE	DW	ADDRESS VADEQ COMMENTS
2	11/21/17	KAL	RE	DW	ADDRESS VADEQ COMMENTS

REVISIONS:

Mountain Valley PIPELINE

EROSION AND SEDIMENT CONTROL PLANS

MOUNTAIN VALLEY PIPELINE PROJECT – H600 LINE

SPREAD 10 – FRANKLIN COUNTY, VIRGINIA

MOUNTAIN VALLEY PIPELINE, LLC
2200 ENERGY DRIVE
CANONSBURG, PA 15317

TETRA TECH
complex world | CLEAR SOLUTIONS™
661 ANDERSEN DRIVE
FOSTER PLAZA 7
PITTSBURGH, PA 15220


EROSION AND SEDIMENT CONTROL PLANS

COMMONWEALTH OF VIRGINIA
DAVID J. WALLNER
Lic. No. 57593
PROFESSIONAL ENGINEER
12/1/2022

DRAWN BY:	JJZ
CHECKED BY:	DCW
APPROVED BY:	TD
DATE:	11/30/22
SCALE:	AS SHOWN
	– REVISION

SHT. NO. 14.54ES OF 14.81ES


TETRA TECH CAD FILE PATH: X:\CADD_Pittsburgh\EQT\7157 – MVP\15 – Franklin\E&S\ES Version 5.0.0\7157ES14.54(S10).dwg PLOTTED ON: 12/1/2022 11:32 AM PLOTTED BY: Zeigler, Justin PLOT FILE: ENVIRONMENTAL_COLOR.ctb

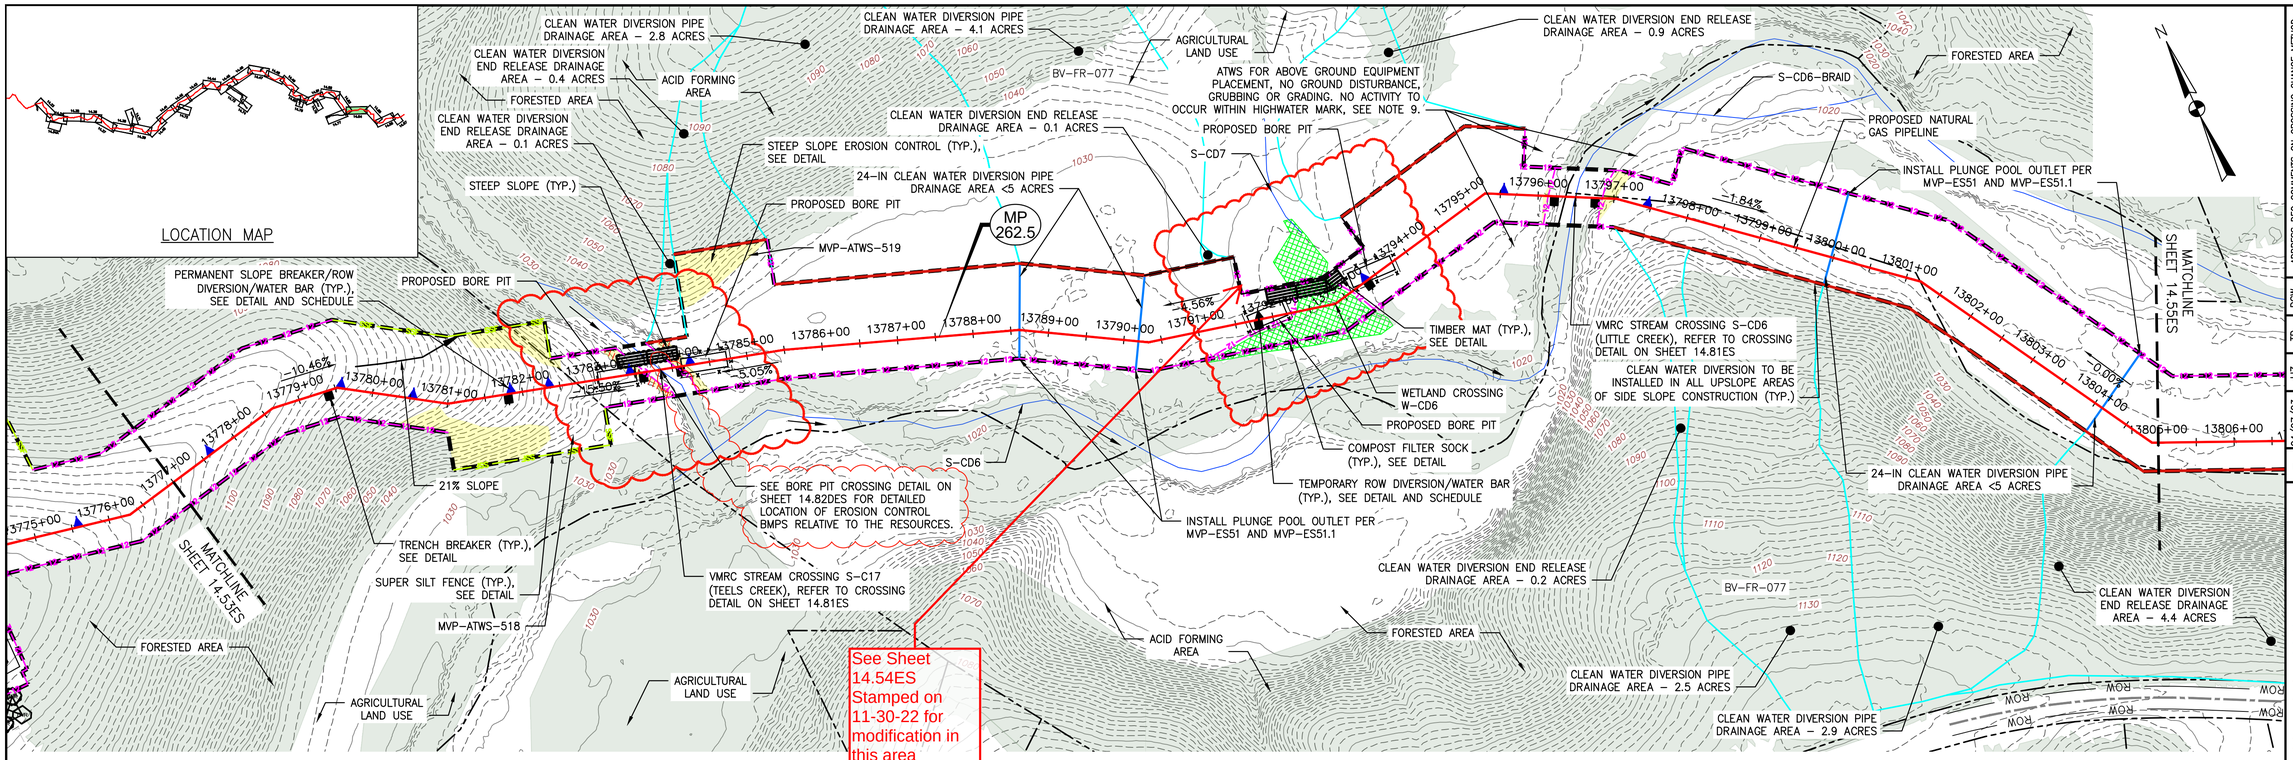

PLAN

SCALE: 1" = 100'

100 0 100 200

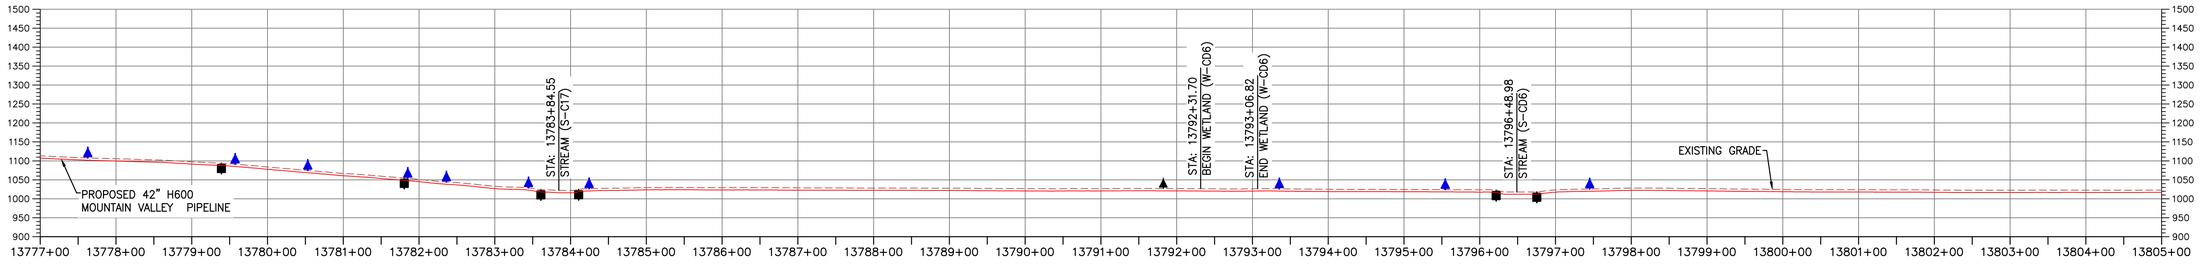

PROFILE

HORIZONTAL SCALE: SCALE: 1" = 100'

100 0 100 200

VERTICAL SCALE: SCALE: 1" = 200'

200 0 200 400

LEGEND

- PROPOSED LIMIT OF DISTURBANCE
- STREAM
- USDA FOREST SERVICE (NATIONAL FOREST) LANDS
- APPALACHIAN NATIONAL SCENIC TRAIL
- EXISTING ROAD/TRAIL
- EXISTING PROPERTY LINE
- EXISTING STATE LINE
- EXISTING COUNTY LINE
- POND
- WETLAND
- ACID FORMING MATERIAL
- EXISTING FOREST
- PROPOSED LIMIT OF DISTURBANCE
- PROPOSED ACCESS ROAD CENTERLINE
- PROPOSED PIPELINE
- PROPOSED SILT FENCE (SEE NOTE 5)
- PROPOSED SUPER SILT FENCE (SEE DETAIL MVP–ES9.2)
- PROPOSED REINFORCED FILTRATION DEVICE (SEE DETAILS MVP–ES9, 9.1, 9.2, 9.3)
- ORANGE CONSTRUCTION SAFETY FENCE
- PROPOSED COMPOST FILTER SOCK (SEE DETAILS MVP–ES3, 3.1, 3.2)
- PROPOSED COMPOST FILTER SOCK (SEE DETAILS MVP–ES3, 3.1, 3.2)
- PROPOSED COMPOST FILTER SOCK (SEE DETAILS MVP–ES3, 3.1, 3.2)
- GRASS–LINED CHANNEL (SEE DETAIL MVP–ES39)
- CLEAN WATER DIVERSION PIPE
- CLEAN WATER DIVERSION DIKE (SEE DETAIL MVP–ES50 AND MVP–ES51)
- STREAM FLOW DIRECTION
- FEMA 100 YEAR FLOODPLAIN
- DRAINAGE AREA BOUNDARY
- TIMBER MAT (SEE DETAIL MVP–ES37)
- STEEP SLOPE EROSION CONTROL (SEE NOTE 2)
- STEEP SLOPE AREAS (SEE NOTE 4)
- PROPOSED ROCK CONSTRUCTION ENTRANCE
- PROPOSED TRENCH BREAKER (SEE DETAIL MVP–20)
- TEMPORARY ROW DIVERSION/WATER BAR (SEE DETAIL MVP–17)
- PERMANENT SLOPE BREAKER/ROW DIVERSION/WATER BAR (SEE DETAIL MVP–17)

COMMONWEALTH OF VIRGINIA
4/7/23
DANIEL C. WITT
Lic. No. 65093
PROFESSIONAL ENGINEER

THIS SEAL APPLIES ONLY TO REVISIONS DATED 04–07–2023

NOTES:

1. TOPSOIL SEGREGATION TO BE CONDUCTED THROUGHOUT THE JEFFERSON NATIONAL FOREST.
2. FLEXTERRA, EARTHGUARD OR EQUIVALENT MAY BE USED AS A SUBSTITUTE TO EROSION CONTROL BLANKET AS DIRECTED BY MVP.
3. CONTRACTOR IS RESPONSIBLE TO IDENTIFY ALL UTILITIES. THE UTILITY LINES SHOWN ON THE PLAN ARE FOR INFORMATIONAL PURPOSES ONLY AND DO NOT REPRESENT SURVEYED LINE INFORMATION.
4. SLOPES OF 30° OR GREATER EXIST. CONSTRUCTION FOR STEEP SLOPES TO BE PERFORMED USING STEEP SLOPE TECHNIQUES IDENTIFIED IN THE DETAIL SHEETS. ALSO REFER TO THE SITE–SPECIFIC DESIGN OF STABILIZATION MEASURES IN SELECTED HIGH–HAZARD PORTIONS OF THE ROUTE OF THE PROPOSED MOUNTAIN VALLEY PIPLELINE PROJECT.
5. WHERE CONSTRUCTION CONDITIONS PRECLUDE THE USE OF DIVERSION DITCHES DUE TO SITE CONDITIONS THE CONTRACTOR WILL INSTALL SILT FENCE AT THE DIRECTION OF MVP.
6. DRAINAGE FEATURE CROSSINGS TO BE PERFORMED PER DETAIL MVP–ES49.
7. TEMPORARY ACCESS ROAD CROSSING OF STREAMS AND WETLANDS WILL UTILIZE TIMBERMATS. ANY PERMANENT ROAD CROSSINGS WILL BE CONDUCTED VIA CULVERTS. NO UNPERMITTED IMPACT TO STREAMS WILL OCCUR AS A RESULT OF ROAD OR PIPELINE CROSSINGS AND ALL ESC BMP'S WILL BE INSTALLED TO CONTINUE THE STREAM FLOW.
8. ALL NON VMRC STREAM CROSSINGS WILL BE PERFORMED AS DESCRIBED IN THE STREAM CROSSING TABLE INCLUDED IN THIS PACKAGE AND PER DETAIL MVP–ES49.
9. ADDITIONAL WORK SPACES FOR ABOVE GROUND EQUIPMENT PLACEMENT WILL NOT BE DISTURBED AND WILL BE SEGREGATED FROM PROJECT DISTURBED AREAS WITH ORANGE CONSTRUCTION FENCE. THE ACTUAL LOCATION OF THE WATERWARD EDGE OF THE PERIMETER CONTROLS WILL BE BASED ON FIELD CONDITIONS AND WILL BE LOCATED OUTSIDE THE RESOURCE ABOVE THE ORDINARY HIGH WATER MARK, HOWEVER, THE CONTROLS WILL NOT BE LOCATED CLOSER TO THE RESOURCE THAN WHAT IS SHOWN ON THESE DRAWINGS.

NO.	DATE:	DESCRIPTION:
–	04/07/23	ADDRESS DEQ COMMENTS ON CROSSING CHANGE METHOD
–	05/12/21	CROSSING METHOD CHANGE FROM OPEN CUT TO BORE
5	03/04/18	ADDRESS VADEQ COMMENTS
4	02/27/18	ADDRESS VADEQ COMMENTS
3	02/05/18	ADDRESS VADEQ COMMENTS

REVISIONS:

DWN.:	CHKD.:	APPD.:
JJZ	TD	DCW
JJZ	RE	DW
KAL	RE	DW
KAL	RE	DW
KAL	RE	DW

Mountain Valley PIPELINE

EROSION AND SEDIMENT CONTROL PLANS

MOUNTAIN VALLEY PIPELINE PROJECT – H600 LINE

SPREAD 10 – FRANKLIN COUNTY, VIRGINIA

MOUNTAIN VALLEY PIPELINE, LLC
2200 ENERGY DRIVE
CANONSBURG, PA 15317


TETRA TECH
complex world | CLEAR SOLUTIONS™
661 ANDERSEN DRIVE
FOSTER PLAZA 7
PITTSBURGH, PA 15220

EROSION AND SEDIMENT CONTROL PLANS

COMMONWEALTH OF VIRGINIA
DAVID J. WALLNER
Lic. No. 57593
5/12/2021
PROFESSIONAL ENGINEER

DRAWN BY:	JJZ
CHECKED BY:	DCW
APPROVED BY:	TD
DATE:	04/07/23
SCALE:	AS SHOWN
– REVISION	
SHT. NO.	14.54ES OF 14.81ES


TETRA TECH CAD FILE PATH: X:\CADD_Pittsburgh\EQT\7157 – MVP\15 – Franklin\E&S\ES Version 5.0.0\7157ES14.54(S10) BORE REV 23–02–01.dwg PLOTTED ON: 3/31/2023 3:53 PM PLOTTED BY: Zeigler, Justin PLOT FILE: ENVIRONMENTAL_COLOR.ctb

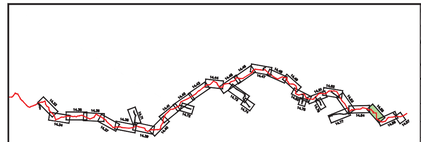

LOCATION MAP

PLAN

SCALE: 1" = 100'

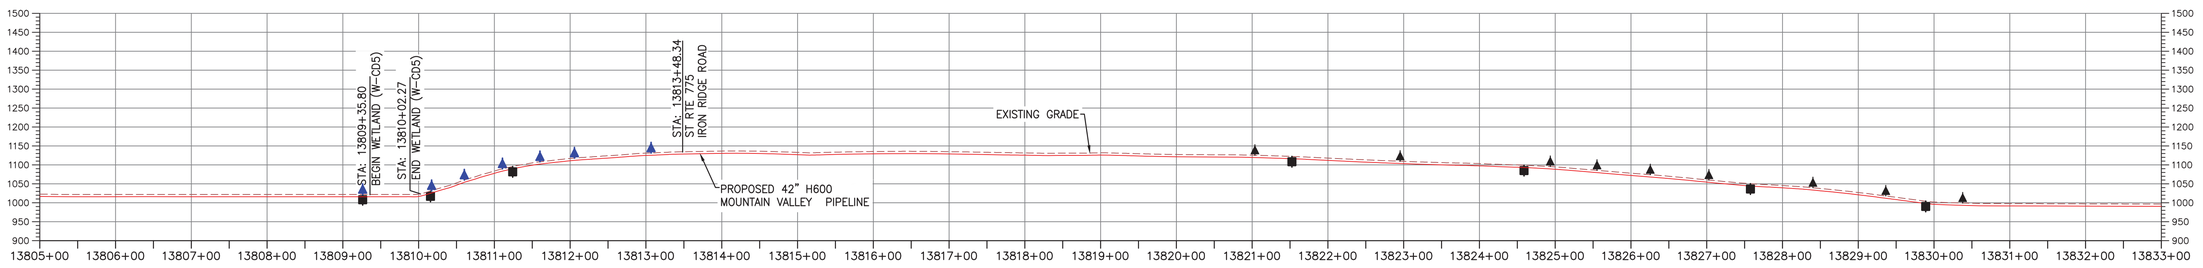

PROFILE

HORIZONTAL SCALE: SCALE: 1" = 100'

VERTICAL SCALE: SCALE: 1" = 200'

LEGEND

- PROPOSED LIMIT OF DISTURBANCE
- STREAM
- USDA FOREST SERVICE (NATIONAL FOREST) LANDS
- APPALACHIAN NATIONAL SCENIC TRAIL
- EXISTING ROAD/TRAIL
- EXISTING PROPERTY LINE
- EXISTING STATE LINE
- EXISTING COUNTY LINE
- POND
- WETLAND
- ACID FORMING MATERIAL
- AGRICULTURAL LAND USE BOUNDARY
- PROPOSED ACCESS ROAD CENTERLINE
- PROPOSED PIPELINE
- PROPOSED SILT FENCE (SEE NOTE 5)
- PROPOSED SUPER SILT FENCE (SEE DETAIL MVP–ES9.2)
- PROPOSED REINFORCED FILTRATION DEVICE (SEE DETAILS MVP–ES9, 9.1, 9.2, 9.3)
- ORANGE CONSTRUCTION SAFETY FENCE
- PROPOSED COMPOST FILTER SOCK (SEE DETAILS MVP–ES3, 3.1, 3.2)
- PROPOSED COMPOST FILTER SOCK (SEE DETAILS MVP–ES3, 3.1, 3.2)
- PROPOSED COMPOST FILTER SOCK (SEE DETAILS MVP–ES3, 3.1, 3.2)
- GRASS–LINED CHANNEL (SEE DETAIL MVP–ES39)
- CLEAN WATER DIVERSION PIPE
- CLEAN WATER DIVERSION DIKE (SEE DETAIL MVP–ES50 AND MVP–ES51)
- STREAM FLOW DIRECTION
- FEMA 100 YEAR FLOODPLAIN
- DRAINAGE AREA BOUNDARY
- TIMBER MAT (SEE DETAIL MVP–ES37)
- STEEP SLOPE EROSION CONTROL (SEE NOTE 2)
- STEEP SLOPE AREAS (SEE NOTE 4)
- PROPOSED ROCK CONSTRUCTION ENTRANCE
- PROPOSED TRENCH BREAKER (SEE DETAIL MVP–20)
- TEMPORARY ROW DIVERSION/WATER BAR (VADEQ STD & SPEC 3.11)
- PERMANENT SLOPE BREAKER/ROW DIVERSION/WATER BAR (SEE DETAILS MVP–17, ES38, AND SCHEDULE)

NOTES:

1. TOPSOIL SEGREGATION WILL BE PERFORMED IN ALL IMMEDIATE CONSTRUCTION AREAS OF THE PROJECT IN ACCORDANCE WITH DETAILS MVP–ES46.1 THROUGH MVP–ES46.3.
2. FLEXTERRA, EARTHGUARD OR EQUIVALENT MAY BE USED AS A SUBSTITUTE TO EROSION CONTROL BLANKET AS DIRECTED BY MVP.
3. CONTRACTOR IS RESPONSIBLE TO IDENTIFY ALL UTILITIES. THE UTILITY LINES SHOWN ON THE PLAN ARE FOR INFORMATIONAL PURPOSES ONLY AND DO NOT REPRESENT SURVEYED LINE INFORMATION.
4. SLOPES OF 30' OR GREATER EXIST. CONSTRUCTION FOR STEEP SLOPES TO BE PERFORMED USING STEEP SLOPE TECHNIQUES IDENTIFIED IN THE DETAIL SHEETS. ALSO REFER TO THE SITE–SPECIFIC DESIGN OF STABILIZATION MEASURES IN SELECTED HIGH–HAZARD PORTIONS OF THE ROUTE OF THE PROPOSED MOUNTAIN VALLEY PIPELINE PROJECT.
5. WHERE CONSTRUCTION CONDITIONS PRECLUDE THE USE OF DIVERSION DITCHES DUE TO SITE CONDITIONS THE CONTRACTOR WILL INSTALL SILT FENCE AT THE DIRECTION OF MVP.
6. IMPROVEMENTS TO PERMANENT AND TEMPORARY ACCESS ROADS WILL BE PERFORMED PER THE SITE SPECIFIC ACCESS ROAD DETAILS.
7. TEMPORARY ACCESS ROAD CROSSING OF STREAMS AND WETLANDS WILL UTILIZE TIMBERMATS. ANY PERMANENT ROAD CROSSINGS WILL BE CONDUCTED VIA CULVERTS.
8. ALL NON VMRC STREAM CROSSINGS WILL BE PERFORMED AS DESCRIBED IN THE STREAM CROSSING TABLE INCLUDED IN THIS PACKAGE.

NO.	DATE:	DWN.:	CHKD.:	APPD.:	DESCRIPTION:
5	03/04/18	KAL	RE	DW	ADDRESS VADEQ COMMENTS
4	02/27/18	KAL	RE	DW	ADDRESS VADEQ COMMENTS
3	02/05/18	KAL	RE	DW	ADDRESS VADEQ COMMENTS
2	11/21/17	KAL	RE	DW	ADDRESS VADEQ COMMENTS
1	09/21/17	KAL	RE	DW	PLAN SUBMISSION

REVISIONS:

Mountain Valley PIPELINE

EROSION AND SEDIMENT CONTROL PLANS

MOUNTAIN VALLEY PIPELINE PROJECT – H600 LINE

SPREAD 10 – FRANKLIN COUNTY, VIRGINIA

MOUNTAIN VALLEY PIPELINE, LLC
555 SOUTHPOINTE BOULEVARD, SUITE 200
CANONSBURG, PA 15317


TETRA TECH
complex world | CLEAR SOLUTIONS™
661 ANDERSEN DRIVE
FOSTER PLAZA 7
PITTSBURGH, PA 15220

EROSION AND SEDIMENT CONTROL PLANS

COMMONWEALTH OF PENNSYLVANIA
DAVID J. WALLNER
Lic. No. 0402057593
PROFESSIONAL ENGINEER

DRAWN BY:	KAL
CHECKED BY:	RE
APPROVED BY:	DW
DATE:	03/04/2018
SCALE:	AS SHOWN
REVISION	5
SHT. NO.	14.55ES OF 14.81ES


TETRA TECH CAD FILE PATH: X:\CADD_Pittsburgh\EQT\7157 – MVP\15 – Franklin\E&S\ES Version 5.0.0\7157ES14.55(S10).dwg PLOTTED ON: 3/2/2018 4:16 PM PLOTTED BY: Zeigler, Justin PLOT FILE: ENVIRONMENTAL_COLOR.ctb

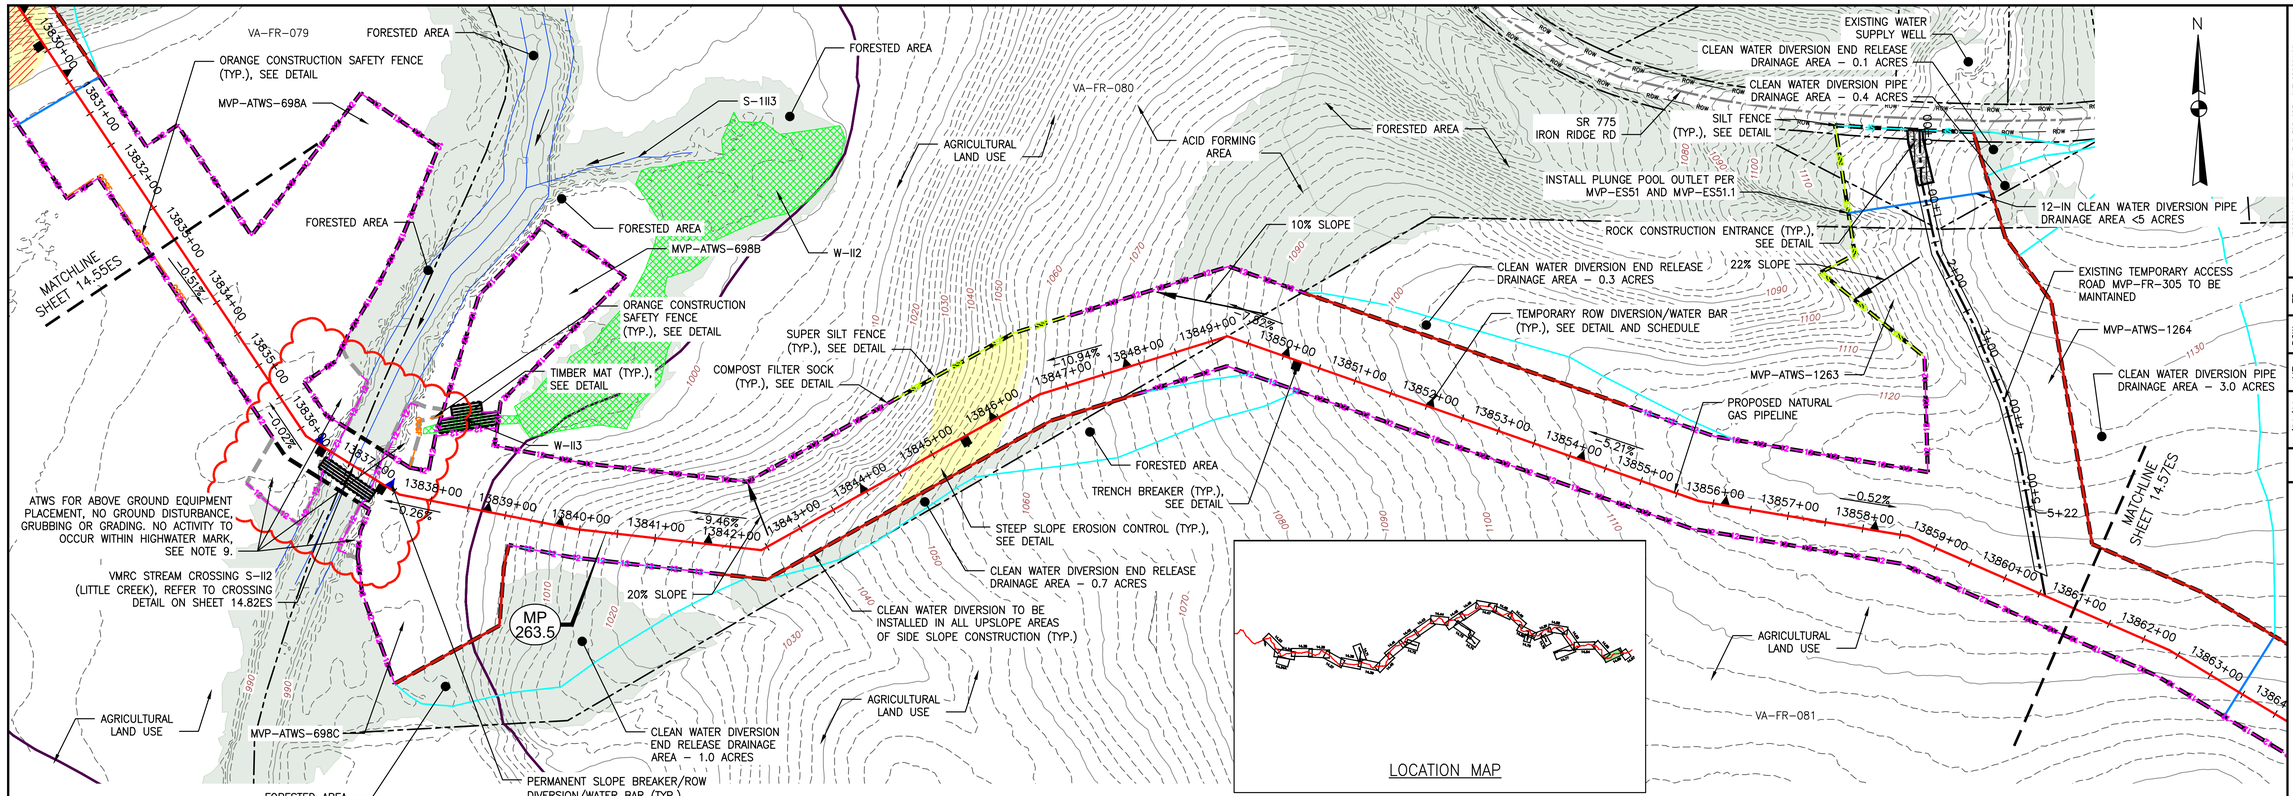

PLAN

SCALE: 1" = 100'

100 0 100 200

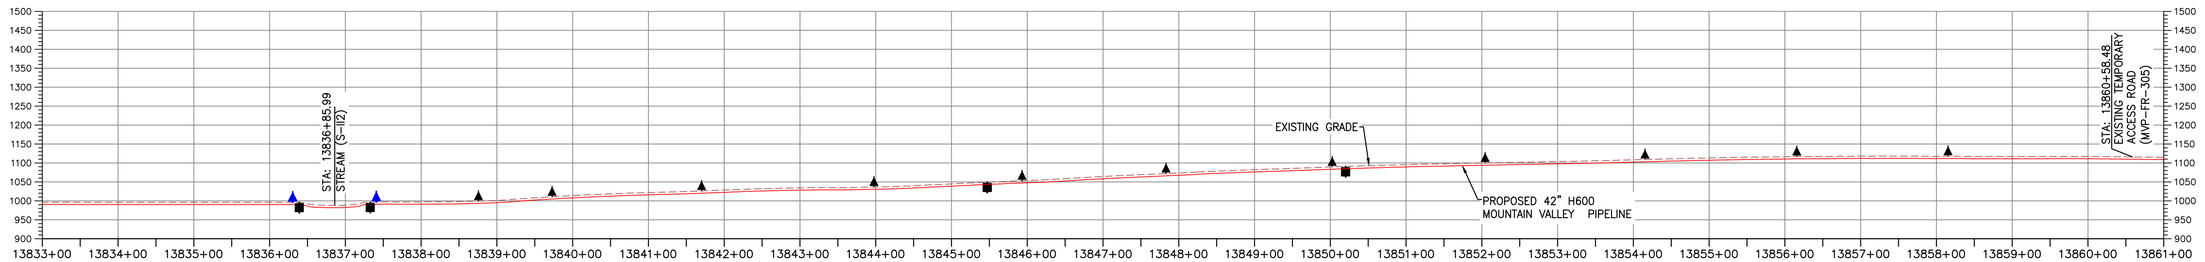

PROFILE

HORIZONTAL SCALE: SCALE: 1" = 100'

100 0 100 200

VERTICAL SCALE: SCALE: 1" = 200'

200 0 200 400

LEGEND

- PROPOSED LIMIT OF DISTURBANCE
- STREAM
- USDA FOREST SERVICE (NATIONAL FOREST) LANDS
- APPALACHIAN NATIONAL SCENIC TRAIL
- EXISTING ROAD/TRAIL
- EXISTING PROPERTY LINE
- EXISTING STATE LINE
- EXISTING COUNTY LINE
- POND
- WETLAND
- ACID FORMING MATERIAL
- EXISTING FOREST
- AREA WITHIN PROJECT LIMITS NOT TO BE DISTURBED
- PROPOSED ACCESS ROAD CENTERLINE
- PROPOSED PIPELINE
- PROPOSED SILT FENCE (SEE NOTE 5)
- PROPOSED SUPER SILT FENCE (SEE DETAIL MVP-ES9.2)
- PROPOSED REINFORCED FILTRATION DEVICE (SEE DETAILS MVP-ES9, 9.1, 9.2, 9.3)
- ORANGE CONSTRUCTION SAFETY FENCE
- PROPOSED COMPOST FILTER SOCK (SEE DETAILS MVP-ES3, 3.1, 3.2)
- PROPOSED COMPOST FILTER SOCK (SEE DETAILS MVP-ES3, 3.1, 3.2)
- PROPOSED COMPOST FILTER SOCK (SEE DETAILS MVP-ES3, 3.1, 3.2)
- GRASS-LINED CHANNEL (SEE DETAIL MVP-ES39)
- CLEAN WATER DIVERSION PIPE
- CLEAN WATER DIVERSION DIKE (SEE DETAIL MVP-ES50 AND MVP-ES51)
- STREAM FLOW DIRECTION
- FEMA 100 YEAR FLOODPLAIN
- DRAINAGE AREA BOUNDARY
- TIMBER MAT (SEE DETAIL MVP-ES37)
- STEEP SLOPE EROSION CONTROL (SEE NOTE 2)
- STEEP SLOPE AREAS (SEE NOTE 4)
- PROPOSED ROCK CONSTRUCTION ENTRANCE
- PROPOSED TRENCH BREAKER (SEE DETAIL MVP-20)
- TEMPORARY ROW DIVERSION/WATER BAR (SEE DETAIL MVP-17)
- PERMANENT SLOPE BREAKER/ROW DIVERSION/WATER BAR (SEE DETAIL MVP-17)

COMMONWEALTH OF VIRGINIA
DANIEL C. WITT
Lic. No. 65096
11/30/22
PROFESSIONAL ENGINEER

THIS SEAL APPLIES ONLY TO REVISIONS DATED 11-30-22

NOTES:

1. TOPSOIL SEGREGATION WILL BE PERFORMED IN ALL IMMEDIATE CONSTRUCTION AREAS OF THE PROJECT IN ACCORDANCE WITH DETAILS MVP-ES46.1 THROUGH MVP-ES46.3.
2. FLEXTERRA, EARTHGUARD OR EQUIVALENT MAY BE USED AS A SUBSTITUTE TO EROSION CONTROL BLANKET AS DIRECTED BY MVP.
3. CONTRACTOR IS RESPONSIBLE TO IDENTIFY ALL UTILITIES. THE UTILITY LINES SHOWN ON THE PLAN ARE FOR INFORMATIONAL PURPOSES ONLY AND DO NOT REPRESENT SURVEYED LINE INFORMATION.
4. SLOPES OF 30' OR GREATER EXIST. CONSTRUCTION FOR STEEP SLOPES TO BE PERFORMED USING STEEP SLOPE TECHNIQUES IDENTIFIED IN THE DETAIL SHEETS. ALSO REFER TO THE SITE-SPECIFIC DESIGN OF STABILIZATION MEASURES IN SELECTED HIGH-HAZARD PORTIONS OF THE ROUTE OF THE PROPOSED MOUNTAIN VALLEY PIPLELINE PROJECT.
5. WHERE CONSTRUCTION CONDITIONS PRECLUDE THE USE OF DIVERSION DITCHES DUE TO SITE CONDITIONS THE CONTRACTOR WILL INSTALL SILT FENCE AT THE DIRECTION OF MVP.
6. IMPROVEMENTS TO PERMANENT AND TEMPORARY ACCESS ROADS WILL BE PERFORMED PER THE SITE SPECIFIC ACCESS ROAD DETAILS.
7. TEMPORARY ACCESS ROAD CROSSING OF STREAMS AND WETLANDS WILL UTILIZE TIMBERMATS. ANY PERMANENT ROAD CROSSINGS WILL BE CONDUCTED VIA CULVERTS.
8. ALL NON VMRC STREAM CROSSINGS WILL BE PERFORMED AS DESCRIBED IN THE STREAM CROSSING TABLE INCLUDED IN THIS PACKAGE.
9. NO GROUND DISTURBANCE TO OCCUR WITHIN ATWS FOR ABOVE GROUND EQUIPMENT PLACEMENT. THE ACTUAL LOCATION OF THE WATERWARD EDGE OF THE ATWS WILL BE BASED ON FIELD CONDITIONS AND WILL BE LOCATED OUTSIDE THE RESOURCE ABOVE THE ORDINARY HIGH WATER MARKS, HOWEVER, THE CONTROLS WILL NOT BE LOCATED CLOSER TO THE RESOURCE THAN WHAT IS SHOWN ON THESE DRAWINGS.

NO.	DATE:	DWN.:	CHKD.:	APPD.:	DESCRIPTION:
–	11/30/22	JJZ	DCW	TD	ADDED COMMENTS ON ATWS FOR OPEN CUT CROSSINGS
–	01/31/22	JJZ	RE	TD	FIELD MODIFICATION - ADDITIONAL WORKSPACES FOR OPEN CUT CROSSINGS
5	03/04/18	KAL	RE	DW	ADDRESS VADEQ COMMENTS
4	02/27/18	KAL	RE	DW	ADDRESS VADEQ COMMENTS
3	02/05/18	KAL	RE	DW	ADDRESS VADEQ COMMENTS
2	11/21/17	KAL	RE	DW	ADDRESS VADEQ COMMENTS

REVISIONS:

Mountain Valley PIPELINE

EROSION AND SEDIMENT CONTROL PLANS
MOUNTAIN VALLEY PIPELINE PROJECT - H600 LINE
SPREAD 10 - FRANKLIN COUNTY, VIRGINIA

MOUNTAIN VALLEY PIPELINE, LLC
2200 ENERGY DRIVE
CANONSBURG, PA 15317

TETRA TECH
complex world | CLEAR SOLUTIONS™
661 ANDERSEN DRIVE
FOSTER PLAZA 7
PITTSBURGH, PA 15220

EROSION AND SEDIMENT CONTROL PLANS

COMMONWEALTH OF VIRGINIA
DAVID J. WALLNER
Lic. No. 57593
12/12/2022
PROFESSIONAL ENGINEER


DRAWN BY:	JJZ
CHECKED BY:	RE
APPROVED BY:	TD
DATE:	11/30/22
SCALE:	AS SHOWN
REVISION	–

SHT. NO. 14.56ES OF 14.81ES

TETRA TECH CAD FILE PATH: X:\CADD_Pittsburgh\EQT\7157 - MVP\15 - Franklin\E&S\ES Version 5.0.0\7157ES14.56(S10).dwg PLOTTED ON: 12/1/2022 8:48 AM PLOTTED BY: Zeigler, Justin PLOT FILE: ENVIRONMENTAL_COLOR.ctb




LOCATION MAP

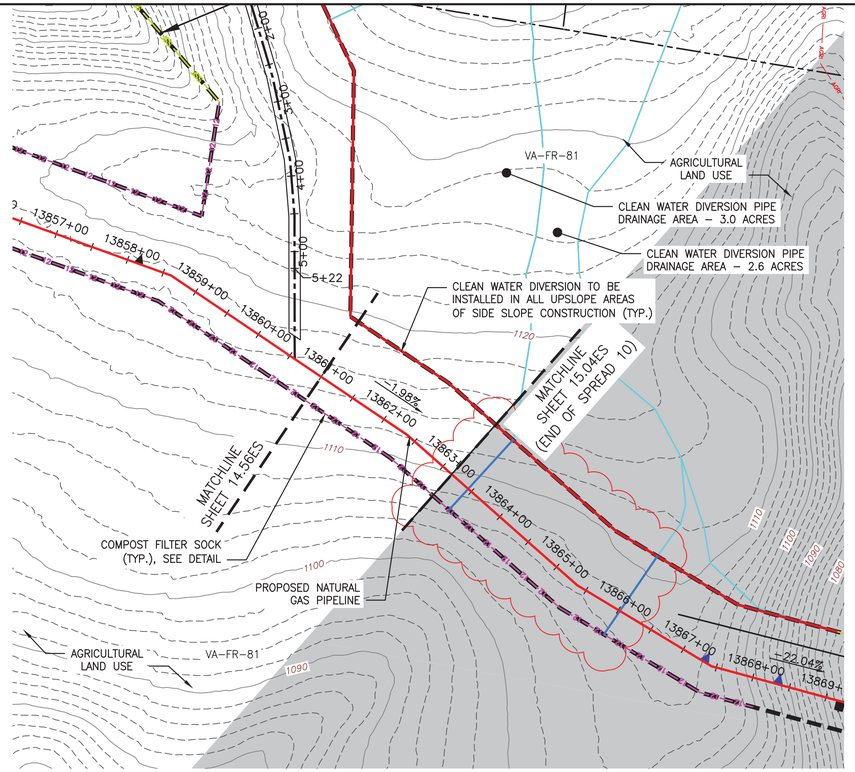

PLAN

SCALE: 1" = 100'

100 0 100 200

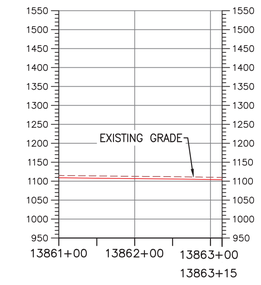

PROFILE

HORIZONTAL SCALE: SCALE: 1" = 100'

100 0 100 200

VERTICAL SCALE: SCALE: 1" = 200'

200 0 200 400

LEGEND

- PROPOSED LIMIT OF DISTURBANCE
- STREAM
- USDA FOREST SERVICE (NATIONAL FOREST) LANDS
- ANST — ANST — APPALACHIAN NATIONAL SCENIC TRAIL
- EXISTING ROAD/TRAIL
- EXISTING PROPERTY LINE
- EXISTING STATE LINE
- EXISTING COUNTY LINE
- POND
- WETLAND
- AFM — AFM — ACID FORMING MATERIAL
- AGRI — AGRI — AGRICULTURAL LAND USE BOUNDARY
- PROPOSED ACCESS ROAD CENTERLINE
- PROPOSED PIPELINE
- SF — SF — PROPOSED SILT FENCE (SEE NOTE 5)
- SSF — SSF — PROPOSED SUPER SILT FENCE (SEE DETAIL MVP–ES9.2)
- RFD — RFD — PROPOSED REINFORCED FILTRATION DEVICE (SEE DETAILS MVP–ES9, 9.1, 9.2, 9.3)
- OCSF — ORANGE CONSTRUCTION SAFETY FENCE
- 12 — 12 — 12 — 12 — PROPOSED COMPOST FILTER SOCK (SEE DETAILS MVP–ES3, 3.1, 3.2)
- 18 — 18 — 18 — 18 — PROPOSED COMPOST FILTER SOCK (SEE DETAILS MVP–ES3, 3.1, 3.2)
- 24 — 24 — 24 — 24 — PROPOSED COMPOST FILTER SOCK (SEE DETAILS MVP–ES3, 3.1, 3.2)
- GRASS–LINED CHANNEL (SEE DETAIL MVP–ES39)
- CLEAN WATER DIVERSION PIPE
- CLEAN WATER DIVERSION DIKE (SEE DETAIL MVP–ES50 AND MVP–ES51)
- STREAM FLOW DIRECTION
- FEMA 100 YEAR FLOODPLAIN
- DRAINAGE AREA BOUNDARY
- TIMBER MAT (SEE DETAIL MVP–ES37)
- STEEP SLOPE EROSION CONTROL (SEE NOTE 2)
- STEEP SLOPE AREAS (SEE NOTE 4)
- PROPOSED ROCK CONSTRUCTION ENTRANCE
- PROPOSED TRENCH BREAKER (SEE DETAIL MVP–20)
- TEMPORARY ROW DIVERSION/WATER BAR (VADEQ STD & SPEC 3.11)
- PERMANENT SLOPE BREAKER/ROW DIVERSION/WATER BAR (SEE DETAILS MVP–17, ES38, AND SCHEDULE)

NOTES:

1. TOPSOIL SEGREGATION WILL BE PERFORMED IN ALL IMMEDIATE CONSTRUCTION AREAS OF THE PROJECT IN ACCORDANCE WITH DETAILS MVP–ES46.1 THROUGH MVP–ES46.3.
2. FLEXTERRA, EARTHGUARD OR EQUIVALENT MAY BE USED AS A SUBSTITUTE TO EROSION CONTROL BLANKET AS DIRECTED BY MVP.
3. CONTRACTOR IS RESPONSIBLE TO IDENTIFY ALL UTILITIES. THE UTILITY LINES SHOWN ON THE PLAN ARE FOR INFORMATIONAL PURPOSES ONLY AND DO NOT REPRESENT SURVEYED LINE INFORMATION.
4. SLOPES OF 30° OR GREATER EXIST. CONSTRUCTION FOR STEEP SLOPES TO BE PERFORMED USING STEEP SLOPE TECHNIQUES IDENTIFIED IN THE DETAIL SHEETS. ALSO REFER TO THE SITE–SPECIFIC DESIGN OF STABILIZATION MEASURES IN SELECTED HIGH–HAZARD PORTIONS OF THE ROUTE OF THE PROPOSED MOUNTAIN VALLEY PIPELINE PROJECT.
5. WHERE CONSTRUCTION CONDITIONS PRECLUDE THE USE OF DIVERSION DITCHES DUE TO SITE CONDITIONS THE CONTRACTOR WILL INSTALL SILT FENCE AT THE DIRECTION OF MVP.
6. IMPROVEMENTS TO PERMANENT AND TEMPORARY ACCESS ROADS WILL BE PERFORMED PER THE SITE SPECIFIC ACCESS ROAD DETAILS.
7. TEMPORARY ACCESS ROAD CROSSING OF STREAMS AND WETLANDS WILL UTILIZE TIMBERMATS. ANY PERMANENT ROAD CROSSINGS WILL BE CONDUCTED VIA CULVERTS.
8. ALL NON VMRC STREAM CROSSINGS WILL BE PERFORMED AS DESCRIBED IN THE STREAM CROSSING TABLE INCLUDED IN THIS PACKAGE.

N

NO.	DATE:	DWN.:	CHKD.:	APPD.:	DESCRIPTION:
5	03/04/18	KAL	RE	DW	ADDRESS VADEQ COMMENTS
4	02/27/18	KAL	RE	DW	ADDRESS VADEQ COMMENTS
3	02/05/18	KAL	RE	DW	ADDRESS VADEQ COMMENTS
2	11/21/17	KAL	RE	DW	ADDRESS VADEQ COMMENTS
1	09/21/17	KAL	RE	DW	PLAN SUBMISSION

REVISIONS:

Mountain Valley PIPELINE

EROSION AND SEDIMENT CONTROL PLANS

MOUNTAIN VALLEY PIPELINE PROJECT – H600 LINE

SPREAD 10 – FRANKLIN COUNTY, VIRGINIA

MOUNTAIN VALLEY PIPELINE, LLC
555 SOUTHPOINTE BOULEVARD, SUITE 200
CANONSBURG, PA 15317


TETRA TECH
complex world | CLEAR SOLUTIONS™
661 ANDERSEN DRIVE
FOSTER PLAZA 7
PITTSBURGH, PA 15220

EROSION AND SEDIMENT CONTROL PLANS

COMMONWEALTH OF VIRGINIA
DAVID J. WALLNER
Lic. No. 0402057593
PROFESSIONAL ENGINEER

DRAWN BY:	KAL
CHECKED BY:	RE
APPROVED BY:	DW
DATE:	03/04/2018
SCALE:	AS SHOWN
REVISION	5
SHT. NO.	14.57ES OF 14.81ES

TETRA TECH CAD FILE PATH: X:\CADD_Pittsburgh\EQT\7157 – MVP\15 – Franklin\E&S\ES Version 5.0.0\7157ES14.57(S10).dwg PLOTTED ON: 3/2/2018 4:26 PM PLOTTED BY: Zeigler, Justin PLOT FILE: ENVIRONMENTAL_COLOR.ctb

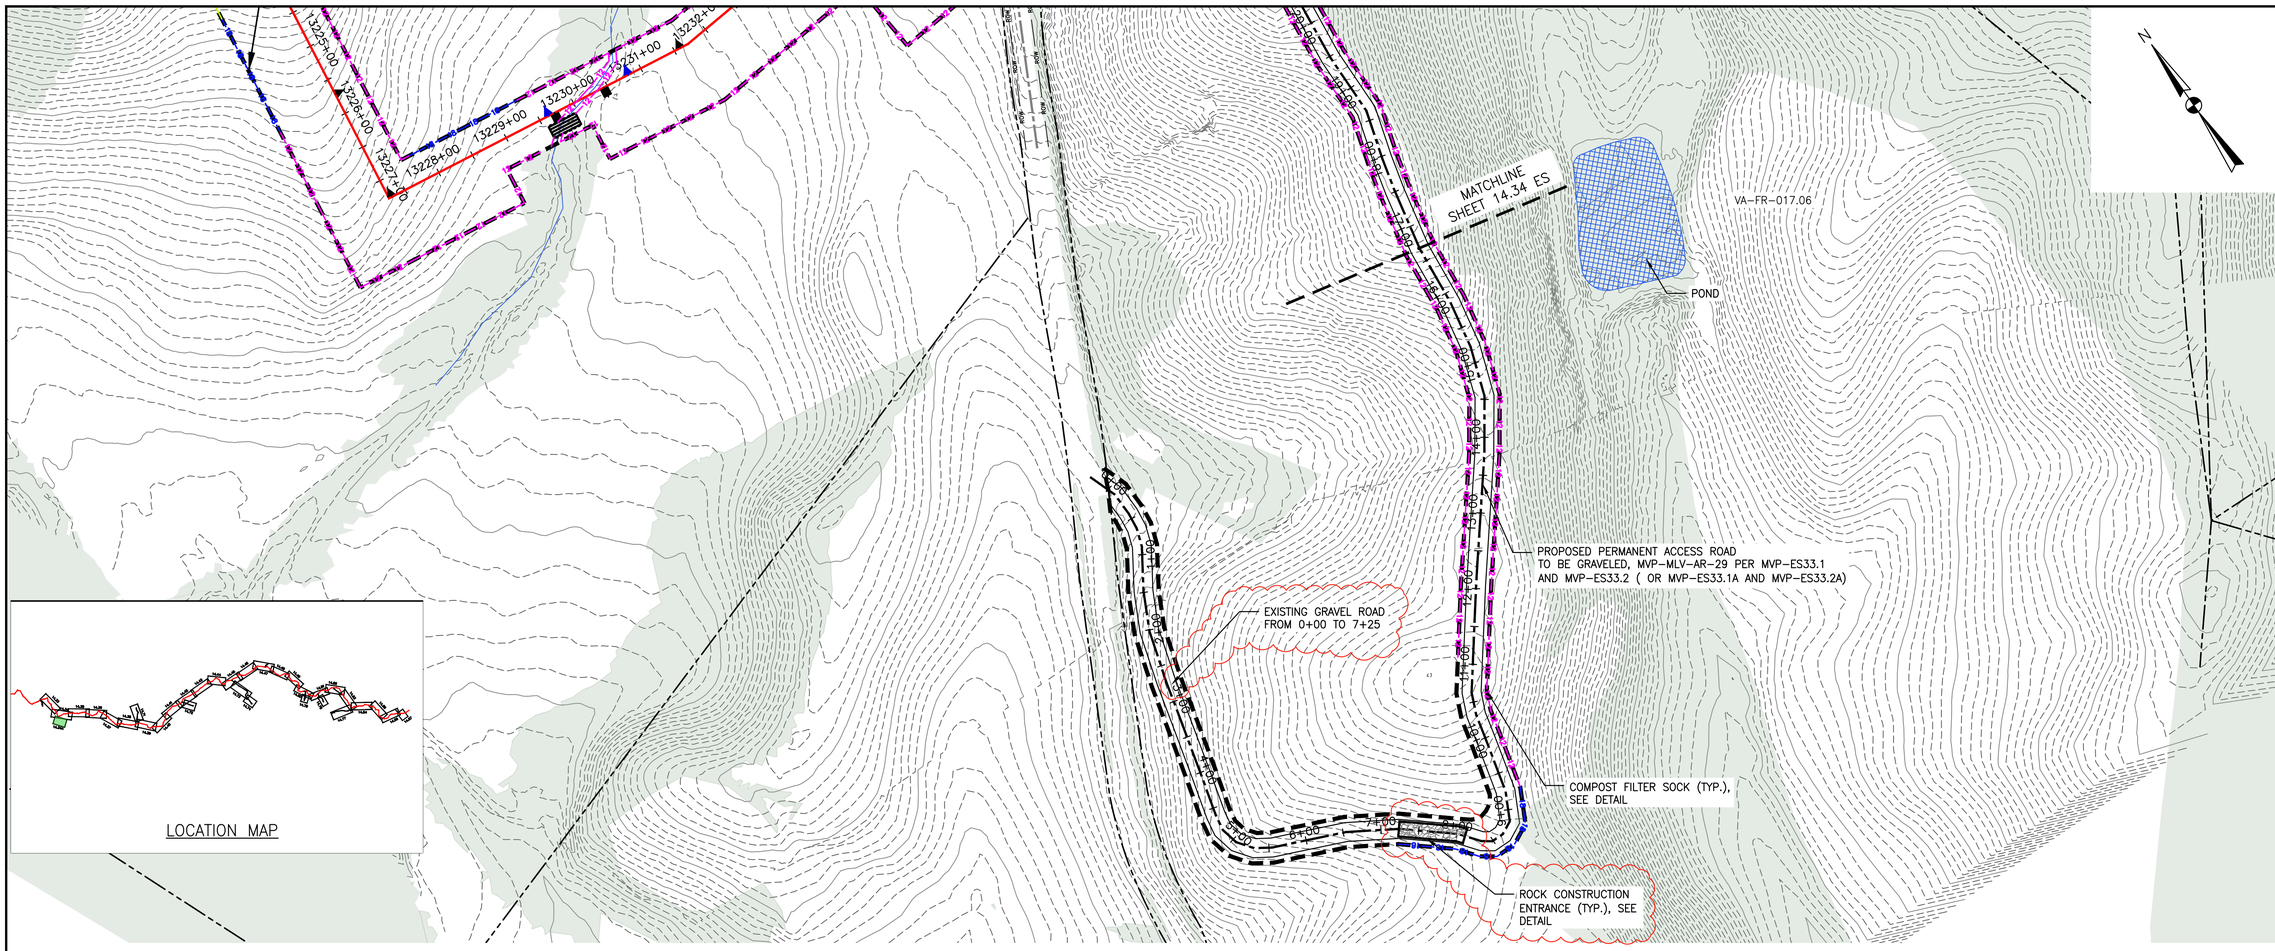

LOCATION MAP

PLAN

SCALE: 1" = 100'

100 0 100 200

COMMONWEALTH OF VIRGINIA
8/14/23
DANIEL C. WITT
Lic. No. 65093
PROFESSIONAL ENGINEER

THIS SEAL APPLIES ONLY TO REVISIONS DATED 07-28-23

LEGEND

- PROPOSED LIMIT OF DISTURBANCE
- STREAM
- USDA FOREST SERVICE (NATIONAL FOREST) LANDS
- APPALACHIAN NATIONAL SCENIC TRAIL
- EXISTING ROAD/TRAIL
- EXISTING PROPERTY LINE
- EXISTING STATE LINE
- EXISTING COUNTY LINE
- POND
- WETLAND
- ACID FORMING MATERIAL
- EXISTING FOREST
- PROPOSED ACCESS ROAD CENTERLINE
- PROPOSED PIPELINE
- PROPOSED SILT FENCE (SEE NOTE 5)
- PROPOSED SUPER SILT FENCE (SEE DETAIL MVP-ES9.2)
- PROPOSED REINFORCED FILTRATION DEVICE (SEE DETAILS MVP-ES9, 9.1, 9.2, 9.3)
- ORANGE CONSTRUCTION SAFETY FENCE
- PROPOSED COMPOST FILTER SOCK (SEE DETAILS MVP-ES3, 3.1, 3.2)
- PROPOSED COMPOST FILTER SOCK (SEE DETAILS MVP-ES3, 3.1, 3.2)
- PROPOSED COMPOST FILTER SOCK (SEE DETAILS MVP-ES3, 3.1, 3.2)
- GRASS-LINED CHANNEL (SEE DETAIL MVP-ES39)
- CLEAN WATER DIVERSION PIPE
- CLEAN WATER DIVERSION DIKE (SEE DETAIL MVP-ES50 AND MVP-ES51)
- STREAM FLOW DIRECTION
- FEMA 100 YEAR FLOODPLAIN
- DRAINAGE AREA BOUNDARY
- TIMBER MAT (SEE DETAIL MVP-ES37)
- STEEP SLOPE EROSION CONTROL (SEE NOTE 2)
- STEEP SLOPE AREAS (SEE NOTE 4)
- PROPOSED ROCK CONSTRUCTION ENTRANCE
- PROPOSED TRENCH BREAKER (SEE DETAIL MVP-20)
- TEMPORARY ROW DIVERSION/WATER BAR (SEE DETAIL MVP-17)
- PERMANENT SLOPE BREAKER/ROW DIVERSION/WATER BAR (SEE DETAIL MVP-17)

NOTES:

1. TOPSOIL SEGREGATION WILL BE PERFORMED IN ALL IMMEDIATE CONSTRUCTION AREAS OF THE PROJECT IN ACCORDANCE WITH DETAILS MVP-ES46.1 THROUGH MVP-ES46.3.
2. FLEXTERRA, EARTHGUARD OR EQUIVALENT MAY BE USED AS A SUBSTITUTE TO EROSION CONTROL BLANKET AS DIRECTED BY MVP.
3. CONTRACTOR IS RESPONSIBLE TO IDENTIFY ALL UTILITIES. THE UTILITY LINES SHOWN ON THE PLAN ARE FOR INFORMATIONAL PURPOSES ONLY AND DO NOT REPRESENT SURVEYED LINE INFORMATION.
4. SLOPES OF 30" OR GREATER EXIST. CONSTRUCTION FOR STEEP SLOPES TO BE PERFORMED USING STEEP SLOPE TECHNIQUES IDENTIFIED IN THE DETAIL SHEETS. ALSO REFER TO THE SITE-SPECIFIC DESIGN OF STABILIZATION MEASURES IN SELECTED HIGH-HAZARD PORTIONS OF THE ROUTE OF THE PROPOSED MOUNTAIN VALLEY PIPLELINE PROJECT.
5. WHERE CONSTRUCTION CONDITIONS PRECLUDE THE USE OF DIVERSION DITCHES DUE TO SITE CONDITIONS THE CONTRACTOR WILL INSTALL SILT FENCE AT THE DIRECTION OF MVP.
6. IMPROVEMENTS TO PERMANENT AND TEMPORARY ACCESS ROADS WILL BE PERFORMED PER THE SITE SPECIFIC ACCESS ROAD DETAILS.
7. TEMPORARY ACCESS ROAD CROSSING OF STREAMS AND WETLANDS WILL UTILIZE TIMBERMATS. ANY PERMANENT ROAD CROSSINGS WILL BE CONDUCTED VIA CULVERTS.
8. ALL NON VMRC STREAM CROSSINGS WILL BE PERFORMED AS DESCRIBED IN THE STREAM CROSSING TABLE INCLUDED IN THIS PACKAGE.

TETRA TECH CAD FILE PATH: X:\CADD_Pittsburgh\EQT\7157 - MVP\15 - Franklin\E&S\ES Version 5.0.0\7157ES14.34AC(S10).dwg PLOTTED ON: 7/25/2023 12:02 PM PLOTTED BY: Zeigler, Justin PLOT FILE: ENVIRONMENTAL_COLOR.ctb

NO.:	DATE:	DWN.:	CHKD.:	APPD.:	DESCRIPTION:
–	06/04/21	JJZ	RE	DW	FIELD MODIFICATION – MLV-29 RELOCATED TO APPROX. MP 252.1
–	03/30/22	JJZ	RE	TD	ADDRES. VADEQ COMMENTS TO FIELD MODIFICATION SUBMITTAL
–	07/28/23	JJZ	IHH	DCW	ADDRESS DEQ COMMENTS

REVISIONS:

Mountain Valley PIPELINE

EROSION AND SEDIMENT CONTROL PLANS

MOUNTAIN VALLEY PIPELINE PROJECT – H600 LINE

SPREAD 10 – FRANKLIN COUNTY, VIRGINIA

MOUNTAIN VALLEY PIPELINE, LLC
2200 ENERGY DRIVE
CANONSBURG, PA 15317


TETRA TECH
complex world | CLEAR SOLUTIONS™
661 ANDERSEN DRIVE
FOSTER PLAZA 7
PITTSBURGH, PA 15220

EROSION AND SEDIMENT CONTROL PLANS

COMMONWEALTH OF VIRGINIA
DAVID J. WALLNER
Lic. No. 57593
PROFESSIONAL ENGINEER
8/12/2023

DRAWN BY:	JJZ
CHECKED BY:	IHH
APPROVED BY:	DCW
DATE:	07/28/2023
SCALE:	AS SHOWN
REVISION	1

SHT. NO. 14.34AES OF 14.81ES

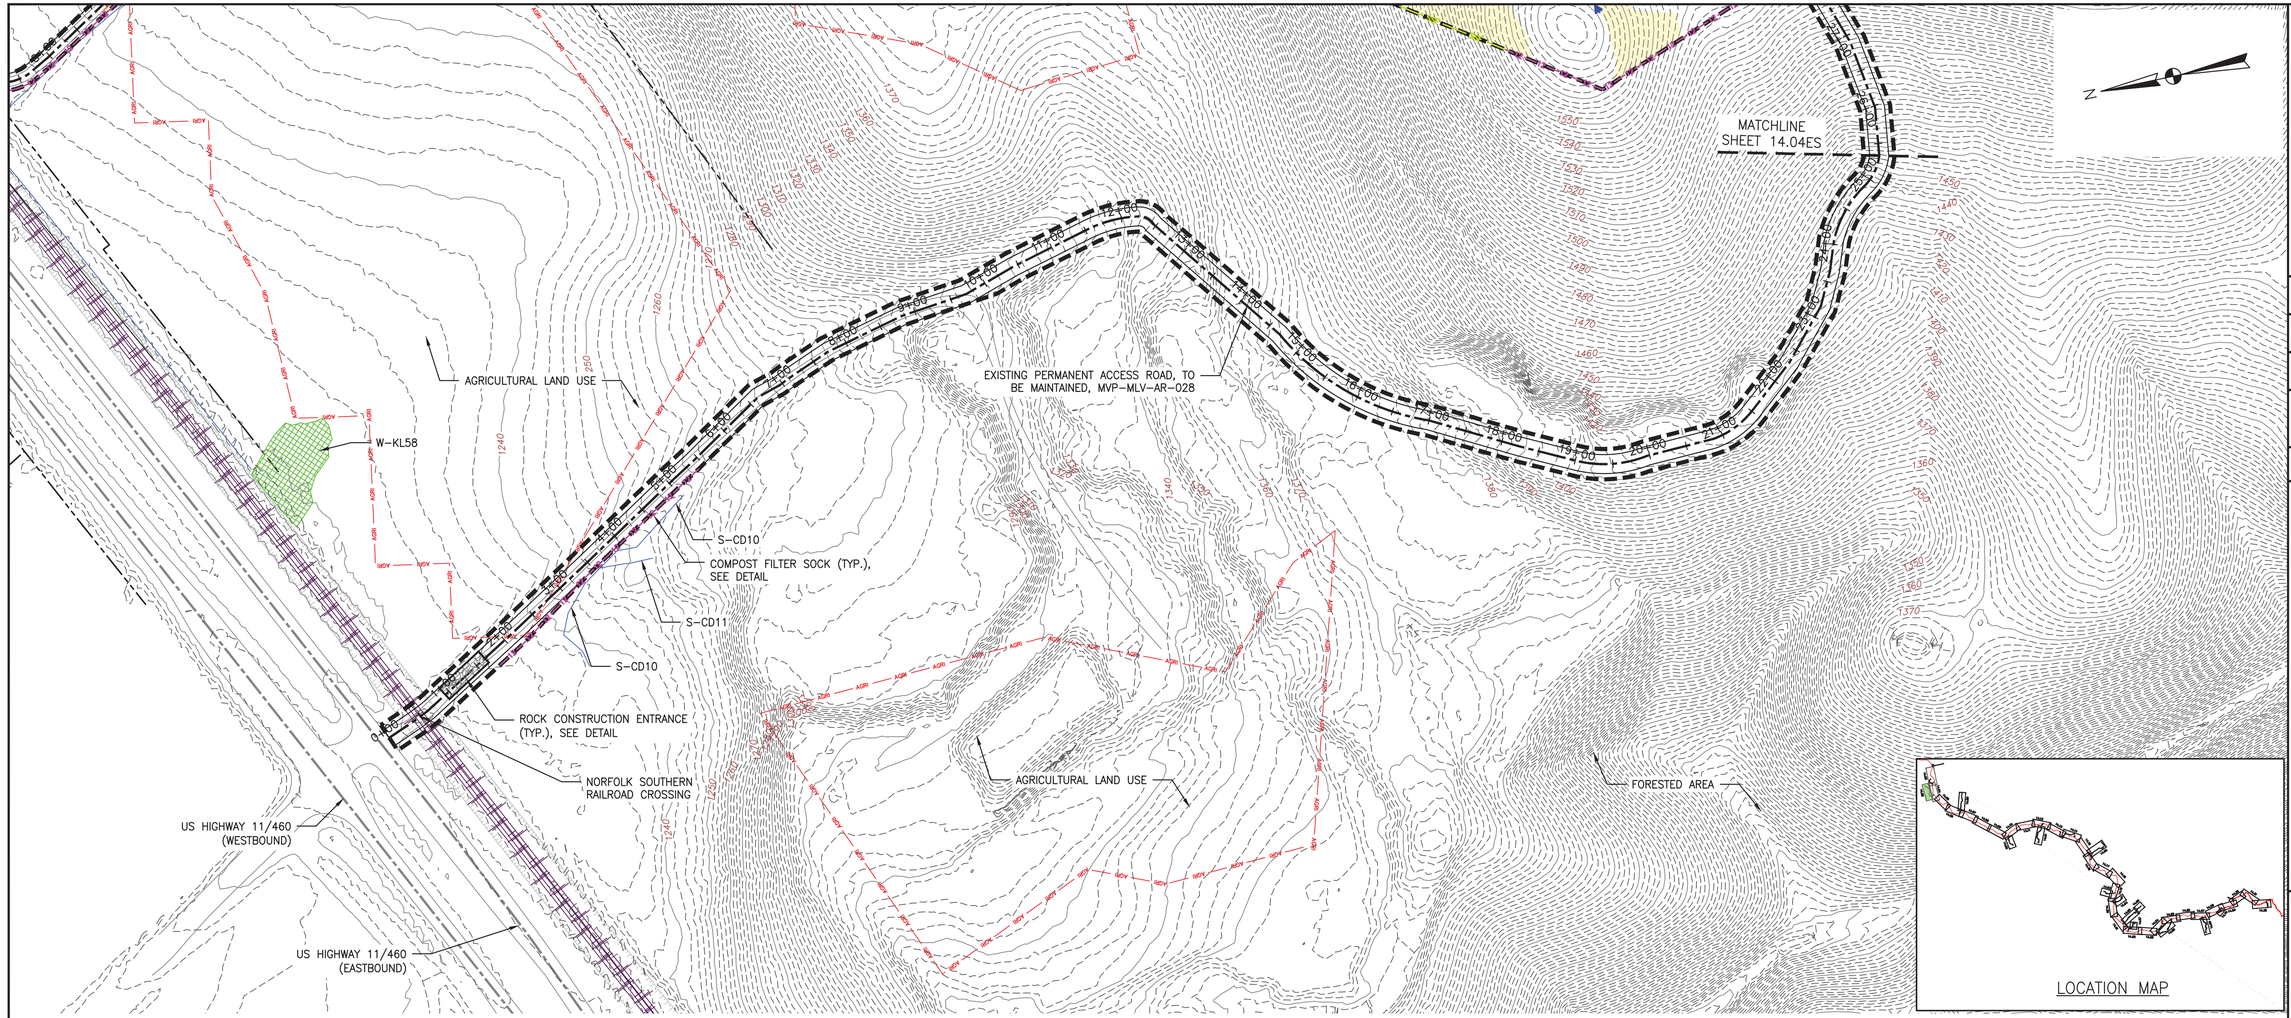

PLAN

SCALE: 1" = 100'

100 0 100 200

LEGEND

- PROPOSED LIMIT OF DISTURBANCE
- STREAM
- USDA FOREST SERVICE (NATIONAL FOREST) LANDS
- APPALACHIAN NATIONAL SCENIC TRAIL
- EXISTING ROAD/TRAIL
- EXISTING PROPERTY LINE
- EXISTING STATE LINE
- EXISTING COUNTY LINE
- POND
- WETLAND
- ACID FORMING MATERIAL
- AGRICULTURAL LAND USE BOUNDARY
- PROPOSED ACCESS ROAD CENTERLINE
- PROPOSED PIPELINE
- PROPOSED SILT FENCE (SEE NOTE 5)
- PROPOSED SUPER SILT FENCE (SEE DETAIL MVP-ES9.2)
- PROPOSED REINFORCED FILTRATION DEVICE (SEE DETAILS MVP-ES9, 9.1, 9.2, 9.3)
- ORANGE CONSTRUCTION SAFETY FENCE
- PROPOSED COMPOST FILTER SOCK (SEE DETAILS MVP-ES3, 3.1, 3.2)
- PROPOSED COMPOST FILTER SOCK (SEE DETAILS MVP-ES3, 3.1, 3.2)
- PROPOSED COMPOST FILTER SOCK (SEE DETAILS MVP-ES3, 3.1, 3.2)
- GRASS-LINED CHANNEL (SEE DETAIL MVP-ES39)
- CLEAN WATER DIVERSION PIPE
- CLEAN WATER DIVERSION DIKE (SEE DETAIL MVP-ES50 AND MVP-ES51)
- STREAM FLOW DIRECTION
- FEMA 100 YEAR FLOODPLAIN
- DRAINAGE AREA BOUNDARY
- TIMBER MAT (SEE DETAIL MVP-ES37)
- STEEP SLOPE EROSION CONTROL (SEE NOTE 2)
- STEEP SLOPE AREAS (SEE NOTE 4)
- PROPOSED ROCK CONSTRUCTION ENTRANCE
- PROPOSED TRENCH BREAKER (SEE DETAIL MVP-20)
- TEMPORARY ROW DIVERSION/WATER BAR (VADEQ STD & SPEC 3.11)
- PERMANENT SLOPE BREAKER/ROW DIVERSION/WATER BAR (SEE DETAILS MVP-17, ES38, AND SCHEDULE)

NOTES:

1. TOPSOIL SEGREGATION WILL BE PERFORMED IN ALL IMMEDIATE CONSTRUCTION AREAS OF THE PROJECT IN ACCORDANCE WITH DETAILS MVP-ES46.1 THROUGH MVP-ES46.3.
2. FLEXTERRA, EARTHGUARD OR EQUIVALENT MAY BE USED AS A SUBSTITUTE TO EROSION CONTROL BLANKET AS DIRECTED BY MVP.
3. CONTRACTOR IS RESPONSIBLE TO IDENTIFY ALL UTILITIES. THE UTILITY LINES SHOWN ON THE PLAN ARE FOR INFORMATIONAL PURPOSES ONLY AND DO NOT REPRESENT SURVEYED LINE INFORMATION.
4. SLOPES OF 30° OR GREATER EXIST. CONSTRUCTION FOR STEEP SLOPES TO BE PERFORMED USING STEEP SLOPE TECHNIQUES IDENTIFIED IN THE DETAIL SHEETS. ALSO REFER TO THE SITE-SPECIFIC DESIGN OF STABILIZATION MEASURES IN SELECTED HIGH-HAZARD PORTIONS OF THE ROUTE OF THE PROPOSED MOUNTAIN VALLEY PIPELINE PROJECT.
5. WHERE CONSTRUCTION CONDITIONS PRECLUDE THE USE OF DIVERSION DITCHES DUE TO SITE CONDITIONS THE CONTRACTOR WILL INSTALL SILT FENCE AT THE DIRECTION OF MVP.
6. IMPROVEMENTS TO PERMANENT AND TEMPORARY ACCESS ROADS WILL BE PERFORMED PER THE SITE SPECIFIC ACCESS ROAD DETAILS.
7. TEMPORARY ACCESS ROAD CROSSING OF STREAMS AND WETLANDS WILL UTILIZE TIMBERMATS. ANY PERMANENT ROAD CROSSINGS WILL BE CONDUCTED VIA CULVERTS.
8. ALL NON VMRC STREAM CROSSINGS WILL BE PERFORMED AS DESCRIBED IN THE STREAM CROSSING TABLE INCLUDED IN THIS PACKAGE.

NO.	DATE:	DWN.:	CHKD.:	APPD.:	DESCRIPTION:
5	03/04/18	KAL	RE	DW	ADDRESS VADEQ COMMENTS
4	02/27/18	KAL	RE	DW	ADDRESS VADEQ COMMENTS
3	02/05/18	KAL	RE	DW	ADDRESS VADEQ COMMENTS
2	11/21/17	KAL	RE	DW	ADDRESS VADEQ COMMENTS
1	09/21/17	KAL	RE	DW	PLAN SUBMISSION

REVISIONS:

Mountain Valley PIPELINE

EROSION AND SEDIMENT CONTROL PLANS

MOUNTAIN VALLEY PIPELINE PROJECT – H600 LINE

SPREAD 10 – MONTGOMERY COUNTY, VIRGINIA

MOUNTAIN VALLEY PIPELINE, LLC
555 SOUTHPOINTE BOULEVARD, SUITE 200
CANONSBURG, PA 15311

TETRA TECH
complex world | CLEAR SOLUTIONS™
661 ANDERSEN DRIVE
FOSTER PLAZA 7
PITTSBURGH, PA 15220


EROSION AND SEDIMENT CONTROL PLANS

COMMONWEALTH OF VIRGINIA
DAVID J. WALLNER
Lic. No. 0402057593
PROFESSIONAL ENGINEER

DRAWN BY:	KAL
CHECKED BY:	RE
APPROVED BY:	DW
DATE:	03/04/2018
SCALE:	AS SHOWN
SHT. NO.	14.58ES OF 14.81ES

REVISION

TETRA TECH CAD FILE PATH: X:\CADD_Pittsburgh\EQT\7157 – MVP\13 – Montgomery\E&S\E&S Version 5.0.0\7157ES14.58(S10).dwg PLOTTED ON: 3/2/2018 4:36 PM PLOTTED BY: Zeigler, Justin PLOT FILE: ENVIRONMENTAL_COLOR.ctb

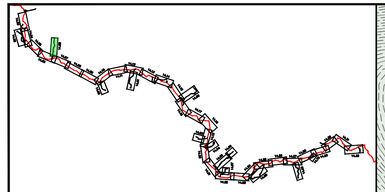

LOCATION MAP

PLAN

SCALE: 1" = 100'

100 0 100 200

LEGEND

- PROPOSED LIMIT OF DISTURBANCE
- STREAM
- USDA FOREST SERVICE (NATIONAL FOREST) LANDS
- APPALACHIAN NATIONAL SCENIC TRAIL (ANST)
- EXISTING ROAD/TRAIL
- EXISTING PROPERTY LINE
- EXISTING STATE LINE
- EXISTING COUNTY LINE
- POND
- WETLAND
- ACID FORMING MATERIAL (AFM)
- EXISTING FOREST
- PROPOSED ACCESS ROAD CENTERLINE
- PROPOSED PIPELINE
- PROPOSED SILT FENCE (SEE NOTE 5) (SF)
- PROPOSED SUPER SILT FENCE (SEE DETAIL MVP-ES9.2) (SSF)
- PROPOSED REINFORCED FILTRATION DEVICE (SEE DETAILS MVP-ES9, 9.1, 9.2, 9.3) (RFD)
- ORANGE CONSTRUCTION SAFETY FENCE (OCSF)
- PROPOSED COMPOST FILTER SOCK (SEE DETAILS MVP-ES3, 3.1, 3.2) (12)
- PROPOSED COMPOST FILTER SOCK (SEE DETAILS MVP-ES3, 3.1, 3.2) (18)
- PROPOSED COMPOST FILTER SOCK (SEE DETAILS MVP-ES3, 3.1, 3.2) (24)
- GRASS-LINED CHANNEL (SEE DETAIL MVP-ES39)
- CLEAN WATER DIVERSION PIPE
- CLEAN WATER DIVERSION DIKE (SEE DETAIL MVP-ES50 AND MVP-ES51)
- STREAM FLOW DIRECTION
- FEMA 100 YEAR FLOODPLAIN
- DRAINAGE AREA BOUNDARY
- TIMBER MAT (SEE DETAIL MVP-ES37)
- STEEP SLOPE EROSION CONTROL (SEE NOTE 2)
- STEEP SLOPE AREAS (SEE NOTE 4)
- PROPOSED ROCK CONSTRUCTION ENTRANCE
- PROPOSED TRENCH BREAKER (SEE DETAIL MVP-20)
- TEMPORARY ROW DIVERSION/WATER BAR (VADEQ STD & SPEC 3.11)
- PERMANENT SLOPE BREAKER/ROW DIVERSION/WATER BAR (SEE DETAILS MVP-17, ES38, AND SCHEDULE)

NOTES:

1. TOPSOIL SEGREGATION WILL BE PERFORMED IN ALL IMMEDIATE CONSTRUCTION AREAS OF THE PROJECT IN ACCORDANCE WITH DETAILS MVP-ES46.1 THROUGH MVP-ES46.3.
2. FLEXTERRA, EARTHGUARD OR EQUIVALENT MAY BE USED AS A SUBSTITUTE TO EROSION CONTROL BLANKET AS DIRECTED BY MVP.
3. CONTRACTOR IS RESPONSIBLE TO IDENTIFY ALL UTILITIES. THE UTILITY LINES SHOWN ON THE PLAN ARE FOR INFORMATIONAL PURPOSES ONLY AND DO NOT REPRESENT SURVEYED LINE INFORMATION.
4. SLOPES OF 30" OR GREATER EXIST. CONSTRUCTION FOR STEEP SLOPES TO BE PERFORMED USING STEEP SLOPE TECHNIQUES IDENTIFIED IN THE DETAIL SHEETS. ALSO REFER TO THE SITE-SPECIFIC DESIGN OF STABILIZATION MEASURES IN SELECTED HIGH-HAZARD PORTIONS OF THE ROUTE OF THE PROPOSED MOUNTAIN VALLEY PIPELINE PROJECT.
5. WHERE CONSTRUCTION CONDITIONS PRECLUDE THE USE OF DIVERSION DITCHES DUE TO SITE CONDITIONS THE CONTRACTOR WILL INSTALL SILT FENCE AT THE DIRECTION OF MVP.
6. IMPROVEMENTS TO PERMANENT AND TEMPORARY ACCESS ROADS WILL BE PERFORMED PER THE SITE SPECIFIC ACCESS ROAD DETAILS.
7. TEMPORARY ACCESS ROAD CROSSING OF STREAMS AND WETLANDS WILL UTILIZE TIMBERMATS. ANY PERMANENT ROAD CROSSINGS WILL BE CONDUCTED VIA CULVERTS.
8. ALL NON VMRC STREAM CROSSINGS WILL BE PERFORMED AS DESCRIBED IN THE STREAM CROSSING TABLE INCLUDED IN THIS PACKAGE.

NO.	DATE:	DWN.:	CHKD.:	APPD.:	DESCRIPTION:
–	02/08/19	GAR	RE	DW	ADDRESS VADEQ COMMENTS TO H-9 FIELD MODIFICATION SUBMITTAL
7	10/01/18	GAR	RE	DW	FIELD MODIFICATION
6	03/16/18	KAL	RE	DW	ADDRESS VADEQ COMMENTS
5	03/04/18	KAL	RE	DW	ADDRESS VADEQ COMMENTS
4	02/27/18	KAL	RE	DW	ADDRESS VADEQ COMMENTS
3	02/05/18	KAL	RE	DW	ADDRESS VADEQ COMMENTS

REVISIONS:

Mountain Valley PIPELINE

EROSION AND SEDIMENT CONTROL PLANS

MOUNTAIN VALLEY PIPELINE PROJECT – H600 LINE

SPREAD 10 – MONTGOMERY COUNTY, VIRGINIA

MOUNTAIN VALLEY PIPELINE, LLC
2200 ENERGY DRIVE
CANONSBURG, PA 15311

TETRA TECH
complex world | CLEAR SOLUTIONS™
661 ANDERSEN DRIVE
FOSTER PLAZA 7
PITTSBURGH, PA 15220


EROSION AND SEDIMENT CONTROL PLANS

COMMONWEALTH OF VIRGINIA
DAVID J. WALLNER
Lic. No. 0402057593
PROFESSIONAL ENGINEER


DRAWN BY:	GAR
CHECKED BY:	RE
APPROVED BY:	DW
DATE:	02/08/2019
SCALE:	AS SHOWN
SHT. NO.	14.59ES OF 14.81ES

REVISION

TETRA TECH CAD FILE PATH: X:\CADD_Pittsburgh\EQT\7157 – MVP\13 – Montgomery\E&S\E&S Version 5.0.0\7157ES14.59(S10).dwg PLOTTED ON: 4/10/2019 2:08 PM PLOTTED BY: Kusiowski, Jim PLOT FILE: ENVIRONMENTAL_COLOR.ctb

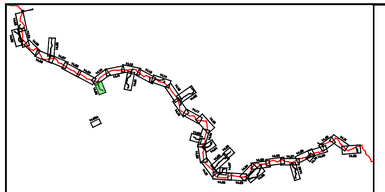

LOCATION MAP

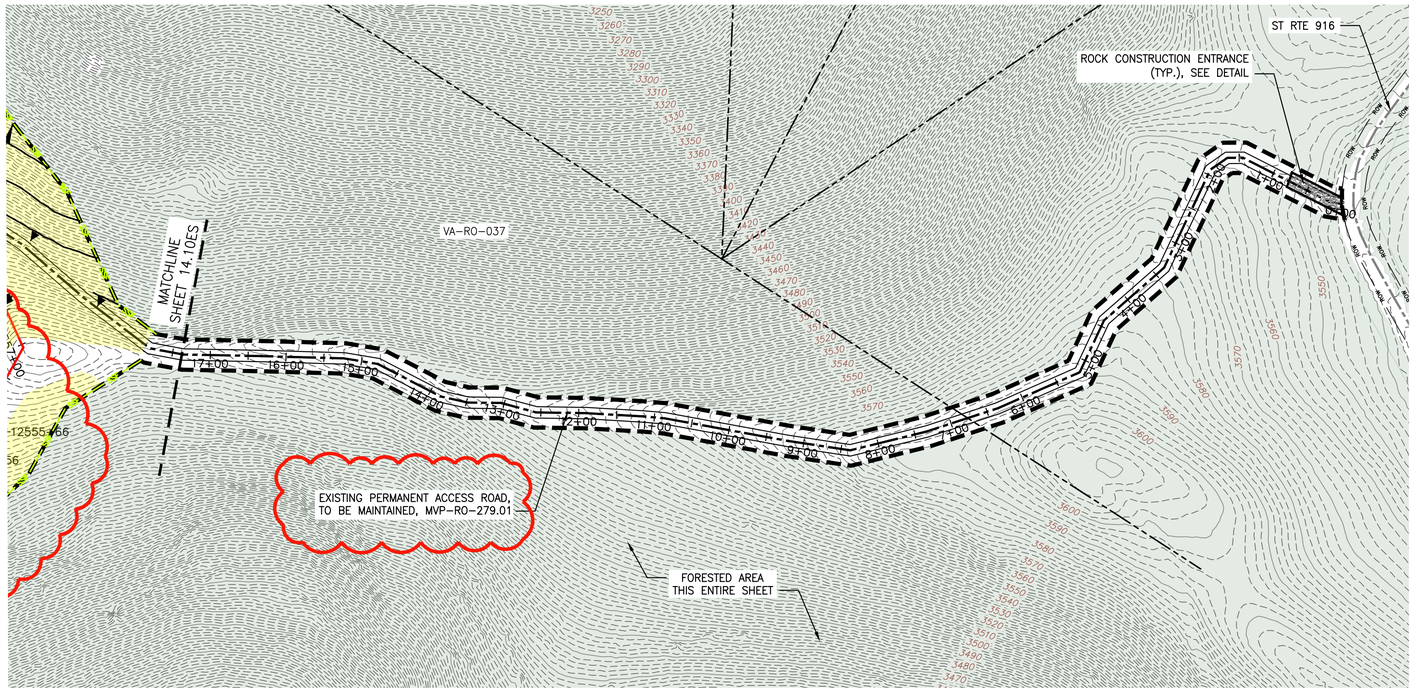

PLAN

SCALE: 1" = 100'

100 0 100 200

N

LEGEND

- PROPOSED LIMIT OF DISTURBANCE
- STREAM
- USDA FOREST SERVICE (NATIONAL FOREST) LANDS
- APPALACHIAN NATIONAL SCENIC TRAIL
- EXISTING ROAD/TRAIL
- EXISTING PROPERTY LINE
- EXISTING STATE LINE
- EXISTING COUNTY LINE
- POND
- WETLAND
- ACID FORMING MATERIAL
- EXISTING FOREST
- PROPOSED ACCESS ROAD CENTERLINE
- PROPOSED PIPELINE
- PROPOSED SILT FENCE (SEE NOTE 5)
- PROPOSED SUPER SILT FENCE (SEE DETAIL MVP-ES9.2)
- PROPOSED REINFORCED FILTRATION DEVICE (SEE DETAILS MVP-ES9, 9.1, 9.2, 9.3)
- ORANGE CONSTRUCTION SAFETY FENCE
- PROPOSED COMPOST FILTER SOCK (SEE DETAILS MVP-ES3, 3.1, 3.2)
- PROPOSED COMPOST FILTER SOCK (SEE DETAILS MVP-ES3, 3.1, 3.2)
- PROPOSED COMPOST FILTER SOCK (SEE DETAILS MVP-ES3, 3.1, 3.2)
- GRASS-LINED CHANNEL (SEE DETAIL MVP-ES39)
- CLEAN WATER DIVERSION PIPE
- CLEAN WATER DIVERSION DIKE (SEE DETAIL MVP-ES50 AND MVP-ES51)
- STREAM FLOW DIRECTION
- FEMA 100 YEAR FLOODPLAIN
- DRAINAGE AREA BOUNDARY
- TIMBER MAT (SEE DETAIL MVP-ES37)
- STEEP SLOPE EROSION CONTROL (SEE NOTE 2)
- STEEP SLOPE AREAS (SEE NOTE 4)
- PROPOSED ROCK CONSTRUCTION ENTRANCE
- PROPOSED TRENCH BREAKER (SEE DETAIL MVP-20)
- TEMPORARY ROW DIVERSION/WATER BAR (SEE DETAIL MP-17)
- PERMANENT SLOPE BREAKER/ROW DIVERSION/WATER BAR (SEE DETAIL MP-17)

NOTES:

1. TOPSOIL SEGREGATION WILL BE PERFORMED IN ALL IMMEDIATE CONSTRUCTION AREAS OF THE PROJECT IN ACCORDANCE WITH DETAILS MVP-ES46.1 THROUGH MVP-ES46.3.
2. FLEXTERRA, EARTHGUARD OR EQUIVALENT MAY BE USED AS A SUBSTITUTE TO EROSION CONTROL BLANKET AS DIRECTED BY MVP.
3. CONTRACTOR IS RESPONSIBLE TO IDENTIFY ALL UTILITIES. THE UTILITY LINES SHOWN ON THE PLAN ARE FOR INFORMATIONAL PURPOSES ONLY AND DO NOT REPRESENT SURVEYED LINE INFORMATION.
4. SLOPES OF 30" OR GREATER EXIST. CONSTRUCTION FOR STEEP SLOPES TO BE PERFORMED USING STEEP SLOPE TECHNIQUES IDENTIFIED IN THE DETAIL SHEETS. ALSO REFER TO THE SITE-SPECIFIC DESIGN OF STABILIZATION MEASURES IN SELECTED HIGH-HAZARD PORTIONS OF THE ROUTE OF THE PROPOSED MOUNTAIN VALLEY PIPLELINE PROJECT.
5. WHERE CONSTRUCTION CONDITIONS PRECLUDE THE USE OF DIVERSION DITCHES DUE TO SITE CONDITIONS THE CONTRACTOR WILL INSTALL SILT FENCE AT THE DIRECTION OF MVP.
6. IMPROVEMENTS TO PERMANENT AND TEMPORARY ACCESS ROADS WILL BE PERFORMED PER THE SITE SPECIFIC ACCESS ROAD DETAILS.
7. TEMPORARY ACCESS ROAD CROSSING OF STREAMS AND WETLANDS WILL UTILIZE TIMBERMATS. ANY PERMANENT ROAD CROSSINGS WILL BE CONDUCTED VIA CULVERTS.
8. ALL NON VMRC STREAM CROSSINGS WILL BE PERFORMED AS DESCRIBED IN THE STREAM CROSSING TABLE INCLUDED IN THIS PACKAGE.

NO.:	DATE:	DWN.:	CHKD.:	APPD.:	DESCRIPTION:
–	09/19/22	JJZ	RE	DW	CORRECTED LABEL FOR MVP-RO-279.01
6	07/31/18	JJZ	RE	DW	FIELD MODIFICATION
5	03/04/18	KAL	RE	DW	ADDRESS VADEQ COMMENTS
4	02/27/18	KAL	RE	DW	ADDRESS VADEQ COMMENTS
3	02/05/18	KAL	RE	DW	ADDRESS VADEQ COMMENTS
2	11/21/17	KAL	RE	DW	ADDRESS VADEQ COMMENTS

REVISIONS:

Mountain Valley PIPELINE

EROSION AND SEDIMENT CONTROL PLANS

MOUNTAIN VALLEY PIPELINE PROJECT – H600 LINE

SPREAD 10 – ROANOKE COUNTY, VIRGINIA

MOUNTAIN VALLEY PIPELINE, LLC
2200 ENERGY DRIVE
CANONSBURG, PA 15311

TETRA TECH
complex world | CLEAR SOLUTIONS™
661 ANDERSEN DRIVE
FOSTER PLAZA 7
PITTSBURGH, PA 15220

EROSION AND SEDIMENT CONTROL PLANS


COMMONWEALTH OF VIRGINIA
DAVID J. WALLNER
Lic. No. 0402057593
PROFESSIONAL ENGINEER

DRAWN BY:	JJZ
CHECKED BY:	RE
APPROVED BY:	DW
DATE:	09/19/2022
SCALE:	AS SHOWN

6 REVISION


SHT. NO. 14.60ES OF 14.81ES


TETRA TECH CAD FILE PATH: X:\CADD_Pittsburgh\EQT\7157 – MVP\14 – Roanoke\E&S\E&S VERSION 5.0.0\7157ES14.60(S10).dwg PLOTTED ON: 9/28/2022 3:23 PM PLOTTED BY: Zeigler, Justin PLOT FILE: ENVIRONMENTAL_COLOR.ctb

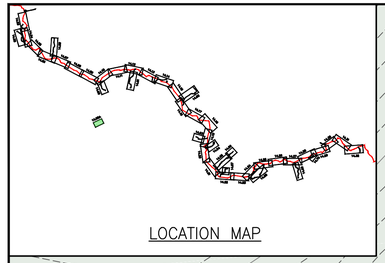

LOCATION MAP

SITE ACCESS INSET

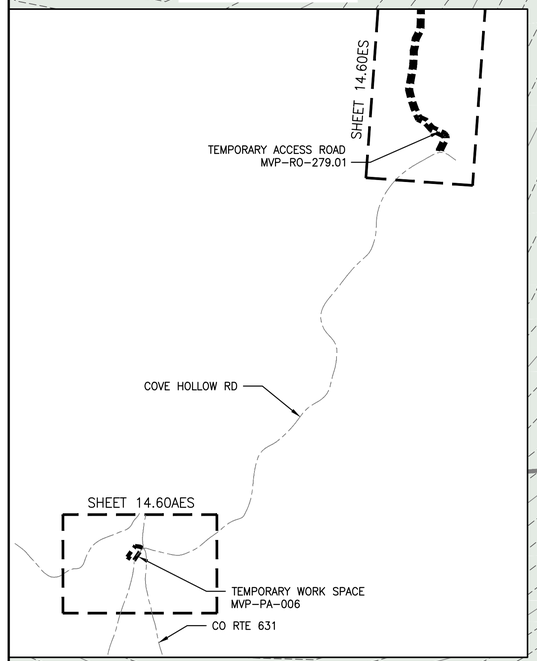

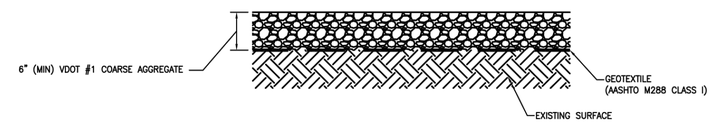

TEMPORARY GRAVEL SURFACE SPECIFICATIONS

- NO SOIL DISTURBANCE WILL OCCUR AND THE GRAVEL WILL BE PLACED ON EXISTING GRADE.
- THE EXISTING SURFACE SHALL BE CLEARED OF ALL VEGETATION AND OTHER OBJECTIONABLE MATERIAL BY BRUSH HOGGING THE AREA. NO GRUBBING OR OTHER SOIL DISTURBING ACTIVITIES WILL BE CONDUCTED, AND TOPSOIL STRIPPING WILL NOT OCCUR.
- A 6-INCH COURSE OF VDOT #1 COARSE AGGREGATE (AS PER SECTION 203 OF VDOT'S ROAD AND BRIDGE SPECIFICATIONS) SHALL BE PROVIDED AS SOON AS VEGETATION REMOVAL IS COMPLETE.
- IN "HEAVY DUTY" TRAFFIC SITUATIONS THE AGGREGATE SHOULD INSTEAD BE PLACED AT AN 8- TO 10-INCH DEPTH TO AVOID EXCESSIVE DISSIPATION OR MAINTENANCE NEEDS.
- IF THE GRAVEL SURFACE BECOMES CLOGGED WITH SEDIMENT AND OTHER DEBRIS, IT SHALL BE REMOVED AND REPLACED WITH CLEAN AGGREGATE SO THAT INFILTRATION IS MAINTAINED.
- GEOTEXTILE SHALL BE NON-WOVEN WITH AASHTO M288 SURVIVABILITY CLASS (1) AND A MIN. PERMITTIVITY OF 90 GAL/MIN/FT².

TYPICAL GRAVEL SURFACE DETAIL
N.T.S.

PLAN
SCALE: 1" = 50'

50 0 50 100

LEGEND

- EXISTING PROPERTY LINE
- 1160 EXISTING CONTOUR (MAJOR)
- EXISTING CONTOUR (MINOR)
- EXISTING EDGE OF ROAD (SURVEYED)
- EXISTING ROAD CENTERLINE
- PROPOSED LIMIT OF DISTURBANCE
- 12 PROPOSED 12" COMPOST FILTER SOCK
- FLOW DIRECTION
- EXISTING FOREST

TOPO DATA SOURCE:

CONTOUR DATA DERIVED FROM RADFORD UNIVERSITY ONLINE RESOURCE

NOTES:

1. ALL FACILITIES ARE TEMPORARY AND WILL BE REMOVED FOLLOWING CONSTRUCTION. ALL GRAVEL WILL BE REMOVED AND THE LOD WILL BE REVEGETATED PER THE TABLES ON DETAILS MVP-ES11.1 TO MVP-ES11.9 OR PER LANDOWNER REQUEST.
2. CONTRACTOR IS RESPONSIBLE TO IDENTIFY ALL UTILITIES. THE UTILITY LINES SHOWN ON THE PLAN ARE FOR INFORMATIONAL PURPOSES ONLY AND DO NOT REPRESENT SURVEYED LINE INFORMATION.
3. VEGETATION WILL BE REMOVED BY BRUSH HOGGING THE AREA; ANY TREES TO BE REMOVED WILL BE CONDUCTED BY HAND FELLING/CUTTING OF STUMPS AT THE GROUND SURFACE. TEMPORARY GRAVEL OVER GEOTEXTILE (SEE DETAIL) WILL BE INSTALLED AFTER ALL VEGETATION/TREES ARE REMOVED.
4. NO GRUBBING OR OTHER SOIL DISTURBING ACTIVITIES WILL BE CONDUCTED, AND TOPSOIL STRIPPING WILL NOT OCCUR.

REVISIONS:

NO.:	DATE:	DWN.:	CHKD.:	APPD.:	DESCRIPTION:
1	02/13/20	GAR	RE	DW	ADDRESS VAEQ COMMENTS
0	07/12/19	JK	RE	DW	TEMPORARY WORK SPACE ADDED TO FACILITATE TRUCK TURNAROUND

Mountain Valley PIPELINE

EROSION AND SEDIMENT CONTROL PLANS
MOUNTAIN VALLEY PIPELINE PROJECT – H600 LINE
SPREAD 10 – MONTGOMERY COUNTY, VIRGINIA

MOUNTAIN VALLEY PIPELINE, LLC
2200 ENERGY DRIVE
CANONSBURG, PA 15317

TETRA TECH
complex world | CLEAR SOLUTIONS™
661 ANDERSEN DRIVE
FOSTER PLAZA 7
PITTSBURGH, PA 15220


EROSION AND SEDIMENT CONTROL PLANS


COMMONWEALTH OF VIRGINIA
DAVID J. WALLNER
Lic. No. 0402057593
PROFESSIONAL ENGINEER

DRAWN BY:	JK
CHECKED BY:	RE
APPROVED BY:	DW
DATE:	02/13/2020
SCALE:	AS SHOWN
SHT. NO.	14.60AES OF 14.81ES

1 REVISION

LOCATION MAP

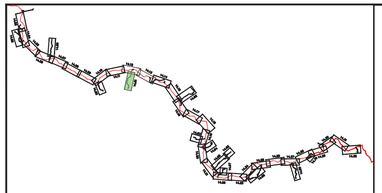

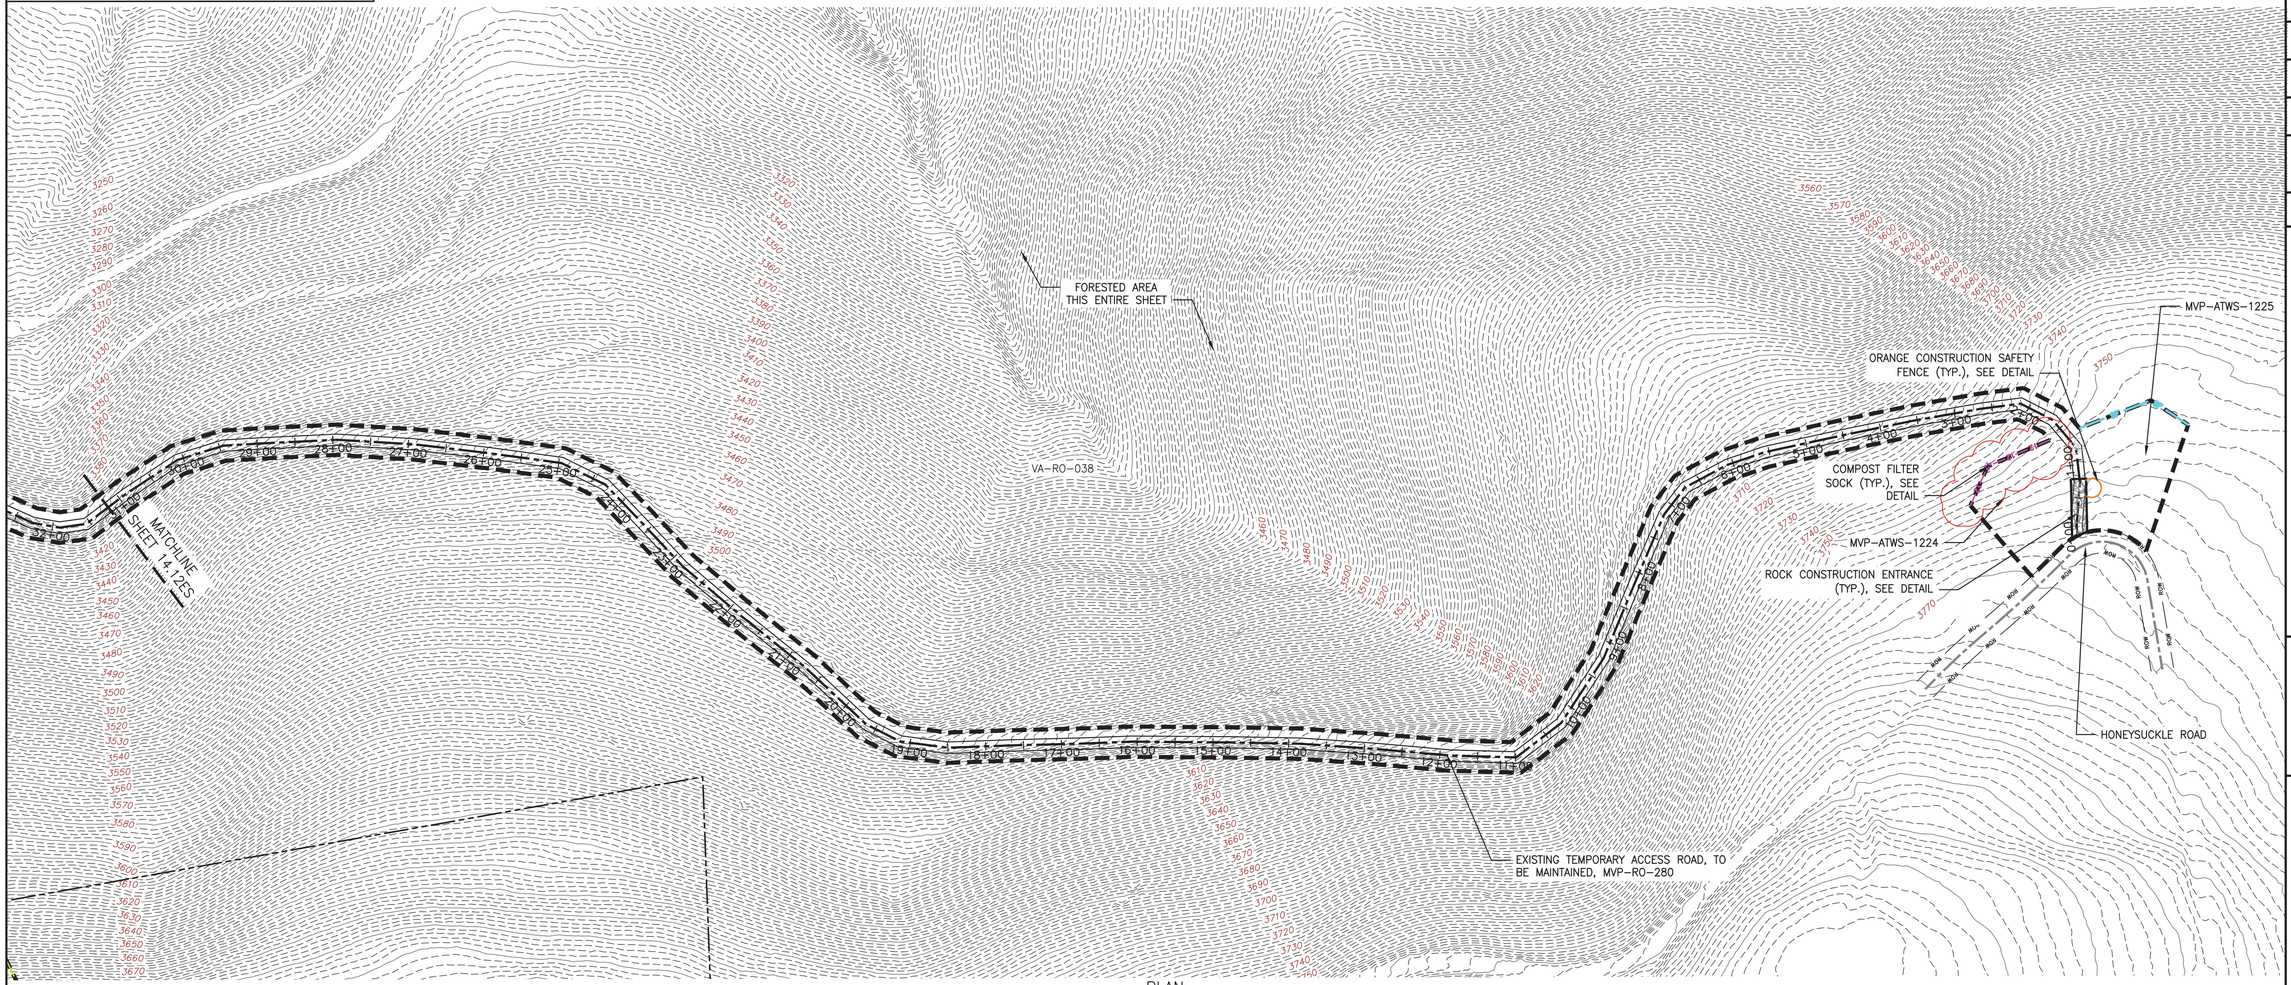

PLAN

SCALE: 1" = 100'

100 0 100 200

LEGEND

- PROPOSED LIMIT OF DISTURBANCE
- STREAM
- USDA FOREST SERVICE (NATIONAL FOREST) LANDS
- APPALACHIAN NATIONAL SCENIC TRAIL
- EXISTING ROAD/TRAIL
- EXISTING PROPERTY LINE
- EXISTING STATE LINE
- EXISTING COUNTY LINE
- POND
- WETLAND
- ACID FORMING MATERIAL
- AGRICULTURAL LAND USE BOUNDARY
- PROPOSED ACCESS ROAD CENTERLINE
- PROPOSED PIPELINE
- PROPOSED SILT FENCE (SEE NOTE 5)
- PROPOSED SUPER SILT FENCE (SEE DETAIL MVP-ES9.2)
- PROPOSED REINFORCED FILTRATION DEVICE (SEE DETAILS MVP-ES9, 9.1, 9.2, 9.3)
- ORANGE CONSTRUCTION SAFETY FENCE
- PROPOSED COMPOST FILTER SOCK (SEE DETAILS MVP-ES3, 3.1, 3.2)
- PROPOSED COMPOST FILTER SOCK (SEE DETAILS MVP-ES3, 3.1, 3.2)
- PROPOSED COMPOST FILTER SOCK (SEE DETAILS MVP-ES3, 3.1, 3.2)
- GRASS-LINED CHANNEL (SEE DETAIL MVP-ES39)
- CLEAN WATER DIVERSION PIPE
- CLEAN WATER DIVERSION DIKE (SEE DETAIL MVP-ES50 AND MVP-ES51)
- STREAM FLOW DIRECTION
- FEMA 100 YEAR FLOODPLAIN
- DRAINAGE AREA BOUNDARY
- TIMBER MAT (SEE DETAIL MVP-ES37)
- STEEP SLOPE EROSION CONTROL (SEE NOTE 2)
- STEEP SLOPE AREAS (SEE NOTE 4)
- PROPOSED ROCK CONSTRUCTION ENTRANCE
- PROPOSED TRENCH BREAKER (SEE DETAIL MVP-20)
- TEMPORARY ROW DIVERSION/WATER BAR (VADEQ STD & SPEC 3.11)
- PERMANENT SLOPE BREAKER/ROW DIVERSION/WATER BAR (SEE DETAILS MVP-17, ES38, AND SCHEDULE)

NOTES:

1. TOPSOIL SEGREGATION WILL BE PERFORMED IN ALL IMMEDIATE CONSTRUCTION AREAS OF THE PROJECT IN ACCORDANCE WITH DETAILS MVP-ES46.1 THROUGH MVP-ES46.3.
2. FLEXTERRA, EARTHGUARD OR EQUIVALENT MAY BE USED AS A SUBSTITUTE TO EROSION CONTROL BLANKET AS DIRECTED BY MVP.
3. CONTRACTOR IS RESPONSIBLE TO IDENTIFY ALL UTILITIES. THE UTILITY LINES SHOWN ON THE PLAN ARE FOR INFORMATIONAL PURPOSES ONLY AND DO NOT REPRESENT SURVEYED LINE INFORMATION.
4. SLOPES OF 30° OR GREATER EXIST. CONSTRUCTION FOR STEEP SLOPES TO BE PERFORMED USING STEEP SLOPE TECHNIQUES IDENTIFIED IN THE DETAIL SHEETS. ALSO REFER TO THE SITE-SPECIFIC DESIGN OF STABILIZATION MEASURES IN SELECTED HIGH-HAZARD PORTIONS OF THE ROUTE OF THE PROPOSED MOUNTAIN VALLEY PIPELINE PROJECT.
5. WHERE CONSTRUCTION CONDITIONS PRECLUDE THE USE OF DIVERSION DITCHES DUE TO SITE CONDITIONS THE CONTRACTOR WILL INSTALL SILT FENCE AT THE DIRECTION OF MVP.
6. IMPROVEMENTS TO PERMANENT AND TEMPORARY ACCESS ROADS WILL BE PERFORMED PER THE SITE SPECIFIC ACCESS ROAD DETAILS.
7. TEMPORARY ACCESS ROAD CROSSING OF STREAMS AND WETLANDS WILL UTILIZE TIMBERMATS. ANY PERMANENT ROAD CROSSINGS WILL BE CONDUCTED VIA CULVERTS.
8. ALL NON VMRC STREAM CROSSINGS WILL BE PERFORMED AS DESCRIBED IN THE STREAM CROSSING TABLE INCLUDED IN THIS PACKAGE.

NO.:	DATE:	DWN.:	CHKD.:	APPD.:	DESCRIPTION:
5	03/04/18	KAL	RE	DW	ADDRESS VADEQ COMMENTS
4	02/27/18	KAL	RE	DW	ADDRESS VADEQ COMMENTS
3	02/05/18	KAL	RE	DW	ADDRESS VADEQ COMMENTS
2	11/21/17	KAL	RE	DW	ADDRESS VADEQ COMMENTS
1	09/21/17	KAL	RE	DW	PLAN SUBMISSION

REVISIONS:

Mountain Valley PIPELINE

EROSION AND SEDIMENT CONTROL PLANS

MOUNTAIN VALLEY PIPELINE PROJECT – H600 LINE

SPREAD 10 – ROANOKE COUNTY, VIRGINIA

MOUNTAIN VALLEY PIPELINE, LLC
555 SOUTHPOINTE BOULEVARD, SUITE 200
CANONSBURG, PA 15311

TETRA TECH
complex world | CLEAR SOLUTIONS™
661 ANDERSEN DRIVE
FOSTER PLAZA 7
PITTSBURGH, PA 15220

EROSION AND SEDIMENT CONTROL PLANS


COMMONWEALTH OF VIRGINIA
DAVID J. WALLNER
Lic. No. 0402057593
PROFESSIONAL ENGINEER

DRAWN BY:	KAL
CHECKED BY:	RE
APPROVED BY:	DW
DATE:	03/04/2018
SCALE:	AS SHOWN
REVISION	

SHT. NO. 14.16ES OF 14.81ES

TETRA TECH CAD FILE PATH: X:\CADD_Pittsburgh\EGT\7157 – MVP\14 – Roanoke\E&S\E&S VERSION 5.0.0\7157ES14.61(S10).dwg PLOTTED ON: 3/2/2018 4:50 PM PLOTTED BY: Zeigler, Justin PLOT FILE: ENVIRONMENTAL_COLOR.ctb

LOCATION MAP

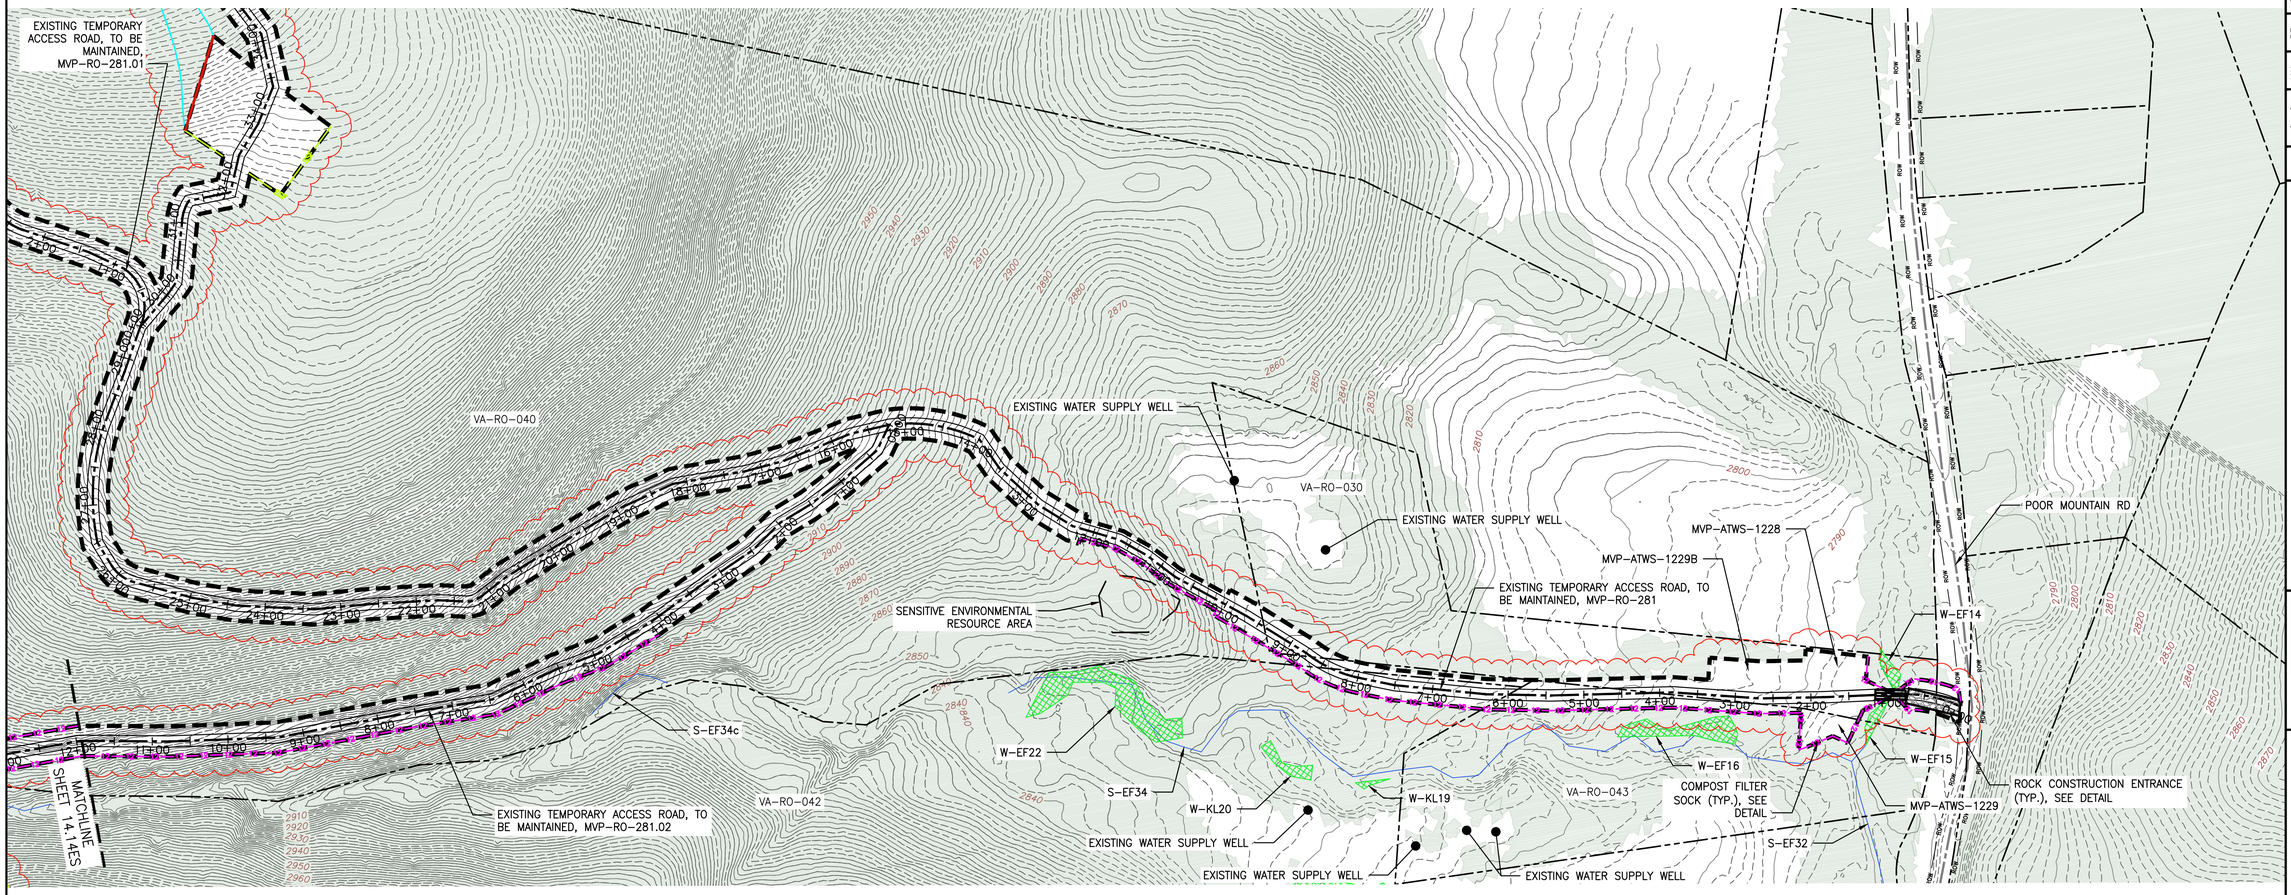

N

PLAN
SCALE: 1" = 100'
100 0 100 200

LEGEND

- PROPOSED LIMIT OF DISTURBANCE
- STREAM
- USDA FOREST SERVICE (NATIONAL FOREST) LANDS
- APPALACHIAN NATIONAL SCENIC TRAIL
- EXISTING ROAD/TRAIL
- EXISTING PROPERTY LINE
- EXISTING STATE LINE
- EXISTING COUNTY LINE
- POND
- WETLAND
- ACID FORMING MATERIAL
- EXISTING FOREST
- PROPOSED ACCESS ROAD CENTERLINE
- PROPOSED PIPELINE
- PROPOSED SILT FENCE (SEE NOTE 5)
- PROPOSED SUPER SILT FENCE (SEE DETAIL MVP-ES9.2)
- PROPOSED REINFORCED FILTRATION DEVICE (SEE DETAILS MVP-ES9, 9.1, 9.2, 9.3)
- ORANGE CONSTRUCTION SAFETY FENCE
- PROPOSED COMPOST FILTER SOCK (SEE DETAILS MVP-ES3, 3.1, 3.2)
- PROPOSED COMPOST FILTER SOCK (SEE DETAILS MVP-ES3, 3.1, 3.2)
- PROPOSED COMPOST FILTER SOCK (SEE DETAILS MVP-ES3, 3.1, 3.2)
- GRASS-LINED CHANNEL (SEE DETAIL MVP-ES39)
- CLEAN WATER DIVERSION PIPE
- CLEAN WATER DIVERSION DIKE (SEE DETAIL MVP-ES50 AND MVP-ES51)
- STREAM FLOW DIRECTION
- FEMA 100 YEAR FLOODPLAIN
- DRAINAGE AREA BOUNDARY
- TIMBER MAT (SEE DETAIL MVP-ES37)
- STEEP SLOPE EROSION CONTROL (SEE NOTE 2)
- STEEP SLOPE AREAS (SEE NOTE 4)
- PROPOSED ROCK CONSTRUCTION ENTRANCE
- PROPOSED TRENCH BREAKER (SEE DETAIL MVP-20)
- TEMPORARY ROW DIVERSION/WATER BAR (SEE DETAIL MP-17)
- PERMANENT SLOPE BREAKER/ROW DIVERSION/WATER BAR (SEE DETAIL MVP-17)

NOTES:

1. TOPSOIL SEGREGATION WILL BE PERFORMED IN ALL IMMEDIATE CONSTRUCTION AREAS OF THE PROJECT IN ACCORDANCE WITH DETAILS MVP-ES46.1 THROUGH MVP-ES46.3.
2. FLEXTERRA, EARTHGUARD OR EQUIVALENT MAY BE USED AS A SUBSTITUTE TO EROSION CONTROL BLANKET AS DIRECTED BY MVP.
3. CONTRACTOR IS RESPONSIBLE TO IDENTIFY ALL UTILITIES. THE UTILITY LINES SHOWN ON THE PLAN ARE FOR INFORMATIONAL PURPOSES ONLY AND DO NOT REPRESENT SURVEYED LINE INFORMATION.
4. SLOPES OF 30° OR GREATER EXIST. CONSTRUCTION FOR STEEP SLOPES TO BE PERFORMED USING STEEP SLOPE TECHNIQUES IDENTIFIED IN THE DETAIL SHEETS. ALSO REFER TO THE SITE-SPECIFIC DESIGN OF STABILIZATION MEASURES IN SELECTED HIGH-HAZARD PORTIONS OF THE ROUTE OF THE PROPOSED MOUNTAIN VALLEY PIPLELINE PROJECT.
5. WHERE CONSTRUCTION CONDITIONS PRECLUDE THE USE OF DIVERSION DITCHES DUE TO SITE CONDITIONS THE CONTRACTOR WILL INSTALL SILT FENCE AT THE DIRECTION OF MVP.
6. IMPROVEMENTS TO PERMANENT AND TEMPORARY ACCESS ROADS WILL BE PERFORMED PER THE SITE SPECIFIC ACCESS ROAD DETAILS.
7. TEMPORARY ACCESS ROAD CROSSING OF STREAMS AND WETLANDS WILL UTILIZE TIMBERMATS. ANY PERMANENT ROAD CROSSINGS WILL BE CONDUCTED VIA CULVERTS.
8. ALL NON VMRC STREAM CROSSINGS WILL BE PERFORMED AS DESCRIBED IN THE STREAM CROSSING TABLE INCLUDED IN THIS PACKAGE.

NO.:	DATE:	DWN.:	CHKD.:	APPD.:	DESCRIPTION:
6	07/31/18	KAL	RE	DW	FIELD MODIFICATION
5	03/04/18	KAL	RE	DW	ADDRESS VADEQ COMMENTS
4	02/27/18	KAL	RE	DW	ADDRESS VADEQ COMMENTS
3	02/05/18	KAL	RE	DW	ADDRESS VADEQ COMMENTS
2	11/21/17	KAL	RE	DW	ADDRESS VADEQ COMMENTS
1	09/21/17	KAL	RE	DW	PLAN SUBMISSION

REVISIONS:

Mountain Valley PIPELINE

EROSION AND SEDIMENT CONTROL PLANS
MOUNTAIN VALLEY PIPELINE PROJECT – H600 LINE
SPREAD 10 – ROANOKE COUNTY, VIRGINIA

MOUNTAIN VALLEY PIPELINE, LLC
555 SOUTHPOINTE BOULEVARD, SUITE 200
CANONSBURG, PA 15311

TETRA TECH
complex world | CLEAR SOLUTIONS™
661 ANDERSEN DRIVE
FOSTER PLAZA 7
PITTSBURGH, PA 15220


EROSION AND SEDIMENT CONTROL PLANS

COMMONWEALTH OF VIRGINIA
DAVID J. WALLNER
Lic. No. 0402057593
PROFESSIONAL ENGINEER

DRAWN BY:	KAL
CHECKED BY:	RE
APPROVED BY:	DW
DATE:	07/31/2018
SCALE:	AS SHOWN
REVISION	6

SHT. NO. 14.61AES OF 14.81ES

TETRA TECH CAD FILE PATH: X:\CADD_Pittsburgh\EQT\7157 – MVP\14 – Roanoke\E&S\E&S VERSION 5.0.0\7157ES14.61A(S10).dwg PLOTTED ON: 7/31/2018 10:39 AM PLOTTED BY: Kusiowski, Jim PLOT FILE: ENVIRONMENTAL_COLOR.ctb

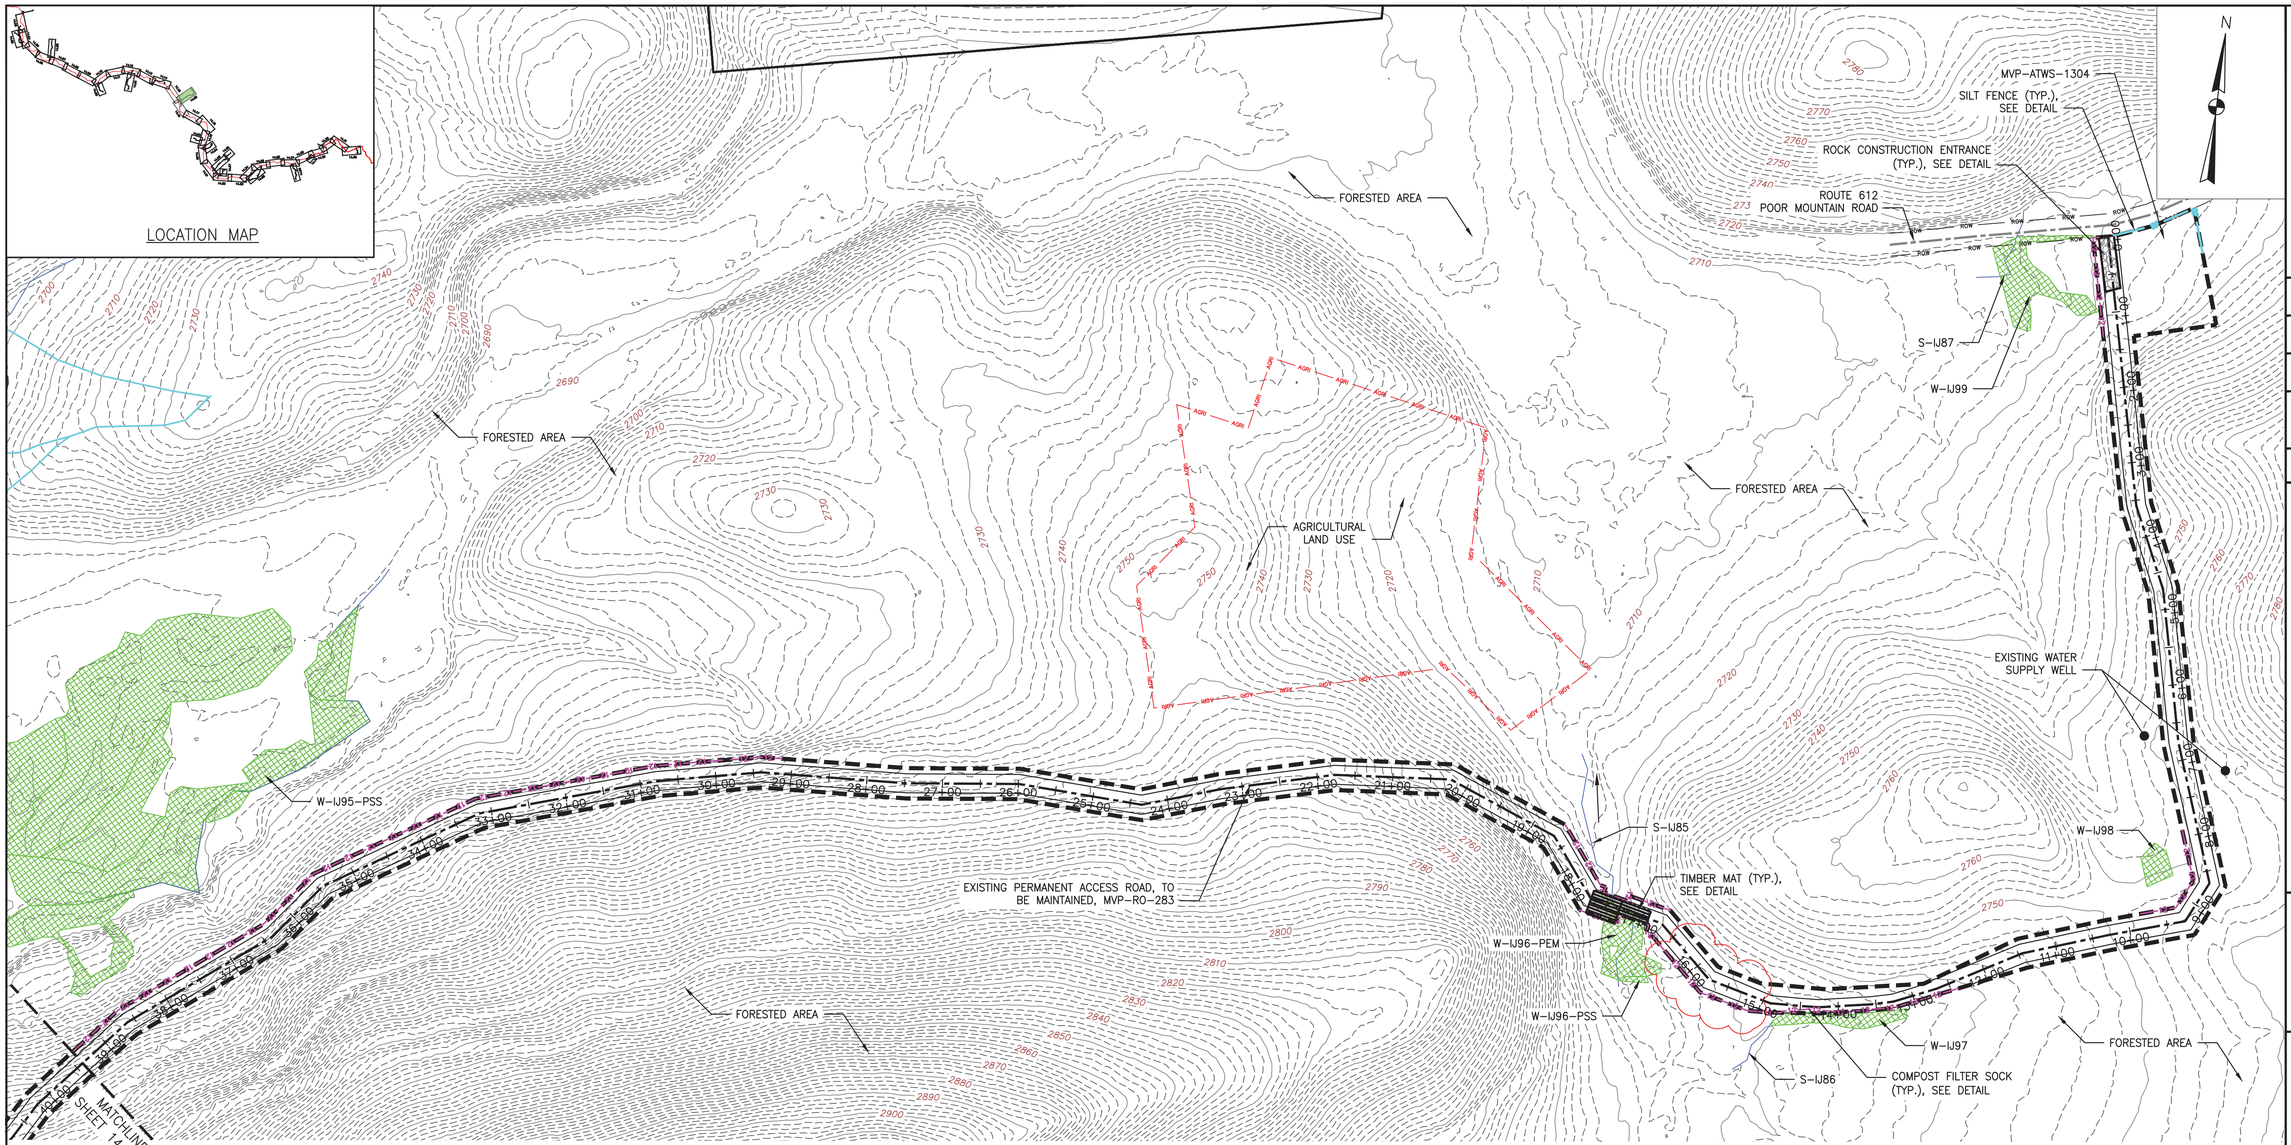

PLAN

SCALE: 1" = 100'

100 0 100 200

LEGEND

- PROPOSED LIMIT OF DISTURBANCE
- STREAM
- USDA FOREST SERVICE (NATIONAL FOREST) LANDS
- APPALACHIAN NATIONAL SCENIC TRAIL
- EXISTING ROAD/TRAIL
- EXISTING PROPERTY LINE
- EXISTING STATE LINE
- EXISTING COUNTY LINE
- POND
- WETLAND
- ACID FORMING MATERIAL
- AGRICULTURAL LAND USE BOUNDARY
- PROPOSED ACCESS ROAD CENTERLINE
- PROPOSED PIPELINE
- PROPOSED SILT FENCE (SEE NOTE 5)
- PROPOSED SUPER SILT FENCE (SEE DETAIL MVP-ES9.2)
- PROPOSED REINFORCED FILTRATION DEVICE (SEE DETAILS MVP-ES9, 9.1, 9.2, 9.3)
- ORANGE CONSTRUCTION SAFETY FENCE
- PROPOSED COMPOST FILTER SOCK (SEE DETAILS MVP-ES3, 3.1, 3.2)
- PROPOSED COMPOST FILTER SOCK (SEE DETAILS MVP-ES3, 3.1, 3.2)
- PROPOSED COMPOST FILTER SOCK (SEE DETAILS MVP-ES3, 3.1, 3.2)
- GRASS-LINED CHANNEL (SEE DETAIL MVP-ES39)
- CLEAN WATER DIVERSION PIPE
- CLEAN WATER DIVERSION DIKE (SEE DETAIL MVP-ES50 AND MVP-ES51)
- STREAM FLOW DIRECTION
- FEMA 100 YEAR FLOODPLAIN
- DRAINAGE AREA BOUNDARY
- TIMBER MAT (SEE DETAIL MVP-ES37)
- STEEP SLOPE EROSION CONTROL (SEE NOTE 2)
- STEEP SLOPE AREAS (SEE NOTE 4)
- PROPOSED ROCK CONSTRUCTION ENTRANCE
- PROPOSED TRENCH BREAKER (SEE DETAIL MVP-20)
- TEMPORARY ROW DIVERSION/WATER BAR (VADEQ STD & SPEC 3.11)
- PERMANENT SLOPE BREAKER/ROW DIVERSION/WATER BAR (SEE DETAILS MVP-17, ES38, AND SCHEDULE)

NOTES:

1. TOPSOIL SEGREGATION WILL BE PERFORMED IN ALL IMMEDIATE CONSTRUCTION AREAS OF THE PROJECT IN ACCORDANCE WITH DETAILS MVP-ES46.1 THROUGH MVP-ES46.3.
2. FLEXTERRA, EARTHGUARD OR EQUIVALENT MAY BE USED AS A SUBSTITUTE TO EROSION CONTROL BLANKET AS DIRECTED BY MVP.
3. CONTRACTOR IS RESPONSIBLE TO IDENTIFY ALL UTILITIES. THE UTILITY LINES SHOWN ON THE PLAN ARE FOR INFORMATIONAL PURPOSES ONLY AND DO NOT REPRESENT SURVEYED LINE INFORMATION.
4. SLOPES OF 30° OR GREATER EXIST. CONSTRUCTION FOR STEEP SLOPES TO BE PERFORMED USING STEEP SLOPE TECHNIQUES IDENTIFIED IN THE DETAIL SHEETS. ALSO REFER TO THE SITE-SPECIFIC DESIGN OF STABILIZATION MEASURES IN SELECTED HIGH-HAZARD PORTIONS OF THE ROUTE OF THE PROPOSED MOUNTAIN VALLEY PIPELINE PROJECT.
5. WHERE CONSTRUCTION CONDITIONS PRECLUDE THE USE OF DIVERSION DITCHES DUE TO SITE CONDITIONS THE CONTRACTOR WILL INSTALL SILT FENCE AT THE DIRECTION OF MVP.
6. IMPROVEMENTS TO PERMANENT AND TEMPORARY ACCESS ROADS WILL BE PERFORMED PER THE SITE SPECIFIC ACCESS ROAD DETAILS.
7. TEMPORARY ACCESS ROAD CROSSING OF STREAMS AND WETLANDS WILL UTILIZE TIMBERMATS. ANY PERMANENT ROAD CROSSINGS WILL BE CONDUCTED VIA CULVERTS.
8. ALL NON VMRC STREAM CROSSINGS WILL BE PERFORMED AS DESCRIBED IN THE STREAM CROSSING TABLE INCLUDED IN THIS PACKAGE.

NO.	DATE:	DWN.:	CHKD.:	APPD.:	DESCRIPTION:
5	03/04/18	KAL	RE	DW	ADDRESS VADEQ COMMENTS
4	02/27/18	KAL	RE	DW	ADDRESS VADEQ COMMENTS
3	02/05/18	KAL	RE	DW	ADDRESS VADEQ COMMENTS
2	11/21/17	KAL	RE	DW	ADDRESS VADEQ COMMENTS
1	09/21/17	KAL	RE	DW	PLAN SUBMISSION

REVISIONS:

Mountain Valley PIPELINE

EROSION AND SEDIMENT CONTROL PLANS

MOUNTAIN VALLEY PIPELINE PROJECT – H600 LINE

SPREAD 10 – ROANOKE COUNTY, VIRGINIA

MOUNTAIN VALLEY PIPELINE, LLC
555 SOUTHPOINTE BOULEVARD, SUITE 200
CANONSBURG, PA 15311

TETRA TECH
complex world | CLEAR SOLUTIONS™
661 ANDERSEN DRIVE
FOSTER PLAZA 7
PITTSBURGH, PA 15220


EROSION AND SEDIMENT CONTROL PLANS

COMMONWEALTH OF VIRGINIA
DAVID J. WALLNER
Lic. No. 0402057593
PROFESSIONAL ENGINEER


DRAWN BY:	KAL
CHECKED BY:	RE
APPROVED BY:	DW
DATE:	03/04/2018
SCALE:	AS SHOWN
SHT. NO.	14.62ES OF 14.81ES

REVISION

TETRA TECH CAD FILE PATH: X:\CADD_Pittsburgh\EQT\7157 – MVP\14 – Roanoke\E&S\E&S VERSION 5.0.0\7157ES14.62(S10).dwg PLOTTED ON: 3/2/2018 4:51 PM PLOTTED BY: Zeigler, Justin PLOT FILE: ENVIRONMENTAL_COLOR.ctb

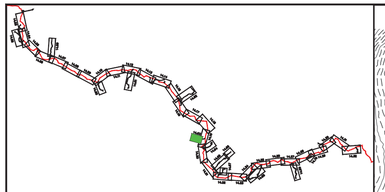

LOCATION MAP

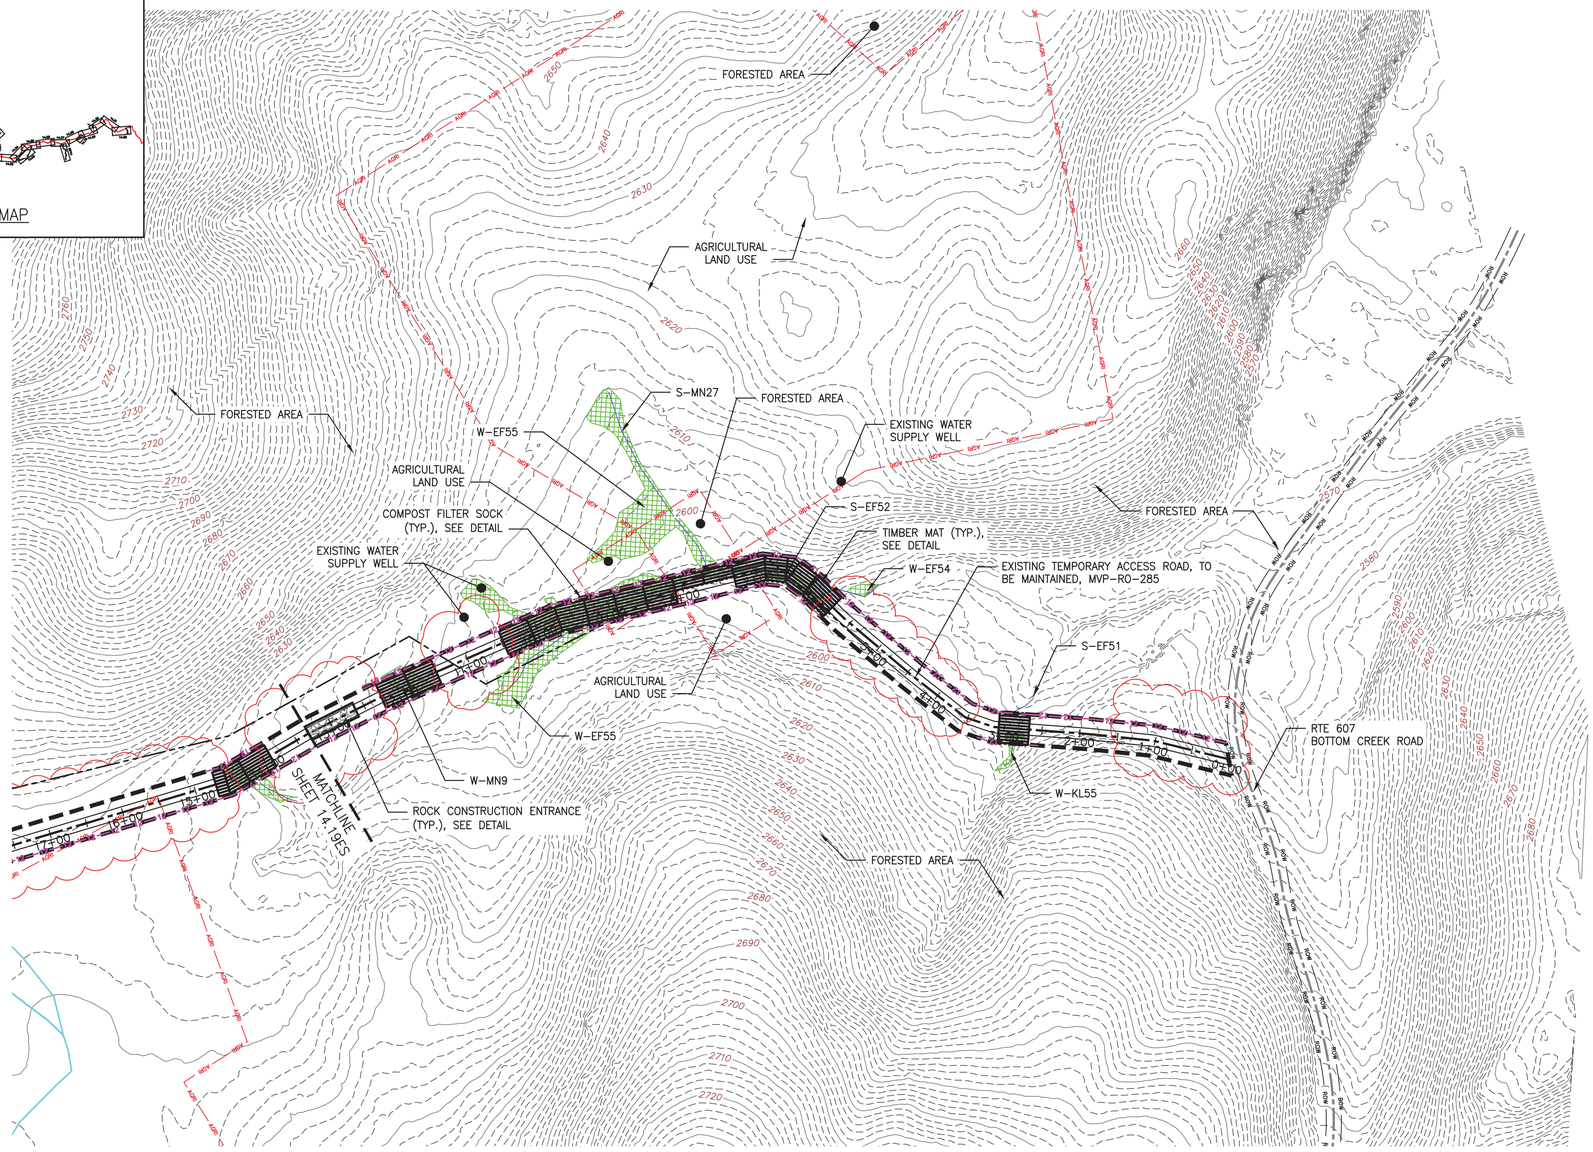

PLAN

SCALE: 1" = 100'

100 0 100 200

LEGEND

- PROPOSED LIMIT OF DISTURBANCE
- STREAM
- USDA FOREST SERVICE (NATIONAL FOREST) LANDS
- APPALACHIAN NATIONAL SCENIC TRAIL
- EXISTING ROAD/TRAIL
- EXISTING PROPERTY LINE
- EXISTING STATE LINE
- EXISTING COUNTY LINE
- POND
- WETLAND
- ACID FORMING MATERIAL
- AGRICULTURAL LAND USE BOUNDARY
- PROPOSED ACCESS ROAD CENTERLINE
- PROPOSED PIPELINE
- PROPOSED SILT FENCE (SEE NOTE 5)
- PROPOSED SUPER SILT FENCE (SEE DETAIL MVP-ES9.2)
- PROPOSED REINFORCED FILTRATION DEVICE (SEE DETAILS MVP-ES9, 9.1, 9.2, 9.3)
- ORANGE CONSTRUCTION SAFETY FENCE
- PROPOSED COMPOST FILTER SOCK (SEE DETAILS MVP-ES3, 3.1, 3.2)
- PROPOSED COMPOST FILTER SOCK (SEE DETAILS MVP-ES3, 3.1, 3.2)
- PROPOSED COMPOST FILTER SOCK (SEE DETAILS MVP-ES3, 3.1, 3.2)
- GRASS-LINED CHANNEL (SEE DETAIL MVP-ES39)
- CLEAN WATER DIVERSION PIPE
- CLEAN WATER DIVERSION DIKE (SEE DETAIL MVP-ES50 AND MVP-ES51)
- STREAM FLOW DIRECTION
- FEMA 100 YEAR FLOODPLAIN
- DRAINAGE AREA BOUNDARY
- TIMBER MAT (SEE DETAIL MVP-ES37)
- STEEP SLOPE EROSION CONTROL (SEE NOTE 2)
- STEEP SLOPE AREAS (SEE NOTE 4)
- PROPOSED ROCK CONSTRUCTION ENTRANCE
- PROPOSED TRENCH BREAKER (SEE DETAIL MVP-20)
- TEMPORARY ROW DIVERSION/WATER BAR (VADEQ STD & SPEC 3.11)
- PERMANENT SLOPE BREAKER/ROW DIVERSION/WATER BAR (SEE DETAILS MVP-17, ES38, AND SCHEDULE)

NOTES:

1. TOPSOIL SEGREGATION WILL BE PERFORMED IN ALL IMMEDIATE CONSTRUCTION AREAS OF THE PROJECT IN ACCORDANCE WITH DETAILS MVP-ES46.1 THROUGH MVP-ES46.3.
2. FLEXTERRA, EARTHGUARD OR EQUIVALENT MAY BE USED AS A SUBSTITUTE TO EROSION CONTROL BLANKET AS DIRECTED BY MVP.
3. CONTRACTOR IS RESPONSIBLE TO IDENTIFY ALL UTILITIES. THE UTILITY LINES SHOWN ON THE PLAN ARE FOR INFORMATIONAL PURPOSES ONLY AND DO NOT REPRESENT SURVEYED LINE INFORMATION.
4. SLOPES OF 30' OR GREATER EXIST. CONSTRUCTION FOR STEEP SLOPES TO BE PERFORMED USING STEEP SLOPE TECHNIQUES IDENTIFIED IN THE DETAIL SHEETS. ALSO REFER TO THE SITE-SPECIFIC DESIGN OF STABILIZATION MEASURES IN SELECTED HIGH-HAZARD PORTIONS OF THE ROUTE OF THE PROPOSED MOUNTAIN VALLEY PIPLELINE PROJECT.
5. WHERE CONSTRUCTION CONDITIONS PRECLUDE THE USE OF DIVERSION DITCHES DUE TO SITE CONDITIONS THE CONTRACTOR WILL INSTALL SILT FENCE AT THE DIRECTION OF MVP.
6. IMPROVEMENTS TO PERMANENT AND TEMPORARY ACCESS ROADS WILL BE PERFORMED PER THE SITE SPECIFIC ACCESS ROAD DETAILS.
7. TEMPORARY ACCESS ROAD CROSSING OF STREAMS AND WETLANDS WILL UTILIZE TIMBERMATS. ANY PERMANENT ROAD CROSSINGS WILL BE CONDUCTED VIA CULVERTS.
8. ALL NON VMRC STREAM CROSSINGS WILL BE PERFORMED AS DESCRIBED IN THE STREAM CROSSING TABLE INCLUDED IN THIS PACKAGE.

NO.:	DATE:	DWN.:	CHKD.:	APPD.:	DESCRIPTION:
5	03/04/18	KAL	RE	DW	ADDRESS VADEQ COMMENTS
4	02/27/18	KAL	RE	DW	ADDRESS VADEQ COMMENTS
3	02/05/18	KAL	RE	DW	ADDRESS VADEQ COMMENTS
2	11/21/17	KAL	RE	DW	ADDRESS VADEQ COMMENTS
1	09/21/17	KAL	RE	DW	PLAN SUBMISSION

REVISIONS:

Mountain Valley PIPELINE

EROSION AND SEDIMENT CONTROL PLANS

MOUNTAIN VALLEY PIPELINE PROJECT – H600 LINE

SPREAD 10 – ROANOKE COUNTY, VIRGINIA

TETRA TECH

complex world | CLEAR SOLUTIONS™


661 ANDERSEN DRIVE
FOSTER PLAZA 7
PITTSBURGH, PA 15220

EROSION AND SEDIMENT CONTROL PLANS




DRAWN BY:	KAL
CHECKED BY:	RE
APPROVED BY:	DW
DATE:	03/04/2018
SCALE:	AS SHOWN
REVISION	5
SHT. NO.	14.63ES OF 14.81ES

TETRA TECH CAD FILE PATH: X:\CADD_Pittsburgh\EQT\7157 – MVP\14 – Roanoke\E&S\E&S VERSION 5.0.0\7157ES14.63(S10).dwg PLOTTED ON: 3/2/2018 4:52 PM PLOTTED BY: Zeigler, Justin PLOT FILE: ENVIRONMENTAL_COLOR.ctb

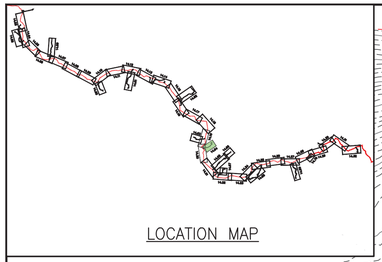

LOCATION MAP

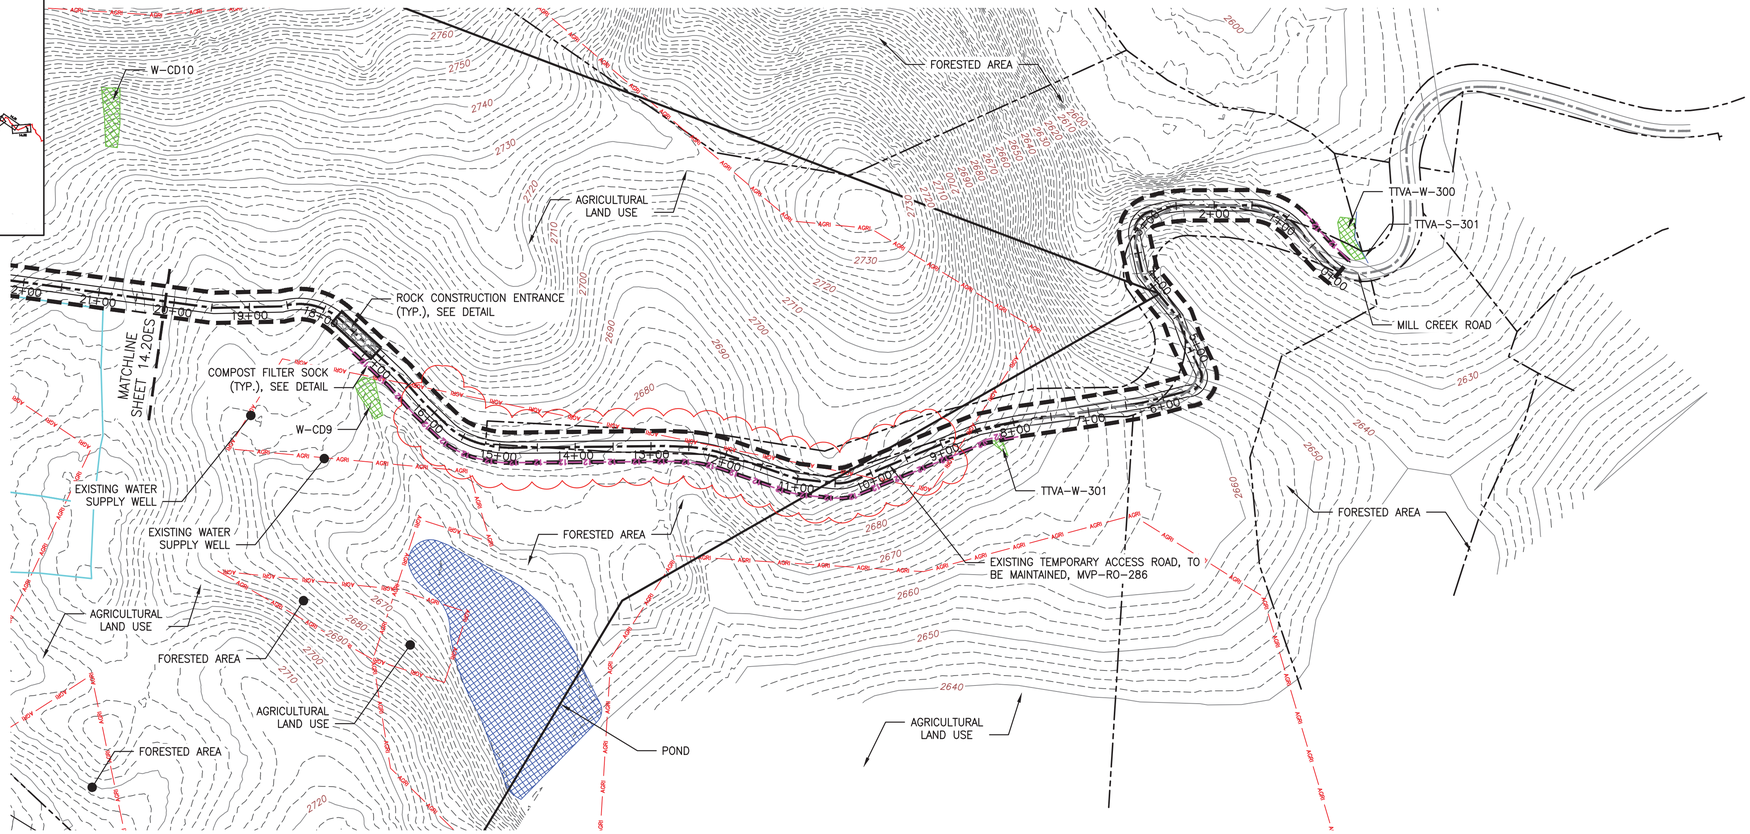

PLAN

SCALE: 1" = 100'

100 0 100 200

LEGEND

- PROPOSED LIMIT OF DISTURBANCE
- STREAM
- USDA FOREST SERVICE (NATIONAL FOREST) LANDS
- ANST — ANST — APPALACHIAN NATIONAL SCENIC TRAIL
- EXISTING ROAD/TRAIL
- EXISTING PROPERTY LINE
- EXISTING STATE LINE
- EXISTING COUNTY LINE
- POND
- WETLAND
- AFM — AFM — ACID FORMING MATERIAL
- AGR — AGR — AGRICULTURAL LAND USE BOUNDARY
- PROPOSED ACCESS ROAD CENTERLINE
- PROPOSED PIPELINE
- SF — SF — PROPOSED SILT FENCE (SEE NOTE 5)
- SSF — SSF — PROPOSED SUPER SILT FENCE (SEE DETAIL MVP-ES9.2)
- RFD — RFD — PROPOSED REINFORCED FILTRATION DEVICE (SEE DETAILS MVP-ES9, 9.1, 9.2, 9.3)
- OCSF — ORANGE CONSTRUCTION SAFETY FENCE
- 12 — 12 — 12 — 12 — PROPOSED COMPOST FILTER SOCK (SEE DETAILS MVP-ES3, 3.1, 3.2)
- 18 — 18 — 18 — 18 — PROPOSED COMPOST FILTER SOCK (SEE DETAILS MVP-ES3, 3.1, 3.2)
- 24 — 24 — 24 — 24 — PROPOSED COMPOST FILTER SOCK (SEE DETAILS MVP-ES3, 3.1, 3.2)
- GRASS-LINED CHANNEL (SEE DETAIL MVP-ES39)
- CLEAN WATER DIVERSION PIPE
- CLEAN WATER DIVERSION DIKE (SEE DETAIL MVP-ES50 AND MVP-ES51)
- STREAM FLOW DIRECTION
- FEMA 100 YEAR FLOODPLAIN
- DRAINAGE AREA BOUNDARY
- TIMBER MAT (SEE DETAIL MVP-ES37)
- STEEP SLOPE EROSION CONTROL (SEE NOTE 2)
- STEEP SLOPE AREAS (SEE NOTE 4)
- PROPOSED ROCK CONSTRUCTION ENTRANCE
- PROPOSED TRENCH BREAKER (SEE DETAIL MVP-20)
- TEMPORARY ROW DIVERSION/WATER BAR (VADEQ STD & SPEC 3.11)
- PERMANENT SLOPE BREAKER/ROW DIVERSION/WATER BAR (SEE DETAILS MVP-17, ES38, AND SCHEDULE)

NOTES:

1. TOPSOIL SEGREGATION WILL BE PERFORMED IN ALL IMMEDIATE CONSTRUCTION AREAS OF THE PROJECT IN ACCORDANCE WITH DETAILS MVP-ES46.1 THROUGH MVP-ES46.3.
2. FLEXTERRA, EARTHGUARD OR EQUIVALENT MAY BE USED AS A SUBSTITUTE TO EROSION CONTROL BLANKET AS DIRECTED BY MVP.
3. CONTRACTOR IS RESPONSIBLE TO IDENTIFY ALL UTILITIES. THE UTILITY LINES SHOWN ON THE PLAN ARE FOR INFORMATIONAL PURPOSES ONLY AND DO NOT REPRESENT SURVEYED LINE INFORMATION.
4. SLOPES OF 30' OR GREATER EXIST. CONSTRUCTION FOR STEEP SLOPES TO BE PERFORMED USING STEEP SLOPE TECHNIQUES IDENTIFIED IN THE DETAIL SHEETS. ALSO REFER TO THE SITE-SPECIFIC DESIGN OF STABILIZATION MEASURES IN SELECTED HIGH-HAZARD PORTIONS OF THE ROUTE OF THE PROPOSED MOUNTAIN VALLEY PIPLELINE PROJECT.
5. WHERE CONSTRUCTION CONDITIONS PRECLUDE THE USE OF DIVERSION DITCHES DUE TO SITE CONDITIONS THE CONTRACTOR WILL INSTALL SILT FENCE AT THE DIRECTION OF MVP.
6. IMPROVEMENTS TO PERMANENT AND TEMPORARY ACCESS ROADS WILL BE PERFORMED PER THE SITE SPECIFIC ACCESS ROAD DETAILS.
7. TEMPORARY ACCESS ROAD CROSSING OF STREAMS AND WETLANDS WILL UTILIZE TIMBERMATS. ANY PERMANENT ROAD CROSSINGS WILL BE CONDUCTED VIA CULVERTS.
8. ALL NON VMRC STREAM CROSSINGS WILL BE PERFORMED AS DESCRIBED IN THE STREAM CROSSING TABLE INCLUDED IN THIS PACKAGE.

NO.:	DATE:	DWN.:	CHKD.:	APPD.:	DESCRIPTION:
5	03/04/18	KAL	RE	DW	ADDRESS VADEQ COMMENTS
4	02/27/18	KAL	RE	DW	ADDRESS VADEQ COMMENTS
3	02/05/18	KAL	RE	DW	ADDRESS VADEQ COMMENTS
2	11/21/17	KAL	RE	DW	ADDRESS VADEQ COMMENTS
1	09/21/17	KAL	RE	DW	PLAN SUBMISSION

REVISIONS:

Mountain Valley PIPELINE

EROSION AND SEDIMENT CONTROL PLANS

MOUNTAIN VALLEY PIPELINE PROJECT – H600 LINE

SPREAD 10 – ROANOKE COUNTY, VIRGINIA

MOUNTAIN VALLEY PIPELINE, LLC
555 SOUTHPOINTE BOULEVARD, SUITE 200
CANONSBURG, PA 15311

TETRA TECH
complex world | CLEAR SOLUTIONS™
661 ANDERSEN DRIVE
FOSTER PLAZA 7
PITTSBURGH, PA 15220

EROSION AND SEDIMENT CONTROL PLANS


COMMONWEALTH OF VIRGINIA
DAVID J. WALLNER
Lic. No. 0402057593
PROFESSIONAL ENGINEER

DRAWN BY:	KAL
CHECKED BY:	RE
APPROVED BY:	DW
DATE:	03/04/2018
SCALE:	AS SHOWN

REVISION

SHT. NO. 14.64ES OF 14.81ES

TETRA TECH CAD FILE PATH: X:\CADD_Pittsburgh\EQT\7157 – MVP\14 – Roanoke\E&S\E&S VERSION 5.0.0\7157ES14.64(S10).dwg PLOTTED ON: 3/2/2018 4:53 PM PLOTTED BY: Zeigler, Justin PLOT FILE: ENVIRONMENTAL_COLOR.ctb

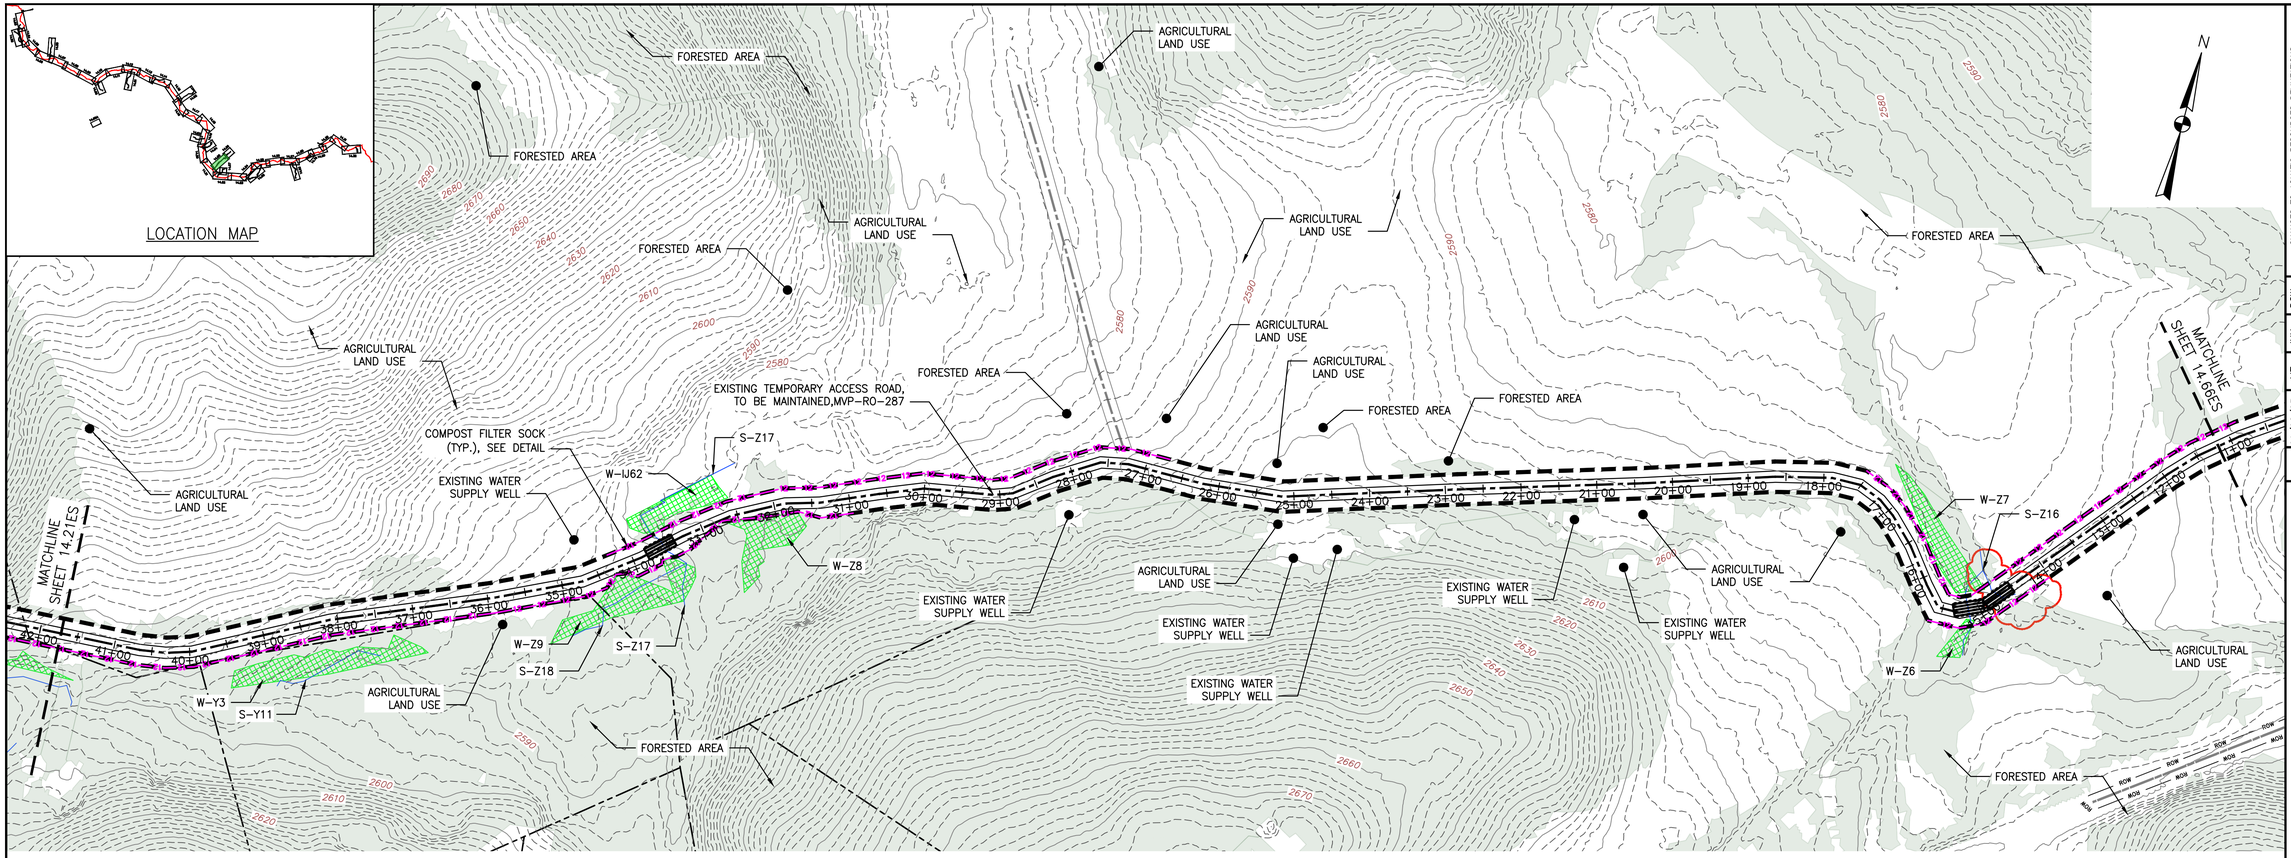

PLAN

SCALE: 1" = 100'

100 0 100 200

COMMONWEALTH OF VIRGINIA
9/8/23
DANIEL C. WITT
Lic. No. 65093
PROFESSIONAL ENGINEER

THIS SEAL ONLY APPLIES TO REVISION DATED 09-08-2023

LEGEND

- PROPOSED LIMIT OF DISTURBANCE
- STREAM
- USDA FOREST SERVICE (NATIONAL FOREST) LANDS
- APPALACHIAN NATIONAL SCENIC TRAIL
- EXISTING ROAD/TRAIL
- EXISTING PROPERTY LINE
- EXISTING STATE LINE
- EXISTING COUNTY LINE
- POND
- WETLAND
- ACID FORMING MATERIAL
- EXISTING FOREST
- PROPOSED ACCESS ROAD CENTERLINE
- PROPOSED PIPELINE
- PROPOSED SILT FENCE (SEE NOTE 5)
- PROPOSED SUPER SILT FENCE (SEE DETAIL MVP-ES9.2)
- PROPOSED REINFORCED FILTRATION DEVICE (SEE DETAILS MVP-ES9, 9.1, 9.2, 9.3)
- ORANGE CONSTRUCTION SAFETY FENCE
- PROPOSED COMPOST FILTER SOCK (SEE DETAILS MVP-ES3, 3.1, 3.2)
- PROPOSED COMPOST FILTER SOCK (SEE DETAILS MVP-ES3, 3.1, 3.2)
- PROPOSED COMPOST FILTER SOCK (SEE DETAILS MVP-ES3, 3.1, 3.2)
- GRASS-LINED CHANNEL (SEE DETAIL MVP-ES39)
- CLEAN WATER DIVERSION PIPE
- CLEAN WATER DIVERSION DIKE (SEE DETAIL MVP-ES50 AND MVP-ES51)
- STREAM FLOW DIRECTION
- FEMA 100 YEAR FLOODPLAIN
- DRAINAGE AREA BOUNDARY
- TIMBER MAT (SEE DETAIL MVP-ES37)
- STEEP SLOPE EROSION CONTROL (SEE NOTE 2)
- STEEP SLOPE AREAS (SEE NOTE 4)
- PROPOSED ROCK CONSTRUCTION ENTRANCE
- PROPOSED TRENCH BREAKER (SEE DETAIL MVP-20)
- TEMPORARY ROW DIVERSION/WATER BAR (SEE DETAIL MP-17)
- PERMANENT SLOPE BREAKER/ROW DIVERSION/WATER BAR (SEE DETAIL MVP-17)

NOTES:

1. TOPSOIL SEGREGATION WILL BE PERFORMED IN ALL IMMEDIATE CONSTRUCTION AREAS OF THE PROJECT IN ACCORDANCE WITH DETAILS MVP-ES46.1 THROUGH MVP-ES46.3.
2. FLEXTERRA, EARTHGUARD OR EQUIVALENT MAY BE USED AS A SUBSTITUTE TO EROSION CONTROL BLANKET AS DIRECTED BY MVP.
3. CONTRACTOR IS RESPONSIBLE TO IDENTIFY ALL UTILITIES. THE UTILITY LINES SHOWN ON THE PLAN ARE FOR INFORMATIONAL PURPOSES ONLY AND DO NOT REPRESENT SURVEYED LINE INFORMATION.
4. SLOPES OF 30° OR GREATER EXIST. CONSTRUCTION FOR STEEP SLOPES TO BE PERFORMED USING STEEP SLOPE TECHNIQUES IDENTIFIED IN THE DETAIL SHEETS. ALSO REFER TO THE SITE-SPECIFIC DESIGN OF STABILIZATION MEASURES IN SELECTED HIGH-HAZARD PORTIONS OF THE ROUTE OF THE PROPOSED MOUNTAIN VALLEY PIPLELINE PROJECT.
5. WHERE CONSTRUCTION CONDITIONS PRECLUDE THE USE OF DIVERSION DITCHES DUE TO SITE CONDITIONS THE CONTRACTOR WILL INSTALL SILT FENCE AT THE DIRECTION OF MVP.
6. IMPROVEMENTS TO PERMANENT AND TEMPORARY ACCESS ROADS WILL BE PERFORMED PER THE SITE SPECIFIC ACCESS ROAD DETAILS.
7. TEMPORARY ACCESS ROAD CROSSING OF STREAMS AND WETLANDS WILL UTILIZE TIMBERMATS. ANY PERMANENT ROAD CROSSINGS WILL BE CONDUCTED VIA CULVERTS.
8. ALL NON VMRC STREAM CROSSINGS WILL BE PERFORMED AS DESCRIBED IN THE STREAM CROSSING TABLE INCLUDED IN THIS PACKAGE.

TETRA TECH CAD FILE PATH: X:\CADD_Pittsburgh\EQT\7157 - MVP\14 - Roanoke\E&S\E&S VERSION 5.0.0\7157ES14.65(S10).dwg PLOTTED ON: 9/7/2023 10:30 AM PLOTTED BY: Zeigler, Justin PLOT FILE: ENVIRONMENTAL_COLOR.ctb

NO.:	DATE:	DWN.:	CHKD.:	APPD.:	DESCRIPTION:
–	09/08/23	JJZ	IHH	DCW	CHANGES TO AQUATIC RESOURCES DELINEATIONS
5	03/04/18	KAL	RE	DW	ADDRESS VADEQ COMMENTS
4	02/27/17	KAL	RE	DW	ADDRESS VADEQ COMMENTS
3	02/05/18	KAL	RE	DW	ADDRESS VADEQ COMMENTS
2	11/21/17	KAL	RE	DW	ADDRESS VADEQ COMMENTS
1	09/21/17	KAL	RE	DW	ADDRESS VADEQ COMMENTS

REVISIONS:

Mountain Valley PIPELINE

EROSION AND SEDIMENT CONTROL PLANS

MOUNTAIN VALLEY PIPELINE PROJECT – H600 LINE

SPREAD 10 – ROANOKE COUNTY, VIRGINIA

MOUNTAIN VALLEY PIPELINE, LLC
2200 ENERGY DRIVE
CANONSBURG, PA 15311


TETRA TECH
complex world | CLEAR SOLUTIONS™
661 ANDERSEN DRIVE
FOSTER PLAZA 7
PITTSBURGH, PA 15220

EROSION AND SEDIMENT CONTROL PLANS


COMMONWEALTH OF VIRGINIA
DAVID J. WALLNER
Lic. No. 0402057593
PROFESSIONAL ENGINEER

DRAWN BY:	JZ
CHECKED BY:	IHH
APPROVED BY:	DCW
DATE:	09/08/2023
SCALE:	AS SHOWN
	– REVISION

SHT. NO. 14.65ES OF 14.81ES

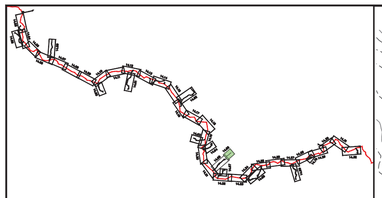

LOCATION MAP

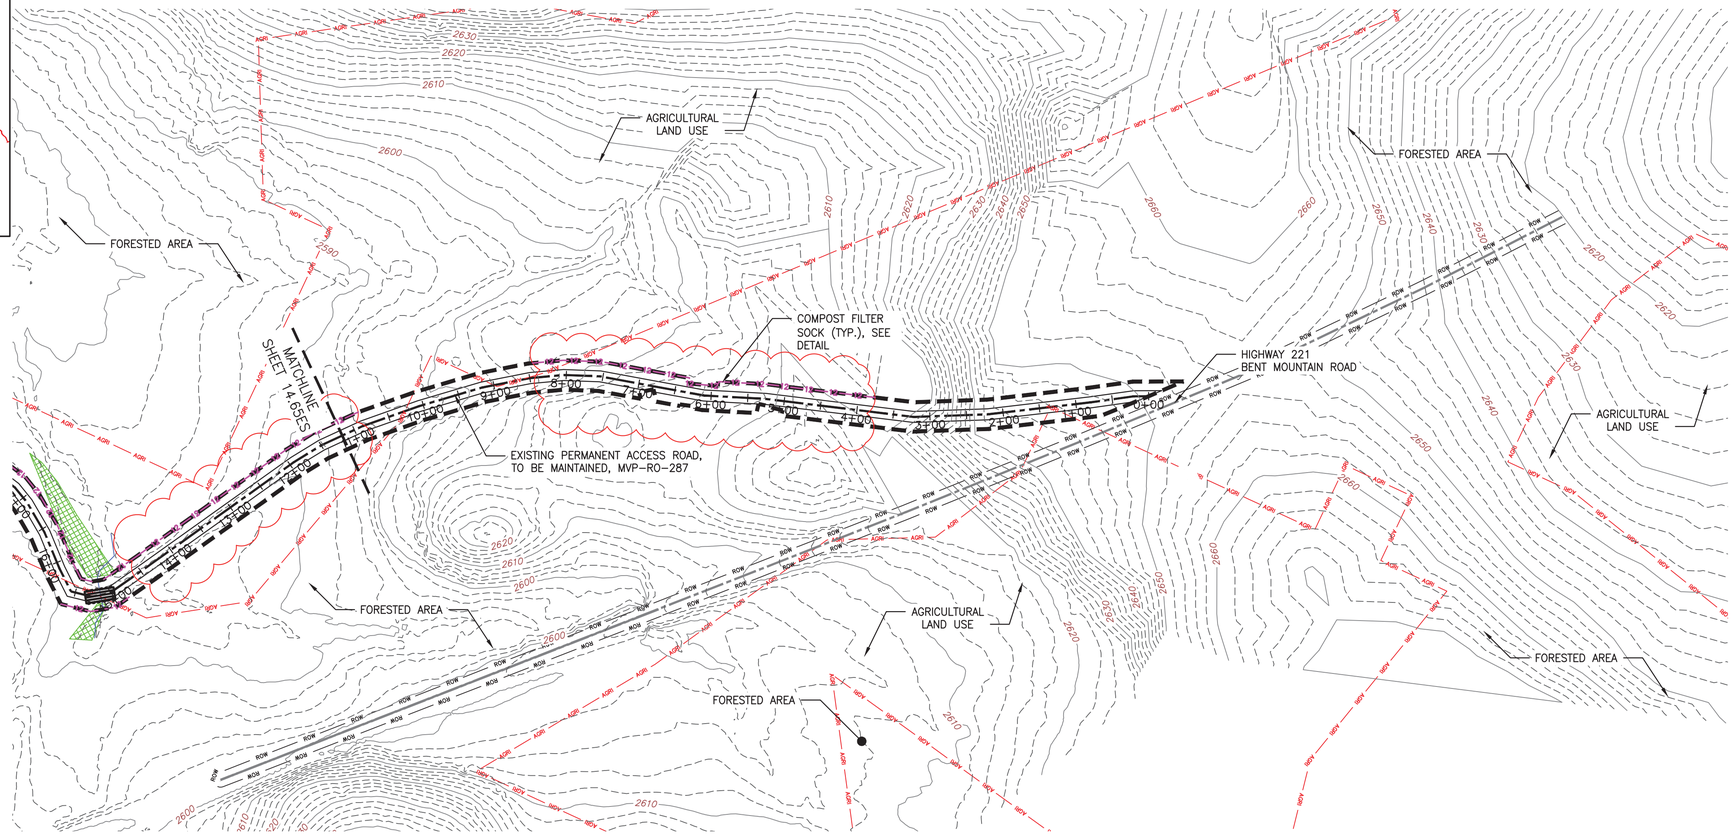

PLAN

SCALE: 1" = 100'

100 0 100 200

LEGEND

- PROPOSED LIMIT OF DISTURBANCE
- STREAM
- USDA FOREST SERVICE (NATIONAL FOREST) LANDS
- ANST — ANST — APPALACHIAN NATIONAL SCENIC TRAIL
- EXISTING ROAD/TRAIL
- EXISTING PROPERTY LINE
- EXISTING STATE LINE
- EXISTING COUNTY LINE
- POND
- WETLAND
- AFM — AFM — ACID FORMING MATERIAL
- AGR — AGR — AGRICULTURAL LAND USE BOUNDARY
- PROPOSED ACCESS ROAD CENTERLINE
- PROPOSED PIPELINE
- SF — SF — PROPOSED SILT FENCE (SEE NOTE 5)
- SSF — SSF — PROPOSED SUPER SILT FENCE (SEE DETAIL MVP-ES9.2)
- RFD — RFD — PROPOSED REINFORCED FILTRATION DEVICE (SEE DETAILS MVP-ES9, 9.1, 9.2, 9.3)
- OCSF — ORANGE CONSTRUCTION SAFETY FENCE
- 12 — 12 — 12 — 12 — PROPOSED COMPOST FILTER SOCK (SEE DETAILS MVP-ES3, 3.1, 3.2)
- 18 — 18 — 18 — 18 — PROPOSED COMPOST FILTER SOCK (SEE DETAILS MVP-ES3, 3.1, 3.2)
- 24 — 24 — 24 — 24 — PROPOSED COMPOST FILTER SOCK (SEE DETAILS MVP-ES3, 3.1, 3.2)
- GRASS-LINED CHANNEL (SEE DETAIL MVP-ES39)
- CLEAN WATER DIVERSION PIPE
- CLEAN WATER DIVERSION DIKE (SEE DETAIL MVP-ES50 AND MVP-ES51)
- STREAM FLOW DIRECTION
- FEMA 100 YEAR FLOODPLAIN
- DRAINAGE AREA BOUNDARY
- TIMBER MAT (SEE DETAIL MVP-ES37)
- STEEP SLOPE EROSION CONTROL (SEE NOTE 2)
- STEEP SLOPE AREAS (SEE NOTE 4)
- PROPOSED ROCK CONSTRUCTION ENTRANCE
- PROPOSED TRENCH BREAKER (SEE DETAIL MVP-20)
- TEMPORARY ROW DIVERSION/WATER BAR (VADEQ STD & SPEC 3.11)
- PERMANENT SLOPE BREAKER/ROW DIVERSION/WATER BAR (SEE DETAILS MVP-17, ES38, AND SCHEDULE)

NOTES:

1. TOPSOIL SEGREGATION WILL BE PERFORMED IN ALL IMMEDIATE CONSTRUCTION AREAS OF THE PROJECT IN ACCORDANCE WITH DETAILS MVP-ES46.1 THROUGH MVP-ES46.3.
2. FLEXTERRA, EARTHGUARD OR EQUIVALENT MAY BE USED AS A SUBSTITUTE TO EROSION CONTROL BLANKET AS DIRECTED BY MVP.
3. CONTRACTOR IS RESPONSIBLE TO IDENTIFY ALL UTILITIES. THE UTILITY LINES SHOWN ON THE PLAN ARE FOR INFORMATIONAL PURPOSES ONLY AND DO NOT REPRESENT SURVEYED LINE INFORMATION.
4. SLOPES OF 30' OR GREATER EXIST. CONSTRUCTION FOR STEEP SLOPES TO BE PERFORMED USING STEEP SLOPE TECHNIQUES IDENTIFIED IN THE DETAIL SHEETS. ALSO REFER TO THE SITE-SPECIFIC DESIGN OF STABILIZATION MEASURES IN SELECTED HIGH-HAZARD PORTIONS OF THE ROUTE OF THE PROPOSED MOUNTAIN VALLEY PIPELINE PROJECT.
5. WHERE CONSTRUCTION CONDITIONS PRECLUDE THE USE OF DIVERSION DITCHES DUE TO SITE CONDITIONS THE CONTRACTOR WILL INSTALL SILT FENCE AT THE DIRECTION OF MVP.
6. IMPROVEMENTS TO PERMANENT AND TEMPORARY ACCESS ROADS WILL BE PERFORMED PER THE SITE SPECIFIC ACCESS ROAD DETAILS.
7. TEMPORARY ACCESS ROAD CROSSING OF STREAMS AND WETLANDS WILL UTILIZE TIMBERMATS. ANY PERMANENT ROAD CROSSINGS WILL BE CONDUCTED VIA CULVERTS.
8. ALL NON VMRC STREAM CROSSINGS WILL BE PERFORMED AS DESCRIBED IN THE STREAM CROSSING TABLE INCLUDED IN THIS PACKAGE.

NO.:	DATE:	DWN.:	CHKD.:	APPD.:	DESCRIPTION:
5	03/04/18	KAL	RE	DW	ADDRESS VADEQ COMMENTS
4	02/27/18	KAL	RE	DW	ADDRESS VADEQ COMMENTS
3	02/05/18	KAL	RE	DW	ADDRESS VADEQ COMMENTS
2	11/21/17	KAL	RE	DW	ADDRESS VADEQ COMMENTS
1	09/21/17	KAL	RE	DW	PLAN SUBMISSION

REVISIONS:

Mountain Valley PIPELINE

EROSION AND SEDIMENT CONTROL PLANS

MOUNTAIN VALLEY PIPELINE PROJECT – H600 LINE

SPREAD 10 – ROANOKE COUNTY, VIRGINIA

MOUNTAIN VALLEY PIPELINE, LLC
555 SOUTHPOINTE BOULEVARD, SUITE 200
CANONSBURG, PA 15311

TETRA TECH
complex world | CLEAR SOLUTIONS™
661 ANDERSEN DRIVE
FOSTER PLAZA 7
PITTSBURGH, PA 15220


EROSION AND SEDIMENT CONTROL PLANS

COMMONWEALTH OF VIRGINIA
DAVID J. WALLNER
Lic. No. 0402057593
PROFESSIONAL ENGINEER


DRAWN BY:	KAL
CHECKED BY:	RE
APPROVED BY:	DW
DATE:	03/04/2018
SCALE:	AS SHOWN
REVISION	5

SHT. NO. 14.66ES OF 14.81ES

TETRA TECH CAD FILE PATH: X:\CADD_Pittsburgh\EQT\7157 – MVP\14 – Roanoke\E&S\E&S VERSION 5.0.0\7157ES14.66(S10).dwg PLOTTED ON: 3/2/2018 4:54 PM PLOTTED BY: Zeigler, Justin PLOT FILE: ENVIRONMENTAL_COLOR.ctb

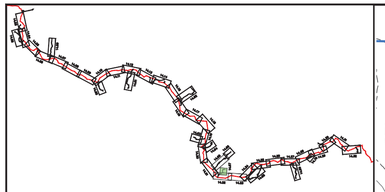

LOCATION MAP

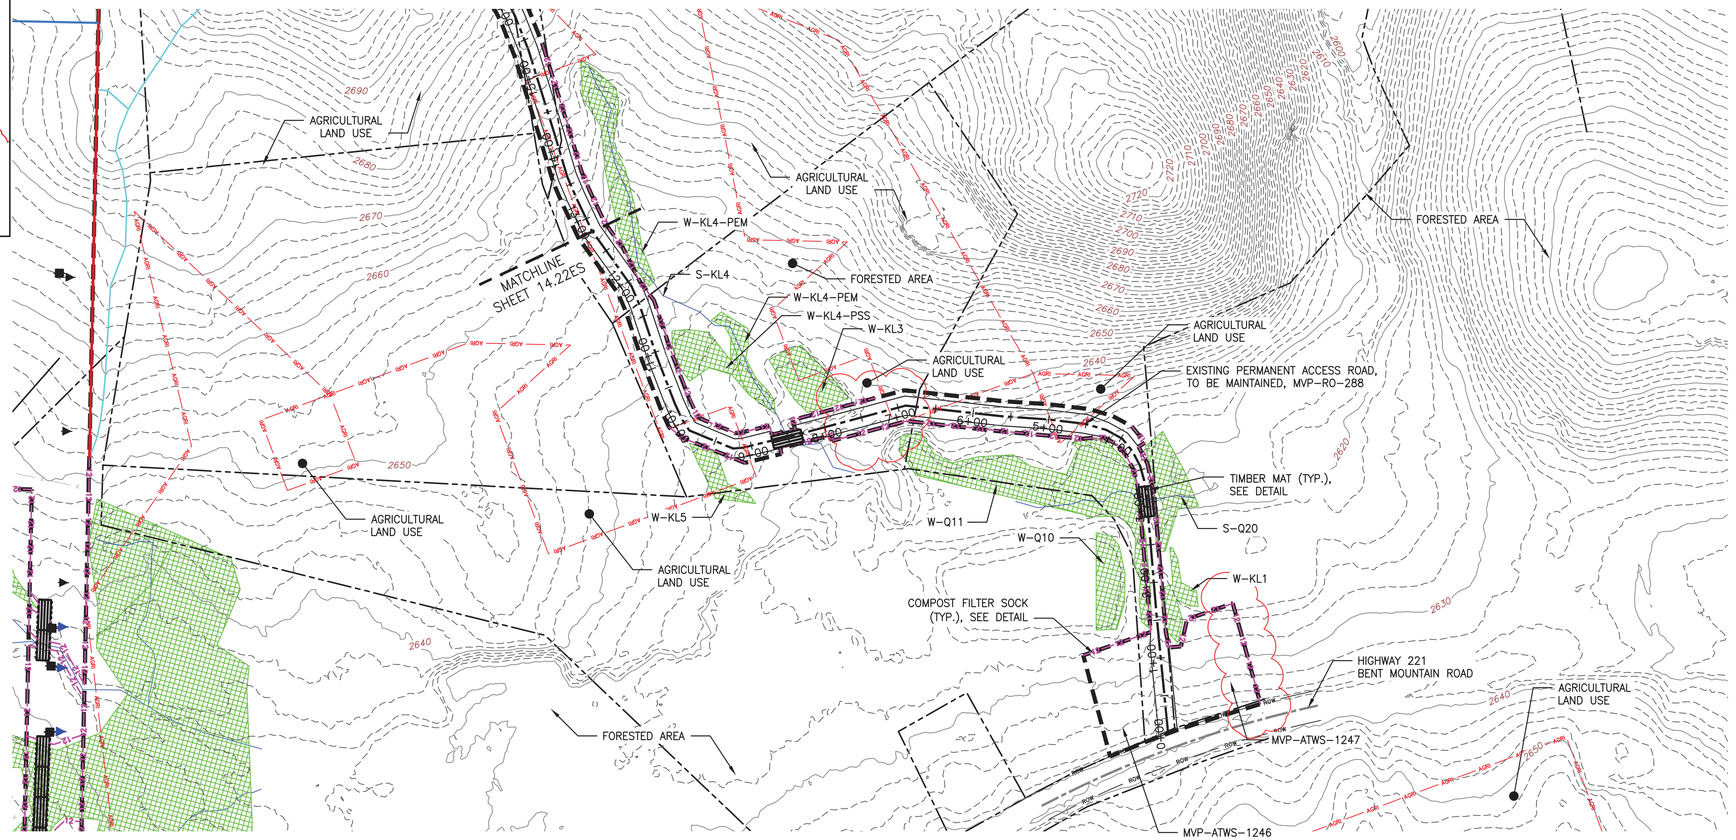

PLAN
SCALE: 1" = 100'
100 0 100 200

LEGEND

- PROPOSED LIMIT OF DISTURBANCE
- STREAM
- USDA FOREST SERVICE (NATIONAL FOREST) LANDS
- ANST — ANST — APPALACHIAN NATIONAL SCENIC TRAIL
- EXISTING ROAD/TRAIL
- EXISTING PROPERTY LINE
- EXISTING STATE LINE
- EXISTING COUNTY LINE
- POND
- WETLAND
- AFM — AFM — ACID FORMING MATERIAL
- AGR — AGR — AGRICULTURAL LAND USE BOUNDARY
- PROPOSED ACCESS ROAD CENTERLINE
- PROPOSED PIPELINE
- SF — SF — PROPOSED SILT FENCE (SEE NOTE 5)
- SSF — SSF — PROPOSED SUPER SILT FENCE (SEE DETAIL MVP-ES9.2)
- RFD — RFD — PROPOSED REINFORCED FILTRATION DEVICE (SEE DETAILS MVP-ES9, 9.1, 9.2, 9.3)
- OCSF — ORANGE CONSTRUCTION SAFETY FENCE
- 12 — 12 — 12 — 12 — PROPOSED COMPOST FILTER SOCK (SEE DETAILS MVP-ES3, 3.1, 3.2)
- 18 — 18 — 18 — 18 — PROPOSED COMPOST FILTER SOCK (SEE DETAILS MVP-ES3, 3.1, 3.2)
- 24 — 24 — 24 — 24 — PROPOSED COMPOST FILTER SOCK (SEE DETAILS MVP-ES3, 3.1, 3.2)
- GRASS-LINED CHANNEL (SEE DETAIL MVP-ES39)
- CLEAN WATER DIVERSION PIPE
- CLEAN WATER DIVERSION DIKE (SEE DETAIL MVP-ES50 AND MVP-ES51)
- STREAM FLOW DIRECTION
- FEMA 100 YEAR FLOODPLAIN
- DRAINAGE AREA BOUNDARY
- TIMBER MAT (SEE DETAIL MVP-ES37)
- STEEP SLOPE EROSION CONTROL (SEE NOTE 2)
- STEEP SLOPE AREAS (SEE NOTE 4)
- PROPOSED ROCK CONSTRUCTION ENTRANCE
- PROPOSED TRENCH BREAKER (SEE DETAIL MVP-20)
- TEMPORARY ROW DIVERSION/WATER BAR (VADEQ STD & SPEC 3.11)
- PERMANENT SLOPE BREAKER/ROW DIVERSION/WATER BAR (SEE DETAILS MVP-17, ES38, AND SCHEDULE)

NOTES:

1. TOPSOIL SEGREGATION WILL BE PERFORMED IN ALL IMMEDIATE CONSTRUCTION AREAS OF THE PROJECT IN ACCORDANCE WITH DETAILS MVP-ES46.1 THROUGH MVP-ES46.3.
2. FLEXTERRA, EARTHGUARD OR EQUIVALENT MAY BE USED AS A SUBSTITUTE TO EROSION CONTROL BLANKET AS DIRECTED BY MVP.
3. CONTRACTOR IS RESPONSIBLE TO IDENTIFY ALL UTILITIES. THE UTILITY LINES SHOWN ON THE PLAN ARE FOR INFORMATIONAL PURPOSES ONLY AND DO NOT REPRESENT SURVEYED LINE INFORMATION.
4. SLOPES OF 30° OR GREATER EXIST. CONSTRUCTION FOR STEEP SLOPES TO BE PERFORMED USING STEEP SLOPE TECHNIQUES IDENTIFIED IN THE DETAIL SHEETS. ALSO REFER TO THE SITE-SPECIFIC DESIGN OF STABILIZATION MEASURES IN SELECTED HIGH-HAZARD PORTIONS OF THE ROUTE OF THE PROPOSED MOUNTAIN VALLEY PIPELINE PROJECT.
5. WHERE CONSTRUCTION CONDITIONS PRECLUDE THE USE OF DIVERSION DITCHES DUE TO SITE CONDITIONS THE CONTRACTOR WILL INSTALL SILT FENCE AT THE DIRECTION OF MVP.
6. IMPROVEMENTS TO PERMANENT AND TEMPORARY ACCESS ROADS WILL BE PERFORMED PER THE SITE SPECIFIC ACCESS ROAD DETAILS.
7. TEMPORARY ACCESS ROAD CROSSING OF STREAMS AND WETLANDS WILL UTILIZE TIMBERMATS. ANY PERMANENT ROAD CROSSINGS WILL BE CONDUCTED VIA CULVERTS.
8. ALL NON VMRC STREAM CROSSINGS WILL BE PERFORMED AS DESCRIBED IN THE STREAM CROSSING TABLE INCLUDED IN THIS PACKAGE.

TETRA TECH CAD FILE PATH: X:\CADD_Pittsburgh\EQT\7157 - MVP\14 - Roanoke\E&S\E&S VERSION 5.0.0\7157ES14.67(S10).dwg PLOTTED ON: 3/2/2018 4:55 PM PLOTTED BY: Zeigler, Justin PLOT FILE: ENVIRONMENTAL_COLOR.ctb

NO.:	DATE:	DWN.:	CHKD.:	APPD.:	DESCRIPTION:
5	03/04/18	KAL	RE	DW	ADDRESS VADEQ COMMENTS
4	02/27/18	KAL	RE	DW	ADDRESS VADEQ COMMENTS
3	02/05/18	KAL	RE	DW	ADDRESS VADEQ COMMENTS
2	11/21/17	KAL	RE	DW	ADDRESS VADEQ COMMENTS
1	09/21/17	KAL	RE	DW	PLAN SUBMISSION

REVISIONS:

Mountain Valley PIPELINE

EROSION AND SEDIMENT CONTROL PLANS

MOUNTAIN VALLEY PIPELINE PROJECT - H600 LINE

SPREAD 10 - ROANOKE COUNTY, VIRGINIA

MOUNTAIN VALLEY PIPELINE, LLC
555 SOUTHPOINTE BOULEVARD, SUITE 200
CANONSBURG, PA 15311

TETRA TECH
complex world | CLEAR SOLUTIONS™
661 ANDERSEN DRIVE
FOSTER PLAZA 7
PITTSBURGH, PA 15220


EROSION AND SEDIMENT CONTROL PLANS

COMMONWEALTH OF VIRGINIA
DAVID J. WALLNER
Lic. No. 0402057593
PROFESSIONAL ENGINEER

DRAWN BY:	KAL
CHECKED BY:	RE
APPROVED BY:	DW
DATE:	03/04/2018
SCALE:	AS SHOWN

REVISION

SHT. NO. 14.67ES OF 14.81ES

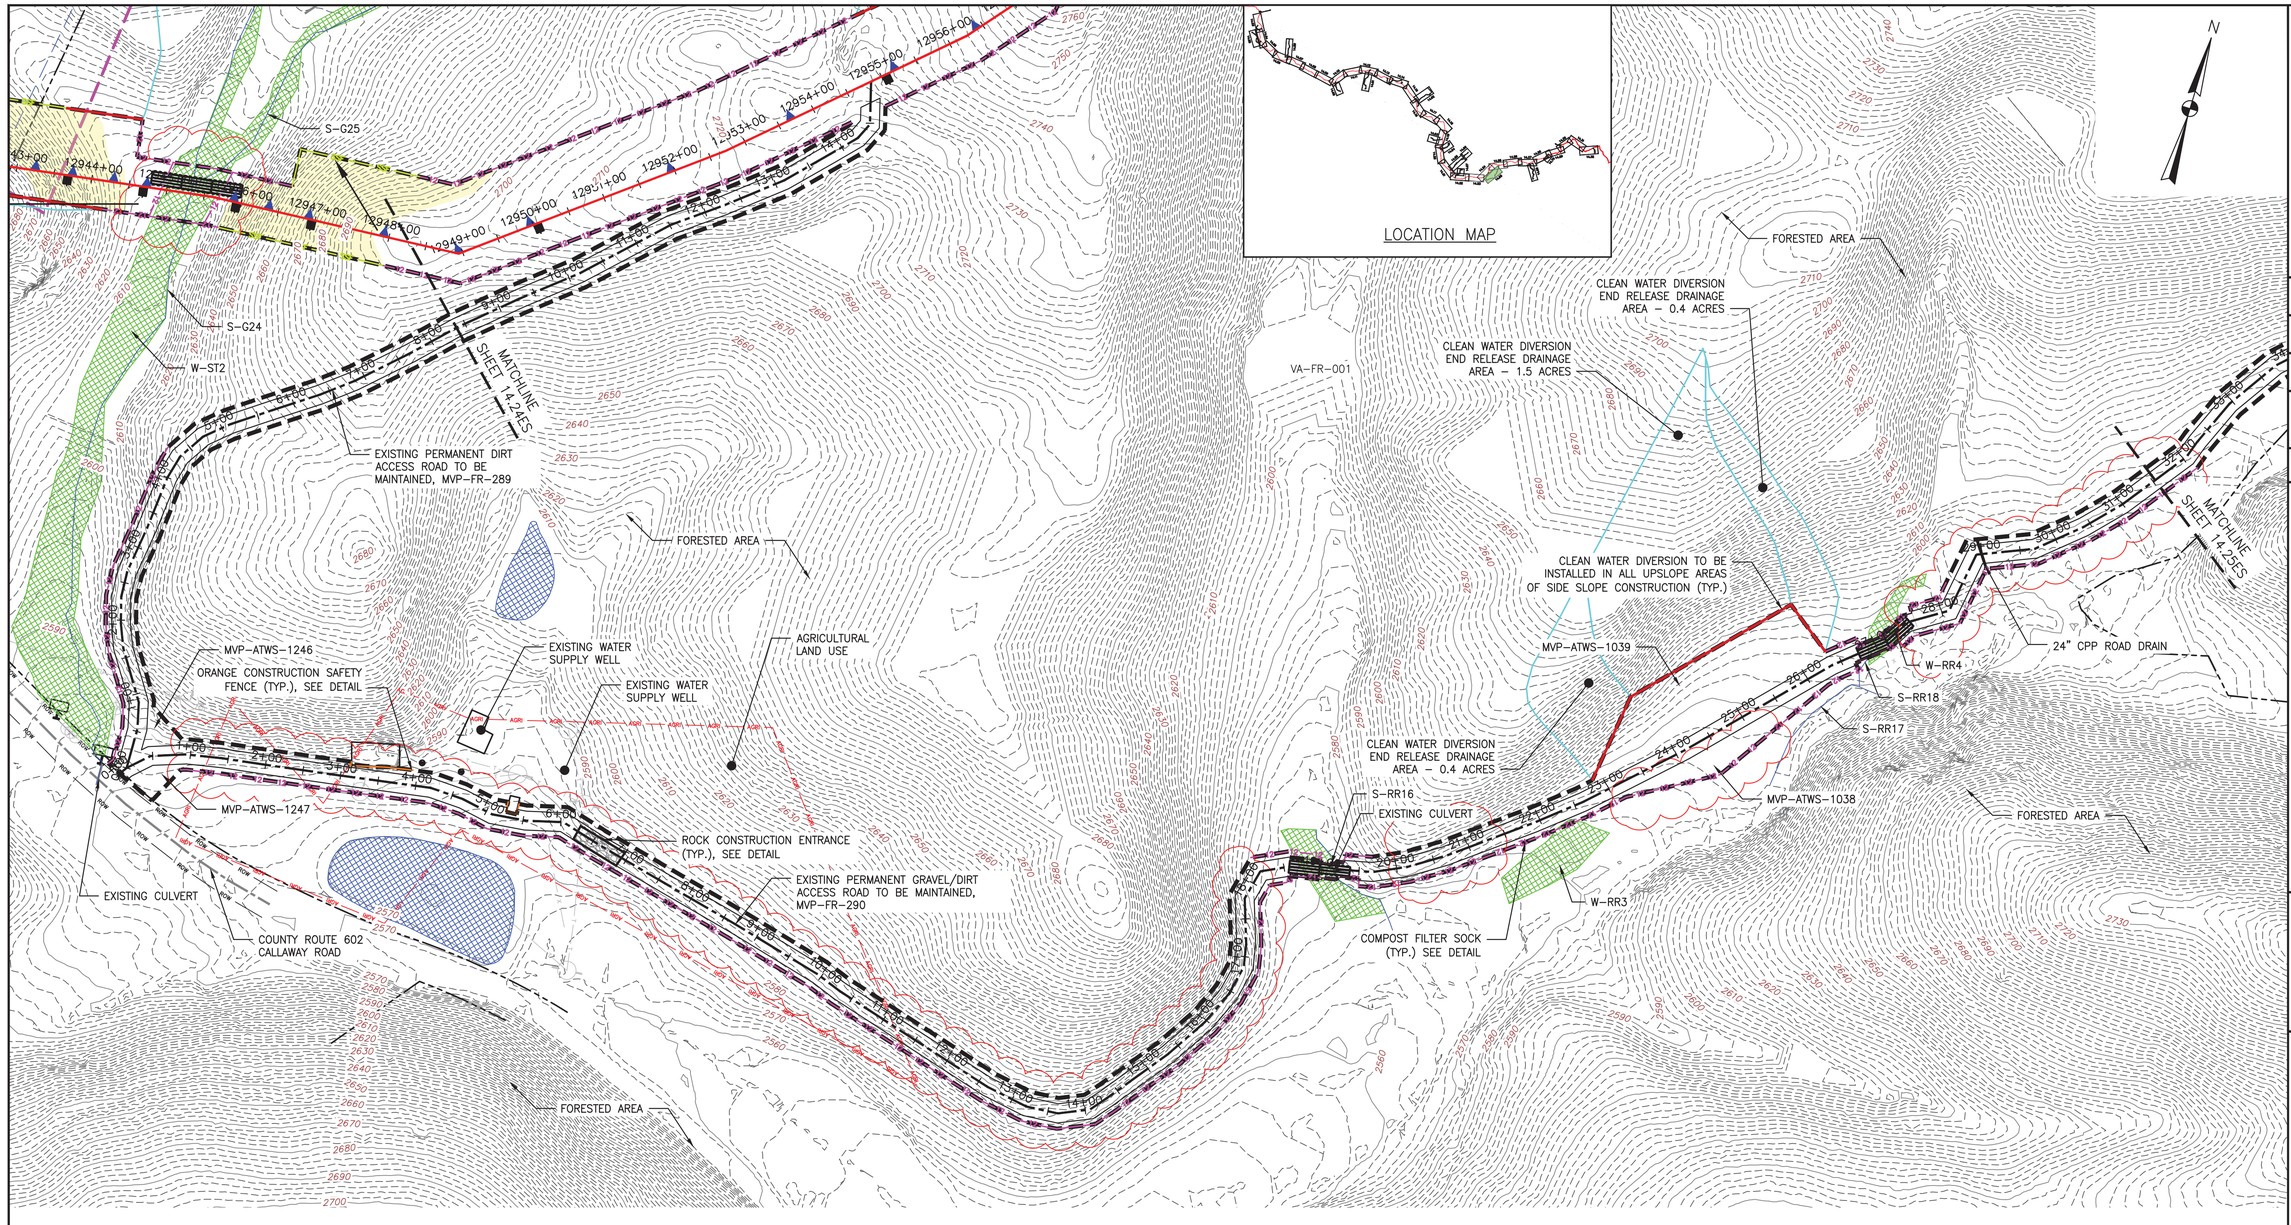

LEGEND

- PROPOSED LIMIT OF DISTURBANCE
- STREAM
- USDA FOREST SERVICE (NATIONAL FOREST) LANDS
- APPALACHIAN NATIONAL SCENIC TRAIL
- EXISTING ROAD/TRAIL
- EXISTING PROPERTY LINE
- EXISTING STATE LINE
- EXISTING COUNTY LINE
- POND
- WETLAND
- ACID FORMING MATERIAL
- AGRICULTURAL LAND USE BOUNDARY
- PROPOSED ACCESS ROAD CENTERLINE
- PROPOSED PIPELINE
- PROPOSED SILT FENCE (SEE NOTE 5)
- PROPOSED SUPER SILT FENCE (SEE DETAIL MVP-ES9.2)
- PROPOSED REINFORCED FILTRATION DEVICE (SEE DETAILS MVP-ES9, 9.1, 9.2, 9.3)
- ORANGE CONSTRUCTION SAFETY FENCE
- PROPOSED COMPOST FILTER SOCK (SEE DETAILS MVP-ES3, 3.1, 3.2)
- PROPOSED COMPOST FILTER SOCK (SEE DETAILS MVP-ES3, 3.1, 3.2)
- PROPOSED COMPOST FILTER SOCK (SEE DETAILS MVP-ES3, 3.1, 3.2)
- GRASS-LINED CHANNEL (SEE DETAIL MVP-ES39)
- CLEAN WATER DIVERSION PIPE
- CLEAN WATER DIVERSION DIKE (SEE DETAIL MVP-ES50 AND MVP-ES51)

PLAN

SCALE: 1" = 100'

100 0 100 200

- STREAM FLOW DIRECTION
- FEMA 100 YEAR FLOODPLAIN
- DRAINAGE AREA BOUNDARY
- TIMBER MAT (SEE DETAIL MVP-ES37)
- STEEP SLOPE EROSION CONTROL (SEE NOTE 2)
- STEEP SLOPE AREAS (SEE NOTE 4)
- PROPOSED ROCK CONSTRUCTION ENTRANCE
- PROPOSED TRENCH BREAKER (SEE DETAIL MVP-20)
- TEMPORARY ROW DIVERSION/WATER BAR (VADEQ STD & SPEC 3.11)
- PERMANENT SLOPE BREAKER/ROW DIVERSION/WATER BAR (SEE DETAILS MVP-17, ES38, AND SCHEDULE)

NOTES:

1. TOPSOIL SEGREGATION WILL BE PERFORMED IN ALL IMMEDIATE CONSTRUCTION AREAS OF THE PROJECT IN ACCORDANCE WITH DETAILS MVP-ES46.1 THROUGH MVP-ES46.3.
2. FLEXTERRA, EARTHGUARD OR EQUIVALENT MAY BE USED AS A SUBSTITUTE TO EROSION CONTROL BLANKET AS DIRECTED BY MVP.
3. CONTRACTOR IS RESPONSIBLE TO IDENTIFY ALL UTILITIES. THE UTILITY LINES SHOWN ON THE PLAN ARE FOR INFORMATIONAL PURPOSES ONLY AND DO NOT REPRESENT SURVEYED LINE INFORMATION.
4. SLOPES OF 30% OR GREATER EXIST. CONSTRUCTION FOR STEEP SLOPES TO BE PERFORMED USING STEEP SLOPE TECHNIQUES IDENTIFIED IN THE DETAIL SHEETS. ALSO REFER TO THE SITE-SPECIFIC DESIGN OF STABILIZATION MEASURES IN SELECTED HIGH-HAZARD PORTIONS OF THE ROUTE OF THE PROPOSED MOUNTAIN VALLEY PIPELINE PROJECT.
5. WHERE CONSTRUCTION CONDITIONS PRECLUDE THE USE OF DIVERSION DITCHES DUE TO SITE CONDITIONS THE CONTRACTOR WILL INSTALL SILT FENCE AT THE DIRECTION OF MVP.
6. IMPROVEMENTS TO PERMANENT AND TEMPORARY ACCESS ROADS WILL BE PERFORMED PER THE SITE SPECIFIC ACCESS ROAD DETAILS.
7. TEMPORARY ACCESS ROAD CROSSING OF STREAMS AND WETLANDS WILL UTILIZE TIMBERMATS. ANY PERMANENT ROAD CROSSINGS WILL BE CONDUCTED VIA CULVERTS.
8. ALL NON VMRC STREAM CROSSINGS WILL BE PERFORMED AS DESCRIBED IN THE STREAM CROSSING TABLE INCLUDED IN THIS PACKAGE.

TETRA TECH CAD FILE PATH: X:\CADD_Pittsburgh\EQT\7157 - MVP\15 - Franklin\E&S\ES Version 5.0.0\7157ES14.68(S10).dwg PLOTTED ON: 3/2/2018 4:57 PM PLOTTED BY: Zeigler, Justin PLOT FILE: ENVIRONMENTAL_COLOR.ctb

NO.	DATE:	DWN.:	CHKD.:	APPD.:	DESCRIPTION:
5	03/04/18	KAL	RE	DW	ADDRESS VADEQ COMMENTS
4	02/27/18	KAL	RE	DW	ADDRESS VADEQ COMMENTS
3	02/05/18	KAL	RE	DW	ADDRESS VADEQ COMMENTS
2	11/21/17	KAL	RE	DW	ADDRESS VADEQ COMMENTS
1	09/21/17	KAL	RE	DW	PLAN SUBMISSION

REVISIONS:

Mountain Valley PIPELINE

EROSION AND SEDIMENT CONTROL PLANS

MOUNTAIN VALLEY PIPELINE PROJECT - H600 LINE

SPREAD 10 - FRANKLIN COUNTY, VIRGINIA

MOUNTAIN VALLEY PIPELINE, LLC
555 SOUTHPOINTE BOULEVARD, SUITE 200
CANONSBURG, PA 15317


TETRA TECH
complex world | CLEAR SOLUTIONS™
661 ANDERSEN DRIVE
FOSTER PLAZA 7
PITTSBURGH, PA 15220

EROSION AND SEDIMENT CONTROL PLANS

COMMONWEALTH OF VIRGINIA
DAVID J. WALLNER
Lic. No. 0402057593
PROFESSIONAL ENGINEER

DRAWN BY:	KAL
CHECKED BY:	RE
APPROVED BY:	DW
DATE:	03/04/2018
SCALE:	AS SHOWN
REVISION	5

SHT. NO. 14.68ES OF 14.81ES

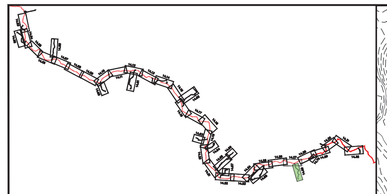

LOCATION MAP

LEGEND

- PROPOSED LIMIT OF DISTURBANCE
- STREAM
- USDA FOREST SERVICE (NATIONAL FOREST) LANDS
- APPALACHIAN NATIONAL SCENIC TRAIL
- EXISTING ROAD/TRAIL
- EXISTING PROPERTY LINE
- EXISTING STATE LINE
- EXISTING COUNTY LINE
- POND
- WETLAND
- ACID FORMING MATERIAL
- AGRICULTURAL LAND USE BOUNDARY
- PROPOSED ACCESS ROAD CENTERLINE
- PROPOSED PIPELINE
- PROPOSED SILT FENCE (SEE NOTE 5)
- PROPOSED SUPER SILT FENCE (SEE DETAIL MVP-ES9.2)
- PROPOSED REINFORCED FILTRATION DEVICE (SEE DETAILS MVP-ES9, 9.1, 9.2, 9.3)
- ORANGE CONSTRUCTION SAFETY FENCE
- PROPOSED COMPOST FILTER SOCK (SEE DETAILS MVP-ES3, 3.1, 3.2)
- PROPOSED COMPOST FILTER SOCK (SEE DETAILS MVP-ES3, 3.1, 3.2)
- PROPOSED COMPOST FILTER SOCK (SEE DETAILS MVP-ES3, 3.1, 3.2)
- GRASS-LINED CHANNEL (SEE DETAIL MVP-ES39)
- CLEAN WATER DIVERSION PIPE
- CLEAN WATER DIVERSION DIKE (SEE DETAIL MVP-ES50 AND MVP-ES51)

PLAN

SCALE: 1" = 100'

100 0 100 200

- STREAM FLOW DIRECTION
- FEMA 100 YEAR FLOODPLAIN
- DRAINAGE AREA BOUNDARY
- TIMBER MAT (SEE DETAIL MVP-ES37)
- STEEP SLOPE EROSION CONTROL (SEE NOTE 2)
- STEEP SLOPE AREAS (SEE NOTE 4)
- PROPOSED ROCK CONSTRUCTION ENTRANCE
- PROPOSED TRENCH BREAKER (SEE DETAIL MVP-20)
- TEMPORARY ROW DIVERSION/WATER BAR (VADEQ STD & SPEC 3.11)
- PERMANENT SLOPE BREAKER/ROW DIVERSION/WATER BAR (SEE DETAILS MVP-17, ES38, AND SCHEDULE)

NOTES:

1. TOPSOIL SEGREGATION WILL BE PERFORMED IN ALL IMMEDIATE CONSTRUCTION AREAS OF THE PROJECT IN ACCORDANCE WITH DETAILS MVP-ES46.1 THROUGH MVP-ES46.3.
2. FLEXTERRA, EARTHGUARD OR EQUIVALENT MAY BE USED AS A SUBSTITUTE TO EROSION CONTROL BLANKET AS DIRECTED BY MVP.
3. CONTRACTOR IS RESPONSIBLE TO IDENTIFY ALL UTILITIES. THE UTILITY LINES SHOWN ON THE PLAN ARE FOR INFORMATIONAL PURPOSES ONLY AND DO NOT REPRESENT SURVEYED LINE INFORMATION.
4. SLOPES OF 30' OR GREATER EXIST. CONSTRUCTION FOR STEEP SLOPES TO BE PERFORMED USING STEEP SLOPE TECHNIQUES IDENTIFIED IN THE DETAIL SHEETS. ALSO REFER TO THE SITE-SPECIFIC DESIGN OF STABILIZATION MEASURES IN SELECTED HIGH-HAZARD PORTIONS OF THE ROUTE OF THE PROPOSED MOUNTAIN VALLEY PIPELINE PROJECT.
5. WHERE CONSTRUCTION CONDITIONS PRECLUDE THE USE OF DIVERSION DITCHES DUE TO SITE CONDITIONS THE CONTRACTOR WILL INSTALL SILT FENCE AT THE DIRECTION OF MVP.
6. IMPROVEMENTS TO PERMANENT AND TEMPORARY ACCESS ROADS WILL BE PERFORMED PER THE SITE SPECIFIC ACCESS ROAD DETAILS.
7. TEMPORARY ACCESS ROAD CROSSING OF STREAMS AND WETLANDS WILL UTILIZE TIMBERMATS. ANY PERMANENT ROAD CROSSINGS WILL BE CONDUCTED VIA CULVERTS.
8. ALL NON VMRC STREAM CROSSINGS WILL BE PERFORMED AS DESCRIBED IN THE STREAM CROSSING TABLE INCLUDED IN THIS PACKAGE.

NO.	DATE:	DWN.:	CHKD.:	APPD.:	DESCRIPTION:
5	03/04/18	KAL	RE	DW	ADDRESS VADEQ COMMENTS
4	02/27/18	KAL	RE	DW	ADDRESS VADEQ COMMENTS
3	02/05/18	KAL	RE	DW	ADDRESS VADEQ COMMENTS
2	11/21/17	KAL	RE	DW	ADDRESS VADEQ COMMENTS
1	09/21/17	KAL	RE	DW	PLAN SUBMISSION

REVISIONS:

Mountain Valley PIPELINE

EROSION AND SEDIMENT CONTROL PLANS

MOUNTAIN VALLEY PIPELINE PROJECT – H600 LINE

SPREAD 10 – FRANKLIN COUNTY, VIRGINIA

MOUNTAIN VALLEY PIPELINE, LLC
555 SOUTHPOINTE BOULEVARD, SUITE 200
CANONSBURG, PA 15317

TETRA TECH
complex world | CLEAR SOLUTIONS™
661 ANDERSEN DRIVE
FOSTER PLAZA 7
PITTSBURGH, PA 15220


EROSION AND SEDIMENT CONTROL PLANS

COMMONWEALTH OF VIRGINIA
DAVID J. WALLNER
Lic. No. 0402057593
PROFESSIONAL ENGINEER

DRAWN BY:	KAL
CHECKED BY:	RE
APPROVED BY:	DW
DATE:	03/04/2018
SCALE:	AS SHOWN
REVISION	
SHT. NO.	14.69ES OF 14.81ES

TETRA TECH CAD FILE PATH: X:\CADD_Pittsburgh\EQT\7157 – MVP\15 – Franklin\E&S\ES Version 5.0.0\7157ES14.69(S10).dwg PLOTTED ON: 3/2/2018 4:59 PM PLOTTED BY: Zeigler, Justin PLOT FILE: ENVIRONMENTAL_COLOR.ctb

LOCATION MAP

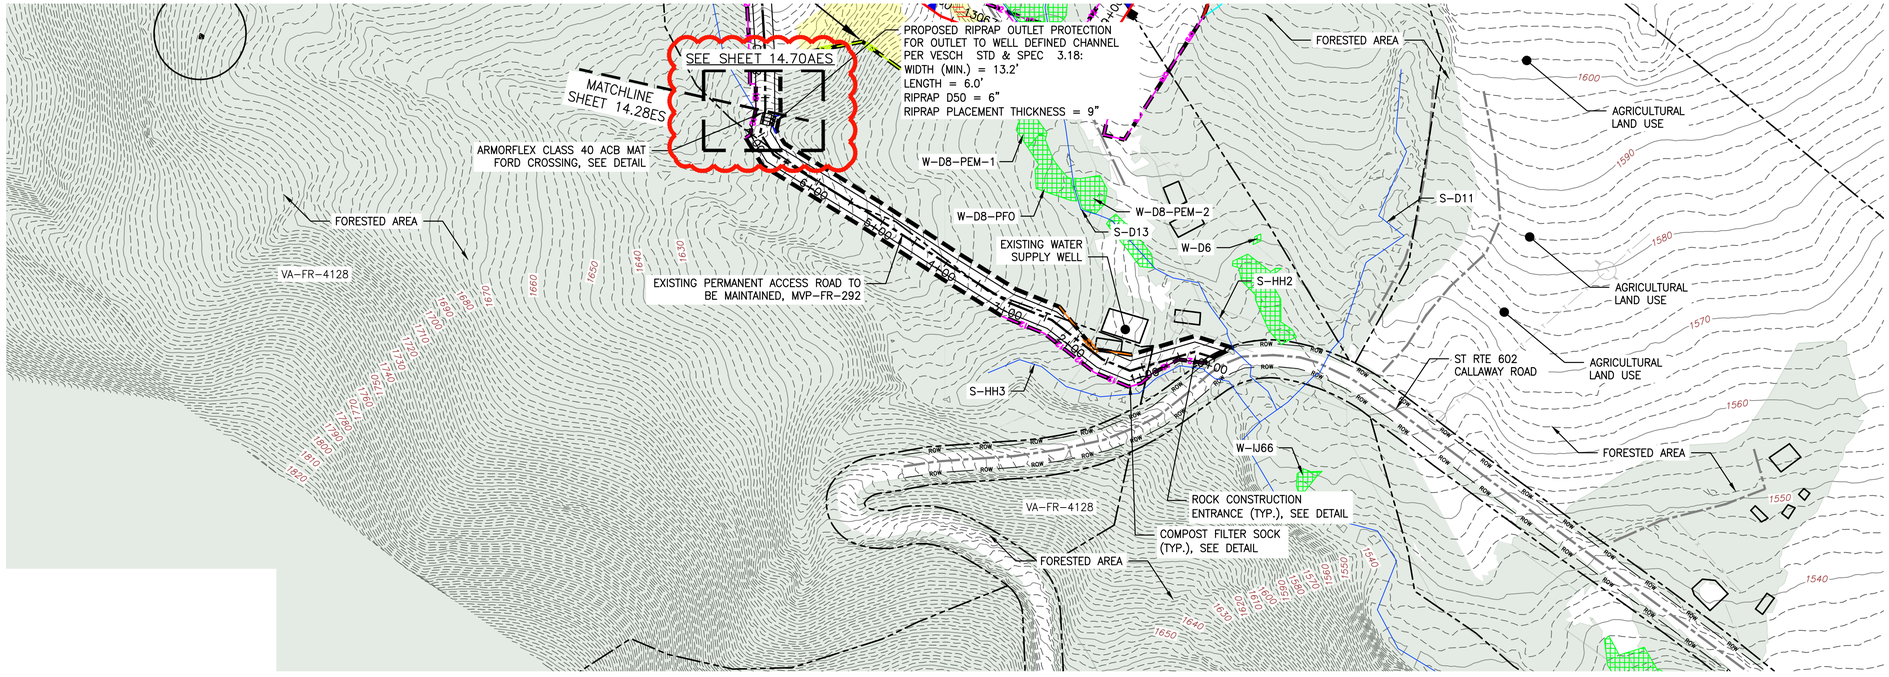

PLAN

SCALE: 1" = 100'

100 0 100 200

LEGEND

- PROPOSED LIMIT OF DISTURBANCE
- STREAM
- USDA FOREST SERVICE (NATIONAL FOREST) LANDS
- APPALACHIAN NATIONAL SCENIC TRAIL
- EXISTING ROAD/TRAIL
- EXISTING PROPERTY LINE
- EXISTING STATE LINE
- EXISTING COUNTY LINE
- POND
- WETLAND
- ACID FORMING MATERIAL
- EXISTING FOREST
- PROPOSED ACCESS ROAD CENTERLINE
- PROPOSED PIPELINE
- PROPOSED SILT FENCE (SEE NOTE 5)
- PROPOSED SUPER SILT FENCE (SEE DETAIL MVP-ES9.2)
- PROPOSED REINFORCED FILTRATION DEVICE (SEE DETAILS MVP-ES9, 9.1, 9.2, 9.3)
- ORANGE CONSTRUCTION SAFETY FENCE
- PROPOSED COMPOST FILTER SOCK (SEE DETAILS MVP-ES3, 3.1, 3.2)
- PROPOSED COMPOST FILTER SOCK (SEE DETAILS MVP-ES3, 3.1, 3.2)
- PROPOSED COMPOST FILTER SOCK (SEE DETAILS MVP-ES3, 3.1, 3.2)
- GRASS-LINED CHANNEL (SEE DETAIL MVP-ES39)
- CLEAN WATER DIVERSION PIPE
- CLEAN WATER DIVERSION DIKE (SEE DETAIL MVP-ES50 AND MVP-ES51)
- STREAM FLOW DIRECTION
- FEMA 100 YEAR FLOODPLAIN
- DRAINAGE AREA BOUNDARY
- TIMBER MAT (SEE DETAIL MVP-ES37)
- STEEP SLOPE EROSION CONTROL (SEE NOTE 2)
- STEEP SLOPE AREAS (SEE NOTE 4)
- PROPOSED ROCK CONSTRUCTION ENTRANCE
- PROPOSED TRENCH BREAKER (SEE DETAIL MVP-20)
- TEMPORARY ROW DIVERSION/WATER BAR (SEE DETAIL MVP-17)
- PERMANENT SLOPE BREAKER/ROW DIVERSION/WATER BAR (SEE DETAIL MVP-17)

NOTES:

1. TOPSOIL SEGREGATION WILL BE PERFORMED IN ALL IMMEDIATE CONSTRUCTION AREAS OF THE PROJECT IN ACCORDANCE WITH DETAILS MVP-ES46.1 THROUGH MVP-ES46.3.
2. FLEXTERRA, EARTHGUARD OR EQUIVALENT MAY BE USED AS A SUBSTITUTE TO EROSION CONTROL BLANKET AS DIRECTED BY MVP.
3. CONTRACTOR IS RESPONSIBLE TO IDENTIFY ALL UTILITIES. THE UTILITY LINES SHOWN ON THE PLAN ARE FOR INFORMATIONAL PURPOSES ONLY AND DO NOT REPRESENT SURVEYED LINE INFORMATION.
4. SLOPES OF 30" OR GREATER EXIST. CONSTRUCTION FOR STEEP SLOPES TO BE PERFORMED USING STEEP SLOPE TECHNIQUES IDENTIFIED IN THE DETAIL SHEETS. ALSO REFER TO THE SITE-SPECIFIC DESIGN OF STABILIZATION MEASURES IN SELECTED HIGH-HAZARD PORTIONS OF THE ROUTE OF THE PROPOSED MOUNTAIN VALLEY PIPLELINE PROJECT.
5. WHERE CONSTRUCTION CONDITIONS PRECLUDE THE USE OF DIVERSION DITCHES DUE TO SITE CONDITIONS THE CONTRACTOR WILL INSTALL SILT FENCE AT THE DIRECTION OF MVP.
6. IMPROVEMENTS TO PERMANENT AND TEMPORARY ACCESS ROADS WILL BE PERFORMED PER THE SITE SPECIFIC ACCESS ROAD DETAILS.
7. TEMPORARY ACCESS ROAD CROSSING OF STREAMS AND WETLANDS WILL UTILIZE TIMBERMATS. ANY PERMANENT ROAD CROSSINGS WILL BE CONDUCTED VIA CULVERTS.
8. ALL NON VMRC STREAM CROSSINGS WILL BE PERFORMED AS DESCRIBED IN THE STREAM CROSSING TABLE INCLUDED IN THIS PACKAGE.

NO.:	DATE:	DWN.:	CHKD.:	APPD.:	DESCRIPTION:
–	06/23/21	JK	RE	DW	ADDRESS VADEQ COMMENTS
–	05/05/21	JK	RE	DW	PROPOSED FORD AT STREAM S-D14 CROSSING (ACCESS ROAD MVP-FR-292)
5	03/04/18	KAL	RE	DW	ADDRESS VADEQ COMMENTS
4	02/27/18	KAL	RE	DW	ADDRESS VADEQ COMMENTS
3	02/05/18	KAL	RE	DW	ADDRESS VADEQ COMMENTS
2	11/21/17	KAL	RE	DW	ADDRESS VADEQ COMMENTS

REVISIONS:

Mountain Valley PIPELINE

EROSION AND SEDIMENT CONTROL PLANS

MOUNTAIN VALLEY PIPELINE PROJECT – H600 LINE

SPREAD 10 – FRANKLIN COUNTY, VIRGINIA

MOUNTAIN VALLEY PIPELINE, LLC
2200 ENERGY DRIVE
CANONSBURG, PA 15317


TETRA TECH
complex world | CLEAR SOLUTIONS™
661 ANDERSEN DRIVE
FOSTER PLAZA 7
PITTSBURGH, PA 15220

EROSION AND SEDIMENT CONTROL PLANS

COMMONWEALTH OF VIRGINIA
DAVID J. WALLNER
Lic. No. 57593
06/23/2021
PROFESSIONAL ENGINEER

DRAWN BY:	JJZ
CHECKED BY:	RE
APPROVED BY:	DW
DATE:	06/23/2021
SCALE:	AS SHOWN
REVISION	–
SHT. NO.	14.70ES OF 14.81ES

TETRA TECH CAD FILE PATH: X:\CADD_Pittsburgh\EQT\7157 – MVP\15 – Franklin\E&S\ES Version 5.0.0\7157ES14.70(S10).dwg PLOTTED ON: 6/25/2021 7:55 AM PLOTTED BY: Rickabaugh, Greg PLOT FILE: ENVIRONMENTAL_COLOR.ctb

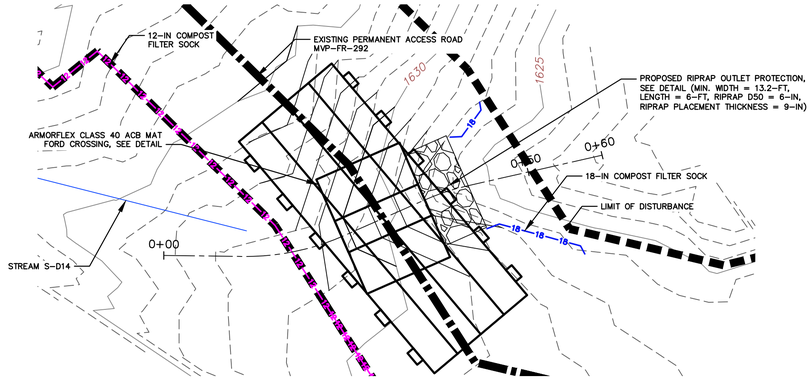


PLAN VIEW

SCALE

0 10 20

SCALE IN FEET

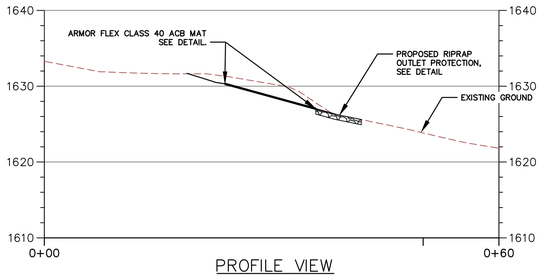


PROFILE VIEW


SCALE

0 10 20


SCALE IN FEET

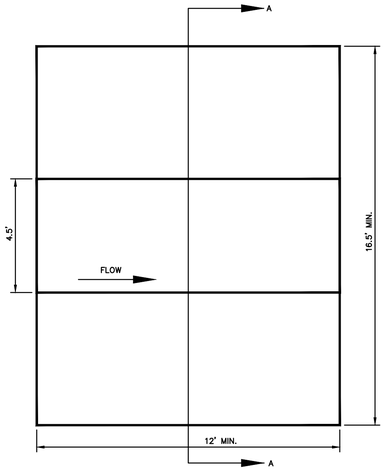

ACB MAT FORD CROSSING PLAN VIEW

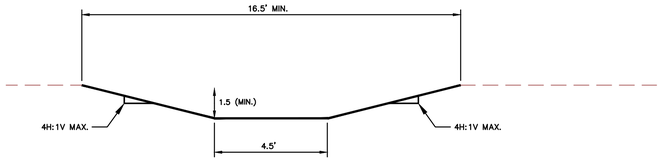

SECTION A-A

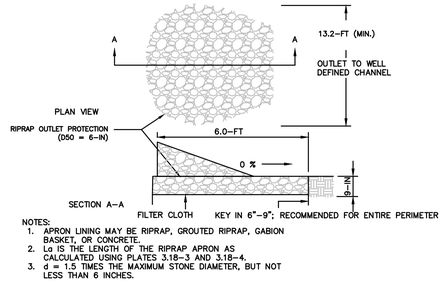


NOTES:
1. APRON LINING MAY BE RIPRAP, GROUTED RIPRAP, GABION BASKET, OR CONCRETE.
2. La IS THE LENGTH OF THE RIPRAP APRON AS CALCULATED USING PLATES 3.18-3 AND 3.18-4.
3. d = 1.5 TIMES THE MAXIMUM STONE DIAMETER, BUT NOT LESS THAN 6 INCHES.


Source: Va. DSWC

Plate 3.18-1

RIPRAP OUTLET PROTECTION DETAIL

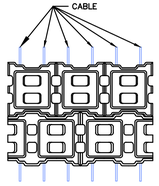


PLAN

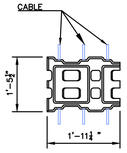

TOP




SIDE

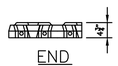

END


TYP. 40 – 1.5 BLOCK

N.T.S

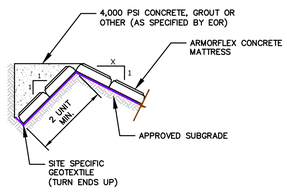


TOP TERMINATION

N.T.S

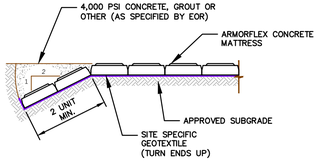


FLANK TERMINATION

N.T.S

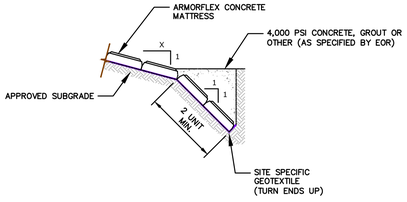


TOE TERMINATION

N.T.S

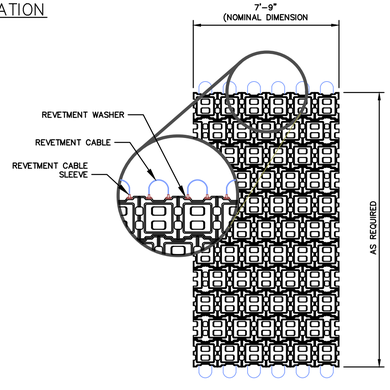

TYP. 40 BLOCK 1.5 MAT


N.T.S

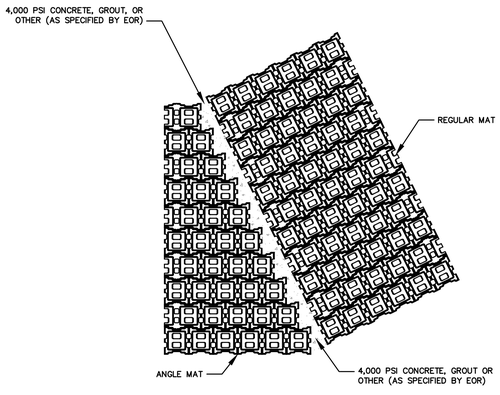

NOTE:
ANGLE MATS WILL BE CONSTRUCTED BY OMITTING THE REQUIRED UNITS SO THE REQUIRED MAT DIMENSIONS CAN BE OBTAINED.

TYP. ANGLE MAT

N.T.S

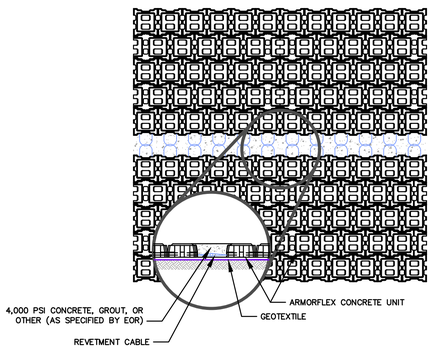

TYP. MAT TO MAT

N.T.S

NO.:	DATE:	DWN.:	CHKD.:	APPD.:	DESCRIPTION:
–	06/23/21	JJZ	RE	DW	ADDRESS VADEQ COMMENTS
0	05/05/21	JK	RE	DW	PROPOSED ACB MAT FORD CROSSING (ACCESS ROAD MVP-FR-232)

REVISIONS:

Mountain Valley PIPELINE

EROSION AND SEDIMENT CONTROL PLANS

MOUNTAIN VALLEY PIPELINE PROJECT – H600 LINE

SPREAD 10 – FRANKLIN COUNTY, VIRGINIA

MOUNTAIN VALLEY PIPELINE, LLC

2200 ENERGY DRIVE

CANONSBURG, PA 15317

TETRA TECH

complex world | CLEAR SOLUTIONS™

661 ANDERSEN DRIVE
FOSTER PLAZA 7
PITTSBURGH, PA 15220

EROSION AND SEDIMENT CONTROL PLANS

COMMONWEALTH OF VIRGINIA
DAVID J. WALLNER
Lic. No. 57593
6/23/2021
PROFESSIONAL ENGINEER

DRAWN BY:	JJZ
CHECKED BY:	RE
APPROVED BY:	DW
DATE:	06/23/2021
SCALE:	AS SHOWN
REVISION	0
SHT. NO.	14.70AES OF 14.81ES



LOCATION MAP

MVP-ATWS-1342

COMPOST FILTER SOCK (TYP.), SEE DETAIL

FORESTED AREA

EXISTING PERMANENT ACCESS ROAD TO BE MAINTAINED, MVP-FR-293.02

MVP-ATWS-1343

MATCHLINE SHEET 14.39ES

FORESTED AREA

VA-FR-017.15

AGRICULTURAL LAND USE

FORESTED AREA

ROCK CONSTRUCTION ENTRANCE (TYP.), SEE DETAIL

AGRICULTURAL LAND USE

STE RT 742 CAHAS MOUNTAIN RD

VA-FR-017.15

FORESTED AREA

PLAN

SCALE: 1" = 100'

100 0 100 200

LEGEND

- PROPOSED LIMIT OF DISTURBANCE
- STREAM
- USDA FOREST SERVICE (NATIONAL FOREST) LANDS
- ANST — ANST — APPALACHIAN NATIONAL SCENIC TRAIL
- EXISTING ROAD/TRAIL
- EXISTING PROPERTY LINE
- EXISTING STATE LINE
- EXISTING COUNTY LINE
- POND
- WETLAND
- AFM — AFM — ACID FORMING MATERIAL
- AGR — AGR — AGRICULTURAL LAND USE BOUNDARY
- PROPOSED ACCESS ROAD CENTERLINE
- PROPOSED PIPELINE
- SF — SF — PROPOSED SILT FENCE (SEE NOTE 5)
- SSF — SSF — PROPOSED SUPER SILT FENCE (SEE DETAIL MVP-ES9.2)
- RFD — RFD — PROPOSED REINFORCED FILTRATION DEVICE (SEE DETAILS MVP-ES9, 9.1, 9.2, 9.3)
- OCSF — ORANGE CONSTRUCTION SAFETY FENCE
- 12 — 12 — 12 — 12 — PROPOSED COMPOST FILTER SOCK (SEE DETAILS MVP-ES3, 3.1, 3.2)
- 18 — 18 — 18 — 18 — PROPOSED COMPOST FILTER SOCK (SEE DETAILS MVP-ES3, 3.1, 3.2)
- 24 — 24 — 24 — 24 — PROPOSED COMPOST FILTER SOCK (SEE DETAILS MVP-ES3, 3.1, 3.2)
- GRASS-LINED CHANNEL (SEE DETAIL MVP-ES39)
- CLEAN WATER DIVERSION PIPE
- CLEAN WATER DIVERSION DIKE (SEE DETAIL MVP-ES50 AND MVP-ES51)
- STREAM FLOW DIRECTION
- FEMA 100 YEAR FLOODPLAIN
- DRAINAGE AREA BOUNDARY
- TIMBER MAT (SEE DETAIL MVP-ES37)
- STEEP SLOPE EROSION CONTROL (SEE NOTE 2)
- STEEP SLOPE AREAS (SEE NOTE 4)
- PROPOSED ROCK CONSTRUCTION ENTRANCE
- PROPOSED TRENCH BREAKER (SEE DETAIL MVP-20)
- TEMPORARY ROW DIVERSION/WATER BAR (VADEQ STD & SPEC 3.11)
- PERMANENT SLOPE BREAKER/ROW DIVERSION/WATER BAR (SEE DETAILS MVP-17, ES38, AND SCHEDULE)

NOTES:

1. TOPSOIL SEGREGATION WILL BE PERFORMED IN ALL IMMEDIATE CONSTRUCTION AREAS OF THE PROJECT IN ACCORDANCE WITH DETAILS MVP-ES46.1 THROUGH MVP-ES46.3.
2. FLEXTERRA, EARTHGUARD OR EQUIVALENT MAY BE USED AS A SUBSTITUTE TO EROSION CONTROL BLANKET AS DIRECTED BY MVP.
3. CONTRACTOR IS RESPONSIBLE TO IDENTIFY ALL UTILITIES. THE UTILITY LINES SHOWN ON THE PLAN ARE FOR INFORMATIONAL PURPOSES ONLY AND DO NOT REPRESENT SURVEYED LINE INFORMATION.
4. SLOPES OF 30° OR GREATER EXIST. CONSTRUCTION FOR STEEP SLOPES TO BE PERFORMED USING STEEP SLOPE TECHNIQUES IDENTIFIED IN THE DETAIL SHEETS. ALSO REFER TO THE SITE-SPECIFIC DESIGN OF STABILIZATION MEASURES IN SELECTED HIGH-HAZARD PORTIONS OF THE ROUTE OF THE PROPOSED MOUNTAIN VALLEY PIPELINE PROJECT.
5. WHERE CONSTRUCTION CONDITIONS PRECLUDE THE USE OF DIVERSION DITCHES DUE TO SITE CONDITIONS THE CONTRACTOR WILL INSTALL SILT FENCE AT THE DIRECTION OF MVP.
6. IMPROVEMENTS TO PERMANENT AND TEMPORARY ACCESS ROADS WILL BE PERFORMED PER THE SITE SPECIFIC ACCESS ROAD DETAILS.
7. TEMPORARY ACCESS ROAD CROSSING OF STREAMS AND WETLANDS WILL UTILIZE TIMBERMATS. ANY PERMANENT ROAD CROSSINGS WILL BE CONDUCTED VIA CULVERTS.
8. ALL NON VMRC STREAM CROSSINGS WILL BE PERFORMED AS DESCRIBED IN THE STREAM CROSSING TABLE INCLUDED IN THIS PACKAGE.

TETRA TECH CAD FILE PATH: X:\CADD_Pittsburgh\EQT\7157 – MVP\15 – Franklin\E&S\ES Version 5.0.0\7157ES14.71(S10).dwg PLOTTED ON: 3/2/2018 5:03 PM PLOTTED BY: Zeigler, Justin PLOT FILE: ENVIRONMENTAL_COLOR.ctb

NO.	DATE:	DWN.:	CHKD.:	APPD.:	DESCRIPTION:
5	03/04/18	KAL	RE	DW	ADDRESS VADEQ COMMENTS
4	02/27/18	KAL	RE	DW	ADDRESS VADEQ COMMENTS
3	02/05/18	KAL	RE	DW	ADDRESS VADEQ COMMENTS
2	11/21/17	KAL	RE	DW	ADDRESS VADEQ COMMENTS
1	09/21/17	KAL	RE	DW	PLAN SUBMISSION

REVISIONS:

Mountain Valley PIPELINE

EROSION AND SEDIMENT CONTROL PLANS

MOUNTAIN VALLEY PIPELINE PROJECT – H600 LINE

SPREAD 10 – FRANKLIN COUNTY, VIRGINIA

TETRA TECH

complex world | CLEAR SOLUTIONS™

661 ANDERSEN DRIVE
FOSTER PLAZA 7
PITTSBURGH, PA 15220

EROSION AND SEDIMENT CONTROL PLANS


COMMONWEALTH OF VIRGINIA
DAVID J. WALLNER
Lic. No. 0402057593
PROFESSIONAL ENGINEER

DRAWN BY:	KAL
CHECKED BY:	RE
APPROVED BY:	DW
DATE:	03/04/2018
SCALE:	AS SHOWN


REVISION

SHT. NO. 14.71ES OF 14.81ES

MOUNTAIN VALLEY PIPELINE, LLC
535 SOUTHPOINTE BOULEVARD, SUITE 200
CANONSBURG, PA 15317

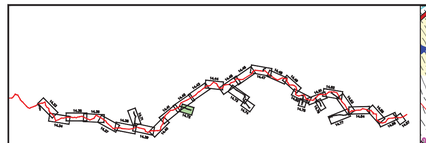

LOCATION MAP

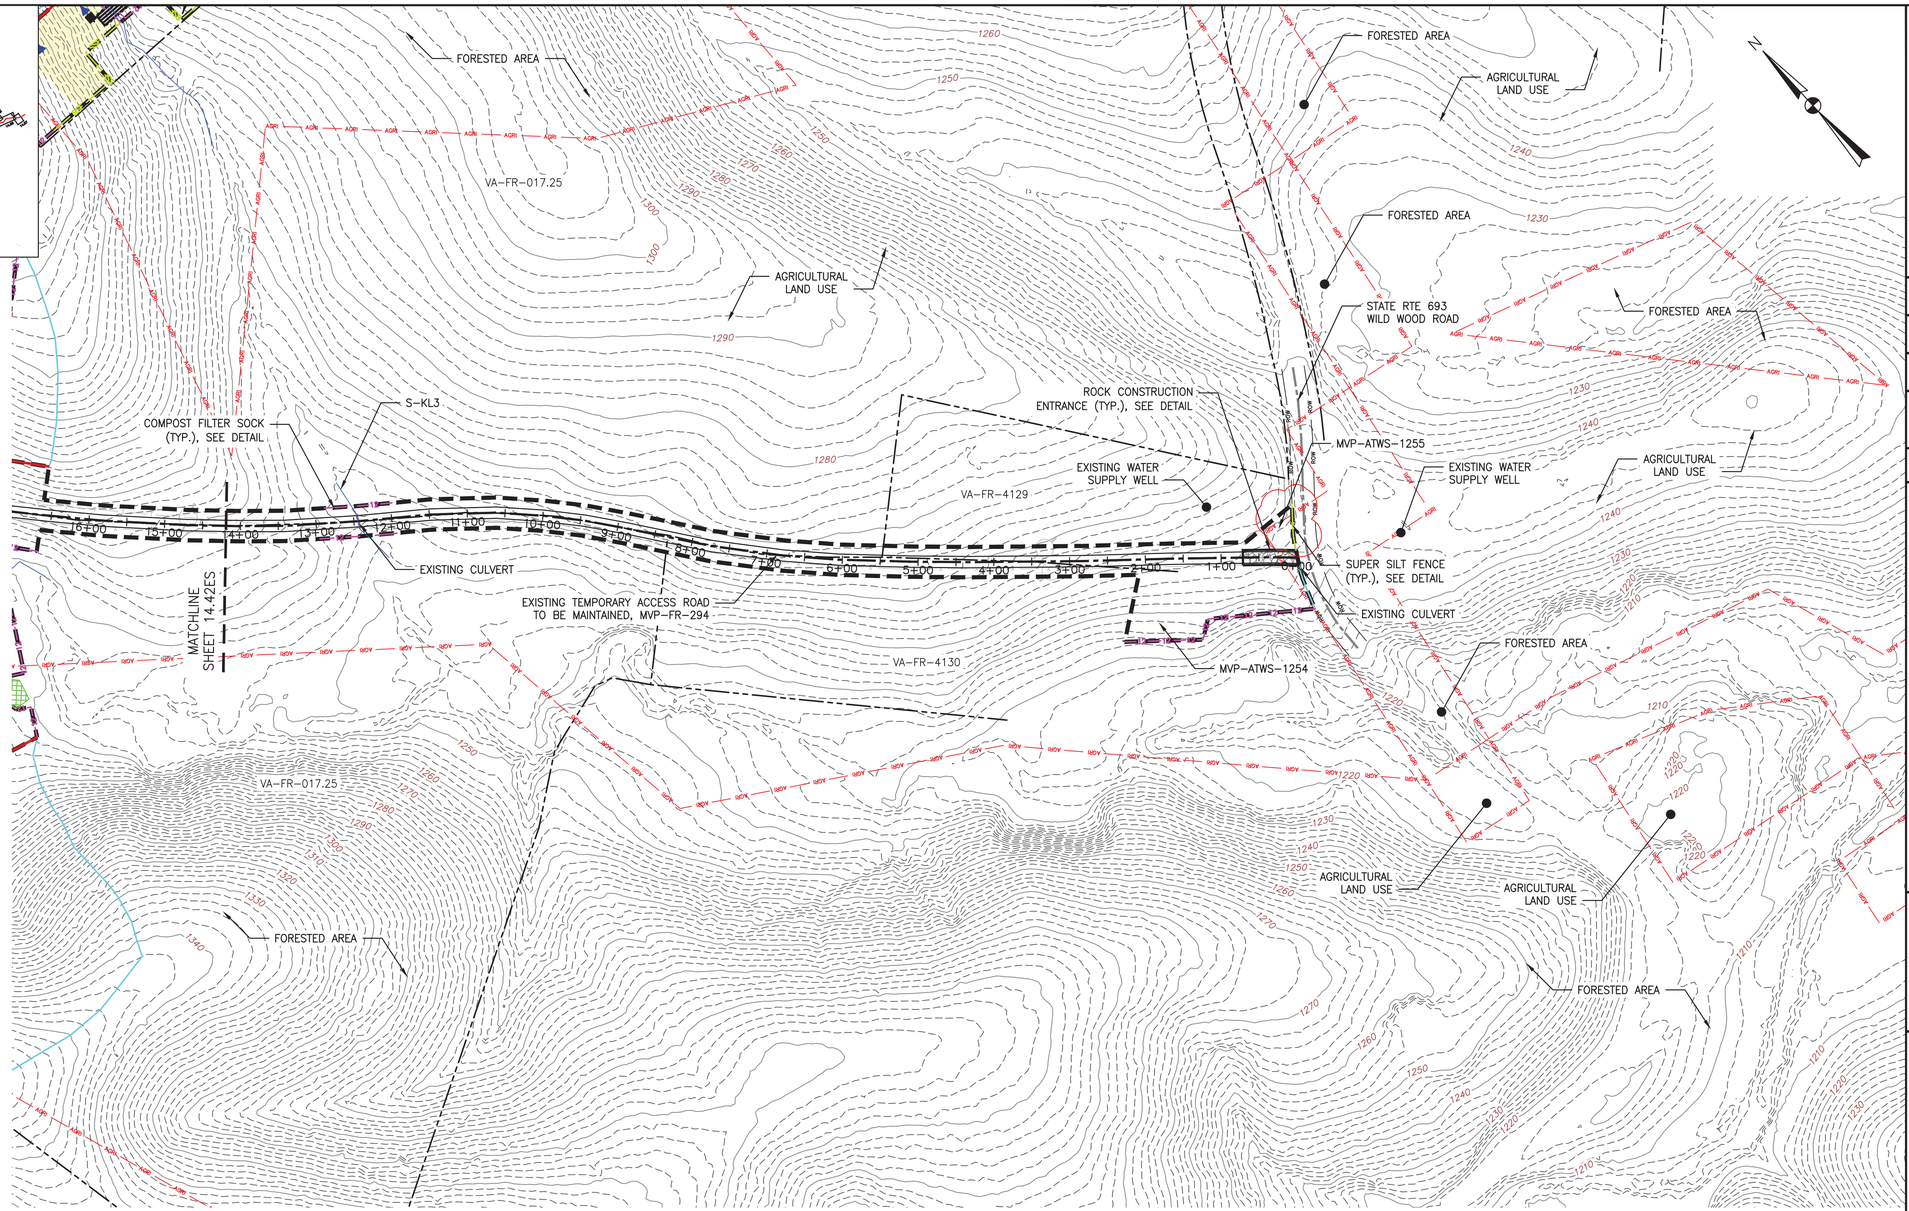

PLAN

SCALE: 1" = 100'

100 0 100 200

LEGEND

- PROPOSED LIMIT OF DISTURBANCE
- STREAM
- USDA FOREST SERVICE (NATIONAL FOREST) LANDS
- APPALACHIAN NATIONAL SCENIC TRAIL
- EXISTING ROAD/TRAIL
- EXISTING PROPERTY LINE
- EXISTING STATE LINE
- EXISTING COUNTY LINE
- POND
- WETLAND
- ACID FORMING MATERIAL
- AGRICULTURAL LAND USE BOUNDARY
- PROPOSED ACCESS ROAD CENTERLINE
- PROPOSED PIPELINE
- PROPOSED SILT FENCE (SEE NOTE 5)
- PROPOSED SUPER SILT FENCE (SEE DETAIL MVP-ES9.2)
- PROPOSED REINFORCED FILTRATION DEVICE (SEE DETAILS MVP-ES9, 9.1, 9.2, 9.3)
- ORANGE CONSTRUCTION SAFETY FENCE
- PROPOSED COMPOST FILTER SOCK (SEE DETAILS MVP-ES3, 3.1, 3.2)
- PROPOSED COMPOST FILTER SOCK (SEE DETAILS MVP-ES3, 3.1, 3.2)
- PROPOSED COMPOST FILTER SOCK (SEE DETAILS MVP-ES3, 3.1, 3.2)
- GRASS-LINED CHANNEL (SEE DETAIL MVP-ES39)
- CLEAN WATER DIVERSION PIPE
- CLEAN WATER DIVERSION DIKE (SEE DETAIL MVP-ES50 AND MVP-ES51)
- STREAM FLOW DIRECTION
- FEMA 100 YEAR FLOODPLAIN
- DRAINAGE AREA BOUNDARY
- TIMBER MAT (SEE DETAIL MVP-ES37)
- STEEP SLOPE EROSION CONTROL (SEE NOTE 2)
- STEEP SLOPE AREAS (SEE NOTE 4)
- PROPOSED ROCK CONSTRUCTION ENTRANCE
- PROPOSED TRENCH BREAKER (SEE DETAIL MVP-20)
- TEMPORARY ROW DIVERSION/WATER BAR (VADEQ STD & SPEC 3.11)
- PERMANENT SLOPE BREAKER/ROW DIVERSION/WATER BAR (SEE DETAILS MVP-17, ES38, AND SCHEDULE)

NOTES:

1. TOPSOIL SEGREGATION WILL BE PERFORMED IN ALL IMMEDIATE CONSTRUCTION AREAS OF THE PROJECT IN ACCORDANCE WITH DETAILS MVP-ES46.1 THROUGH MVP-ES46.3.
2. FLEXTERRA, EARTHGUARD OR EQUIVALENT MAY BE USED AS A SUBSTITUTE TO EROSION CONTROL BLANKET AS DIRECTED BY MVP.
3. CONTRACTOR IS RESPONSIBLE TO IDENTIFY ALL UTILITIES. THE UTILITY LINES SHOWN ON THE PLAN ARE FOR INFORMATIONAL PURPOSES ONLY AND DO NOT REPRESENT SURVEYED LINE INFORMATION.
4. SLOPES OF 30' OR GREATER EXIST. CONSTRUCTION FOR STEEP SLOPES TO BE PERFORMED USING STEEP SLOPE TECHNIQUES IDENTIFIED IN THE DETAIL SHEETS. ALSO REFER TO THE SITE-SPECIFIC DESIGN OF STABILIZATION MEASURES IN SELECTED HIGH-HAZARD PORTIONS OF THE ROUTE OF THE PROPOSED MOUNTAIN VALLEY PIPELINE PROJECT.
5. WHERE CONSTRUCTION CONDITIONS PRECLUDE THE USE OF DIVERSION DITCHES DUE TO SITE CONDITIONS THE CONTRACTOR WILL INSTALL SILT FENCE AT THE DIRECTION OF MVP.
6. IMPROVEMENTS TO PERMANENT AND TEMPORARY ACCESS ROADS WILL BE PERFORMED PER THE SITE SPECIFIC ACCESS ROAD DETAILS.
7. TEMPORARY ACCESS ROAD CROSSING OF STREAMS AND WETLANDS WILL UTILIZE TIMBERMATS. ANY PERMANENT ROAD CROSSINGS WILL BE CONDUCTED VIA CULVERTS.
8. ALL NON VMRC STREAM CROSSINGS WILL BE PERFORMED AS DESCRIBED IN THE STREAM CROSSING TABLE INCLUDED IN THIS PACKAGE.

REVISIONS:

NO.:	DATE:	DWN.:	CHKD.:	APPD.:	DESCRIPTION:
5	03/04/18	KAL	RE	DW	ADDRESS VADEQ COMMENTS
4	02/27/18	KAL	RE	DW	ADDRESS VADEQ COMMENTS
3	02/05/18	KAL	RE	DW	ADDRESS VADEQ COMMENTS
2	11/21/17	KAL	RE	DW	ADDRESS VADEQ COMMENTS
1	09/21/17	KAL	RE	DW	PLAN SUBMISSION

EROSION AND SEDIMENT CONTROL PLANS

MOUNTAIN VALLEY PIPELINE PROJECT – H600 LINE

SPREAD 10 – FRANKLIN COUNTY, VIRGINIA

MOUNTAIN VALLEY PIPELINE, LLC
555 SOUTHPOINTE BOULEVARD, SUITE 200
CANONSBURG, PA 15317

TETRA TECH
complex world | CLEAR SOLUTIONS™
661 ANDERSEN DRIVE
FOSTER PLAZA 7
PITTSBURGH, PA 15220

EROSION AND SEDIMENT CONTROL PLANS


COMMONWEALTH OF PENNSYLVANIA
DAVID J. WALLNER
Lic. No. 040205793
PROFESSIONAL ENGINEER

DRAWN BY:	KAL
CHECKED BY:	RE
APPROVED BY:	DW
DATE:	03/04/2018
SCALE:	AS SHOWN

REVISION

SHT. NO. 14.72ES OF 14.81ES

TETRA TECH CAD FILE PATH: X:\CADD_Pittsburgh\EQT\7157 – MVP\15 – Franklin\E&S\ES Version 5.0.0\7157ES14.72(S10).dwg PLOTTED ON: 3/2/2018 5:04 PM PLOTTED BY: Zeigler, Justin PLOT FILE: ENVIRONMENTAL_COLOR.ctb

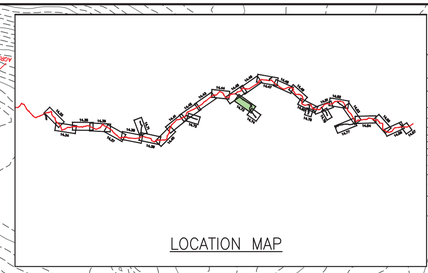

LEGEND

- PROPOSED LIMIT OF DISTURBANCE
- STREAM
- USDA FOREST SERVICE (NATIONAL FOREST) LANDS
- APPALACHIAN NATIONAL SCENIC TRAIL
- EXISTING ROAD/TRAIL
- EXISTING PROPERTY LINE
- EXISTING STATE LINE
- EXISTING COUNTY LINE
- POND
- WETLAND
- ACID FORMING MATERIAL
- AGRICULTURAL LAND USE BOUNDARY
- PROPOSED ACCESS ROAD CENTERLINE
- PROPOSED PIPELINE
- PROPOSED SILT FENCE (SEE NOTE 5)
- PROPOSED SUPER SILT FENCE (SEE DETAIL MVP-ES9.2)
- PROPOSED REINFORCED FILTRATION DEVICE (SEE DETAILS MVP-ES9, 9.1, 9.2, 9.3)
- ORANGE CONSTRUCTION SAFETY FENCE
- PROPOSED COMPOST FILTER SOCK (SEE DETAILS MVP-ES3, 3.1, 3.2)
- PROPOSED COMPOST FILTER SOCK (SEE DETAILS MVP-ES3, 3.1, 3.2)
- PROPOSED COMPOST FILTER SOCK (SEE DETAILS MVP-ES3, 3.1, 3.2)
- GRASS-LINED CHANNEL (SEE DETAIL MVP-ES39)
- CLEAN WATER DIVERSION PIPE
- CLEAN WATER DIVERSION DIKE (SEE DETAIL MVP-ES50 AND MVP-ES51)

PLAN

SCALE: 1" = 100'

100 0 100 200

- STREAM FLOW DIRECTION
- FEMA 100 YEAR FLOODPLAIN
- DRAINAGE AREA BOUNDARY
- TIMBER MAT (SEE DETAIL MVP-ES37)
- STEEP SLOPE EROSION CONTROL (SEE NOTE 2)
- STEEP SLOPE AREAS (SEE NOTE 4)
- PROPOSED ROCK CONSTRUCTION ENTRANCE
- PROPOSED TRENCH BREAKER (SEE DETAIL MVP-20)
- TEMPORARY ROW DIVERSION/WATER BAR (VADEQ STD & SPEC 3.11)
- PERMANENT SLOPE BREAKER/ROW DIVERSION/WATER BAR (SEE DETAILS MVP-17, ES38, AND SCHEDULE)

NOTES:

1. TOPSOIL SEGREGATION WILL BE PERFORMED IN ALL IMMEDIATE CONSTRUCTION AREAS OF THE PROJECT IN ACCORDANCE WITH DETAILS MVP-ES46.1 THROUGH MVP-ES46.3.
2. FLEXTERRA, EARTHGUARD OR EQUIVALENT MAY BE USED AS A SUBSTITUTE TO EROSION CONTROL BLANKET AS DIRECTED BY MVP.
3. CONTRACTOR IS RESPONSIBLE TO IDENTIFY ALL UTILITIES. THE UTILITY LINES SHOWN ON THE PLAN ARE FOR INFORMATIONAL PURPOSES ONLY AND DO NOT REPRESENT SURVEYED LINE INFORMATION.
4. SLOPES OF 30' OR GREATER EXIST. CONSTRUCTION FOR STEEP SLOPES TO BE PERFORMED USING STEEP SLOPE TECHNIQUES IDENTIFIED IN THE DETAIL SHEETS. ALSO REFER TO THE SITE-SPECIFIC DESIGN OF STABILIZATION MEASURES IN SELECTED HIGH-HAZARD PORTIONS OF THE ROUTE OF THE PROPOSED MOUNTAIN VALLEY PIPELINE PROJECT.
5. WHERE CONSTRUCTION CONDITIONS PRECLUDE THE USE OF DIVERSION DITCHES DUE TO SITE CONDITIONS THE CONTRACTOR WILL INSTALL SILT FENCE AT THE DIRECTION OF MVP.
6. IMPROVEMENTS TO PERMANENT AND TEMPORARY ACCESS ROADS WILL BE PERFORMED PER THE SITE SPECIFIC ACCESS ROAD DETAILS.
7. TEMPORARY ACCESS ROAD CROSSING OF STREAMS AND WETLANDS WILL UTILIZE TIMBERMATS. ANY PERMANENT ROAD CROSSINGS WILL BE CONDUCTED VIA CULVERTS.
8. ALL NON VMRC STREAM CROSSINGS WILL BE PERFORMED AS DESCRIBED IN THE STREAM CROSSING TABLE INCLUDED IN THIS PACKAGE.

NO.	DATE:	DWN.:	CHKD.:	APPD.:	DESCRIPTION:
5	03/04/18	KAL	RE	DW	ADDRESS VADEQ COMMENTS
4	02/27/18	KAL	RE	DW	ADDRESS VADEQ COMMENTS
3	02/05/18	KAL	RE	DW	ADDRESS VADEQ COMMENTS
2	11/21/17	KAL	RE	DW	ADDRESS VADEQ COMMENTS
1	09/21/17	KAL	RE	DW	PLAN SUBMISSION

REVISIONS:

EROSION AND SEDIMENT CONTROL PLANS

MOUNTAIN VALLEY PIPELINE PROJECT – H600 LINE

SPREAD 10 – FRANKLIN COUNTY, VIRGINIA

Mountain Valley PIPELINE

MOUNTAIN VALLEY PIPELINE, LLC
555 SOUTHPOINTE BOULEVARD, SUITE 200
CANONSBURG, PA 15317

TETRA TECH
complex world | CLEAR SOLUTIONS™
661 ANDERSEN DRIVE
FOSTER PLAZA 7
PITTSBURGH, PA 15220

EROSION AND SEDIMENT CONTROL PLANS


COMMONWEALTH OF PENNSYLVANIA
DAVID J. WALLNER
Lic. No. 040205793
PROFESSIONAL ENGINEER

DRAWN BY:	KAL
CHECKED BY:	RE
APPROVED BY:	DW
DATE:	03/04/2018
SCALE:	AS SHOWN

REVISION

SHT. NO. 14.73ES OF 14.81ES

TETRA TECH CAD FILE PATH: X:\CADD_Pittsburgh\EQT\7157 – MVP\15 – Franklin\E&S\ES Version 5.0.0\7157ES14.73(S10).dwg PLOTTED ON: 3/2/2018 5:05 PM PLOTTED BY: Zeigler, Justin PLOT FILE: ENVIRONMENTAL_COLOR.ctb

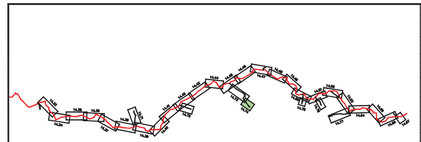

LOCATION MAP

PLAN

SCALE: 1" = 100'

100 0 100 200

LEGEND

- PROPOSED LIMIT OF DISTURBANCE
- STREAM
- USDA FOREST SERVICE (NATIONAL FOREST) LANDS
- APPALACHIAN NATIONAL SCENIC TRAIL
- EXISTING ROAD/TRAIL
- EXISTING PROPERTY LINE
- EXISTING STATE LINE
- EXISTING COUNTY LINE
- POND
- WETLAND
- ACID FORMING MATERIAL
- AGRICULTURAL LAND USE BOUNDARY
- PROPOSED ACCESS ROAD CENTERLINE
- PROPOSED PIPELINE
- PROPOSED SILT FENCE (SEE NOTE 5)
- PROPOSED SUPER SILT FENCE (SEE DETAIL MVP-ES9.2)
- PROPOSED REINFORCED FILTRATION DEVICE (SEE DETAILS MVP-ES9, 9.1, 9.2, 9.3)
- ORANGE CONSTRUCTION SAFETY FENCE
- PROPOSED COMPOST FILTER SOCK (SEE DETAILS MVP-ES3, 3.1, 3.2)
- PROPOSED COMPOST FILTER SOCK (SEE DETAILS MVP-ES3, 3.1, 3.2)
- PROPOSED COMPOST FILTER SOCK (SEE DETAILS MVP-ES3, 3.1, 3.2)
- GRASS-LINED CHANNEL (SEE DETAIL MVP-ES39)
- CLEAN WATER DIVERSION PIPE
- CLEAN WATER DIVERSION DIKE (SEE DETAIL MVP-ES50 AND MVP-ES51)
- STREAM FLOW DIRECTION
- FEMA 100 YEAR FLOODPLAIN
- DRAINAGE AREA BOUNDARY
- TIMBER MAT (SEE DETAIL MVP-ES37)
- STEEP SLOPE EROSION CONTROL (SEE NOTE 2)
- STEEP SLOPE AREAS (SEE NOTE 4)
- PROPOSED ROCK CONSTRUCTION ENTRANCE
- PROPOSED TRENCH BREAKER (SEE DETAIL MVP-20)
- TEMPORARY ROW DIVERSION/WATER BAR (VADEQ STD & SPEC 3.11)
- PERMANENT SLOPE BREAKER/ROW DIVERSION/WATER BAR (SEE DETAILS MVP-17, ES38, AND SCHEDULE)

NOTES:

1. TOPSOIL SEGREGATION WILL BE PERFORMED IN ALL IMMEDIATE CONSTRUCTION AREAS OF THE PROJECT IN ACCORDANCE WITH DETAILS MVP-ES46.1 THROUGH MVP-ES46.3.
2. FLEXTERRA, EARTHGUARD OR EQUIVALENT MAY BE USED AS A SUBSTITUTE TO EROSION CONTROL BLANKET AS DIRECTED BY MVP.
3. CONTRACTOR IS RESPONSIBLE TO IDENTIFY ALL UTILITIES. THE UTILITY LINES SHOWN ON THE PLAN ARE FOR INFORMATIONAL PURPOSES ONLY AND DO NOT REPRESENT SURVEYED LINE INFORMATION.
4. SLOPES OF 30° OR GREATER EXIST. CONSTRUCTION FOR STEEP SLOPES TO BE PERFORMED USING STEEP SLOPE TECHNIQUES IDENTIFIED IN THE DETAIL SHEETS. ALSO REFER TO THE SITE-SPECIFIC DESIGN OF STABILIZATION MEASURES IN SELECTED HIGH-HAZARD PORTIONS OF THE ROUTE OF THE PROPOSED MOUNTAIN VALLEY PIPELINE PROJECT.
5. WHERE CONSTRUCTION CONDITIONS PRECLUDE THE USE OF DIVERSION DITCHES DUE TO SITE CONDITIONS THE CONTRACTOR WILL INSTALL SILT FENCE AT THE DIRECTION OF MVP.
6. IMPROVEMENTS TO PERMANENT AND TEMPORARY ACCESS ROADS WILL BE PERFORMED PER THE SITE SPECIFIC ACCESS ROAD DETAILS.
7. TEMPORARY ACCESS ROAD CROSSING OF STREAMS AND WETLANDS WILL UTILIZE TIMBERMATS. ANY PERMANENT ROAD CROSSINGS WILL BE CONDUCTED VIA CULVERTS.
8. ALL NON VMRC STREAM CROSSINGS WILL BE PERFORMED AS DESCRIBED IN THE STREAM CROSSING TABLE INCLUDED IN THIS PACKAGE.

TETRA TECH CAD FILE PATH: X:\CADD_Pittsburgh\EQT\7157 - MVP\15 - Franklin\E&S\ES Version 5.0.0\7157ES14.74(S10).dwg PLOTTED ON: 3/2/2018 5:06 PM PLOTTED BY: Zeigler, Justin PLOT FILE: ENVIRONMENTAL_COLOR.ctb

NO.	DATE:	DWN.:	CHKD.:	APPD.:	DESCRIPTION:
5	03/04/18	KAL	RE	DW	ADDRESS VADEQ COMMENTS
4	02/27/18	KAL	RE	DW	ADDRESS VADEQ COMMENTS
3	02/05/18	KAL	RE	DW	ADDRESS VADEQ COMMENTS
2	11/21/17	KAL	RE	DW	ADDRESS VADEQ COMMENTS
1	09/21/17	KAL	RE	DW	PLAN SUBMISSION

REVISIONS:

Mountain Valley PIPELINE

EROSION AND SEDIMENT CONTROL PLANS

MOUNTAIN VALLEY PIPELINE PROJECT – H600 LINE

SPREAD 10 – FRANKLIN COUNTY, VIRGINIA

MOUNTAIN VALLEY PIPELINE, LLC
555 SOUTHPOINTE BOULEVARD, SUITE 200
CANONSBURG, PA 15317

TETRA TECH
complex world | CLEAR SOLUTIONS™
661 ANDERSEN DRIVE
FOSTER PLAZA 7
PITTSBURGH, PA 15220

EROSION AND SEDIMENT CONTROL PLANS

COMMONWEALTH OF VIRGINIA
DAVID J. WALLNER
Lic. No. 0402057593
PROFESSIONAL ENGINEER


DRAWN BY:	KAL
CHECKED BY:	RE
APPROVED BY:	DW
DATE:	03/04/2018
SCALE:	AS SHOWN

REVISION

SHT. NO. 14.74ES OF 14.81ES

LOCATION MAP



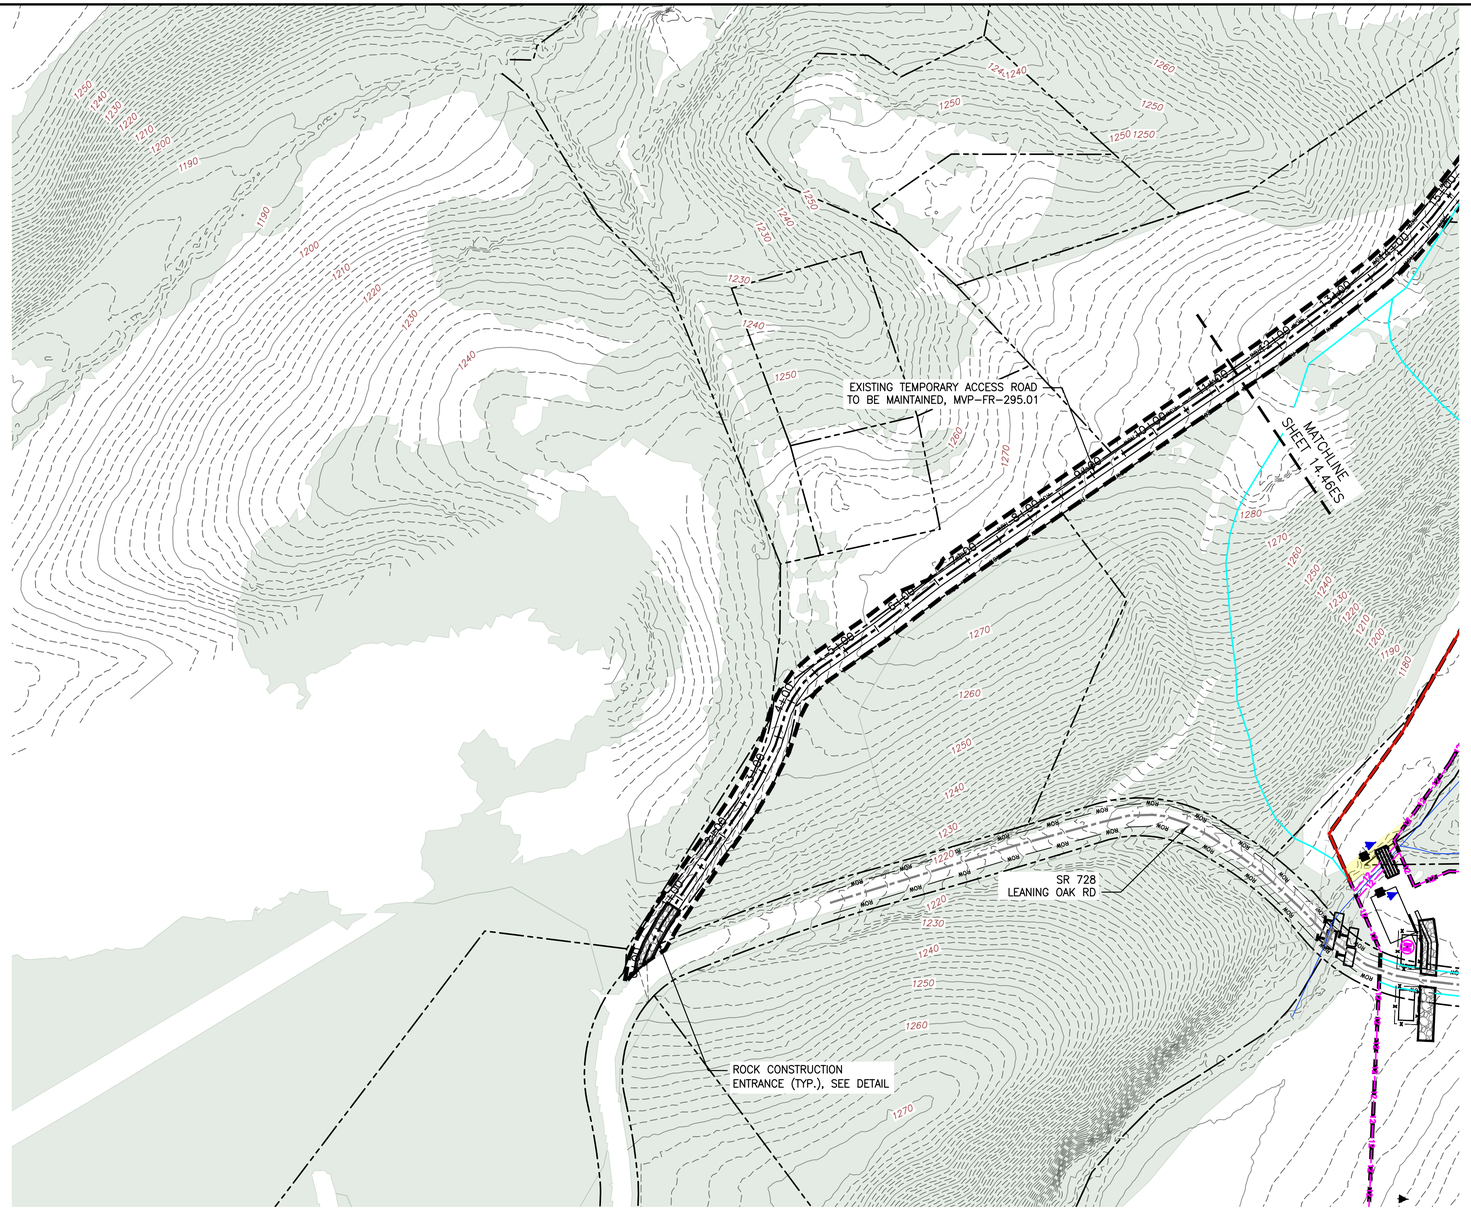

PLAN

SCALE: 1" = 100'

100 0 100 200

LEGEND

- PROPOSED LIMIT OF DISTURBANCE
- STREAM
- USDA FOREST SERVICE (NATIONAL FOREST) LANDS
- APPALACHIAN NATIONAL SCENIC TRAIL
- EXISTING ROAD/TRAIL
- EXISTING PROPERTY LINE
- EXISTING STATE LINE
- EXISTING COUNTY LINE
- POND
- WETLAND
- ACID FORMING MATERIAL
- EXISTING FOREST
- PROPOSED ACCESS ROAD CENTERLINE
- PROPOSED PIPELINE
- PROPOSED SILT FENCE (SEE NOTE 5)
- PROPOSED SUPER SILT FENCE (SEE DETAIL MVP-ES9.2)
- PROPOSED REINFORCED FILTRATION DEVICE (SEE DETAILS MVP-ES9, 9.1, 9.2, 9.3)
- ORANGE CONSTRUCTION SAFETY FENCE
- PROPOSED COMPOST FILTER SOCK (SEE DETAILS MVP-ES3, 3.1, 3.2)
- PROPOSED COMPOST FILTER SOCK (SEE DETAILS MVP-ES3, 3.1, 3.2)
- PROPOSED COMPOST FILTER SOCK (SEE DETAILS MVP-ES3, 3.1, 3.2)
- GRASS-LINED CHANNEL (SEE DETAIL MVP-ES39)
- CLEAN WATER DIVERSION PIPE
- CLEAN WATER DIVERSION DIKE (SEE DETAIL MVP-ES50 AND MVP-ES51)
- STREAM FLOW DIRECTION
- FEMA 100 YEAR FLOODPLAIN
- DRAINAGE AREA BOUNDARY
- TIMBER MAT (SEE DETAIL MVP-ES37)
- STEEP SLOPE EROSION CONTROL (SEE NOTE 2)
- STEEP SLOPE AREAS (SEE NOTE 4)
- PROPOSED ROCK CONSTRUCTION ENTRANCE
- PROPOSED TRENCH BREAKER (SEE DETAIL MVP-20)
- TEMPORARY ROW DIVERSION/WATER BAR (SEE DETAIL MVP-17)
- PERMANENT SLOPE BREAKER/ROW DIVERSION/WATER BAR (SEE DETAIL MVP-17)

NOTES:

1. TOPSOIL SEGREGATION WILL BE PERFORMED IN ALL IMMEDIATE CONSTRUCTION AREAS OF THE PROJECT IN ACCORDANCE WITH DETAILS MVP-ES46.1 THROUGH MVP-ES46.3.
2. FLEXTERRA, EARTHGUARD OR EQUIVALENT MAY BE USED AS A SUBSTITUTE TO EROSION CONTROL BLANKET AS DIRECTED BY MVP.
3. CONTRACTOR IS RESPONSIBLE TO IDENTIFY ALL UTILITIES. THE UTILITY LINES SHOWN ON THE PLAN ARE FOR INFORMATIONAL PURPOSES ONLY AND DO NOT REPRESENT SURVEYED LINE INFORMATION.
4. SLOPES OF 30' OR GREATER EXIST. CONSTRUCTION FOR STEEP SLOPES TO BE PERFORMED USING STEEP SLOPE TECHNIQUES IDENTIFIED IN THE DETAIL SHEETS. ALSO REFER TO THE SITE-SPECIFIC DESIGN OF STABILIZATION MEASURES IN SELECTED HIGH-HAZARD PORTIONS OF THE ROUTE OF THE PROPOSED MOUNTAIN VALLEY PIPLELINE PROJECT.
5. WHERE CONSTRUCTION CONDITIONS PRECLUDE THE USE OF DIVERSION DITCHES DUE TO SITE CONDITIONS THE CONTRACTOR WILL INSTALL SILT FENCE AT THE DIRECTION OF MVP.
6. IMPROVEMENTS TO PERMANENT AND TEMPORARY ACCESS ROADS WILL BE PERFORMED PER THE SITE SPECIFIC ACCESS ROAD DETAILS.
7. TEMPORARY ACCESS ROAD CROSSING OF STREAMS AND WETLANDS WILL UTILIZE TIMBERMATS. ANY PERMANENT ROAD CROSSINGS WILL BE CONDUCTED VIA CULVERTS.
8. ALL NON VMRC STREAM CROSSINGS WILL BE PERFORMED AS DESCRIBED IN THE STREAM CROSSING TABLE INCLUDED IN THIS PACKAGE.

NO.:	DATE:	DWN.:	CHKD.:	APPD.:	DESCRIPTION:
7	12/06/18	KAL	RE	DW	FIELD MODIFICATION
6	03/16/18	KAL	RE	DW	ADDRESS VADEQ COMMENTS
5	03/04/18	KAL	RE	DW	ADDRESS VADEQ COMMENTS
4	02/27/18	KAL	RE	DW	ADDRESS VADEQ COMMENTS
3	02/05/18	KAL	RE	DW	ADDRESS VADEQ COMMENTS
2	11/21/17	KAL	RE	DW	ADDRESS VADEQ COMMENTS

REVISIONS:

Mountain Valley PIPELINE

EROSION AND SEDIMENT CONTROL PLANS

MOUNTAIN VALLEY PIPELINE PROJECT – H600 LINE

SPREAD 10 – FRANKLIN COUNTY, VIRGINIA

MOUNTAIN VALLEY PIPELINE, LLC
2200 ENERGY DRIVE
CANONSBURG, PA 15317

TETRA TECH
complex world | CLEAR SOLUTIONS™
661 ANDERSEN DRIVE
FOSTER PLAZA 7
PITTSBURGH, PA 15220

EROSION AND SEDIMENT CONTROL PLANS

COMMONWEALTH OF VIRGINIA
DAVID J. WALLNER
Lic. No. 57593
12/6/2018
PROFESSIONAL ENGINEER


DRAWN BY:	JJZ
CHECKED BY:	RE
APPROVED BY:	DW
DATE:	12/06/2018
SCALE:	AS SHOWN
REVISION	

SHT. NO. 14.74AES OF 14.81ES

TETRA TECH CAD FILE PATH: X:\CADD_Pittsburgh\EQT\7157 – MVP\15 – Franklin\E&S\ES Version 5.0.0\Mod Revision\7157ES14.74A(S10).dwg PLOTTED ON: 11/10/2021 10:17 AM PLOTTED BY: Zeigler, Justin PLOT FILE: ENVIRONMENTAL_COLOR.ctb



LOCATION MAP

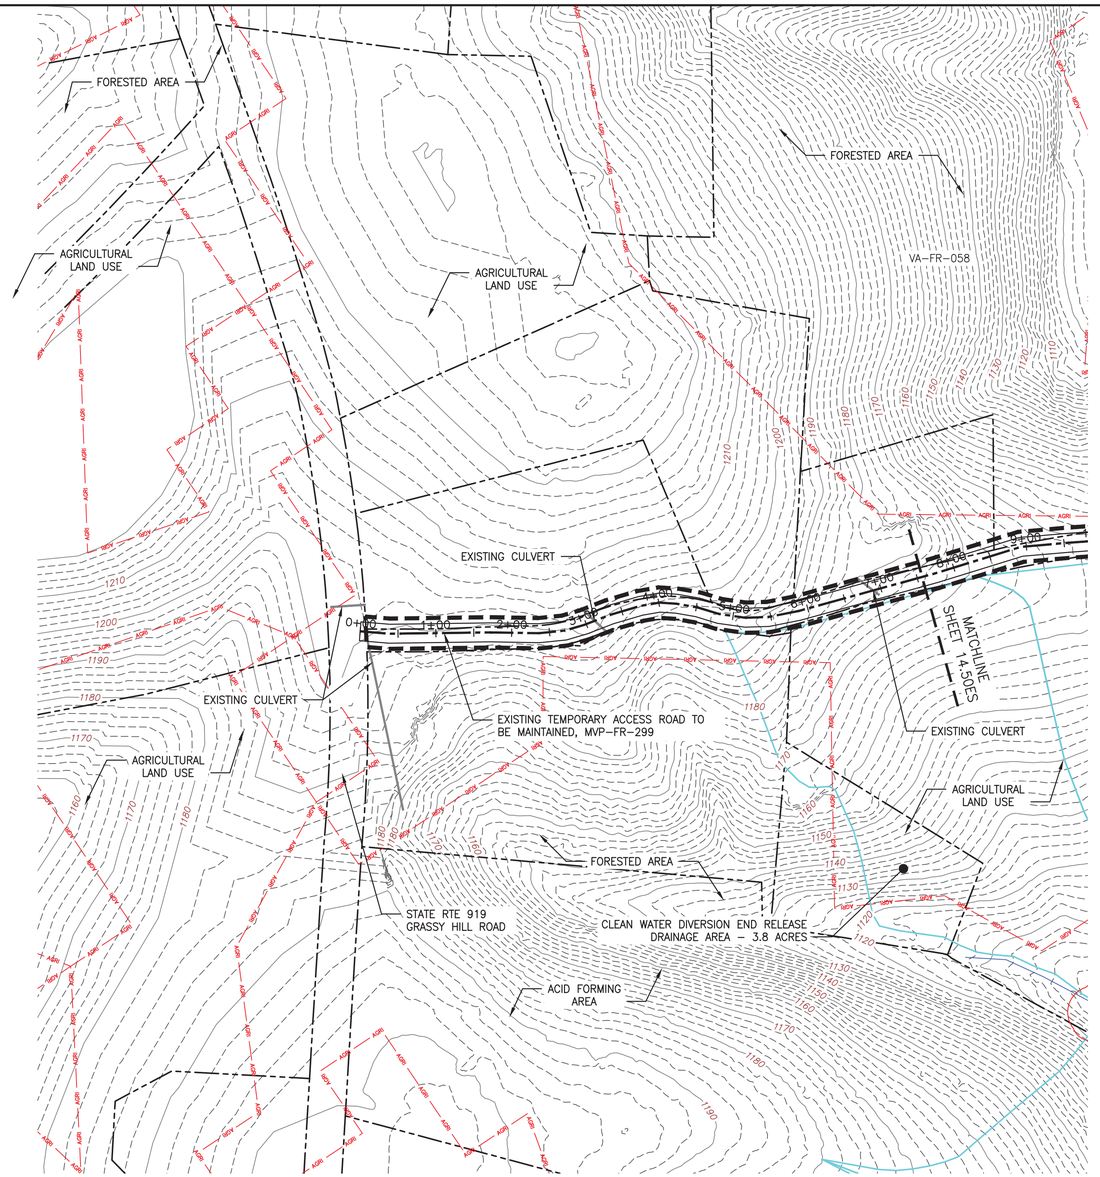

PLAN

SCALE: 1" = 100'

100 0 100 200

LEGEND

- PROPOSED LIMIT OF DISTURBANCE
- STREAM
- USDA FOREST SERVICE (NATIONAL FOREST) LANDS
- APPALACHIAN NATIONAL SCENIC TRAIL
- EXISTING ROAD/TRAIL
- EXISTING PROPERTY LINE
- EXISTING STATE LINE
- EXISTING COUNTY LINE
- POND
- WETLAND
- ACID FORMING MATERIAL
- AGRICULTURAL LAND USE BOUNDARY
- PROPOSED ACCESS ROAD CENTERLINE
- PROPOSED PIPELINE
- PROPOSED SILT FENCE (SEE NOTE 5)
- PROPOSED SUPER SILT FENCE (SEE DETAIL MVP-ES9.2)
- PROPOSED REINFORCED FILTRATION DEVICE (SEE DETAILS MVP-ES9, 9.1, 9.2, 9.3)
- ORANGE CONSTRUCTION SAFETY FENCE
- PROPOSED COMPOST FILTER SOCK (SEE DETAILS MVP-ES3, 3.1, 3.2)
- PROPOSED COMPOST FILTER SOCK (SEE DETAILS MVP-ES3, 3.1, 3.2)
- PROPOSED COMPOST FILTER SOCK (SEE DETAILS MVP-ES3, 3.1, 3.2)
- GRASS-LINED CHANNEL (SEE DETAIL MVP-ES39)
- CLEAN WATER DIVERSION PIPE
- CLEAN WATER DIVERSION DIKE (SEE DETAIL MVP-ES50 AND MVP-ES51)
- STREAM FLOW DIRECTION
- FEMA 100 YEAR FLOODPLAIN
- DRAINAGE AREA BOUNDARY
- TIMBER MAT (SEE DETAIL MVP-ES37)
- STEEP SLOPE EROSION CONTROL (SEE NOTE 2)
- STEEP SLOPE AREAS (SEE NOTE 4)
- PROPOSED ROCK CONSTRUCTION ENTRANCE
- PROPOSED TRENCH BREAKER (SEE DETAIL MVP-20)
- TEMPORARY ROW DIVERSION/WATER BAR (VADEQ STD & SPEC 3.11)
- PERMANENT SLOPE BREAKER/ROW DIVERSION/WATER BAR (SEE DETAILS MVP-17, ES38, AND SCHEDULE)

NOTES:

1. TOPSOIL SEGREGATION WILL BE PERFORMED IN ALL IMMEDIATE CONSTRUCTION AREAS OF THE PROJECT IN ACCORDANCE WITH DETAILS MVP-ES46.1 THROUGH MVP-ES46.3.
2. FLEXTERRA, EARTHGUARD OR EQUIVALENT MAY BE USED AS A SUBSTITUTE TO EROSION CONTROL BLANKET AS DIRECTED BY MVP.
3. CONTRACTOR IS RESPONSIBLE TO IDENTIFY ALL UTILITIES. THE UTILITY LINES SHOWN ON THE PLAN ARE FOR INFORMATIONAL PURPOSES ONLY AND DO NOT REPRESENT SURVEYED LINE INFORMATION.
4. SLOPES OF 30° OR GREATER EXIST. CONSTRUCTION FOR STEEP SLOPES TO BE PERFORMED USING STEEP SLOPE TECHNIQUES IDENTIFIED IN THE DETAIL SHEETS. ALSO REFER TO THE SITE-SPECIFIC DESIGN OF STABILIZATION MEASURES IN SELECTED HIGH-HAZARD PORTIONS OF THE ROUTE OF THE PROPOSED MOUNTAIN VALLEY PIPELINE PROJECT.
5. WHERE CONSTRUCTION CONDITIONS PRECLUDE THE USE OF DIVERSION DITCHES DUE TO SITE CONDITIONS THE CONTRACTOR WILL INSTALL SILT FENCE AT THE DIRECTION OF MVP.
6. IMPROVEMENTS TO PERMANENT AND TEMPORARY ACCESS ROADS WILL BE PERFORMED PER THE SITE SPECIFIC ACCESS ROAD DETAILS.
7. TEMPORARY ACCESS ROAD CROSSING OF STREAMS AND WETLANDS WILL UTILIZE TIMBERMATS. ANY PERMANENT ROAD CROSSINGS WILL BE CONDUCTED VIA CULVERTS.
8. ALL NON VMRC STREAM CROSSINGS WILL BE PERFORMED AS DESCRIBED IN THE STREAM CROSSING TABLE INCLUDED IN THIS PACKAGE.

N

NO.	DATE:	DWN.:	CHKD.:	APPD.:	DESCRIPTION:
5	03/04/18	KAL	RE	DW	ADDRESS VADEQ COMMENTS
4	02/27/18	KAL	RE	DW	ADDRESS VADEQ COMMENTS
3	02/05/18	KAL	RE	DW	ADDRESS VADEQ COMMENTS
2	11/21/17	KAL	RE	DW	ADDRESS VADEQ COMMENTS
1	09/21/17	KAL	RE	DW	PLAN SUBMISSION

REVISIONS:

Mountain Valley PIPELINE

EROSION AND SEDIMENT CONTROL PLANS

MOUNTAIN VALLEY PIPELINE PROJECT – H600 LINE

SPREAD 10 – FRANKLIN COUNTY, VIRGINIA

MOUNTAIN VALLEY PIPELINE, LLC
555 SOUTHPOINTE BOULEVARD, SUITE 200
CANONSBURG, PA 15317

TETRA TECH
complex world | CLEAR SOLUTIONS™
661 ANDERSEN DRIVE
FOSTER PLAZA 7
PITTSBURGH, PA 15220

EROSION AND SEDIMENT CONTROL PLANS


COMMONWEALTH OF VIRGINIA
DAVID J. WALLNER
Lic. No. 0402057593
PROFESSIONAL ENGINEER

DRAWN BY:	KAL
CHECKED BY:	RE
APPROVED BY:	DW
DATE:	03/04/2018
SCALE:	AS SHOWN
REVISION	5
SHT. NO.	14.75ES OF 14.81ES

TETRA TECH CAD FILE PATH: X:\CADD_Pittsburgh\EQT\7157 – MVP\15 – Franklin\E&S\ES Version 5.0.0\7157ES14.75(S10).dwg PLOTTED ON: 3/2/2018 5:08 PM PLOTTED BY: Zeigler, Justin PLOT FILE: ENVIRONMENTAL_COLOR.ctb

LOCATION MAP



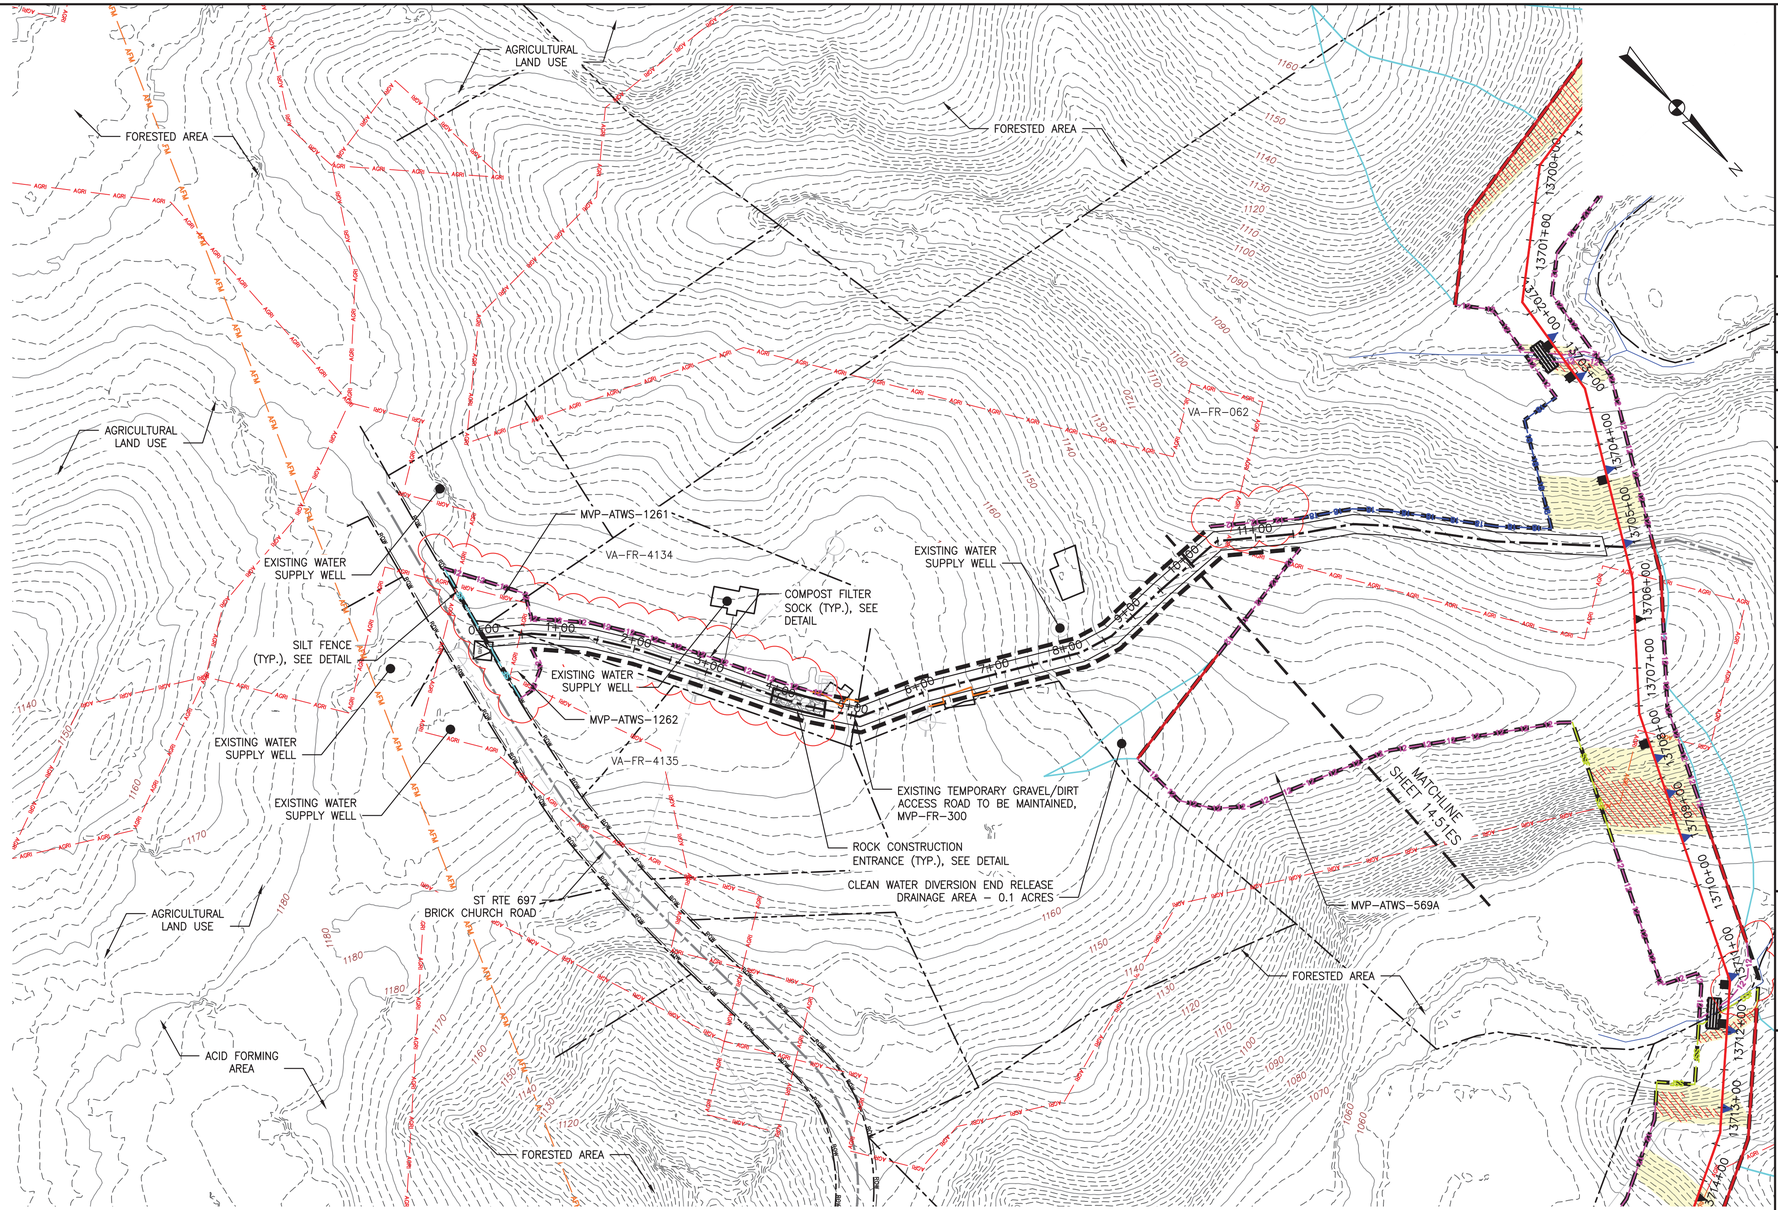

PLAN

SCALE: 1" = 100'

100 0 100 200

LEGEND

- PROPOSED LIMIT OF DISTURBANCE
- STREAM
- USDA FOREST SERVICE (NATIONAL FOREST) LANDS
- APPALACHIAN NATIONAL SCENIC TRAIL (ANST)
- EXISTING ROAD/TRAIL
- EXISTING PROPERTY LINE
- EXISTING STATE LINE
- EXISTING COUNTY LINE
- POND
- WETLAND
- ACID FORMING MATERIAL (AFM)
- AGRICULTURAL LAND USE BOUNDARY (AGRI)
- PROPOSED ACCESS ROAD CENTERLINE
- PROPOSED PIPELINE
- PROPOSED SILT FENCE (SEE NOTE 5) (SF)
- PROPOSED SUPER SILT FENCE (SEE DETAIL MVP-ES9.2) (SSF)
- PROPOSED REINFORCED FILTRATION DEVICE (SEE DETAILS MVP-ES9, 9.1, 9.2, 9.3) (RFD)
- ORANGE CONSTRUCTION SAFETY FENCE (OCSF)
- PROPOSED COMPOST FILTER SOCK (SEE DETAILS MVP-ES3, 3.1, 3.2) (12)
- PROPOSED COMPOST FILTER SOCK (SEE DETAILS MVP-ES3, 3.1, 3.2) (18)
- PROPOSED COMPOST FILTER SOCK (SEE DETAILS MVP-ES3, 3.1, 3.2) (24)
- GRASS-LINED CHANNEL (SEE DETAIL MVP-ES39)
- CLEAN WATER DIVERSION PIPE
- CLEAN WATER DIVERSION DIKE (SEE DETAIL MVP-ES50 AND MVP-ES51)
- STREAM FLOW DIRECTION
- FEMA 100 YEAR FLOODPLAIN
- DRAINAGE AREA BOUNDARY
- TIMBER MAT (SEE DETAIL MVP-ES37)
- STEEP SLOPE EROSION CONTROL (SEE NOTE 2)
- STEEP SLOPE AREAS (SEE NOTE 4)
- PROPOSED ROCK CONSTRUCTION ENTRANCE
- PROPOSED TRENCH BREAKER (SEE DETAIL MVP-20)
- TEMPORARY ROW DIVERSION/WATER BAR (VADEQ STD & SPEC 3.11)
- PERMANENT SLOPE BREAKER/ROW DIVERSION/WATER BAR (SEE DETAILS MVP-17, ES38, AND SCHEDULE)

NOTES:

1. TOPSOIL SEGREGATION WILL BE PERFORMED IN ALL IMMEDIATE CONSTRUCTION AREAS OF THE PROJECT IN ACCORDANCE WITH DETAILS MVP-ES46.1 THROUGH MVP-ES46.3.
2. FLEXTERRA, EARTHGUARD OR EQUIVALENT MAY BE USED AS A SUBSTITUTE TO EROSION CONTROL BLANKET AS DIRECTED BY MVP.
3. CONTRACTOR IS RESPONSIBLE TO IDENTIFY ALL UTILITIES. THE UTILITY LINES SHOWN ON THE PLAN ARE FOR INFORMATIONAL PURPOSES ONLY AND DO NOT REPRESENT SURVEYED LINE INFORMATION.
4. SLOPES OF 30° OR GREATER EXIST. CONSTRUCTION FOR STEEP SLOPES TO BE PERFORMED USING STEEP SLOPE TECHNIQUES IDENTIFIED IN THE DETAIL SHEETS. ALSO REFER TO THE SITE-SPECIFIC DESIGN OF STABILIZATION MEASURES IN SELECTED HIGH-HAZARD PORTIONS OF THE ROUTE OF THE PROPOSED MOUNTAIN VALLEY PIPELINE PROJECT.
5. WHERE CONSTRUCTION CONDITIONS PRECLUDE THE USE OF DIVERSION DITCHES DUE TO SITE CONDITIONS THE CONTRACTOR WILL INSTALL SILT FENCE AT THE DIRECTION OF MVP.
6. IMPROVEMENTS TO PERMANENT AND TEMPORARY ACCESS ROADS WILL BE PERFORMED PER THE SITE SPECIFIC ACCESS ROAD DETAILS.
7. TEMPORARY ACCESS ROAD CROSSING OF STREAMS AND WETLANDS WILL UTILIZE TIMBERMATS. ANY PERMANENT ROAD CROSSINGS WILL BE CONDUCTED VIA CULVERTS.
8. ALL NON VMRC STREAM CROSSINGS WILL BE PERFORMED AS DESCRIBED IN THE STREAM CROSSING TABLE INCLUDED IN THIS PACKAGE.

REVISIONS:

NO.	DATE:	DWN.:	CHKD.:	APPD.:	DESCRIPTION:
5	03/04/18	KAL	RE	DW	ADDRESS VADEQ COMMENTS
4	02/27/18	KAL	RE	DW	ADDRESS VADEQ COMMENTS
3	02/05/18	KAL	RE	DW	ADDRESS VADEQ COMMENTS
2	11/21/17	KAL	RE	DW	ADDRESS VADEQ COMMENTS
1	09/21/17	KAL	RE	DW	PLAN SUBMISSION

Mountain Valley PIPELINE

EROSION AND SEDIMENT CONTROL PLANS

MOUNTAIN VALLEY PIPELINE PROJECT – H600 LINE

SPREAD 10 – FRANKLIN COUNTY, VIRGINIA

TETRA TECH

complex world | CLEAR SOLUTIONS™

661 ANDERSEN DRIVE
FOSTER PLAZA 7
PITTSBURGH, PA 15220

MOUNTAIN VALLEY PIPELINE, LLC
555 SOUTHPOINTE BOULEVARD, SUITE 200
CANONSBURG, PA 15317

EROSION AND SEDIMENT CONTROL PLANS


COMMONWEALTH OF VIRGINIA
DAVID J. WALLNER
Lic. No. 0402057593
PROFESSIONAL ENGINEER

DRAWN BY:	KAL
CHECKED BY:	RE
APPROVED BY:	DW
DATE:	03/04/2018
SCALE:	AS SHOWN

REVISION

SHT. NO. 14.76ES OF 14.81ES

TETRA TECH CAD FILE PATH: X:\CADD_Pittsburgh\EQT\7157 – MVP\15 – Franklin\E&S\ES Version 5.0.0\7157ES14.76(S10).dwg PLOTTED ON: 3/2/2018 5:10 PM PLOTTED BY: Zeigler, Justin PLOT FILE: ENVIRONMENTAL_COLOR.ctb

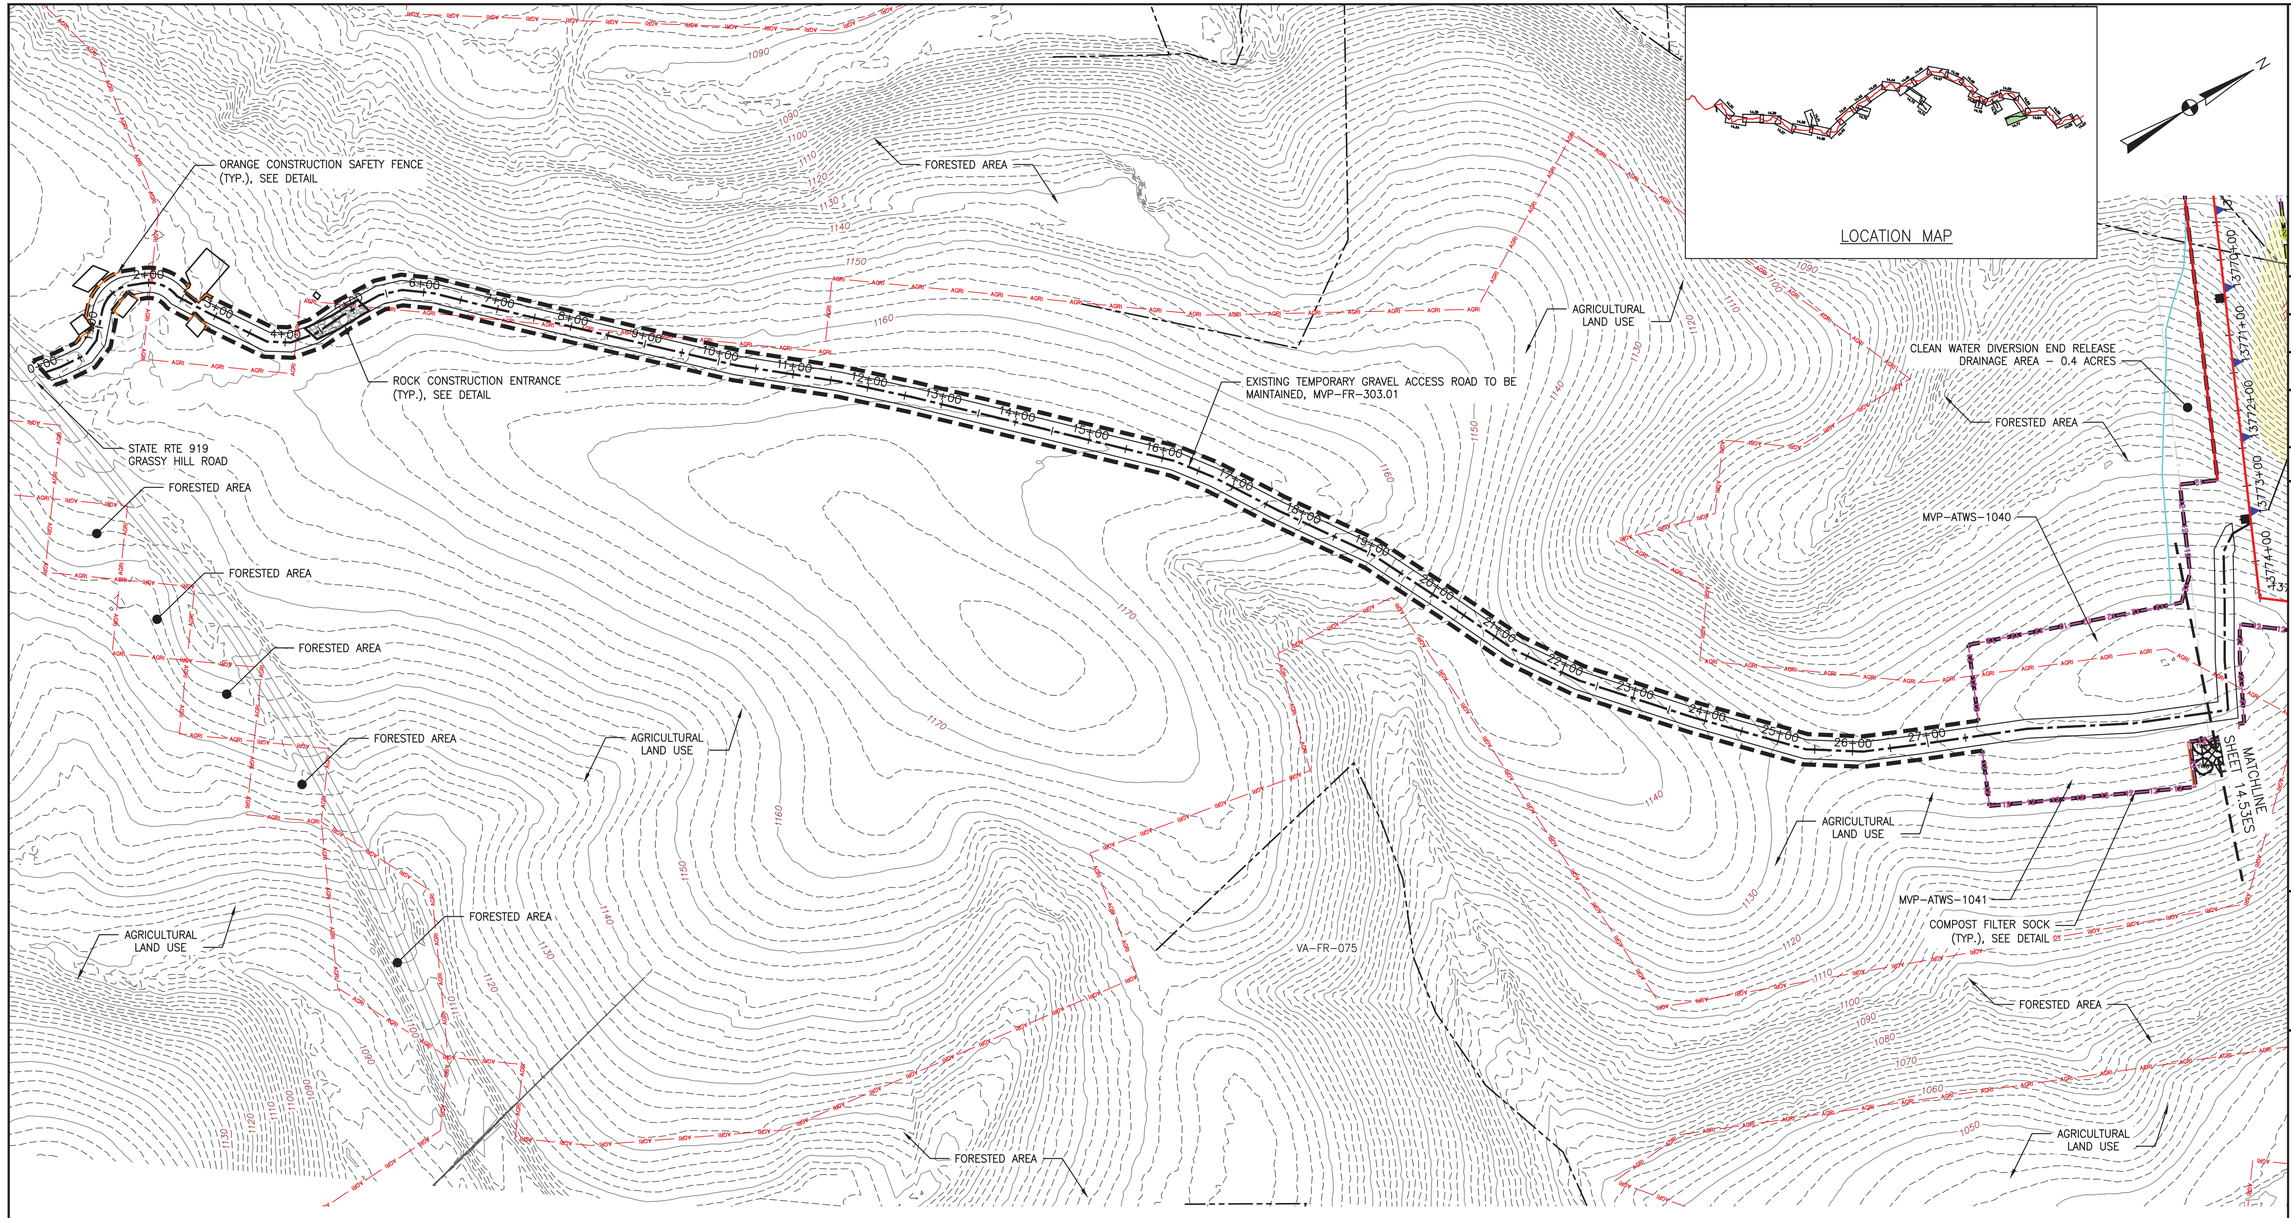

LEGEND

- PROPOSED LIMIT OF DISTURBANCE
- STREAM
- USDA FOREST SERVICE (NATIONAL FOREST) LANDS
- APPALACHIAN NATIONAL SCENIC TRAIL
- EXISTING ROAD/TRAIL
- EXISTING PROPERTY LINE
- EXISTING STATE LINE
- EXISTING COUNTY LINE
- POND
- WETLAND
- ACID FORMING MATERIAL
- AGRICULTURAL LAND USE BOUNDARY
- PROPOSED ACCESS ROAD CENTERLINE
- PROPOSED PIPELINE
- PROPOSED SILT FENCE (SEE NOTE 5)
- PROPOSED SUPER SILT FENCE (SEE DETAIL MVP-ES9.2)
- PROPOSED REINFORCED FILTRATION DEVICE (SEE DETAILS MVP-ES9, 9.1, 9.2, 9.3)
- ORANGE CONSTRUCTION SAFETY FENCE
- PROPOSED COMPOST FILTER SOCK (SEE DETAILS MVP-ES3, 3.1, 3.2)
- PROPOSED COMPOST FILTER SOCK (SEE DETAILS MVP-ES3, 3.1, 3.2)
- PROPOSED COMPOST FILTER SOCK (SEE DETAILS MVP-ES3, 3.1, 3.2)
- GRASS-LINED CHANNEL (SEE DETAIL MVP-ES39)
- CLEAN WATER DIVERSION PIPE
- CLEAN WATER DIVERSION DIKE (SEE DETAIL MVP-ES50 AND MVP-ES51)

PLAN

SCALE: 1" = 100'

100 0 100 200

- STREAM FLOW DIRECTION
- FEMA 100 YEAR FLOODPLAIN
- DRAINAGE AREA BOUNDARY
- TIMBER MAT (SEE DETAIL MVP-ES37)
- STEEP SLOPE EROSION CONTROL (SEE NOTE 2)
- STEEP SLOPE AREAS (SEE NOTE 4)
- PROPOSED ROCK CONSTRUCTION ENTRANCE
- PROPOSED TRENCH BREAKER (SEE DETAIL MVP-20)
- TEMPORARY ROW DIVERSION/WATER BAR (VADEQ STD & SPEC 3.11)
- PERMANENT SLOPE BREAKER/ROW DIVERSION/WATER BAR (SEE DETAILS MVP-17, ES38, AND SCHEDULE)

NOTES:

1. TOPSOIL SEGREGATION WILL BE PERFORMED IN ALL IMMEDIATE CONSTRUCTION AREAS OF THE PROJECT IN ACCORDANCE WITH DETAILS MVP-ES46.1 THROUGH MVP-ES46.3.
2. FLEXTERRA, EARTHGUARD OR EQUIVALENT MAY BE USED AS A SUBSTITUTE TO EROSION CONTROL BLANKET AS DIRECTED BY MVP.
3. CONTRACTOR IS RESPONSIBLE TO IDENTIFY ALL UTILITIES. THE UTILITY LINES SHOWN ON THE PLAN ARE FOR INFORMATIONAL PURPOSES ONLY AND DO NOT REPRESENT SURVEYED LINE INFORMATION.
4. SLOPES OF 30' OR GREATER EXIST. CONSTRUCTION FOR STEEP SLOPES TO BE PERFORMED USING STEEP SLOPE TECHNIQUES IDENTIFIED IN THE DETAIL SHEETS. ALSO REFER TO THE SITE-SPECIFIC DESIGN OF STABILIZATION MEASURES IN SELECTED HIGH-HAZARD PORTIONS OF THE ROUTE OF THE PROPOSED MOUNTAIN VALLEY PIPELINE PROJECT.
5. WHERE CONSTRUCTION CONDITIONS PRECLUDE THE USE OF DIVERSION DITCHES DUE TO SITE CONDITIONS THE CONTRACTOR WILL INSTALL SILT FENCE AT THE DIRECTION OF MVP.
6. IMPROVEMENTS TO PERMANENT AND TEMPORARY ACCESS ROADS WILL BE PERFORMED PER THE SITE SPECIFIC ACCESS ROAD DETAILS.
7. TEMPORARY ACCESS ROAD CROSSING OF STREAMS AND WETLANDS WILL UTILIZE TIMBERMATS. ANY PERMANENT ROAD CROSSINGS WILL BE CONDUCTED VIA CULVERTS.
8. ALL NON VMRC STREAM CROSSINGS WILL BE PERFORMED AS DESCRIBED IN THE STREAM CROSSING TABLE INCLUDED IN THIS PACKAGE.

NO.	DATE:	DWN.:	CHKD.:	APPD.:	DESCRIPTION:
5	03/04/18	KAL	RE	DW	ADDRESS VADEQ COMMENTS
4	02/27/18	KAL	RE	DW	ADDRESS VADEQ COMMENTS
3	02/05/18	KAL	RE	DW	ADDRESS VADEQ COMMENTS
2	11/21/17	KAL	RE	DW	ADDRESS VADEQ COMMENTS
1	09/21/17	KAL	RE	DW	PLAN SUBMISSION

REVISIONS:

Mountain Valley PIPELINE

EROSION AND SEDIMENT CONTROL PLANS
MOUNTAIN VALLEY PIPELINE PROJECT – H600 LINE
SPREAD 10 – FRANKLIN COUNTY, VIRGINIA

MOUNTAIN VALLEY PIPELINE, LLC
555 SOUTHPOINTE BOULEVARD, SUITE 200
CANONSBURG, PA 15317

TETRA TECH
complex world | CLEAR SOLUTIONS™
661 ANDERSEN DRIVE
FOSTER PLAZA 7
PITTSBURGH, PA 15220


EROSION AND SEDIMENT CONTROL PLANS

COMMONWEALTH OF VIRGINIA
DAVID J. WALLNER
Lic. No. 0402057593
PROFESSIONAL ENGINEER

DRAWN BY:	KAL
CHECKED BY:	RE
APPROVED BY:	DW
DATE:	03/04/2018
SCALE:	AS SHOWN
SHT. NO.	14.77ES OF 14.81ES


REVISION

TETRA TECH CAD FILE PATH: X:\CADD_Pittsburgh\EQT\7157 – MVP\15 – Franklin\E&S\ES Version 5.0.0\7157ES14.77(S10).dwg PLOTTED ON: 3/2/2018 5:11 PM PLOTTED BY: Zeigler, Justin PLOT FILE: ENVIRONMENTAL_COLOR.ctb

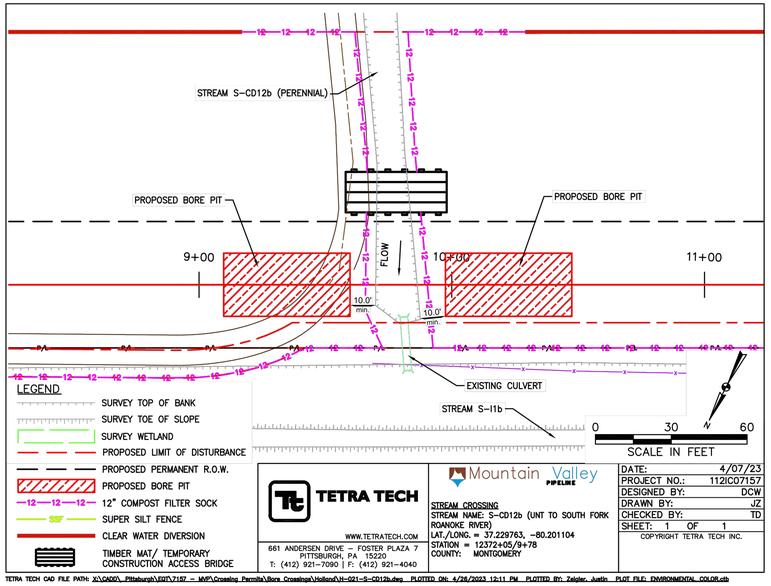


TETRA TECH CAD FILE PATH: X:\CADD_ Pittsburgh\EQT\7157 - MVP\Crossing Permits\Bore Crossings\Holland\H-021-S-CD12b.dwg PLOTTED ON: 4/26/2023 12:11 PM PLOTTED BY: Zeigler, Justin PLOT FILE: ENVIRONMENTAL_COLOR.ctb

BORE PIT STREAM CROSSING S-CD12B
CROSSING ID H-021
PLAN VIEW

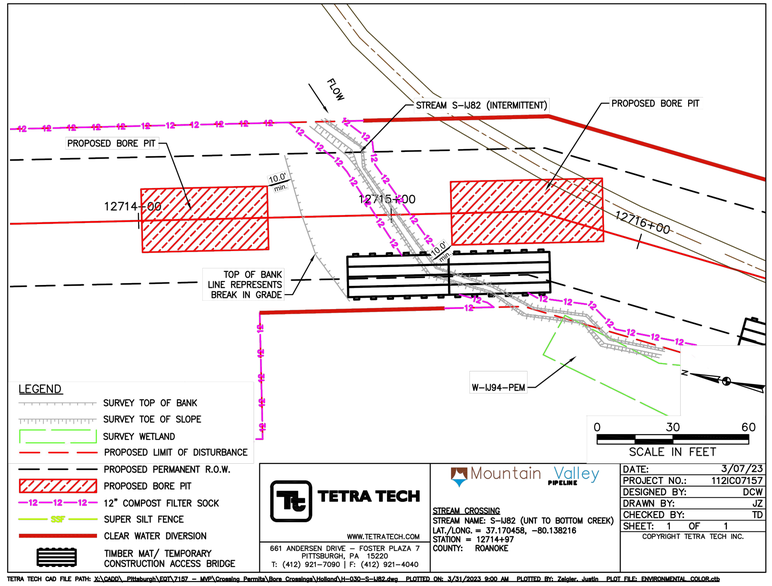


TETRA TECH CAD FILE PATH: X:\CADD_ Pittsburgh\EQT\7157 - MVP\Crossing Permits\Bore Crossings\Holland\H-030-S-IJ82.dwg PLOTTED ON: 3/31/2023 9:00 AM PLOTTED BY: Zeigler, Justin PLOT FILE: ENVIRONMENTAL_COLOR.ctb

BORE PIT STREAM CROSSING S-IJ82
CROSSING ID H-030
PLAN VIEW

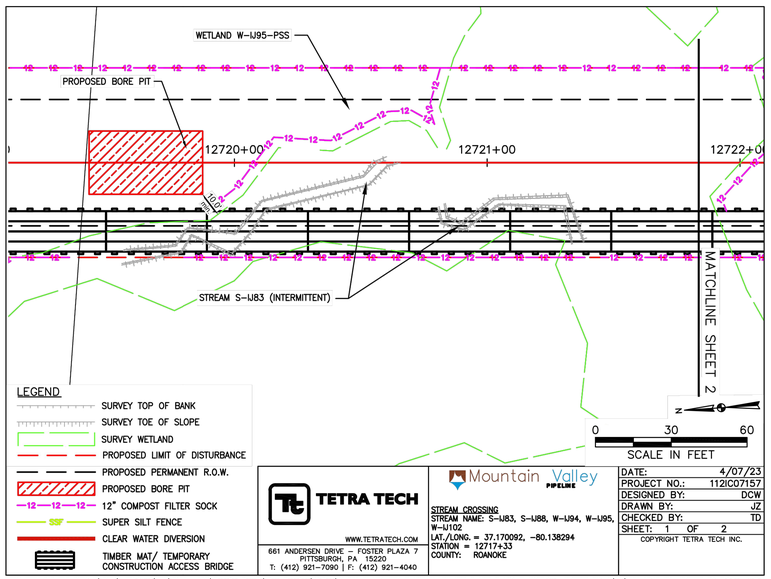

TETRA TECH CAD FILE PATH: X:\CADD_ Pittsburgh\EQT\7157 - MVP\Crossing Permits\Bore Crossings\Holland\H-031-W-IJ94-PEM-S-IJ83-W-IJ95-PSS-S-IJ88-S-IJ84-W-IJ102.dwg PLOTTED ON: 4/26/2023 12:12 PM PLOTTED BY: Zeigler, Justin PLOT FILE:

BORE PIT STREAM CROSSING S-IJ83, S-IJ88, W-IJ95, W-IJ102
CROSSING ID H-031
PLAN VIEW

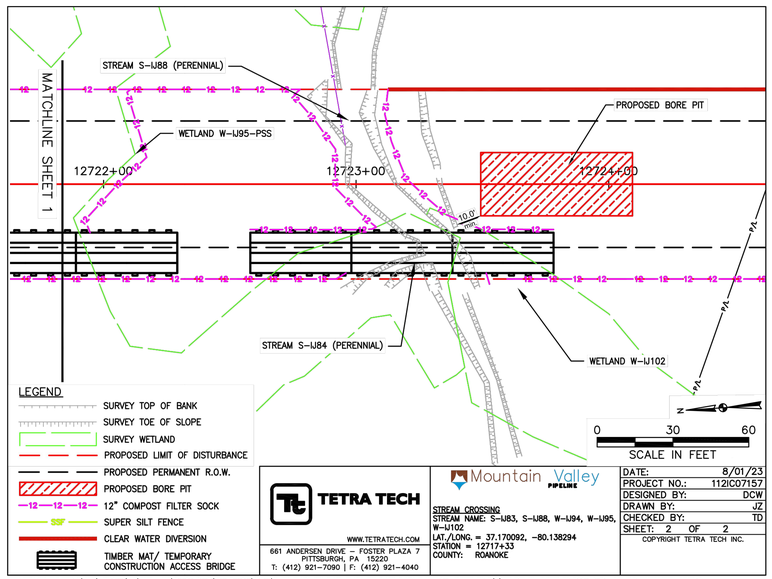

TETRA TECH CAD FILE PATH: X:\CADD_ Pittsburgh\EQT\7157 - MVP\Crossing Permits\Bore Crossings\Holland\Holland\H-031-W-IJ94-PEM-S-IJ83-W-IJ95-PSS-S-IJ88-S-IJ84-W-IJ102.dwg PLOTTED ON: 8/2/2023 8:03 AM PLOTTED BY: Zeigler, Justin PLOT FILE: ENVIRONMENTAL_COLOR.ctb

BORE PIT STREAM CROSSING S-IJ83, S-IJ88, W-IJ95, W-IJ102
CROSSING ID H-031
PLAN VIEW

NO.:	DATE:	DWN.:	CHKD.:	APPD.:	DESCRIPTION:
-	08/01/23	JJZ	IHH	DCW	ADDRESS VADEQ COMMENTS ON BORE PITS
-	06/16/23	JJZ	IHH	DCW	ADDRESS VADEQ COMMENTS ON BORE PITS
-	04/07/23	JJZ	TD	DCW	BORE CROSSING PERMITS

REVISIONS:

Mountain Valley PIPELINE

EROSION AND SEDIMENT CONTROL PLANS

MOUNTAIN VALLEY PIPELINE PROJECT - H600 LINE

SPREAD 10 - MONTGOMERY - ROANOKE - FRANKLIN COUNTY, VIRGINIA

MOUNTAIN VALLEY PIPELINE, LLC
2200 ENERGY DRIVE
CANONSBURG, PA 15317


TETRA TECH
complex world | CLEAR SOLUTIONS™
661 ANDERSEN DRIVE
FOSTER PLAZA 7
PITTSBURGH, PA 15220

EROSION AND SEDIMENT CONTROL PLANS

COMMONWEALTH OF VIRGINIA
8/1/23
DANIEL C. WITT
Lic. No. 65093
PROFESSIONAL ENGINEER


DRAWN BY:	JZ
CHECKED BY:	IHH
APPROVED BY:	DCW
DATE:	08/01/2023
SCALE:	AS SHOWN
REVISION	1
SHT. NO.	14.82AES OF 14.82ES

TETRA TECH CAD FILE PATH: X:\CADD_ Pittsburgh\EQT\7157 - MVP\Crossing Permits\Bore Crossings\Holland\Figures\Spread 10\7157ES14.82AES.dwg PLOTTED ON: 8/2/2023 8:23 AM PLOTTED BY: Zeigler, Justin PLOT FILE: ENVIRONMENTAL_COLOR.ctb

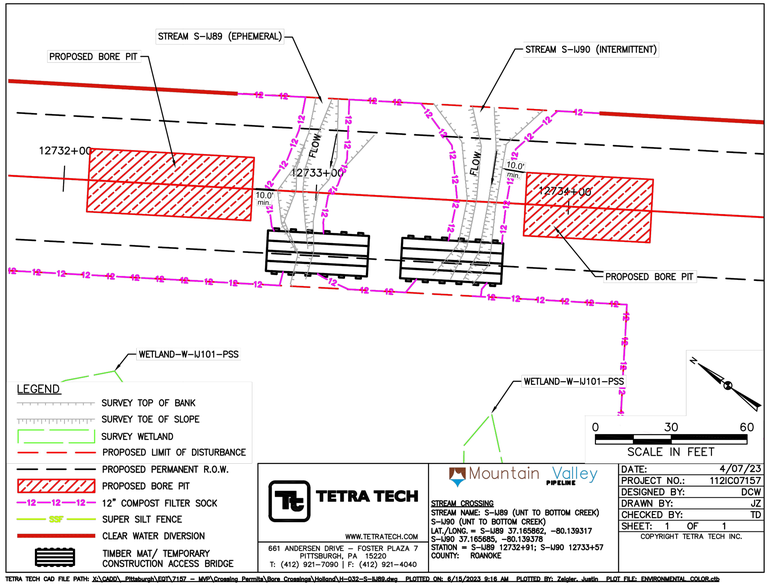


TETRA TECH CAD FILE PATH: X:\CADD_Pittsburgh\EQT\7157 - MVP\Crossing Permits\Bore Crossings\Holland\H-032-S-IJ89.dwg PLOTTED ON: 6/15/2023 8:16 AM PLOTTED BY: Zeigler, Justin PLOT FILE: ENVIRONMENTAL_COLOR.ctb

BORE PIT STREAM CROSSING S-IJ90, S-IJ89
CROSSING ID H-032
PLAN VIEW

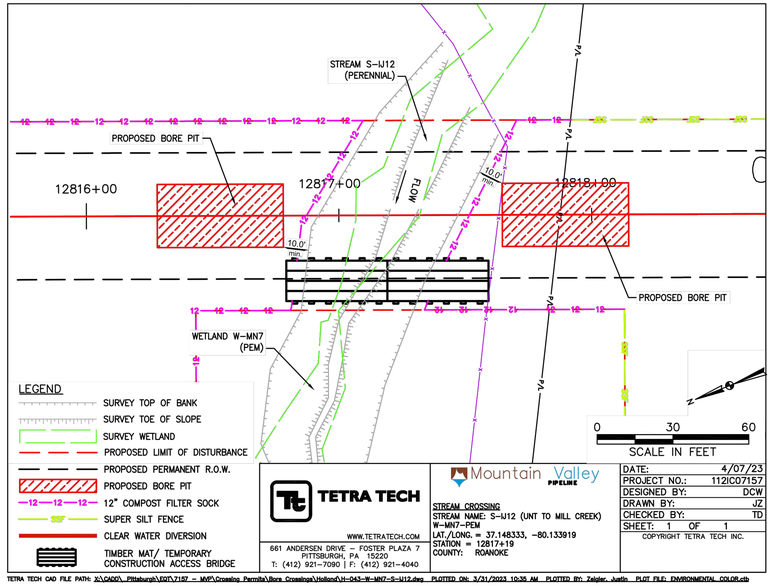


TETRA TECH CAD FILE PATH: X:\CADD_Pittsburgh\EQT\7157 - MVP\Crossing Permits\Bore Crossings\Holland\H-043-W-MN7-S-IJ12.dwg PLOTTED ON: 3/31/2023 10:38 AM PLOTTED BY: Zeigler, Justin PLOT FILE: ENVIRONMENTAL_COLOR.ctb

BORE PIT STREAM CROSSING S-IJ12, W-MN7
CROSSING ID H-043
PLAN VIEW

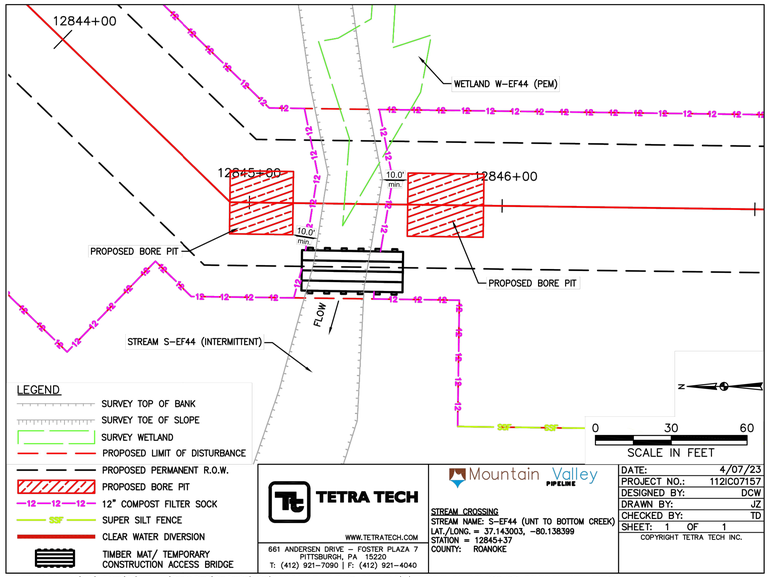

TETRA TECH CAD FILE PATH: X:\CADD_Pittsburgh\EQT\7157 - MVP\Crossing Permits\Bore Crossings\Holland\Figures\H-044-S-EF44-W-EF44-PEM.dwg PLOTTED ON: 3/31/2023 10:47 AM PLOTTED BY: Zeigler, Justin PLOT FILE: ENVIRONMENTAL_COLOR.ctb

BORE PIT STREAM CROSSING S-EF44, W-EF44
CROSSING ID H-044
PLAN VIEW

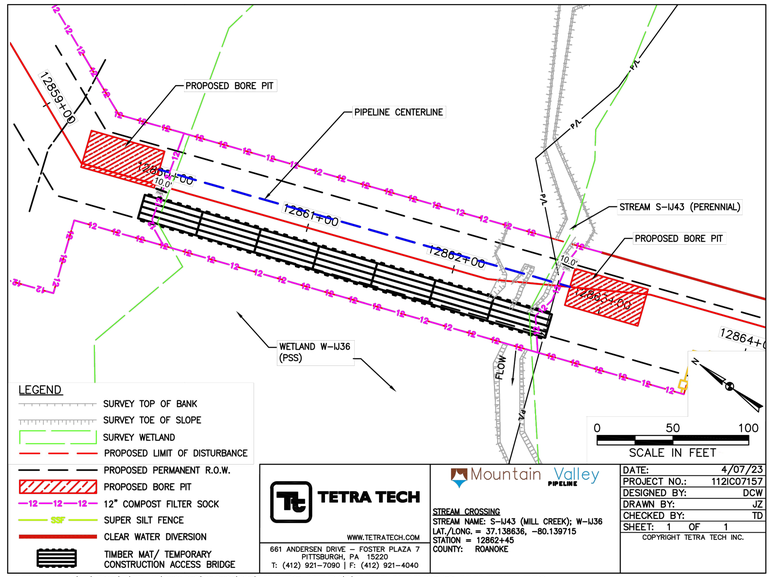

TETRA TECH CAD FILE PATH: X:\CADD_Pittsburgh\EQT\7157 - MVP\Crossing Permits\Bore Crossings\Holland\H-045-W-IJ36.dwg PLOTTED ON: 4/28/2023 12:15 PM PLOTTED BY: Zeigler, Justin PLOT FILE: ENVIRONMENTAL_COLOR.ctb

BORE PIT STREAM CROSSING S-IJ43, W-IJ36
CROSSING ID H-045
PLAN VIEW

NO.:	DATE:	DWN.:	CHKD.:	APPD.:	DESCRIPTION:
-	06/16/23	JJZ	HH	DCW	ADDRESS VAQEG COMMENTS ON BORE PITS
-	04/07/23	JJZ	TD	DCW	BORE CROSSING PERMITS

REVISIONS:

Mountain Valley PIPELINE

EROSION AND SEDIMENT CONTROL PLANS
MOUNTAIN VALLEY PIPELINE PROJECT - H600 LINE
SPREAD 10 - MONTGOMERY - ROANOKE - FRANKLIN COUNTY, VIRGINIA

MOUNTAIN VALLEY PIPELINE, LLC
2200 ENERGY DRIVE
CANONSBURG, PA 15317


TETRA TECH
complex world | CLEAR SOLUTIONS™
661 ANDERSEN DRIVE
FOSTER PLAZA 7
PITTSBURGH, PA 15220

EROSION AND SEDIMENT CONTROL PLANS

COMMONWEALTH OF VIRGINIA
6/16/23
DANIEL C. WITT
Lic. No. 65093
PROFESSIONAL ENGINEER

DRAWN BY:	JZ
CHECKED BY:	IHH
APPROVED BY:	DCW
DATE:	06/16/2023
SCALE:	AS SHOWN
REVISION	1
SHT. NO.	14.82BES OF 14.82ES


TETRA TECH CAD FILE PATH: X:\CADD_Pittsburgh\EQT\7157 - MVP\Crossing Permits\Bore Crossings\Holland\Figures\Spread 10\7157ES14.82BES.dwg PLOTTED ON: 6/15/2023 9:17 AM PLOTTED BY: Zeigler, Justin PLOT FILE: ENVIRONMENTAL_COLOR.ctb

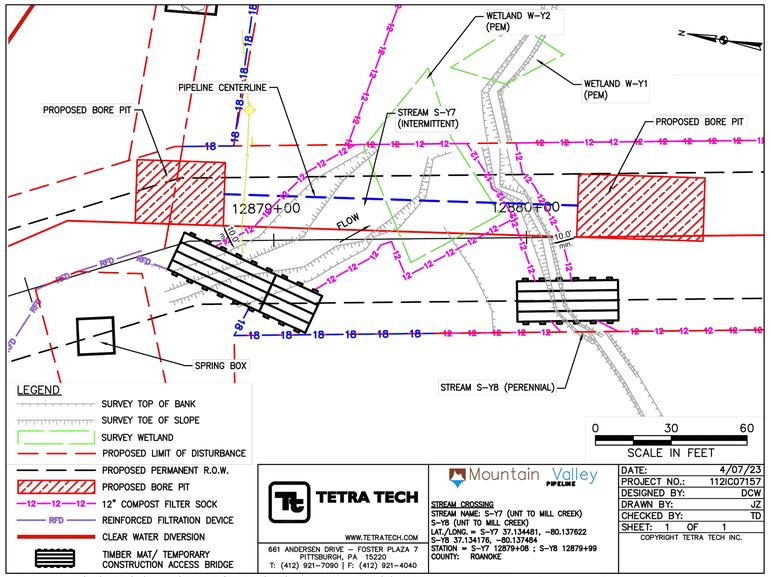

TETRA TECH CAD FILE PATH: X:\CADD_ Pittsburgh\EQT\7157 – MVP\Crossing Permits\Bore Crossings\Holland\H-046-S-Y7.dwg PLOTTED ON: 4/28/2023 12:19 PM PLOTTED BY: Zeigler, Justin PLOT FILE: ENVIRONMENTAL_COLOR.ctb


BORE PIT STREAM CROSSING S-Y7, W-Y2, S-Y8
CROSSING ID H-046
PLAN VIEW

BORE PIT STREAM CROSSING S-SD11
CROSSING ID H-054 HAS BEEN CHANGED TO OPEN CUT

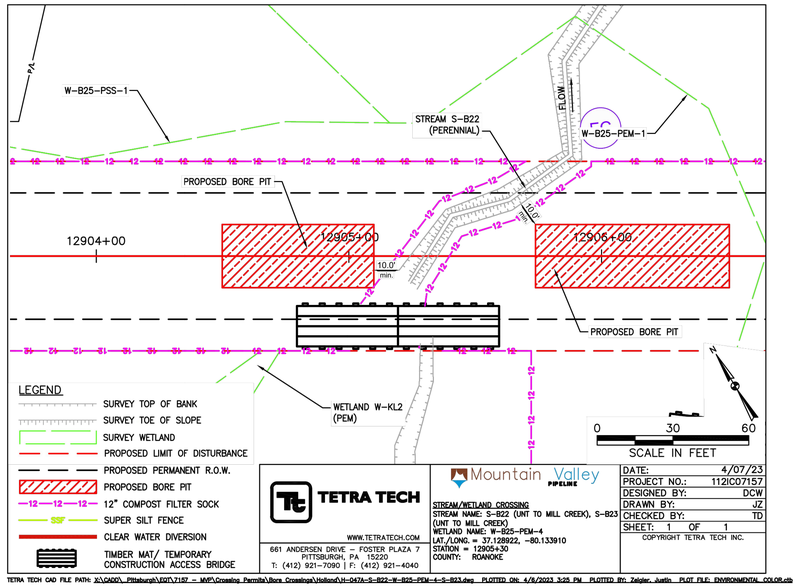

TETRA TECH CAD FILE PATH: X:\CADD_ Pittsburgh\EQT\7157 – MVP\Crossing Permits\Bore Crossings\Holland\H-047A-S-B22-W-B25-PEM-4-S-B23.dwg PLOTTED ON: 4/6/2023 3:25 PM PLOTTED BY: Zeigler, Justin PLOT FILE: ENVIRONMENTAL_COLOR.ctb

BORE PIT STREAM CROSSING S-B22, W-B25
CROSSING ID H-047A
PLAN VIEW

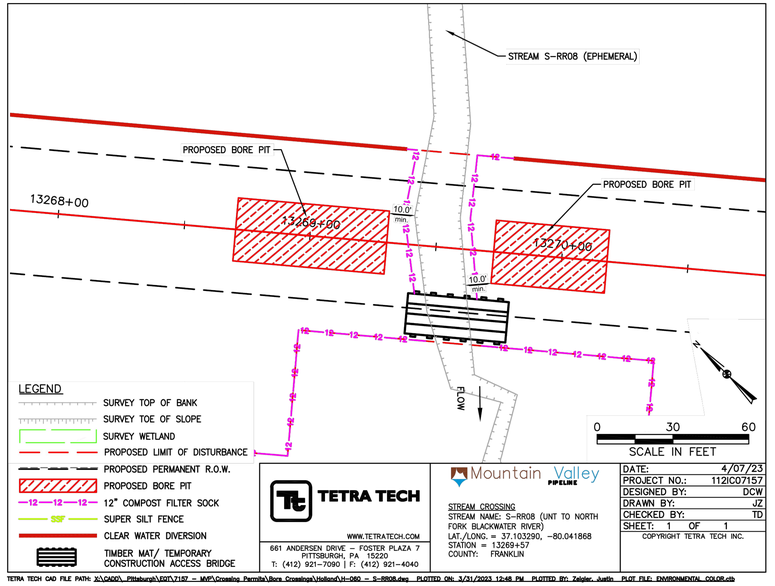

TETRA TECH CAD FILE PATH: X:\CADD_ Pittsburgh\EQT\7157 – MVP\Crossing Permits\Bore Crossings\Holland\H-060 – S-RR08.dwg PLOTTED ON: 3/31/2023 12:48 PM PLOTTED BY: Zeigler, Justin PLOT FILE: ENVIRONMENTAL_COLOR.ctb

BORE PIT STREAM CROSSING S-RR08
CROSSING ID H-060
PLAN VIEW

REVISIONS:

NO.:	DATE:	DWN.:	CHK'D:	APP'D.:	DESCRIPTION:
–	04/07/23	JZ	TD	DCW	BORE CROSSING PERMITS
1	10/12/23	JZ	IHH	DCW	S-D11 CROSSING CHANGED TO OPEN CUT

Mountain Valley PIPELINE

EROSION AND SEDIMENT CONTROL PLANS

MOUNTAIN VALLEY PIPELINE PROJECT – H600 LINE

SPREAD 10 – MONTGOMERY – ROANOKE – FRANKLIN COUNTY, VIRGINIA

MOUNTAIN VALLEY PIPELINE, LLC
2200 ENERGY DRIVE
CANONSBURG, PA 15317

TETRA TECH
complex world | CLEAR SOLUTIONS™
661 ANDERSEN DRIVE
FOSTER PLAZA 7
PITTSBURGH, PA 15220


EROSION AND SEDIMENT CONTROL PLANS

COMMONWEALTH OF VIRGINIA
10/12/23
DANIEL C. WITT
Lic. No. 65093
PROFESSIONAL ENGINEER

DRAWN BY:	JZ
CHECKED BY:	IHH
APPROVED BY:	DCW
DATE:	10/12/2023
SCALE:	AS SHOWN
1	REVISION

SHT. NO. 14.82CES OF 14.82ES

TETRA TECH CAD FILE PATH: X:\CADD_ Pittsburgh\EQT\7157 – MVP\Crossing Permits\Bore Crossings\Holland\Figures\Spread 10\7157ES14.82CES.dwg PLOTTED ON: 10/10/2023 8:46 AM PLOTTED BY: Zeigler, Justin PLOT FILE: ENVIRONMENTAL_COLOR.ctb

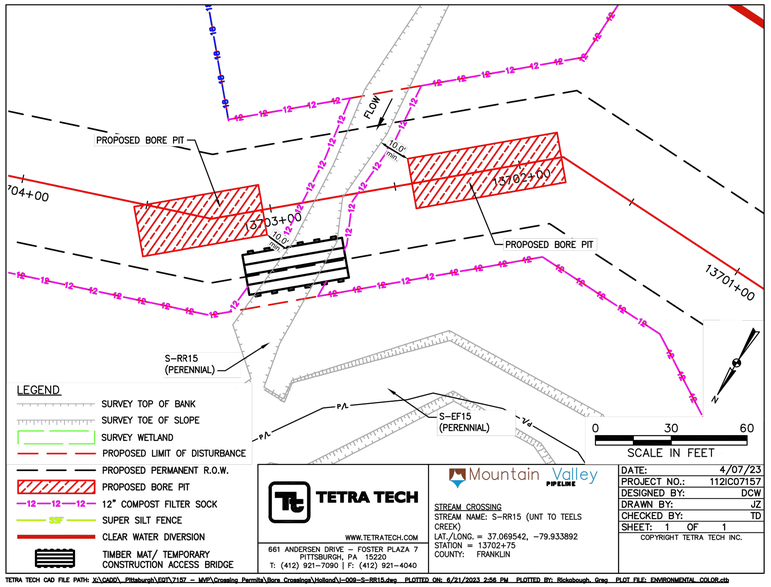

TETRA TECH
661 ANDERSEN DRIVE – FOSTER PLAZA 7
PITTSBURGH, PA 15220
T: (412) 921-7090 | F: (412) 921-4040
WWW.TETRATECH.COM

Mountain Valley PIPELINE


STREAM CROSSING
STREAM NAME: S-RR15 (UNT TO TEELS CREEK)
LAT./LONG. = 37.069542, -79.933892
STATION = 13702+75
COUNTY: FRANKLIN

DATE:	4/07/23
PROJECT NO.:	112IC07157
DESIGNED BY:	DCW
DRAWN BY:	JZ
CHECKED BY:	TD
SHEET:	1 OF 1

COPYRIGHT TETRA TECH INC.

TETRA TECH CAD FILE PATH: X:\CADD_ Pittsburgh\EQT\7157 – MVP\Crossing Permits\Bore Crossings\Holland\I-009-S-RR15.dwg PLOTTED ON: 6/21/2023 2:56 PM PLOTTED BY: Rickabough, Greg PLOT FILE: ENVIRONMENTAL_COLOR.ctb

BORE PIT STREAM CROSSING S-RR15
CROSSING ID I-009
PLAN VIEW

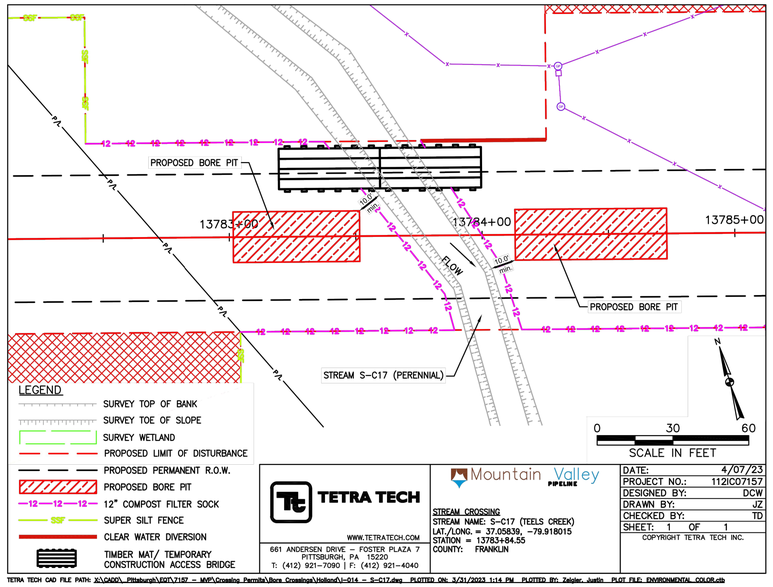

TETRA TECH
661 ANDERSEN DRIVE – FOSTER PLAZA 7
PITTSBURGH, PA 15220
T: (412) 921-7090 | F: (412) 921-4040
WWW.TETRATECH.COM

Mountain Valley PIPELINE

STREAM CROSSING
STREAM NAME: S-C17 (TEELS CREEK)
LAT./LONG. = 37.05839, -79.918015
STATION = 13783+84.55
COUNTY: FRANKLIN

DATE:	4/07/23
PROJECT NO.:	112IC07157
DESIGNED BY:	DCW
DRAWN BY:	JZ
CHECKED BY:	TD
SHEET:	1 OF 1

COPYRIGHT TETRA TECH INC.

TETRA TECH CAD FILE PATH: X:\CADD_ Pittsburgh\EQT\7157 – MVP\Crossing Permits\Bore Crossings\Holland\I-014 – S-C17.dwg PLOTTED ON: 3/31/2023 1:14 PM PLOTTED BY: Zeigler, Justin PLOT FILE: ENVIRONMENTAL_COLOR.ctb

BORE PIT STREAM CROSSING S-C17
CROSSING ID I-014
PLAN VIEW

NO.:	DATE:	DWN.:	CHKD.:	APPD.:	DESCRIPTION:
–	06/16/23	JZ	IHH	DCW	ADDRESS VAQEG COMMENTS ON BORE PITS
–	04/07/23	JZ	TD	DCW	BORE CROSSING PERMITS

REVISIONS:

Mountain Valley PIPELINE

EROSION AND SEDIMENT CONTROL PLANS
MOUNTAIN VALLEY PIPELINE PROJECT – H600 LINE
SPREAD 10 – MONTGOMERY – ROANOKE – FRANKLIN COUNTY, VIRGINIA

MOUNTAIN VALLEY PIPELINE, LLC
2200 ENERGY DRIVE
CANONSBURG, PA 15317

TETRA TECH
complex world | CLEAR SOLUTIONS™
661 ANDERSEN DRIVE
FOSTER PLAZA 7
PITTSBURGH, PA 15220

EROSION AND SEDIMENT CONTROL PLANS

COMMONWEALTH OF VIRGINIA
6/16/23
DANIEL C. WITT
Lic. No. 65093
PROFESSIONAL ENGINEER

DRAWN BY:	JZ
CHECKED BY:	IHH
APPROVED BY:	DCW
DATE:	06/16/2023
SCALE:	AS SHOWN
	– REVISION

SHT. NO. 14.82DES OF 14.82ES

TETRA TECH CAD FILE PATH: X:\CADD_ Pittsburgh\EQT\7157 – MVP\Crossing Permits\Bore Crossings\Holland\Figures\Spread 10\7157ES14.82DES.dwg PLOTTED ON: 6/21/2023 3:04 PM PLOTTED BY: Rickabough, Greg PLOT FILE: ENVIRONMENTAL_COLOR.ctb